


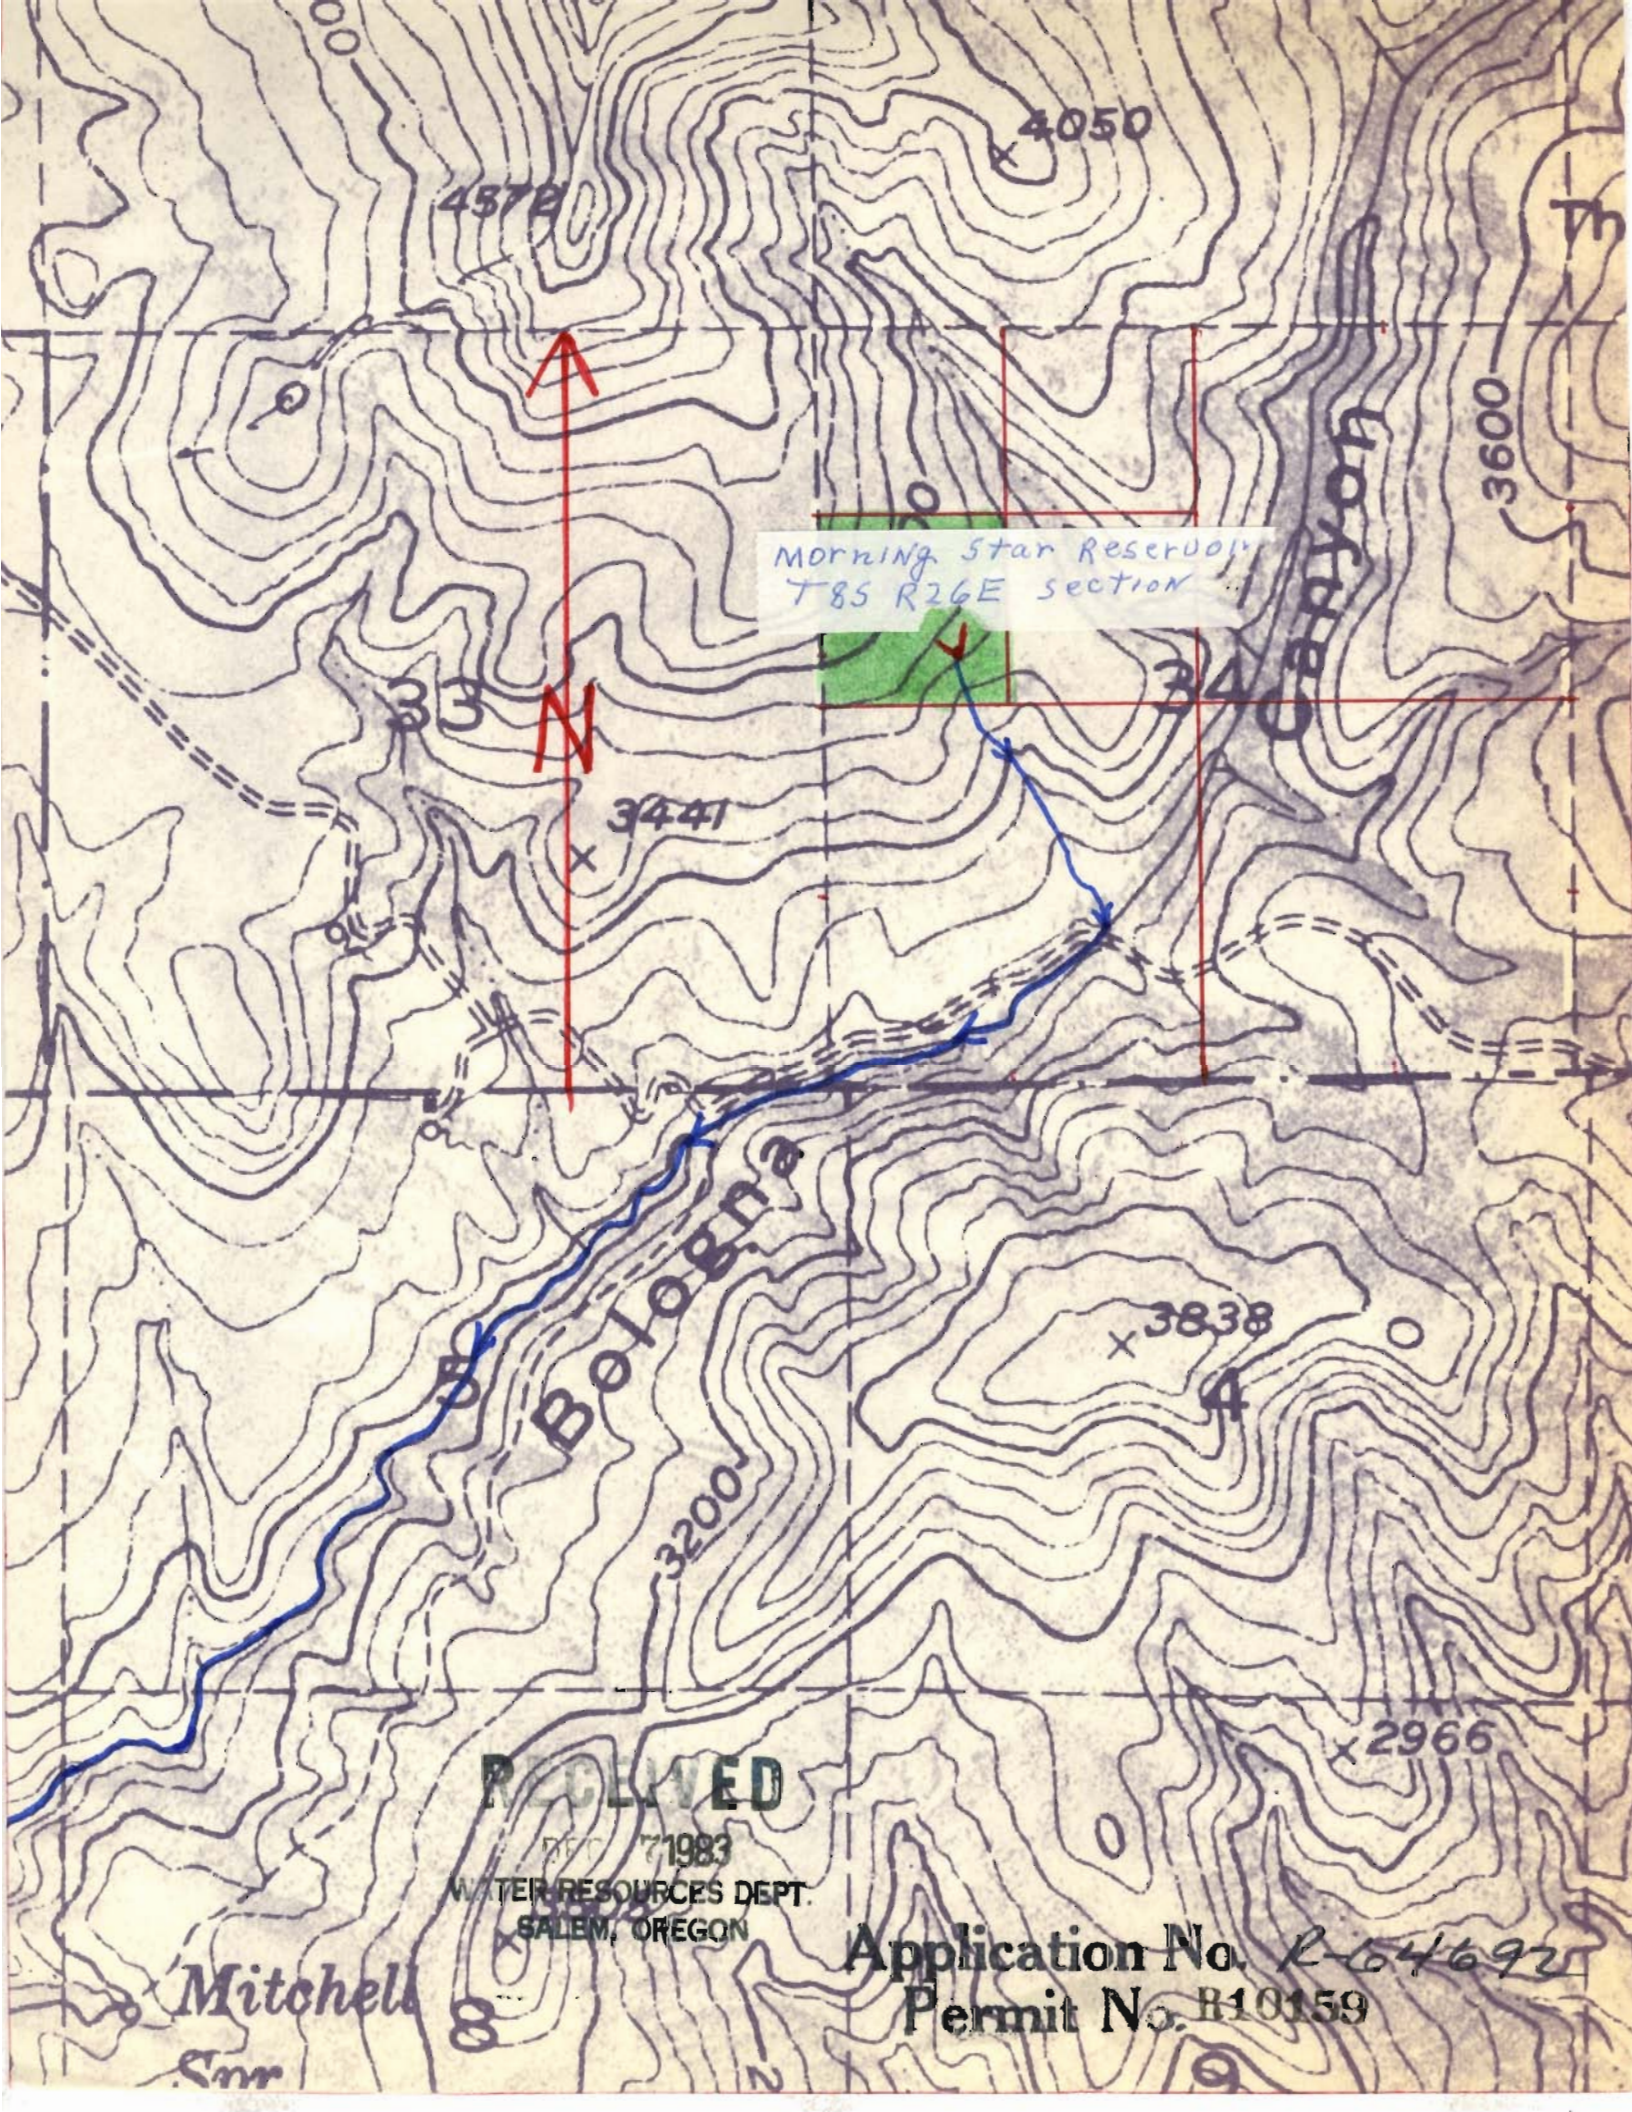

Morning Star Reservoir
T85 R26E section


RECEIVED

DEC 7 1983
WATER RESOURCES DEPT.
SALEM, OREGON

Application No. R-64692
Permit No. R10159

Mitchell


39.83

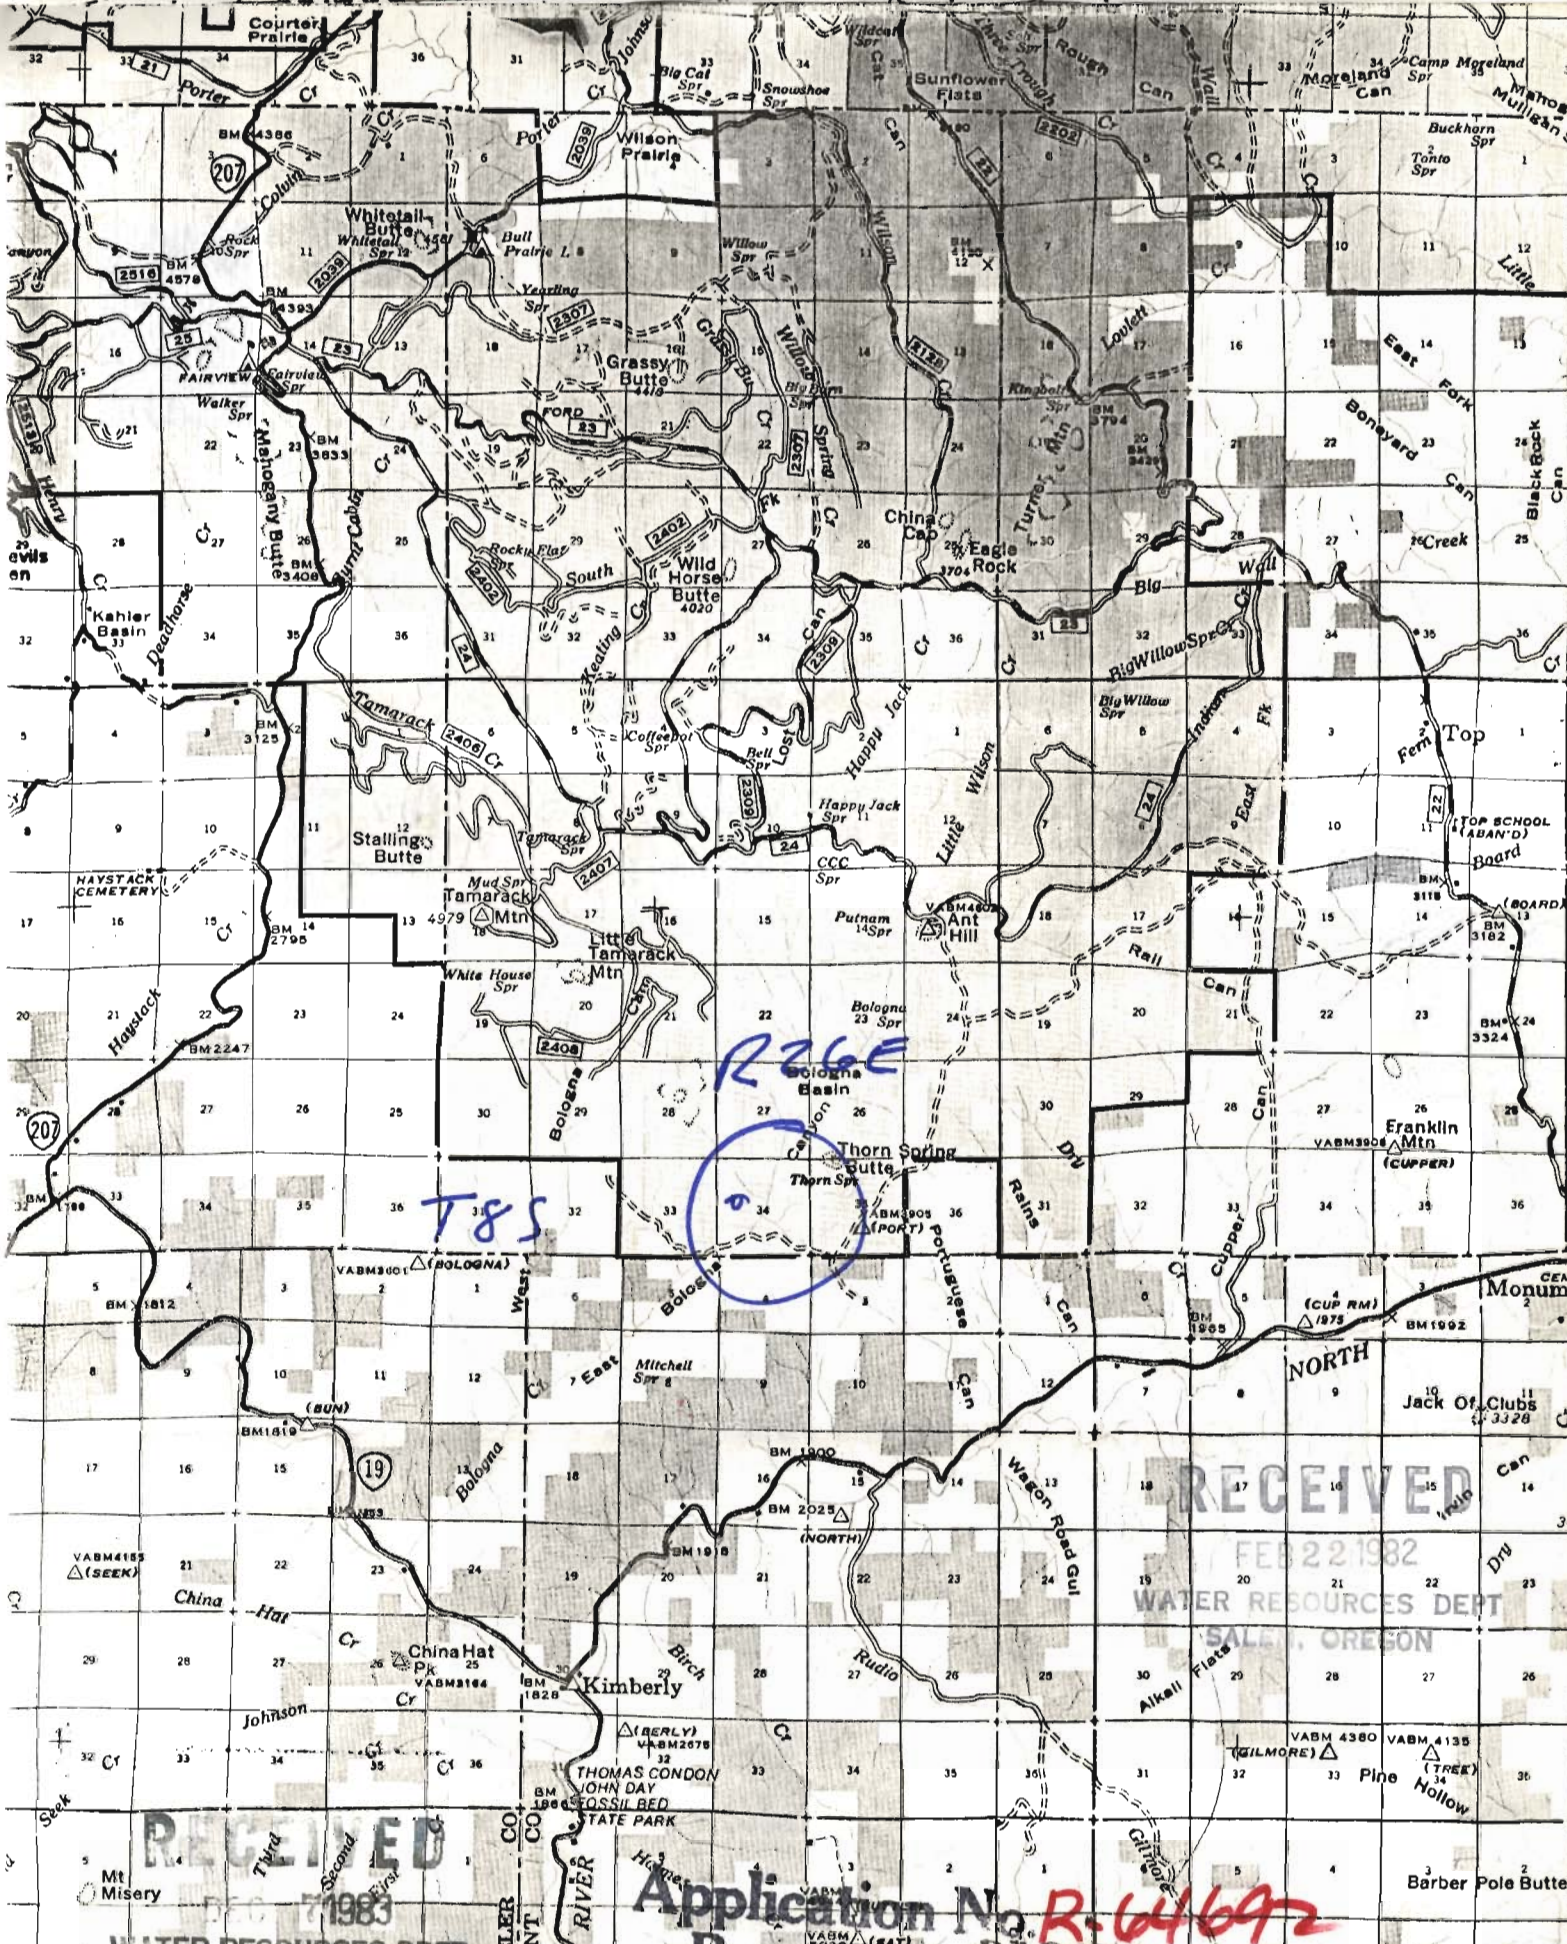

RECEIVED
FEB 22 1982
WATER RESOURCES DEPT
SALEM, OREGON

RECEIVED
1983
WATER RESOURCES DEPT

Application No. R-64692

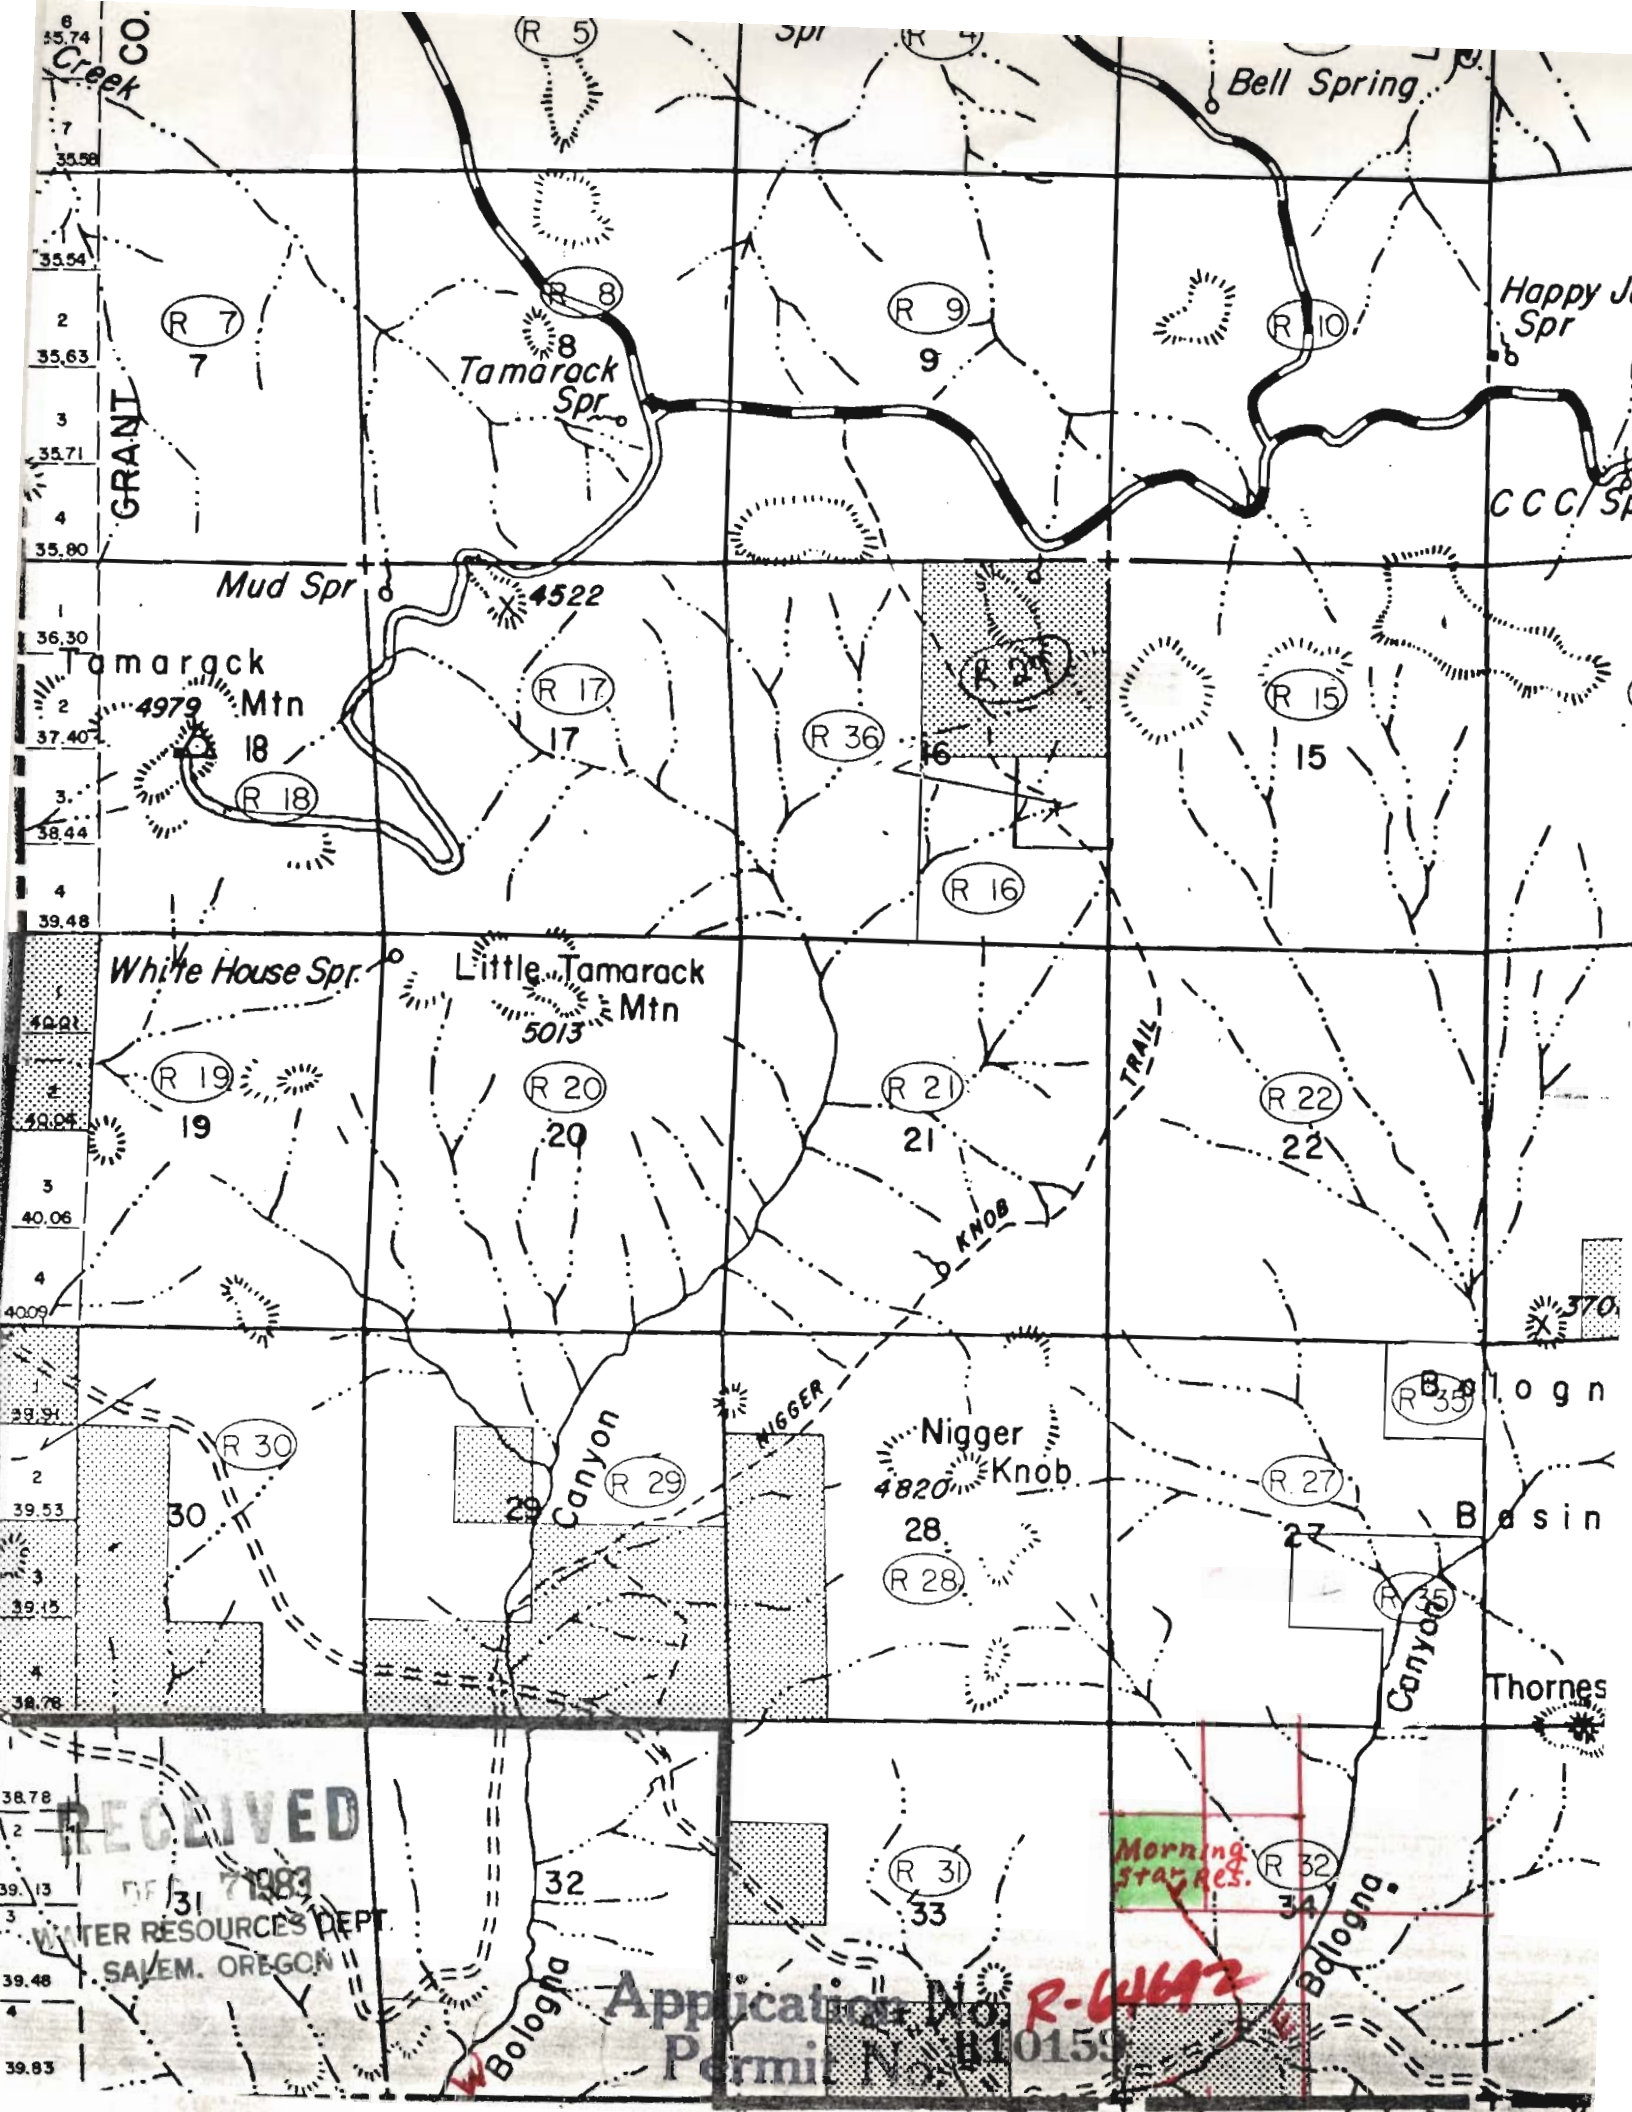


RECEIVED

31 7 1983

WATER RESOURCES DEPT.
SALEM, OREGON

Application No. R-44692
Permit No. 110159

TOWNSHIP 8S, RANGE 26E, SECTION 34, W.M.

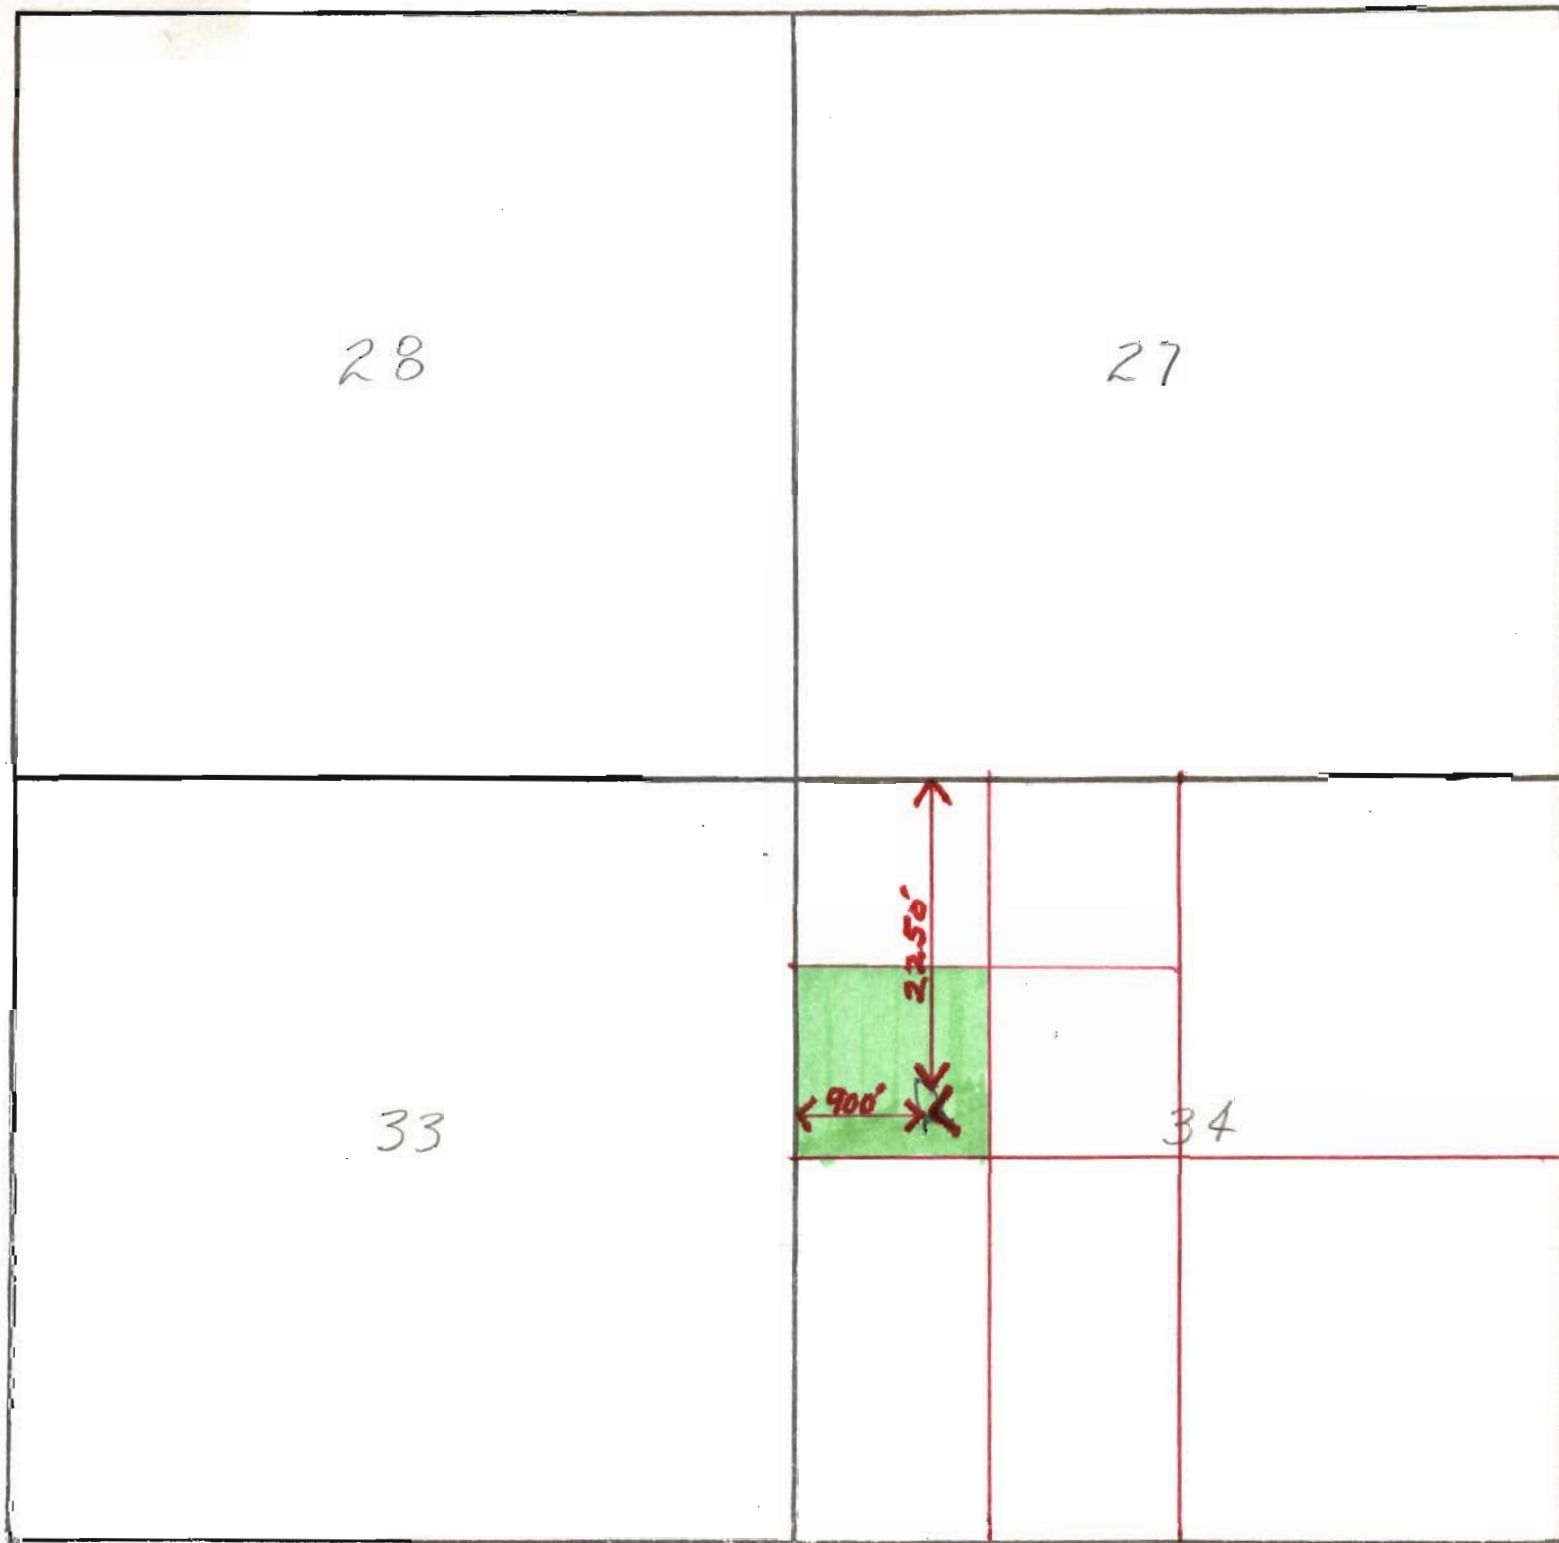

NAME Morning Star Pond COUNTY Grant

RECEIVED

DEC 7 1983
WATER RESOURCES DEPT.
SALEM, OREGON

Application No. R-64692
Permit No. R10159

RECEIVED

FEB 22 1982
WATER RESOURCES DEPT.
SALEM, OREGON