

Sedge Reservoir
T6S R24E section 28
NE SW

Rocky Reservoir
T6S R24E sec 27
SW SW

FOREST
RECEIVED

DEC 7 1983
WATER RESOURCES DEPT.
SALEM, OREGON

Application No. R-64693
Permit No. R10160

Spring

N


PRIVATE

07' 30"

T.6S.

T.7S.

T.8S.

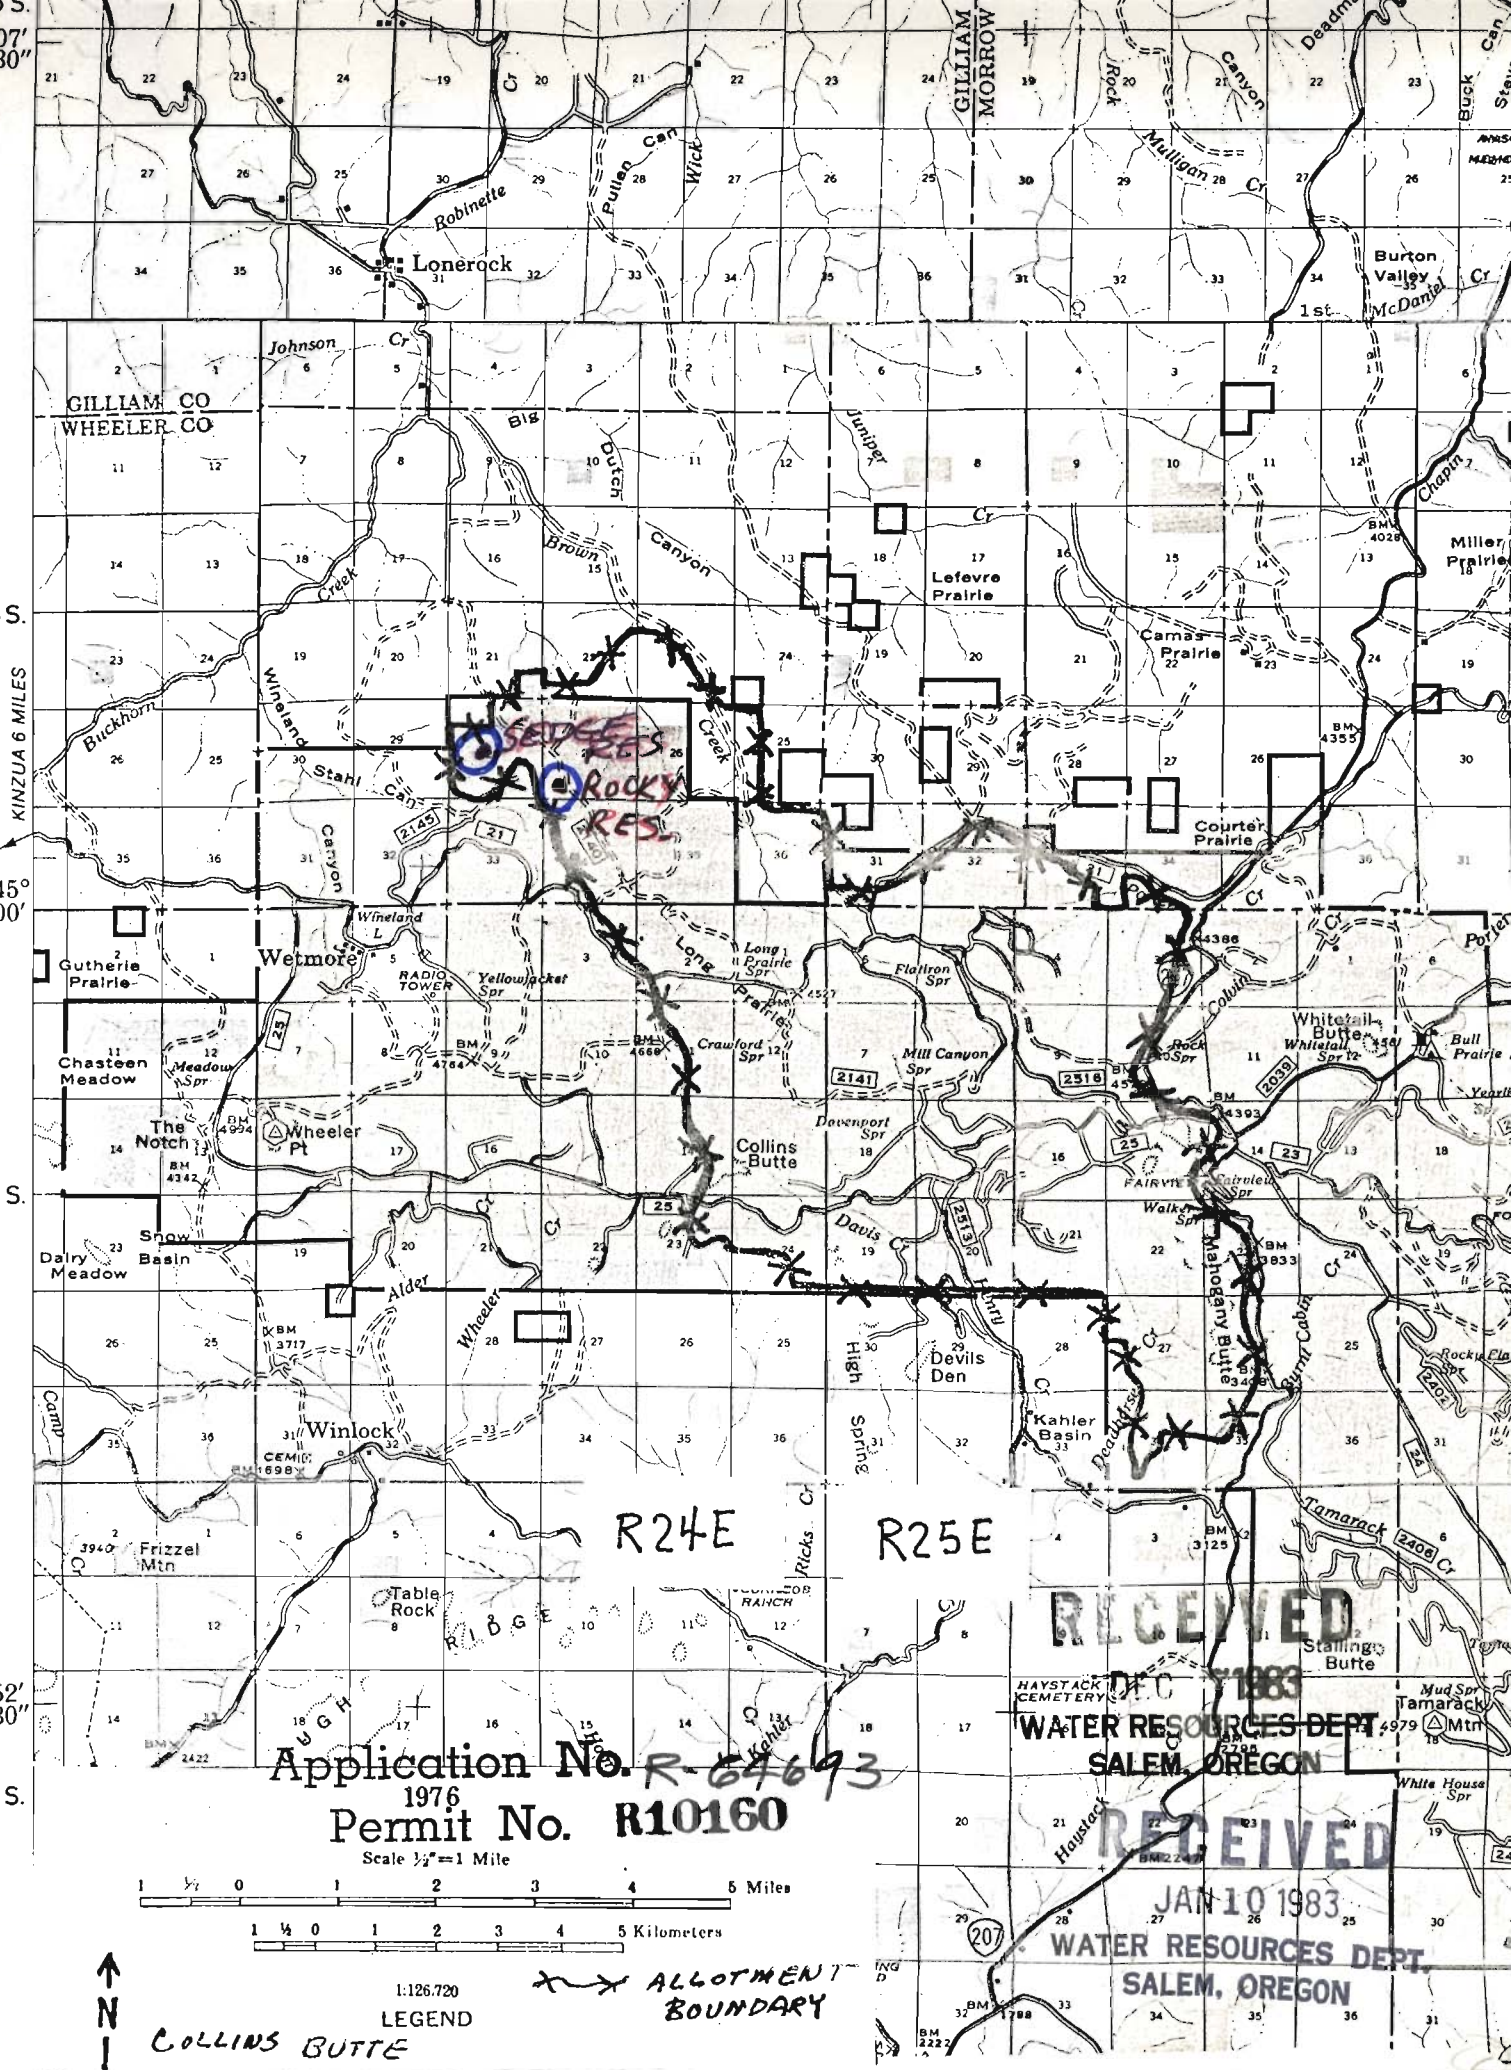

GILLIAM CO
WHEELER CO

Wetmore

The Notch

Winlock

Frizzel Mtn

Table Rock

Collins Butte

Devils Den

Haystack Cemetery

Johnson Cr

Big Dutch Canyon

Stahl Cr




























Juniper Cr

Levee Prairie

Camas Prairie

Courier Prairie

White-tail Butte

White-tail Spr












1 1/2 0 1 2 3 4 5 Miles
1 1/4 0 1 2 3 4 5 Kilometers




COLLINS BUTTE


1:126,720
LEGEND

ALLOTMENT
BOUNDARY

RECEIVED
JAN 10 1983
WATER RESOURCES DEPT
SALEM, OREGON

RECEIVED
JAN 10 1983
WATER RESOURCES DEPT
SALEM, OREGON

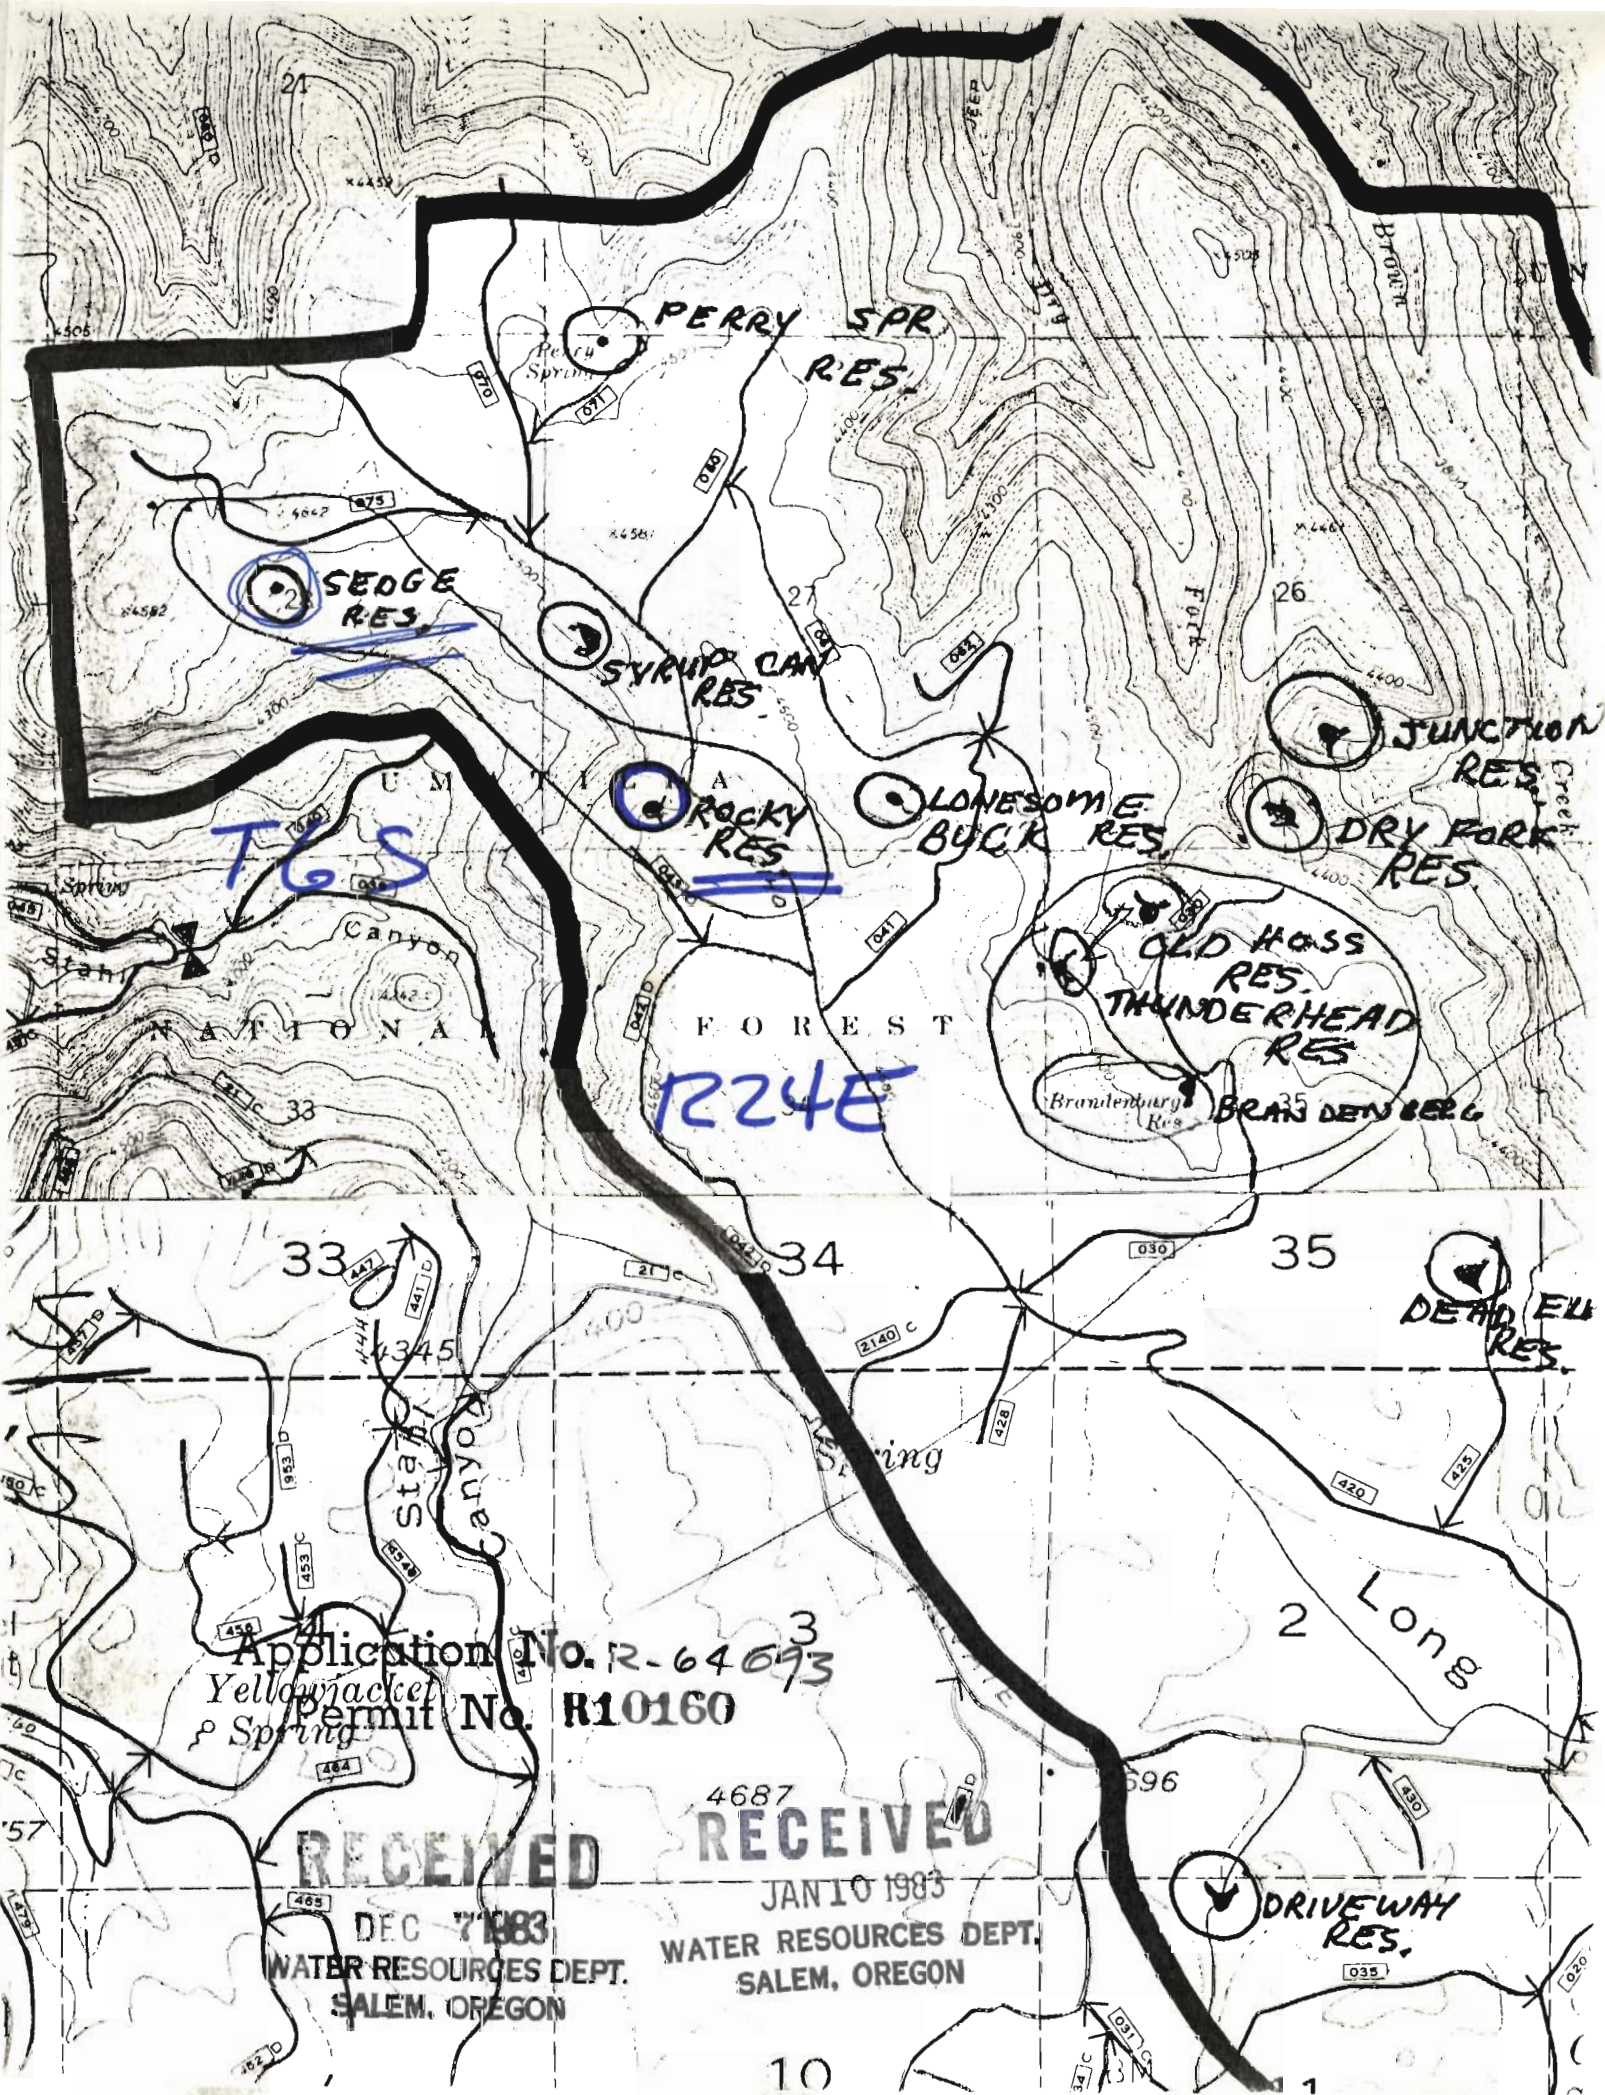

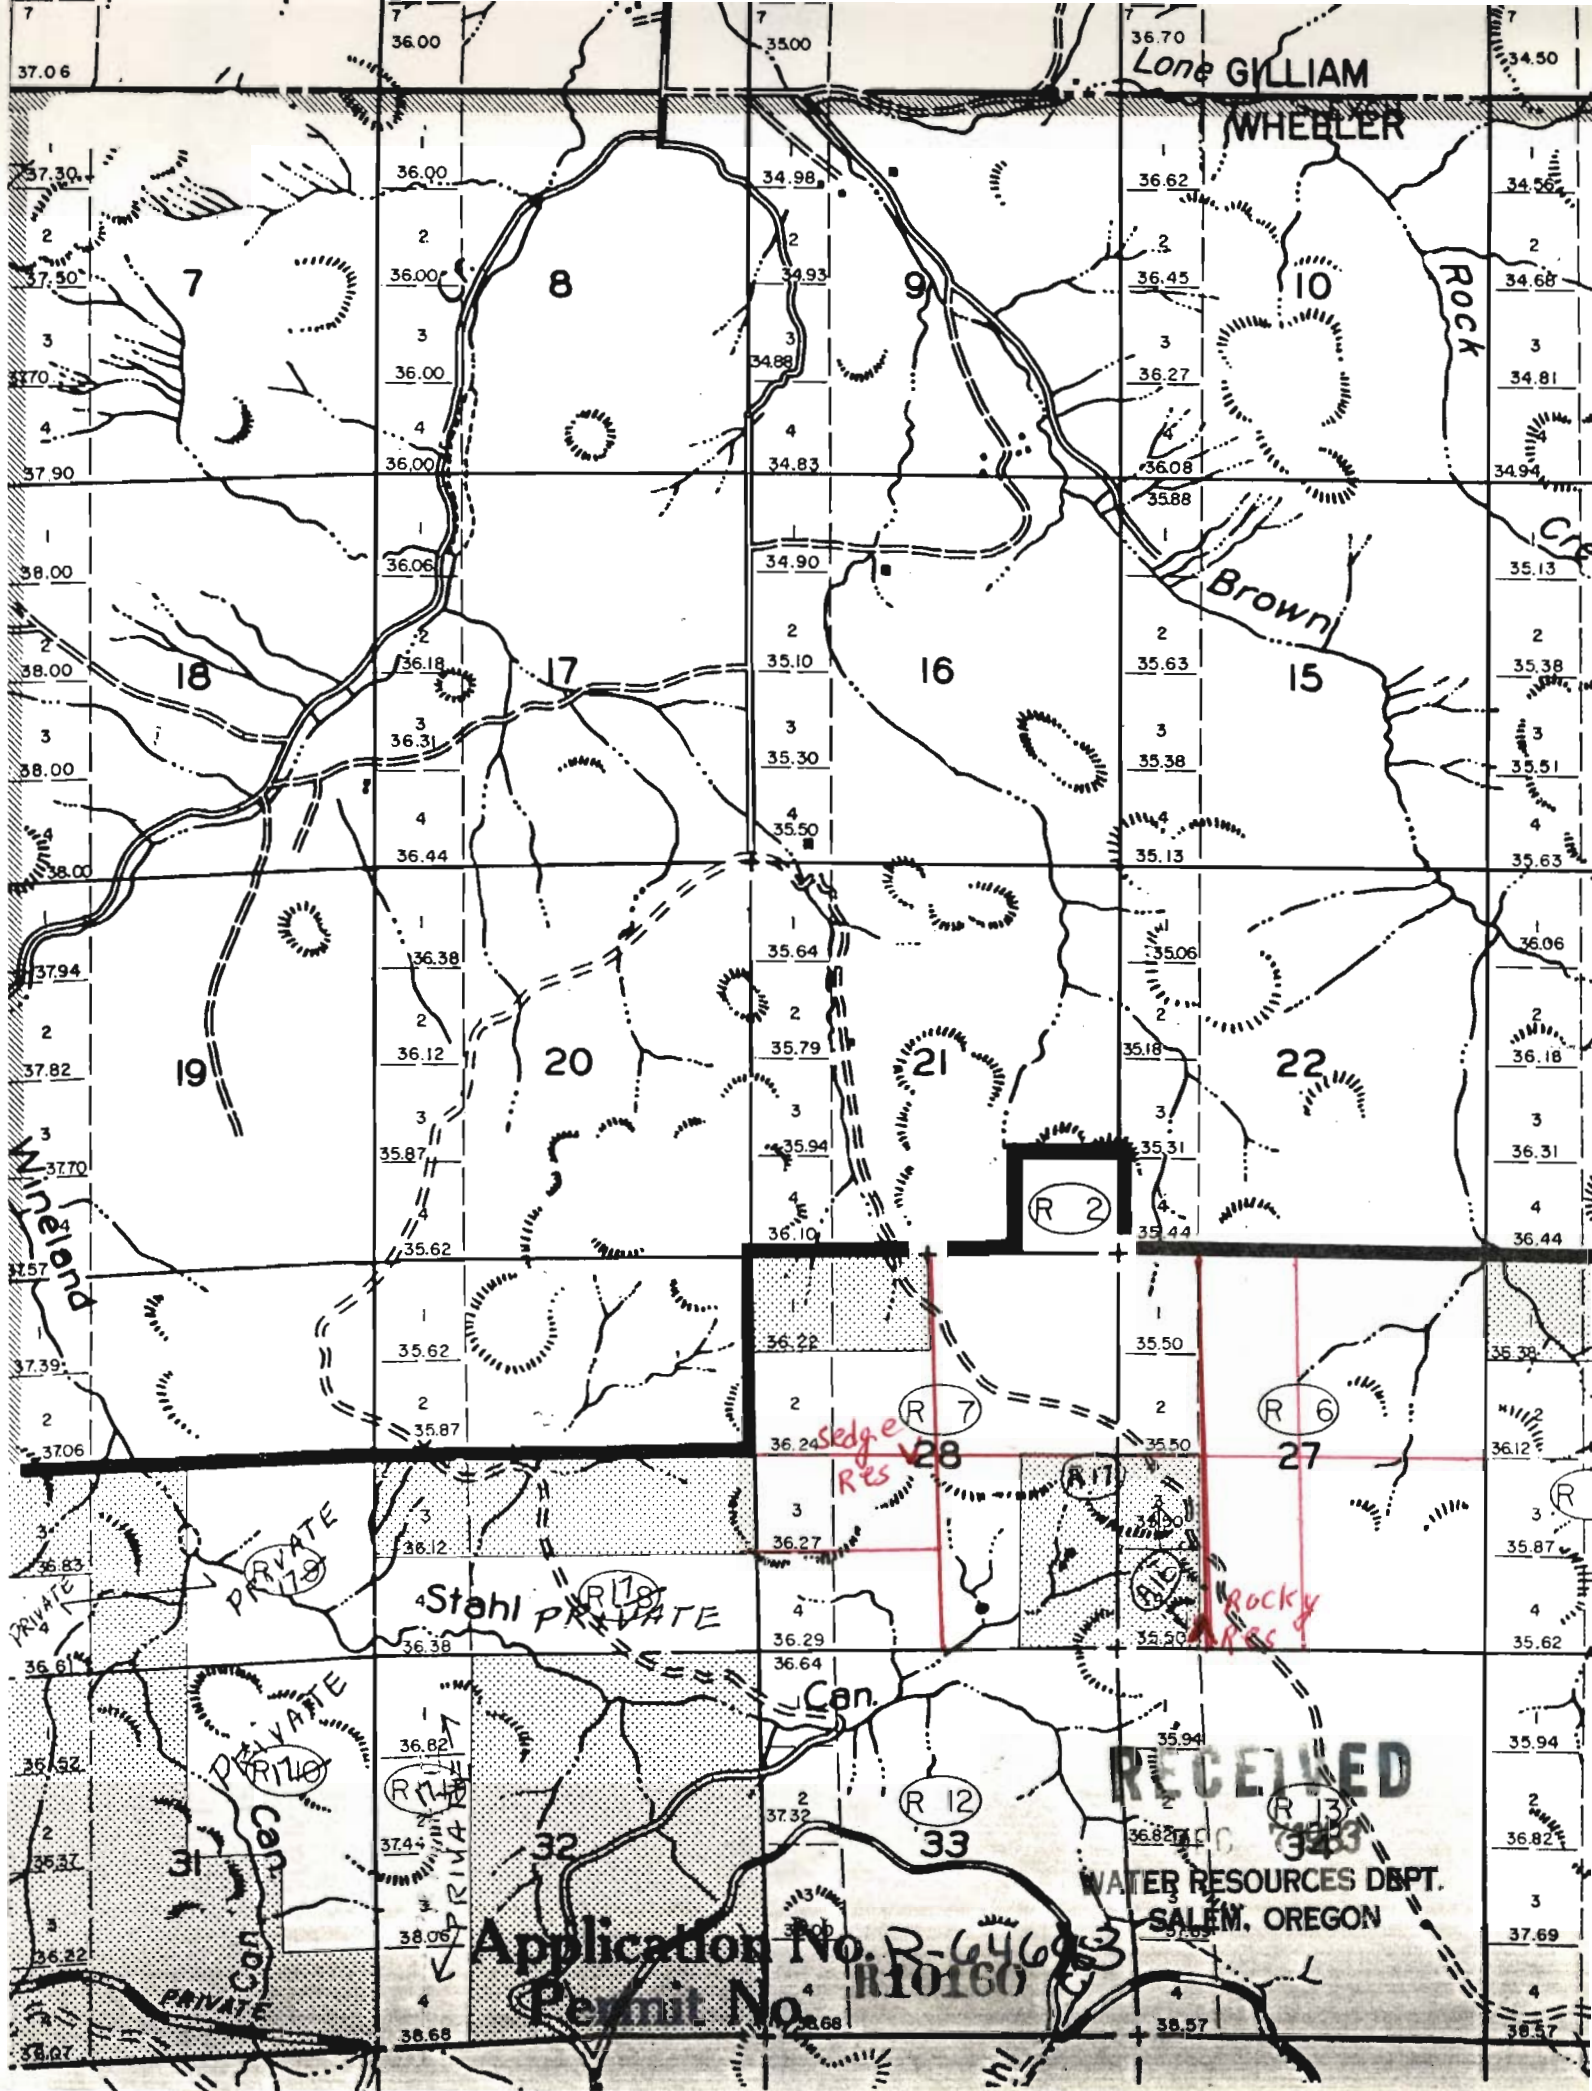

Lone GILLIAM

WHEELER

Rock

Brown

Wineland

PRIVATE
PRIVATE
PRIVATE
Can. 31
PRIVATE

Stahl PRIVATE

Can.

RECEIVED

WATER RESOURCES DBPT.
SALEM, OREGON

Application No. R-64683
Permit No. R10160