


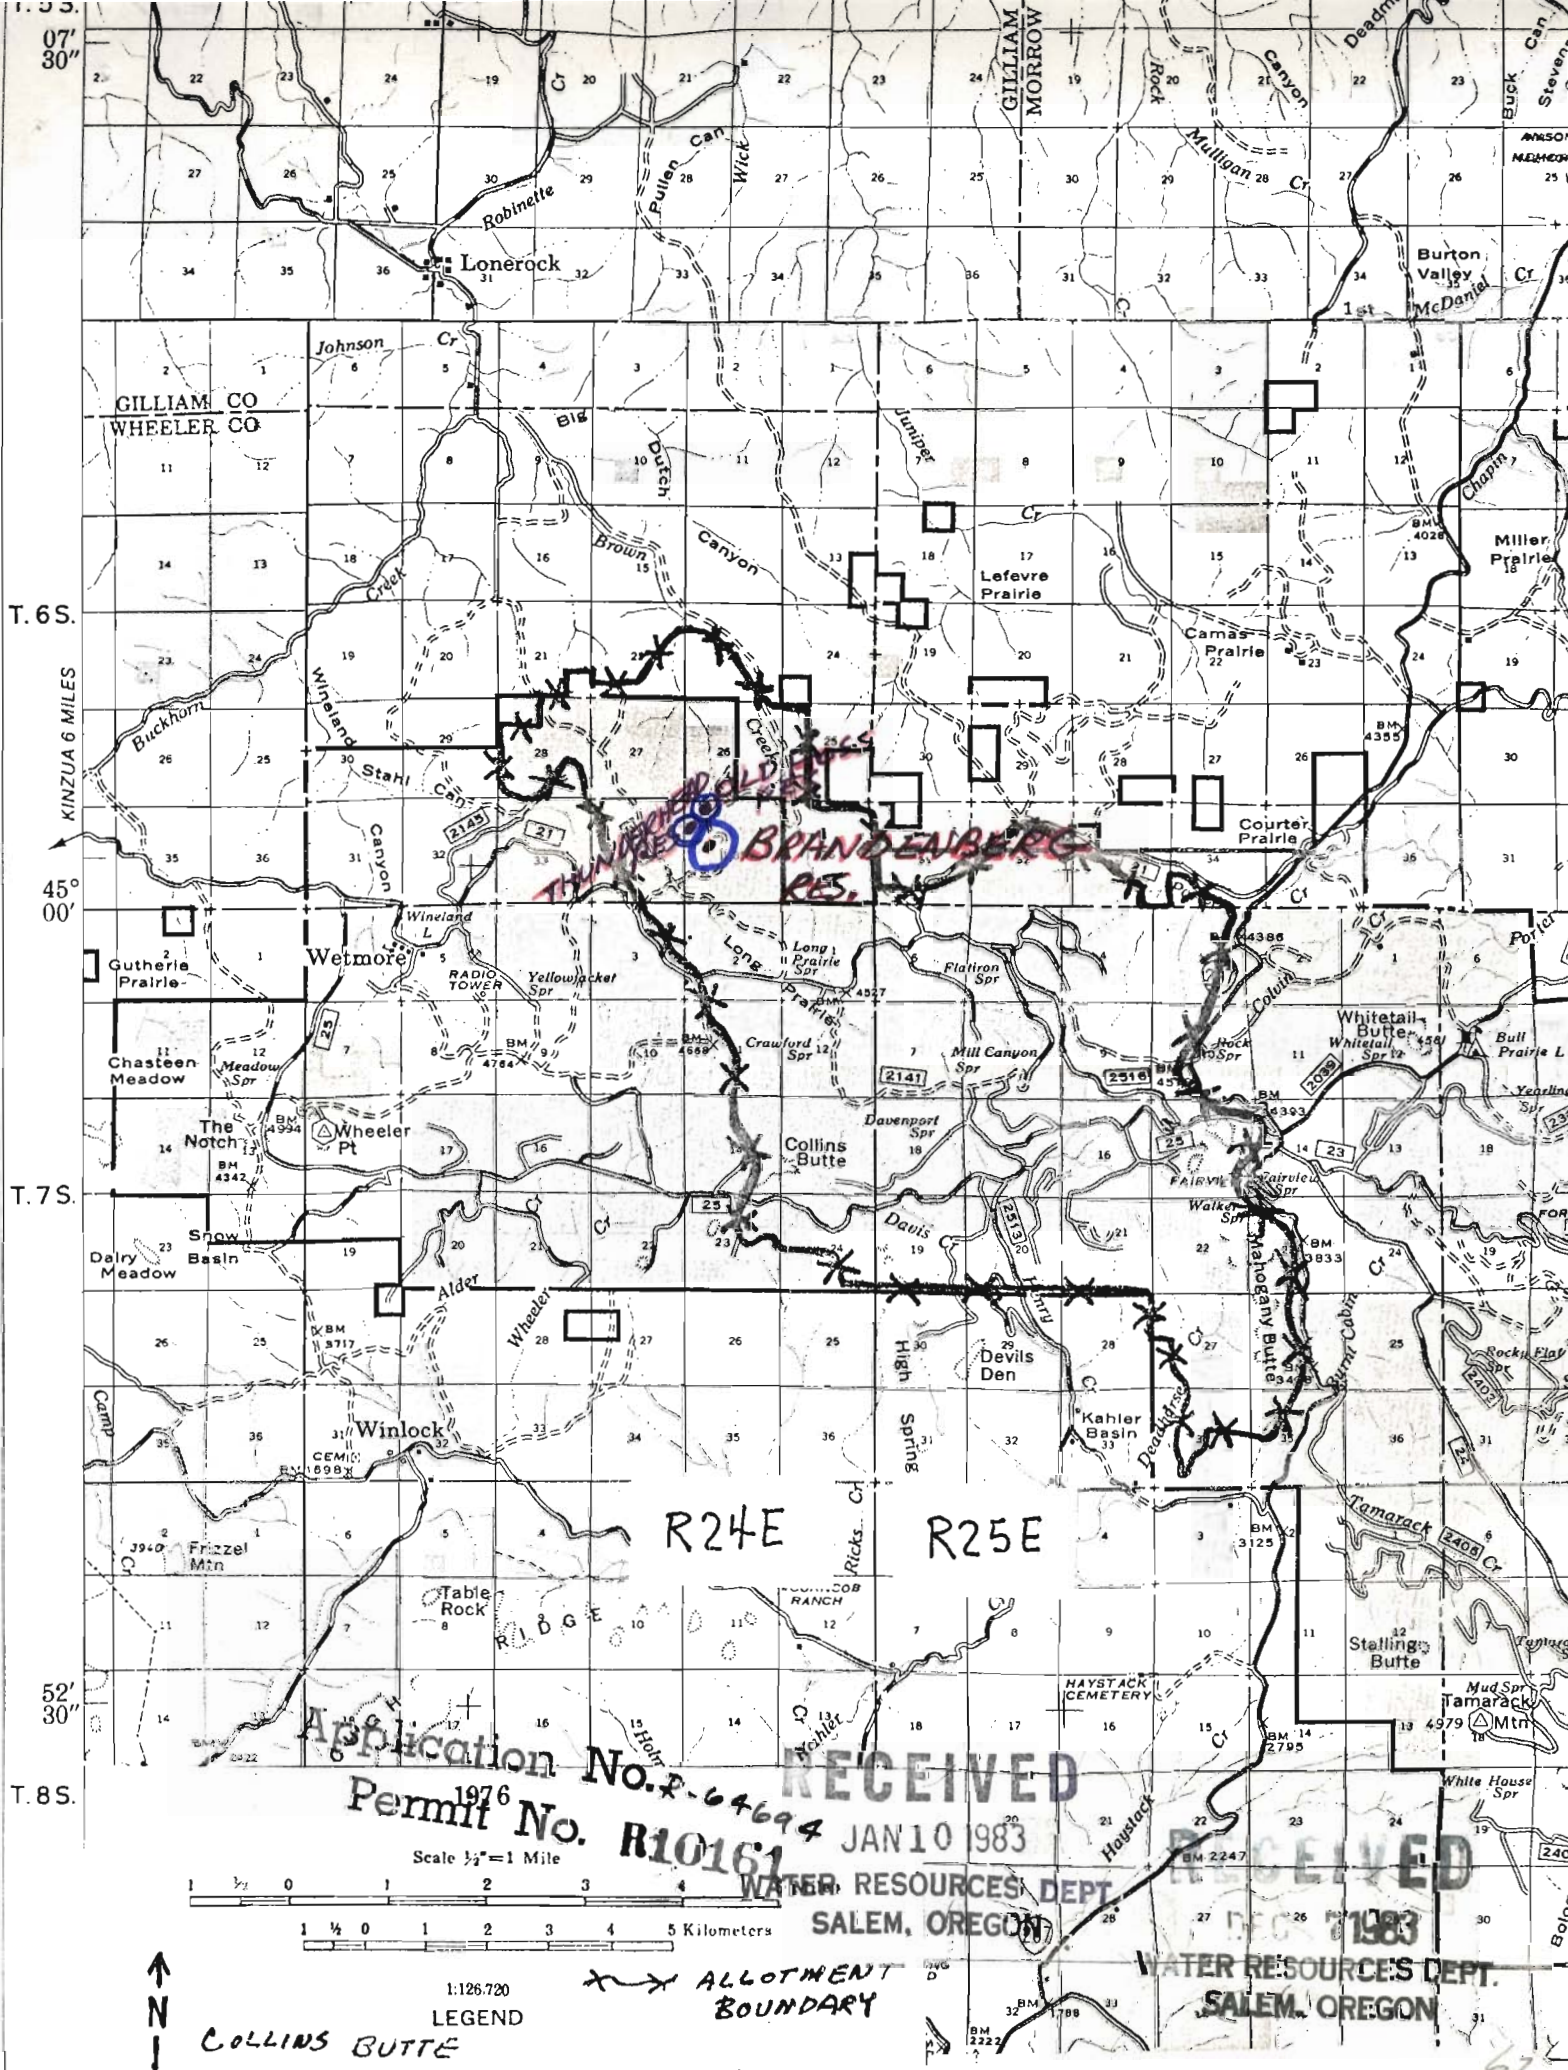

GILLIAM CO
WHEELER CO

T.6S.

45° 00'

T.7S.

T.8S.



R24E

R25E

Application No. 1976
Permit No. R-64694
R10161


RECEIVED
JAN 10 1983
WATER RESOURCES DEPT.
SALEM, OREGON

RECEIVED
DEC 7 1983
WATER RESOURCES DEPT.
SALEM, OREGON

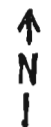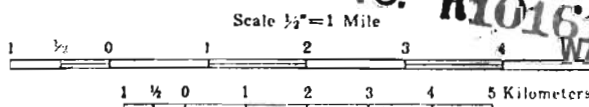

1:126,720
LEGEND
COLLINS BUTTE

ALLOTMENT
BOUNDARY

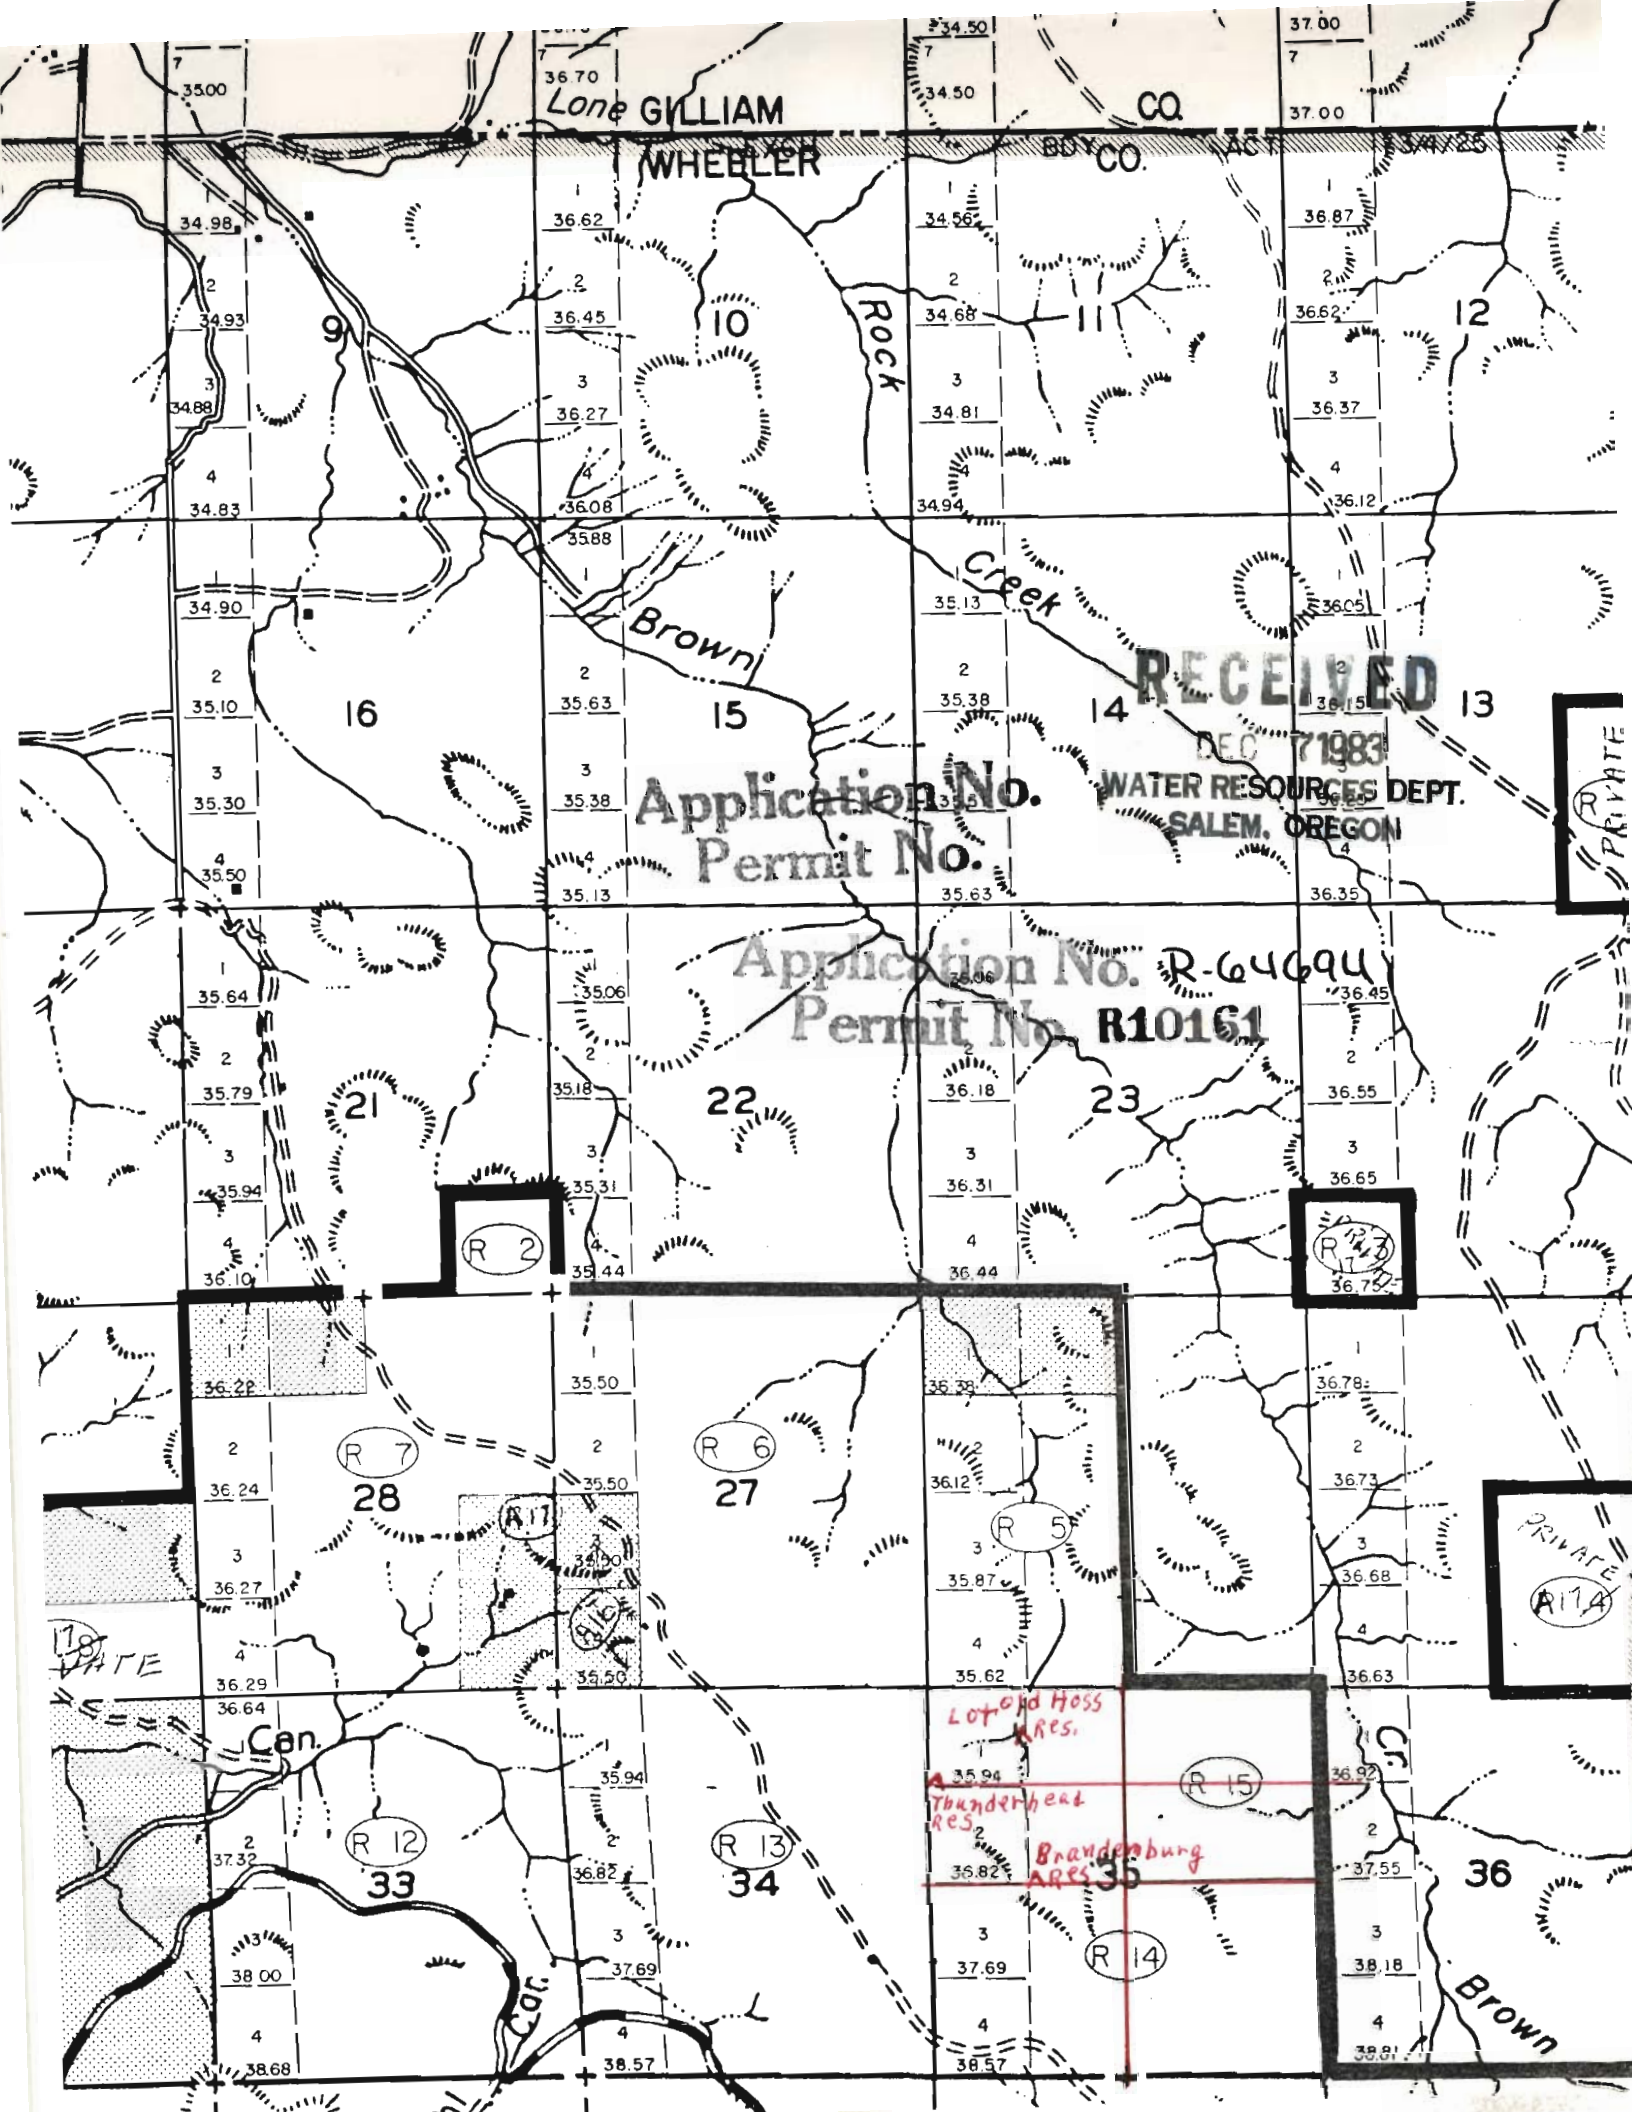

Lone GILLIAM WHEELER CO.

CO.

CO.

RECEIVED

DEC 7 1983

WATER RESOURCES DEPT.
SALEM, OREGON

Application No.
Permit No.

Application No. R-64694
Permit No. R10161

R 2

R 17

R 7
28

R 6
27

R 5

PRIVATE
R 14

R 12
33

R 13
34

R 15

R 14


Lot and Moss
Res.

Thunderhead
Res.

Brandenburg
Res.

Brown

TOWNSHIP 65, RANGE 24E, SECTION 35, W.M.

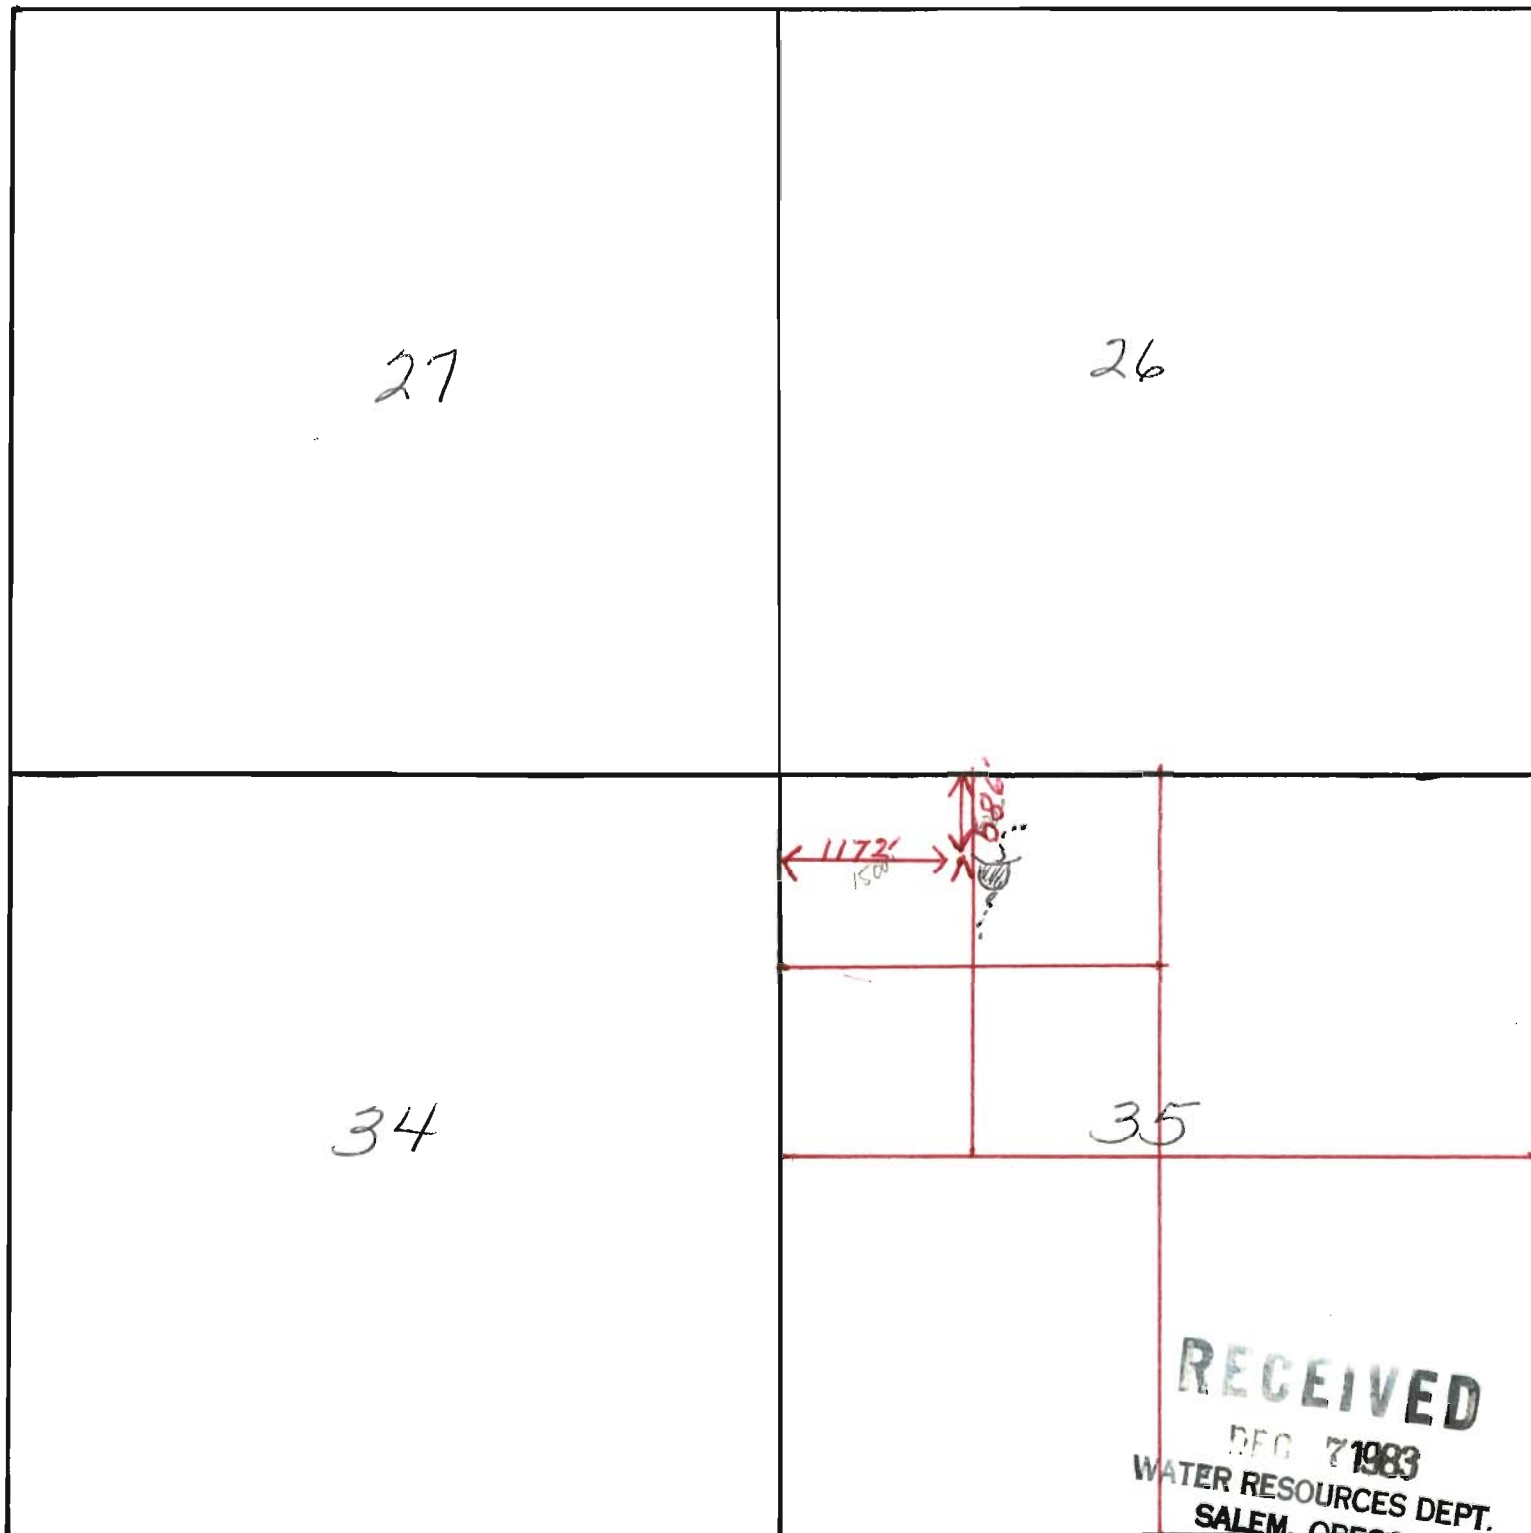

RECEIVED
DEC 7 1983
WATER RESOURCES DEPT.
SALEM, OREGON

NAME OLD HOSS RES.

COUNTY WHEELER


Application No. 2-64694

Permit No. R10161

8A

RECEIVED
JAN 10 1983
WATER RESOURCES DEPT.
SALEM, OREGON

TOWNSHIP 65, RANGE 24E, SECTION 35, W.M.

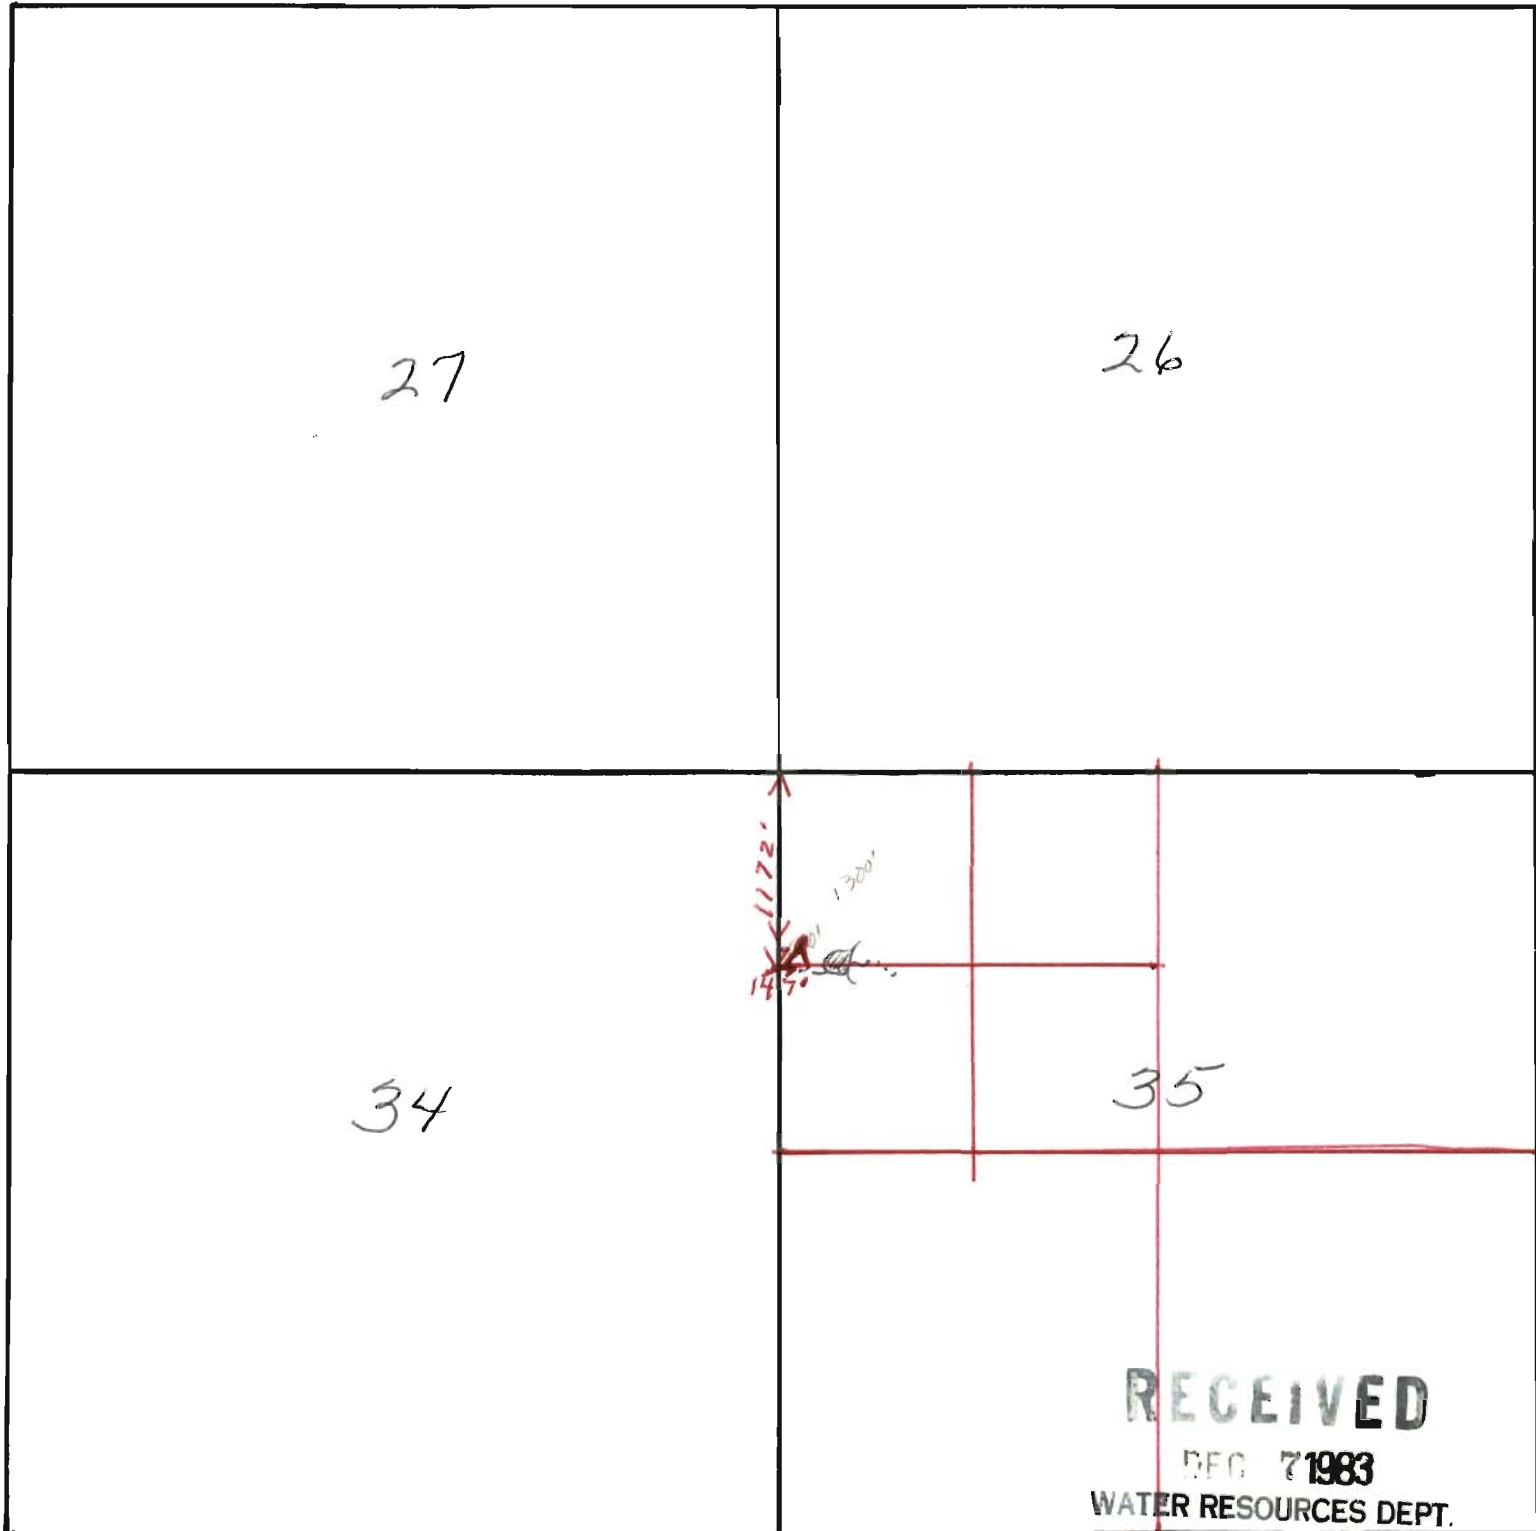

RECEIVED
DEC 7 1983
WATER RESOURCES DEPT.
SALEM, OREGON

NAME THUNDERHEAD RES. COUNTY WHEELER

RECEIVED

Application No. R-64694
Permit No. R10161

8B

JAN 10 1983
WATER RESOURCES DEPT.
SALEM, OREGON


TOWNSHIP 65, RANGE 24E, SECTION 35, W.M.

27

26

34

35

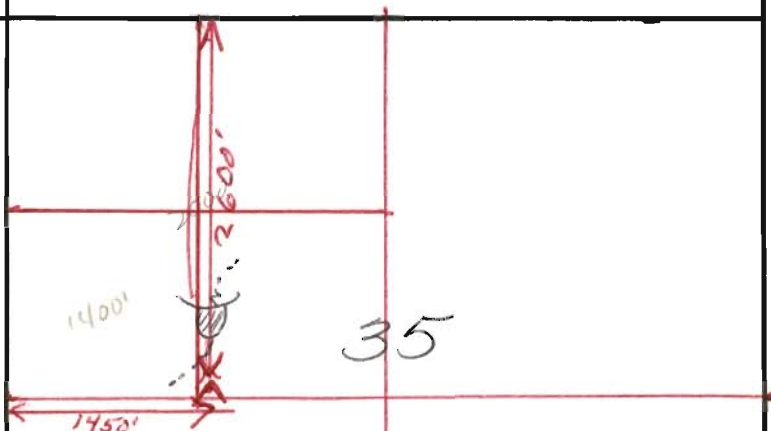

RECEIVED

DEC 7 1983

WATER RESOURCES DEPT.
SALEM, OREGON

NAME BRANDENBURG RES.

COUNTY WHEELER

Application No. R-64694

Permit No. R10161 8C

RECEIVED

JAN 10 1983

WATER RESOURCES DEPT.
SALEM, OREGON

RECEIVED

DEC 7 1983

WATER RESOURCES DEPT.
SALEM, OREGON

Application No. R-64694
Permit No. R10161

ILL A

FOREST

old HOSS Reservoir
T6S R24E NW NW

LOT 1

Thunderhead Reservoir
T6S R24E NW NW

LOT 2

Brandenburg Res

LOT 3

Brandenburg Res
T6S R24E section 35

LOT 4

35

34

34

26

23

22