




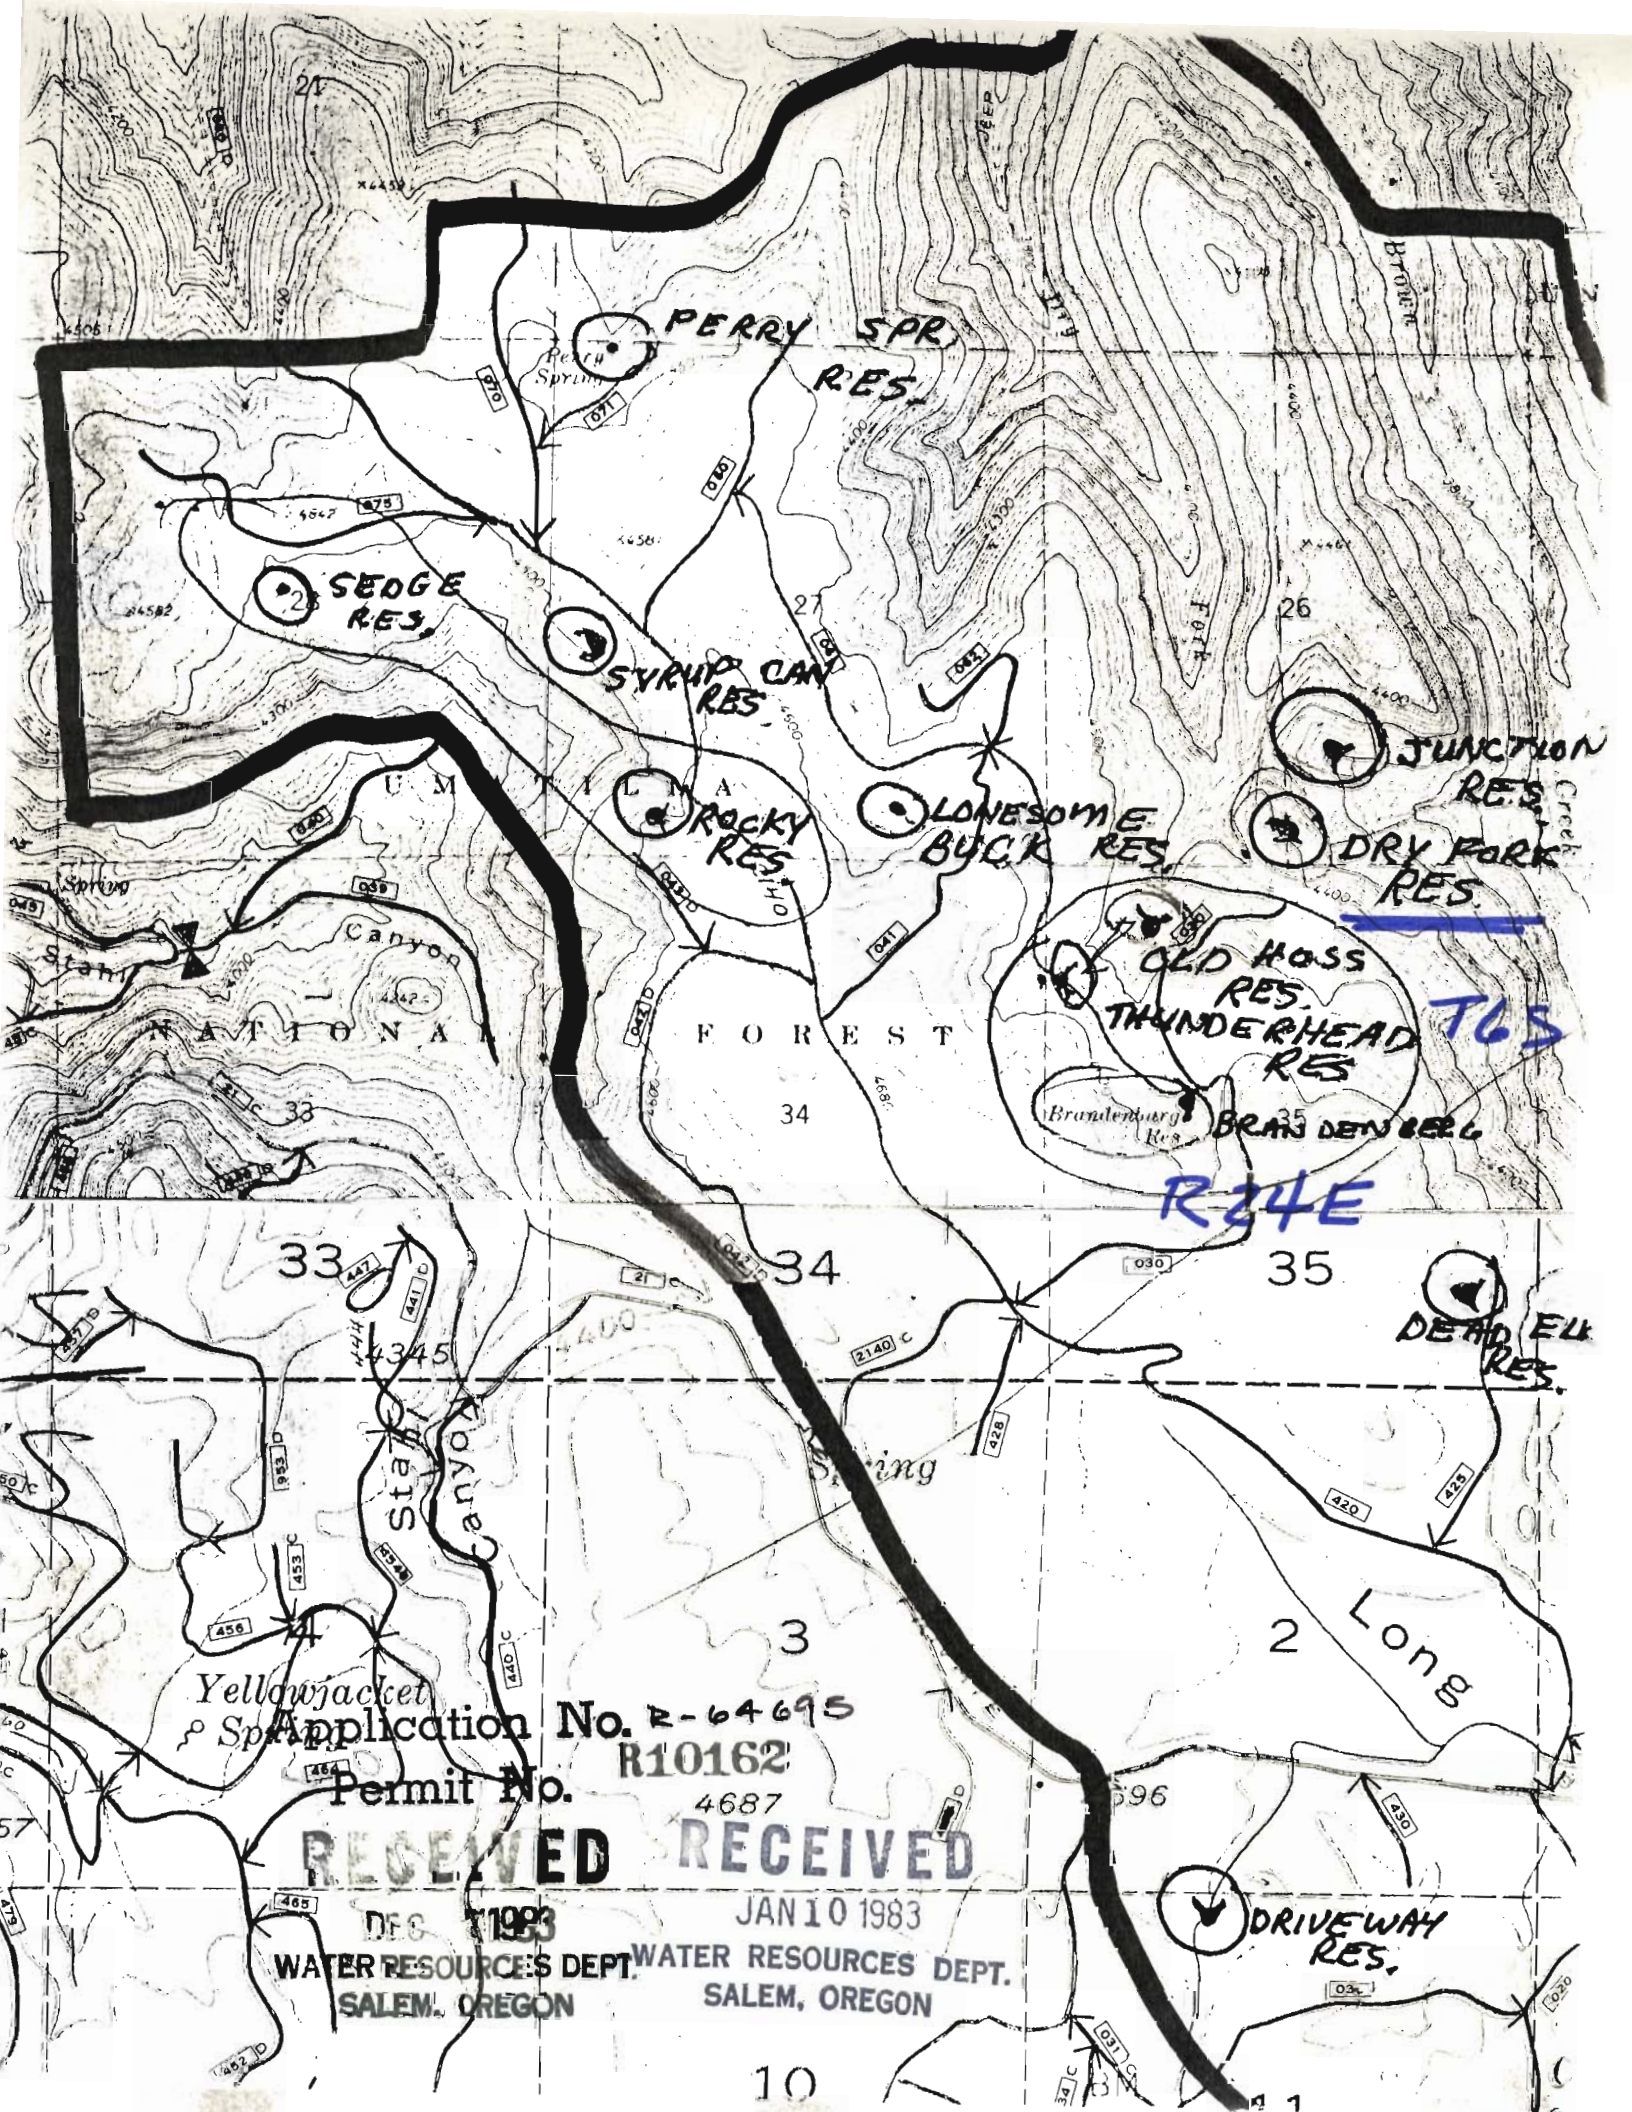

Application No. R-64695
Permit No. R10162
4687

RECEIVED **RECEIVED**
DEC 11 1983 JAN 10 1983
WATER RESOURCES DEPT. WATER RESOURCES DEPT.
SALEM, OREGON SALEM, OREGON

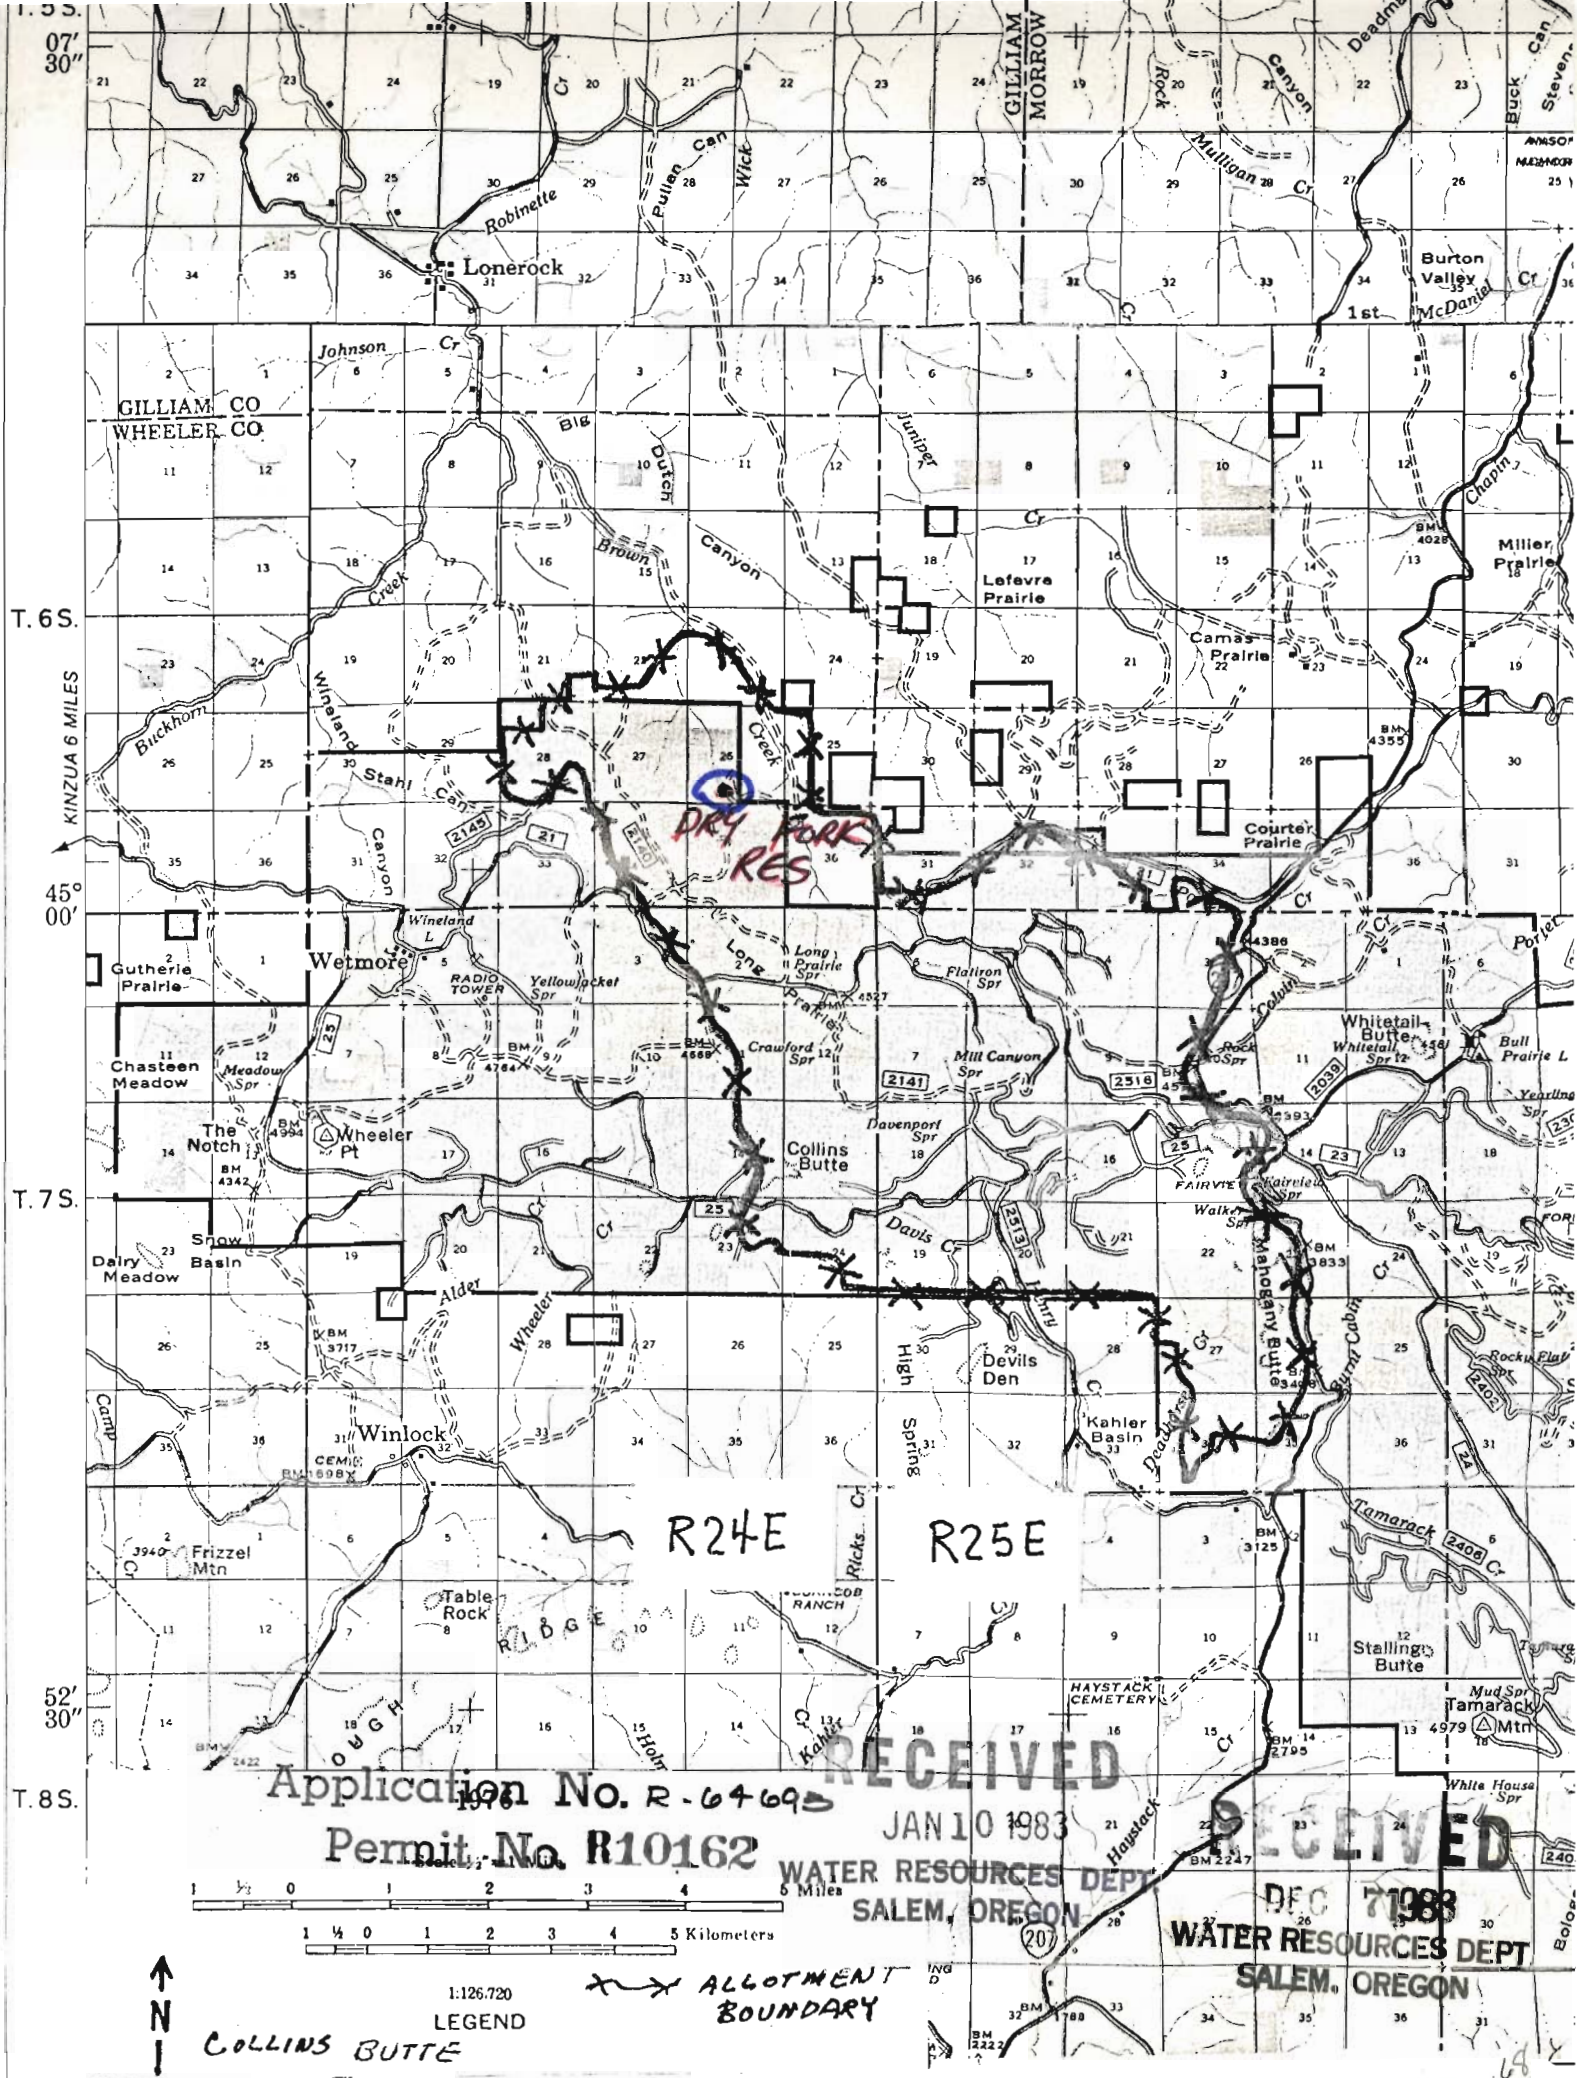

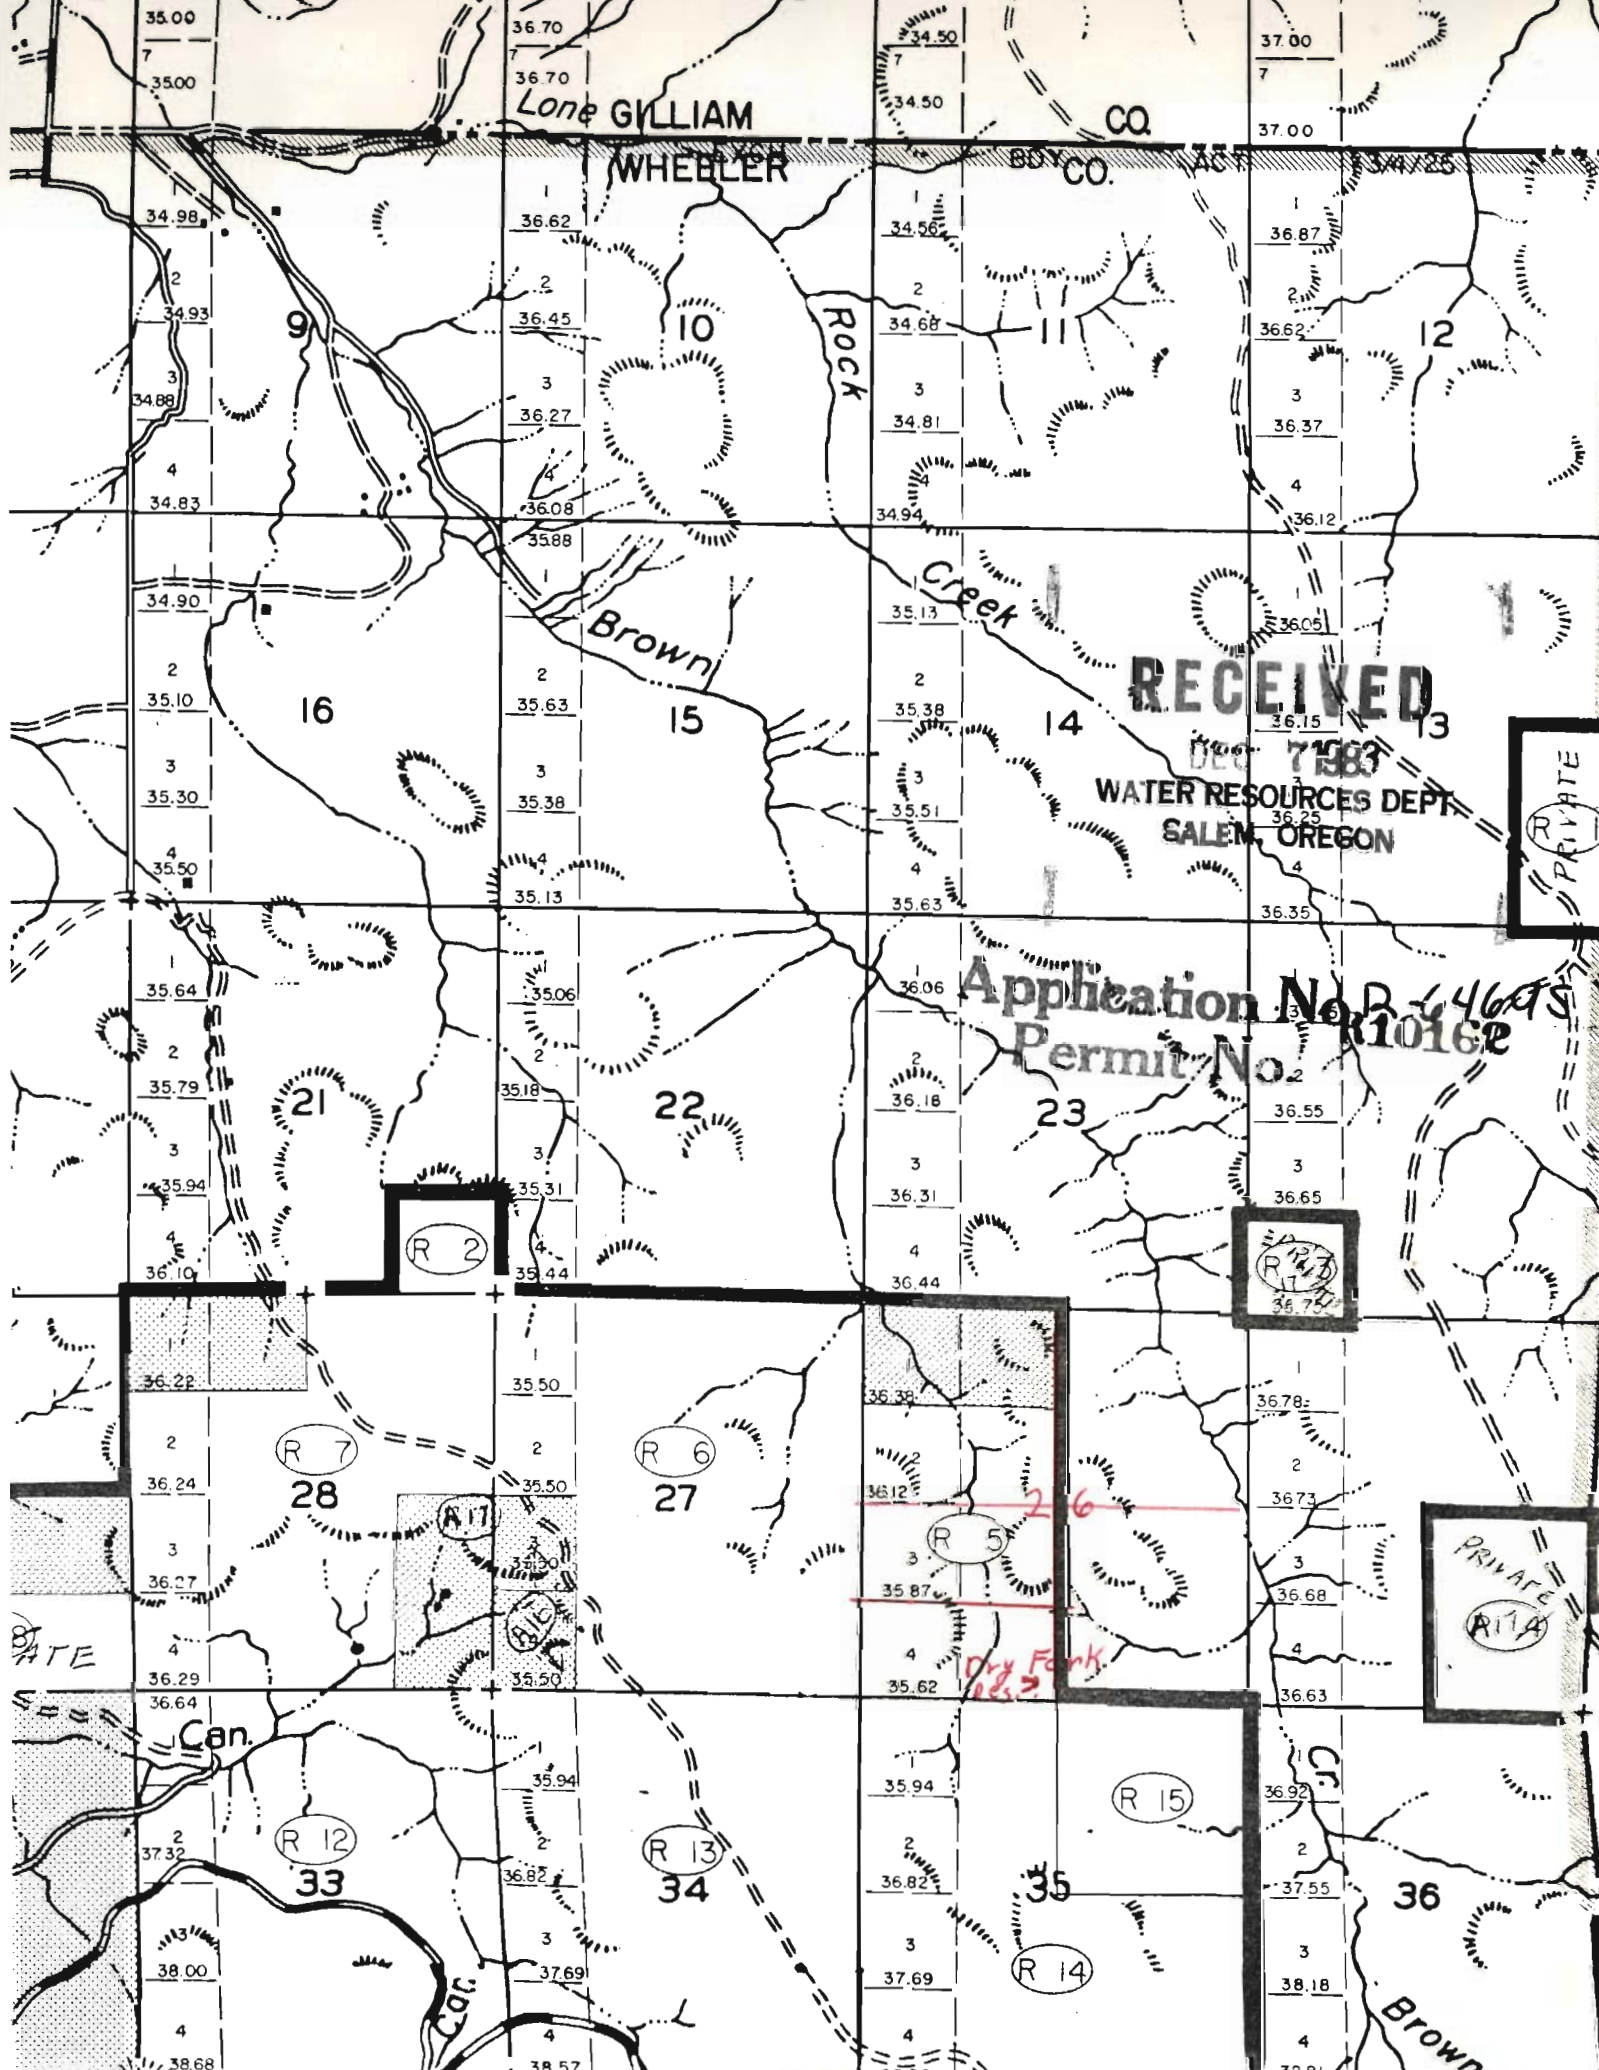

Lone GILLIAM

WHEELER

CO.

CO.

RECEIVED

DEC 7 1983
WATER RESOURCES DEPT
SALEM, OREGON

Application No. R-44695
Permit No. R10162

R 2

R 13

R 7

R 6

R 5

PRIVATE
R1A

R 12

R 13

R 15

R 14

ATE

Can.

Can.

Brown

TOWNSHIP 6S, RANGE 24E, SECTION 26, W.M.

27

26

← 2344 →
2320
40' 293'

34

35

RECEIVED

DEC 7 1983

WATER RESOURCES DEPT.

SALEM, OREGON

RECEIVED

JAN 10 1983

WATER RESOURCES DEPT.
SALEM, OREGON

NAME DRY FORK RES.

COUNTY WHEELER

Application No. R-64695

Permit No. R10162

9