


RECEIVED


DEC 27 1983

WATER RESOURCES DEPT.
SALEM, OREGON

Application No. R-64696
Permit No. R10163

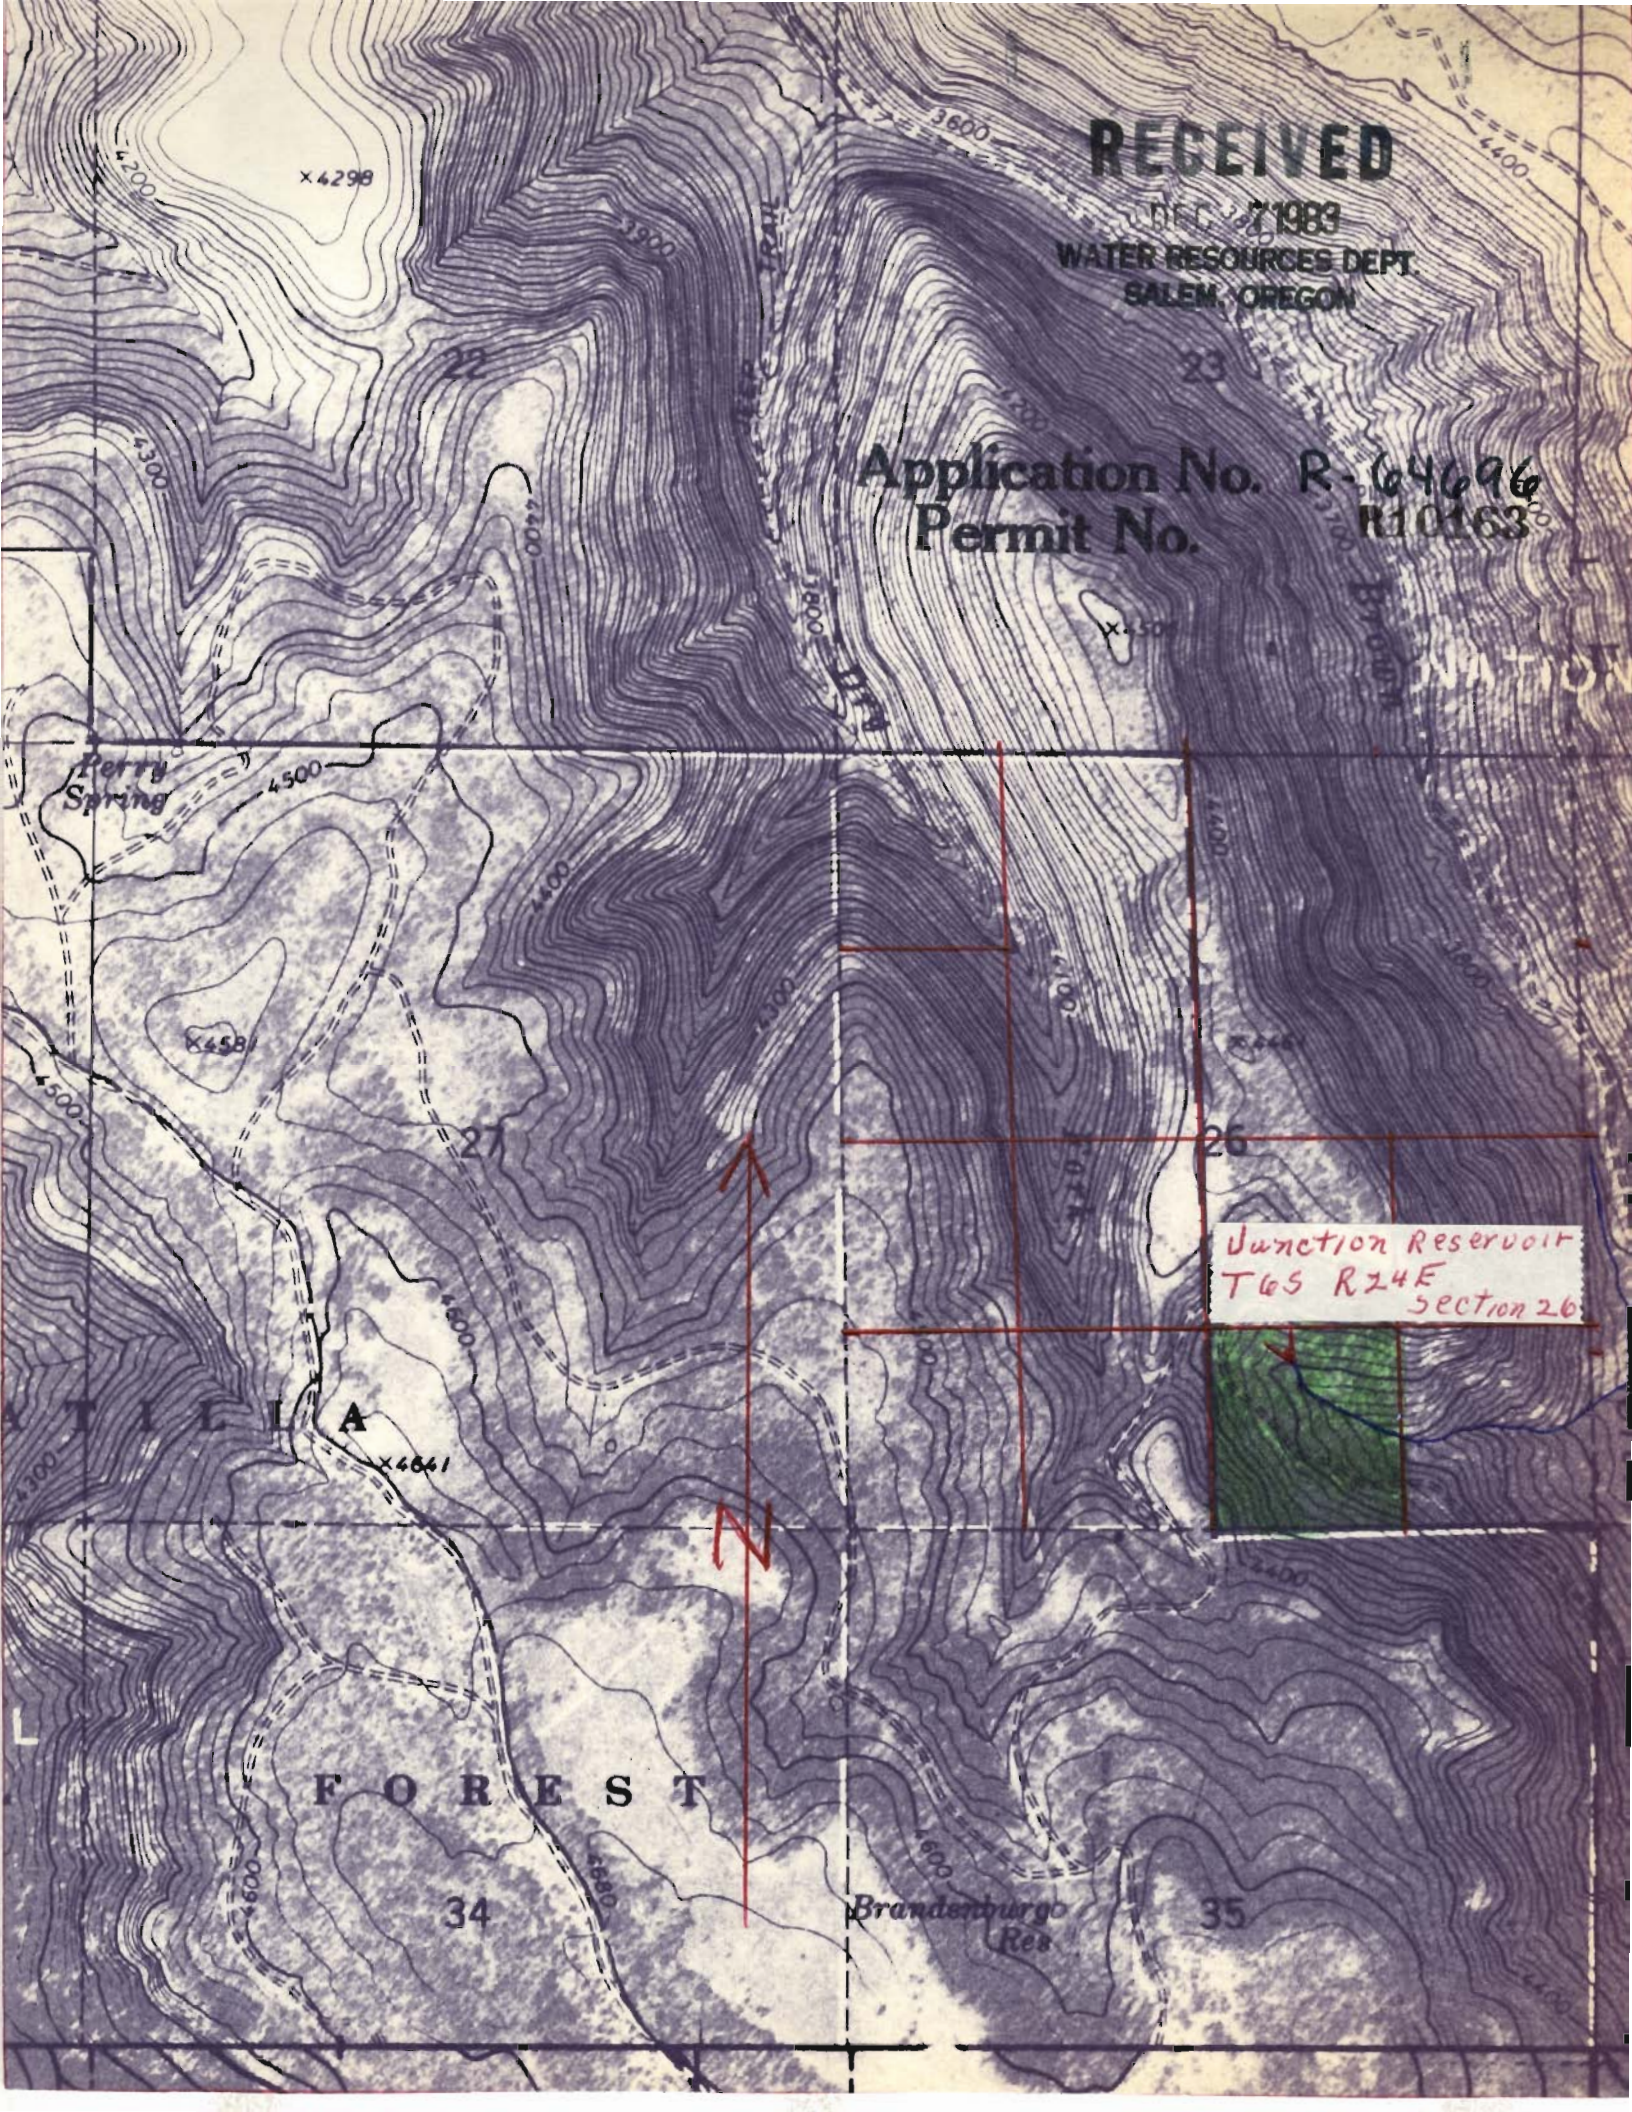

Junction Reservoir
T6S R24E
Section 26

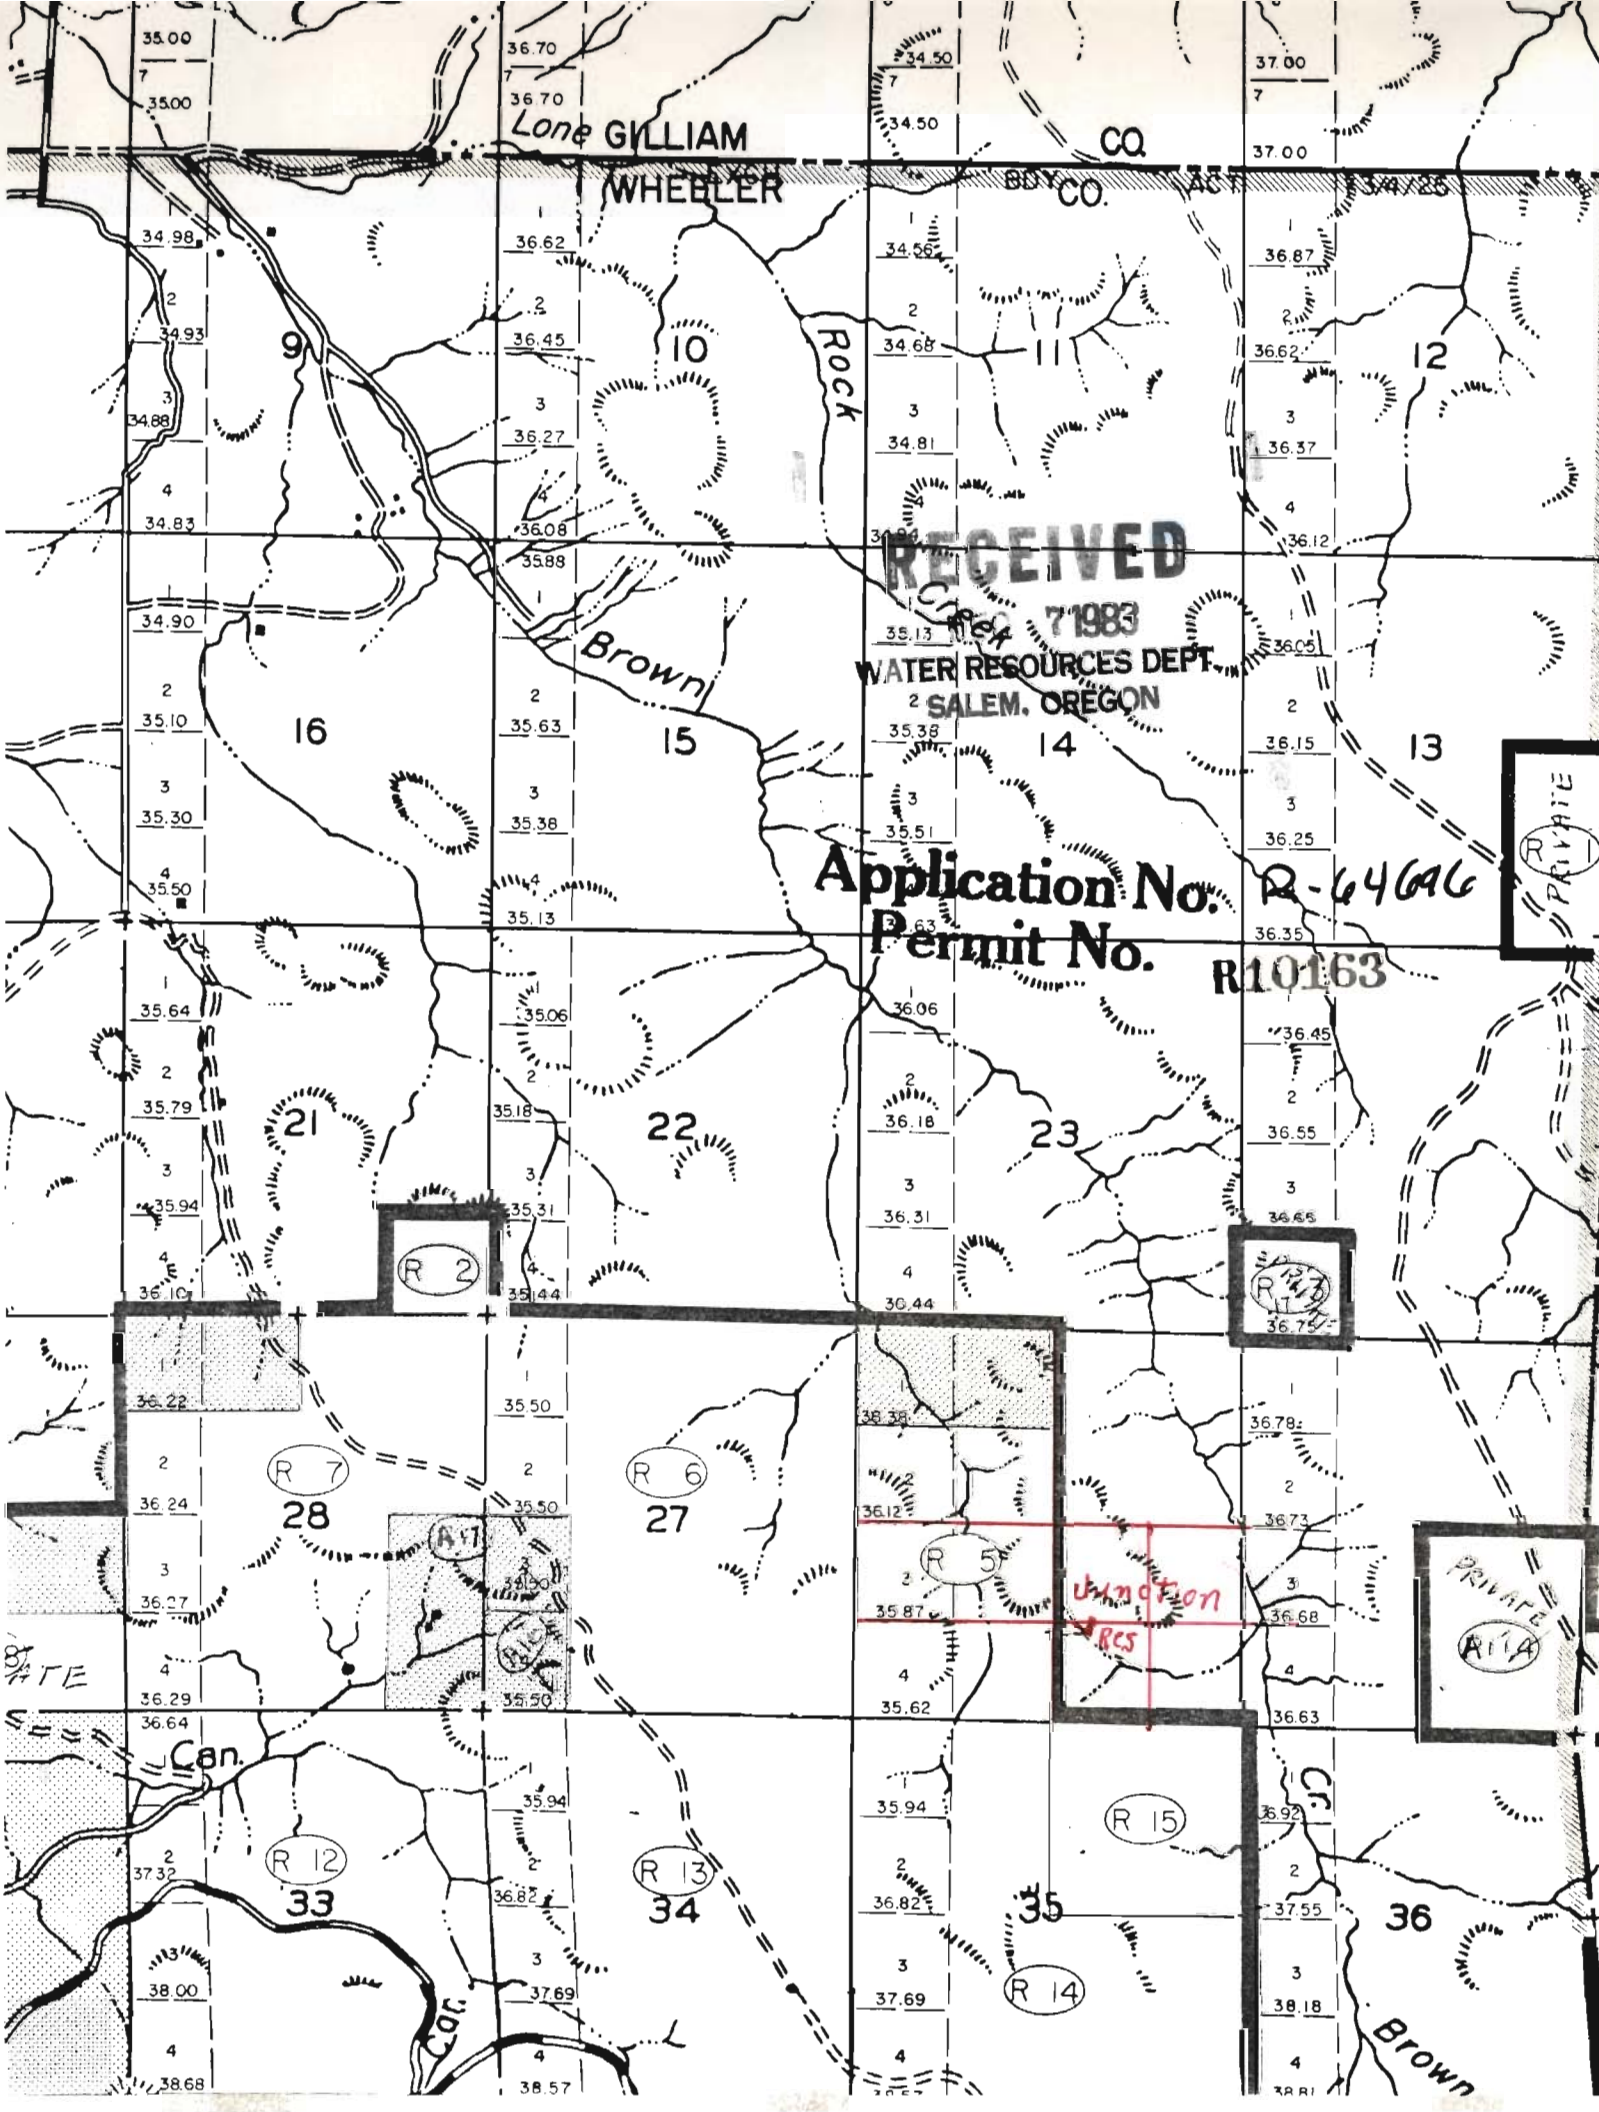

Lone GILLIAM

WHEELER

CQ

CO.

RECEIVED


WATER RESOURCES DEPT.
SALEM, OREGON

Application No. R-64696
Permit No. R10163

PRIVATE


PRIVATE

undr. on
RES

STATE

Can.

Brown


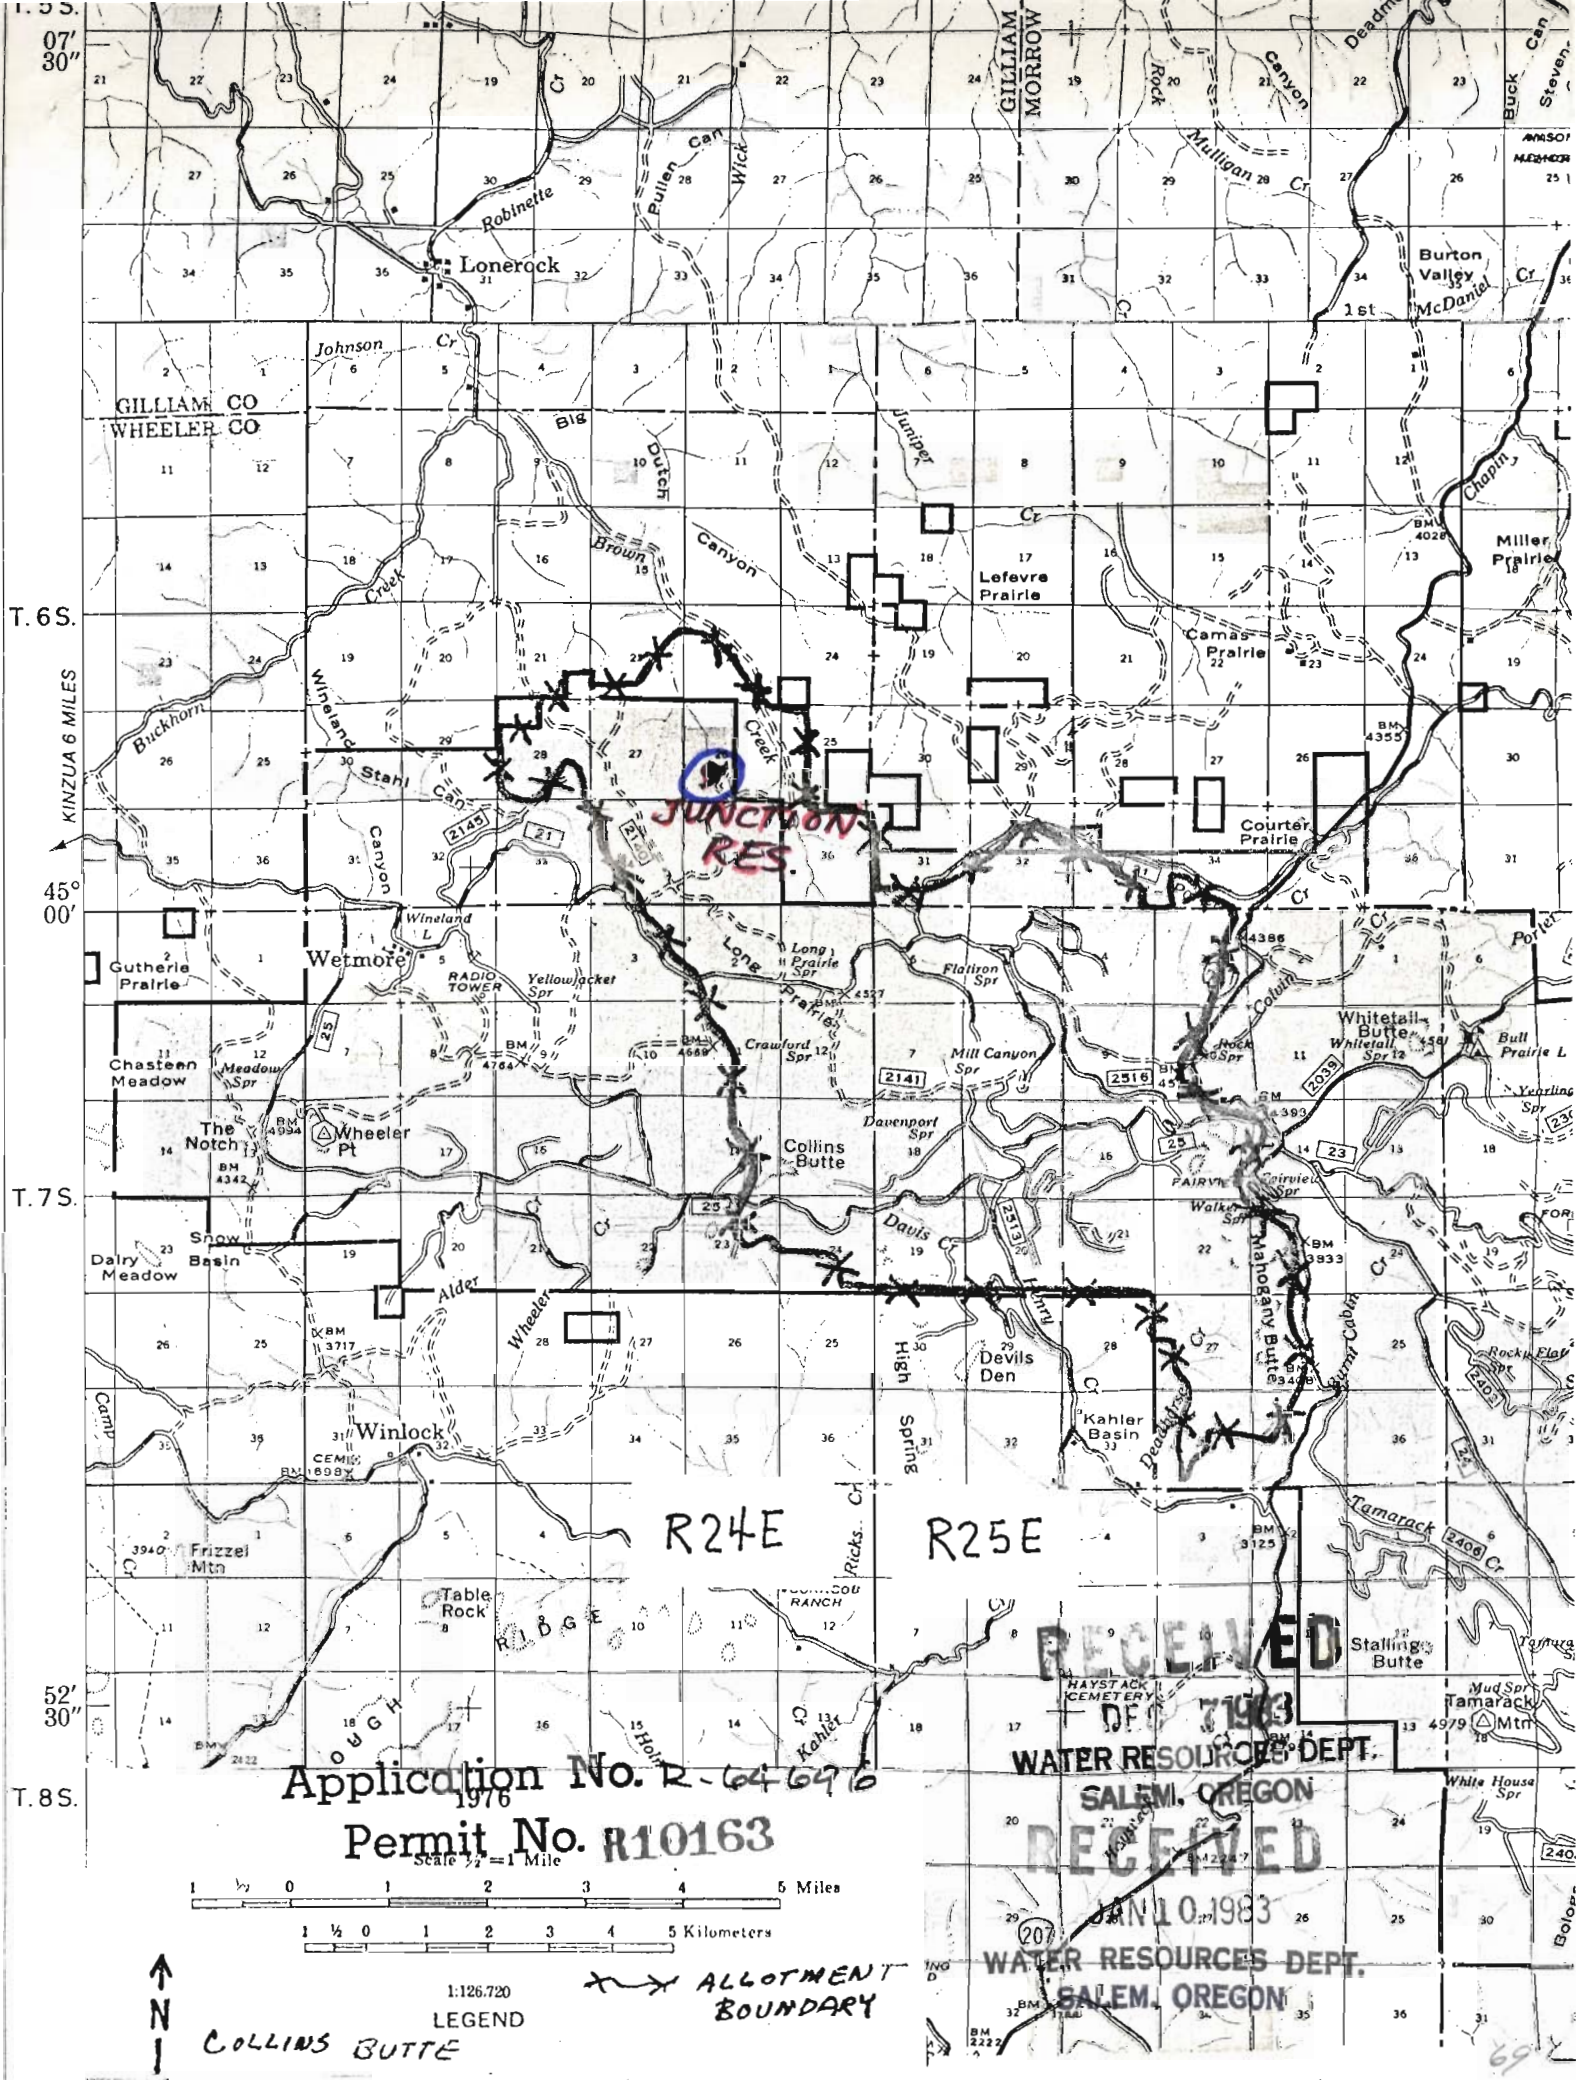


GILLIAM CO
WHEELER CO

R24E

R25E

Application No. R-64696
Permit No. R10163
Scale 1" = 1 Mile
1:126,720

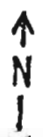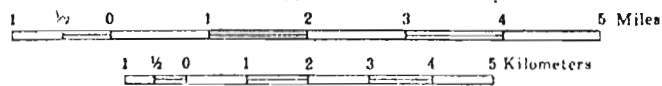

LEGEND

ALLOTMENT BOUNDARY

COLLINS BUTTE

RECEIVED



WATER RESOURCES DEPT.

SALEM, OREGON


RECEIVED

JAN 10 1983

WATER RESOURCES DEPT.
SALEM, OREGON

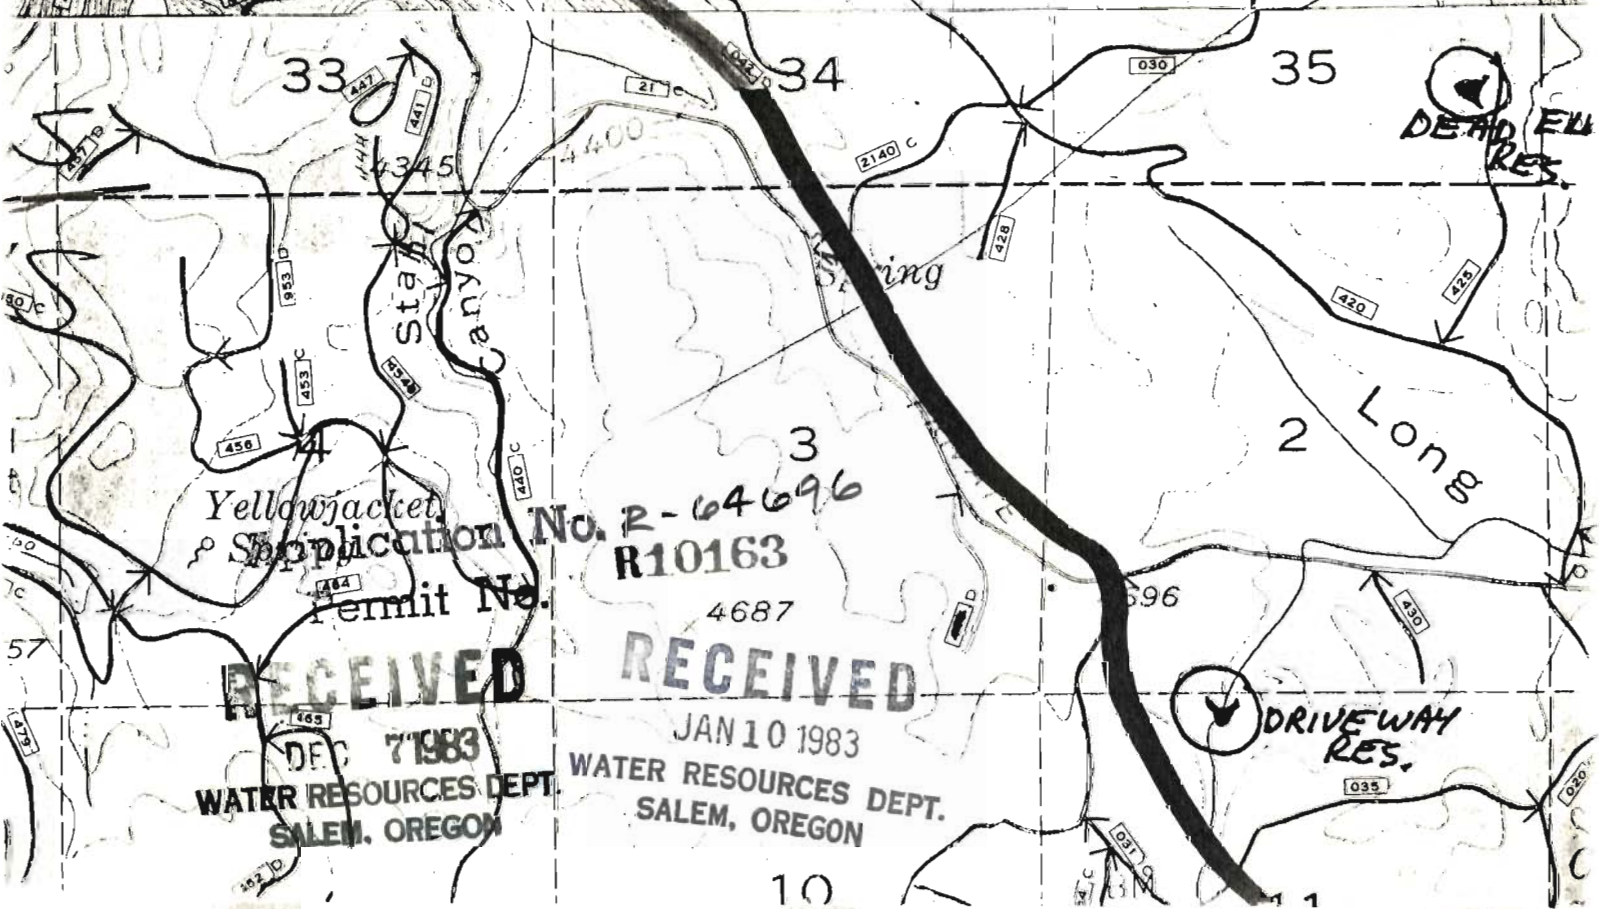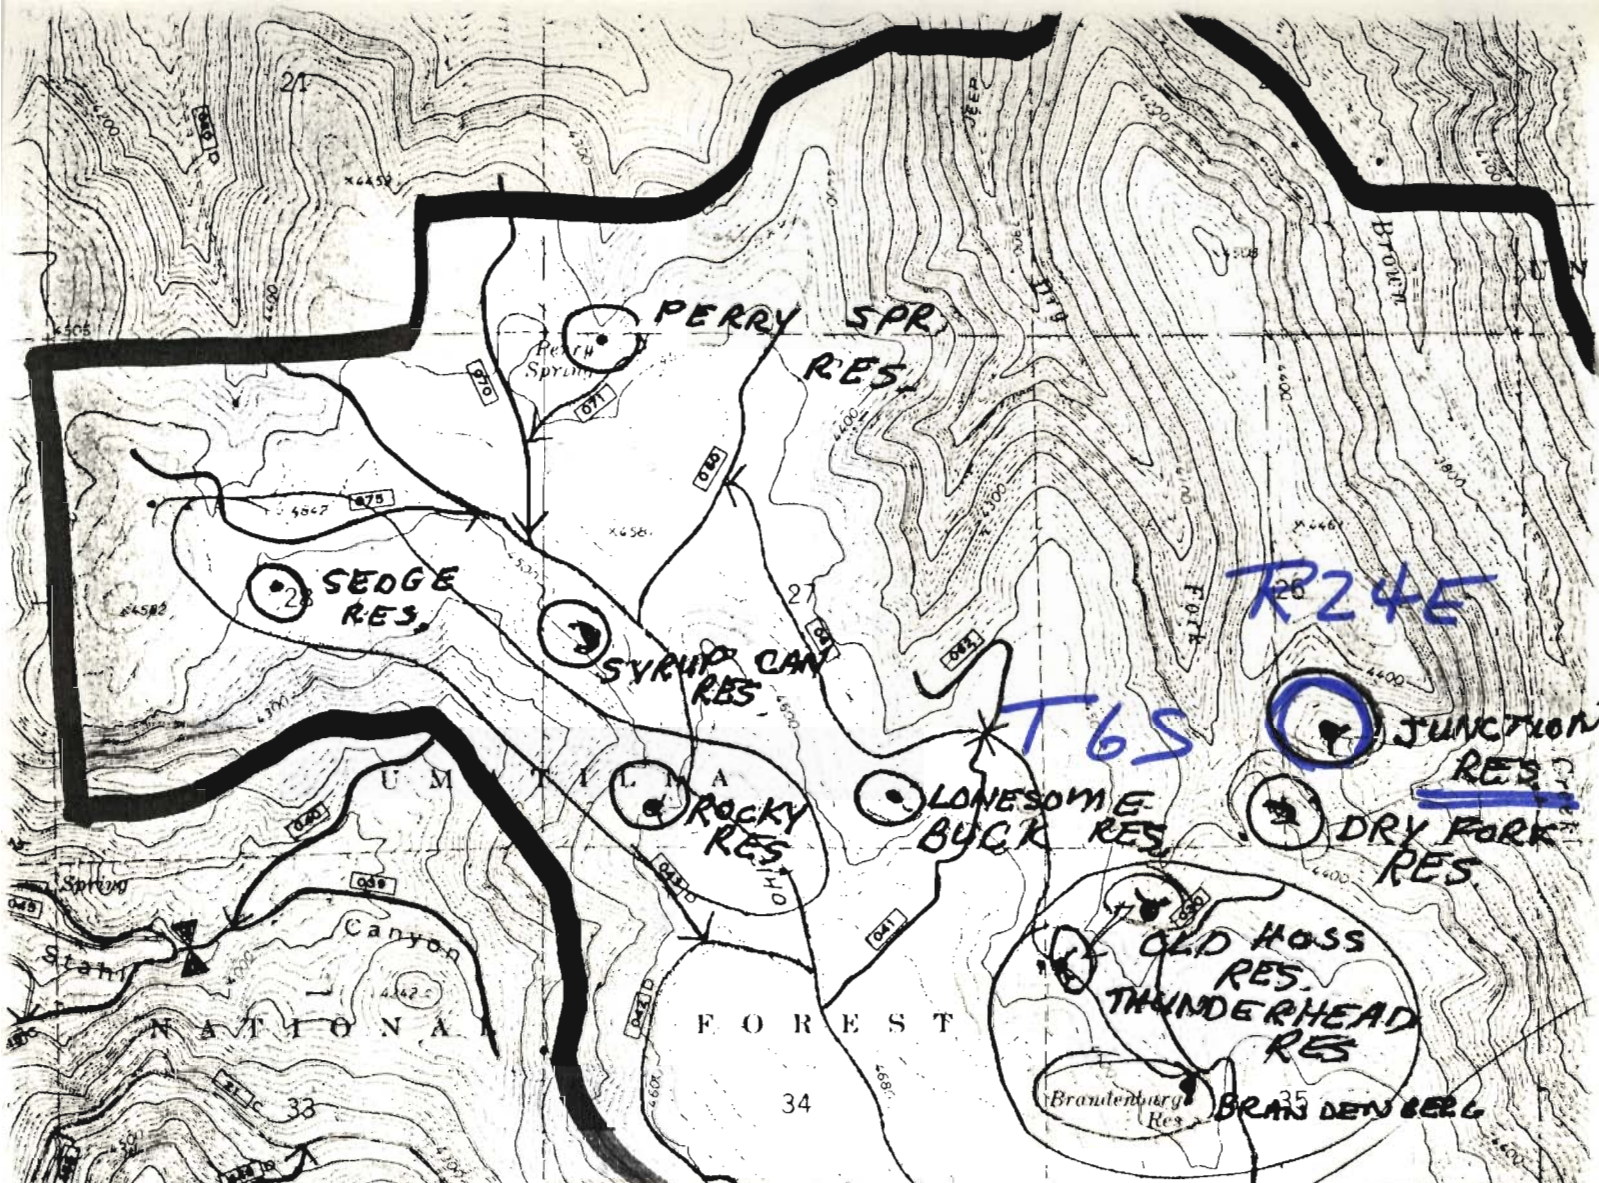

TOWNSHIP 65, RANGE 24E, SECTION 26, W.M.

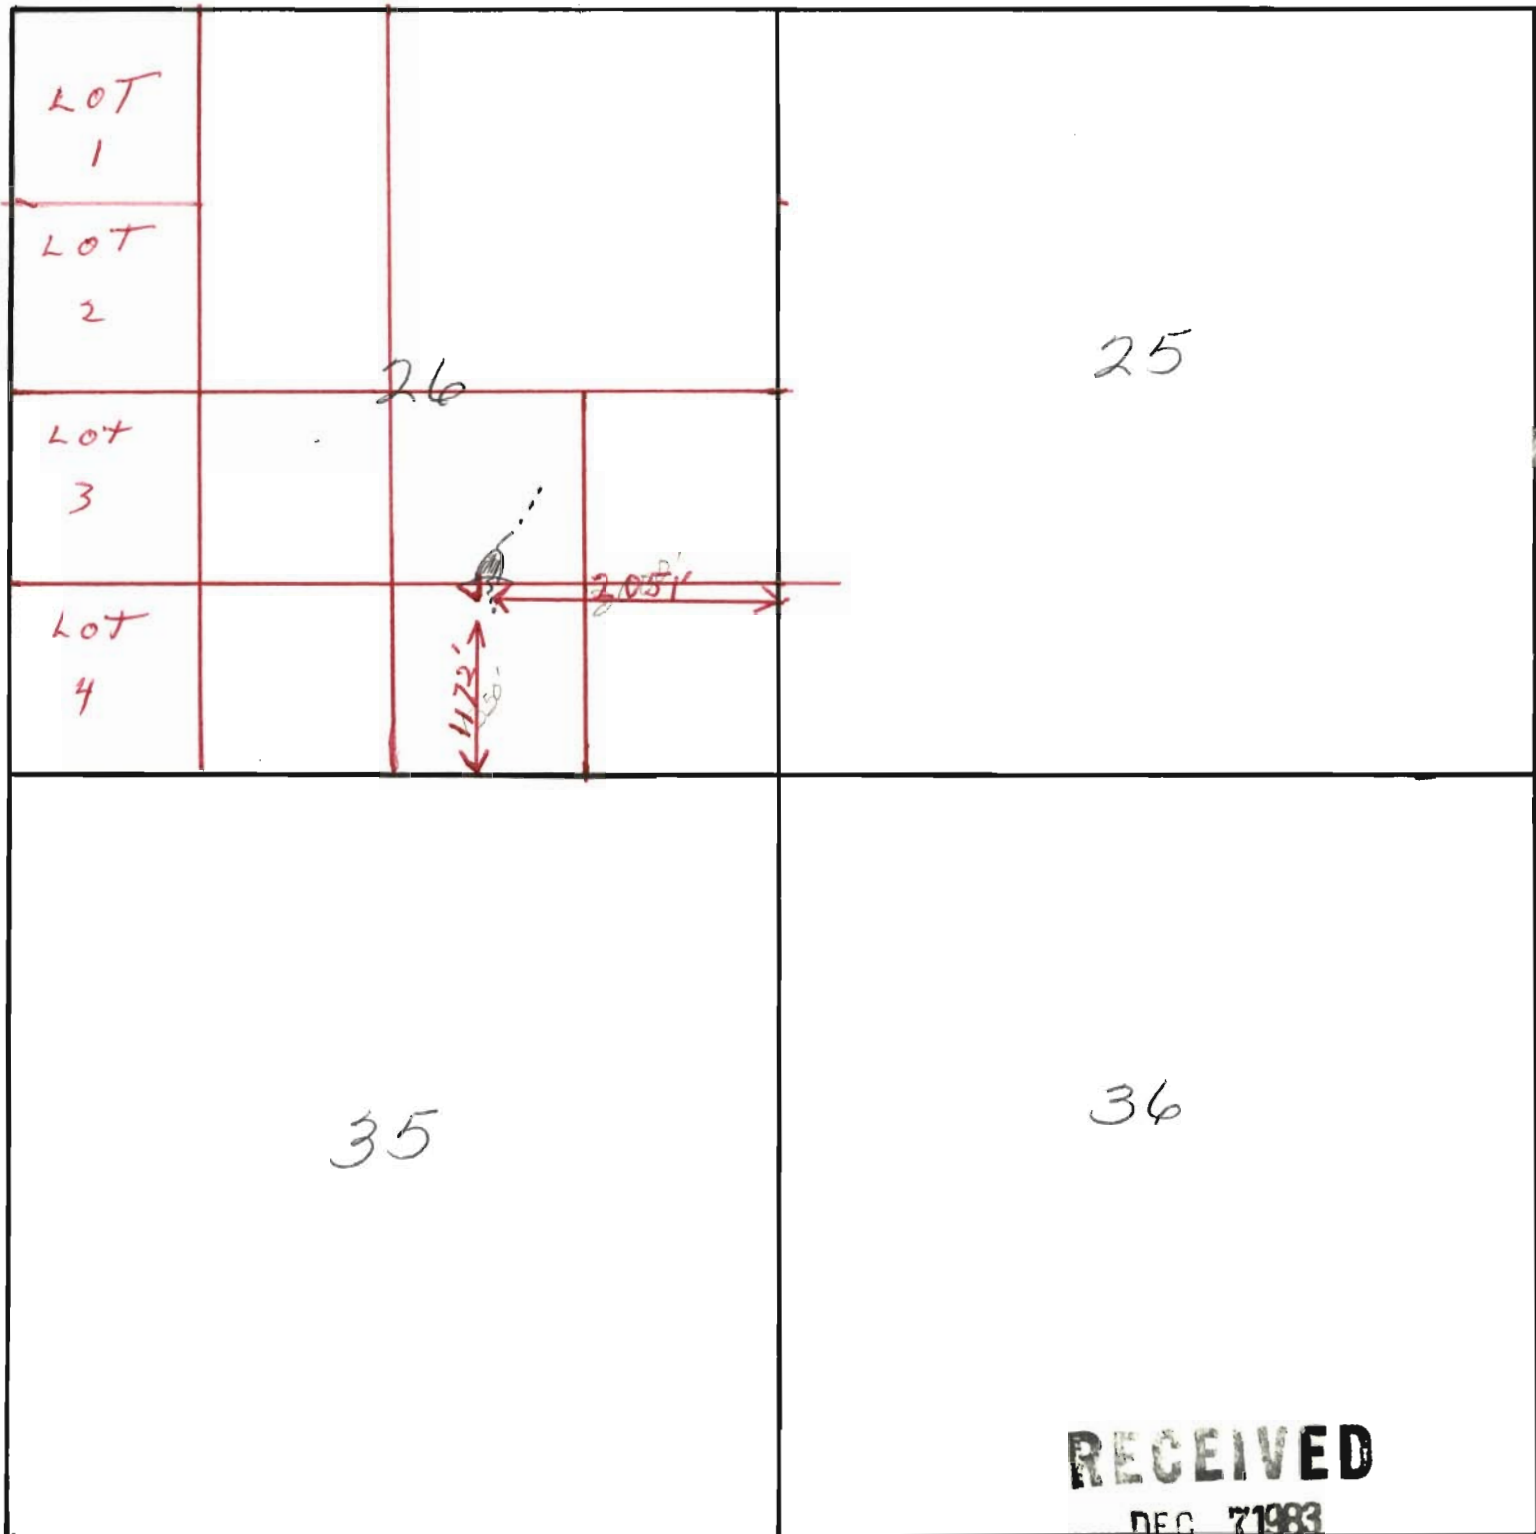NAME JUNCTION RES.

COUNTY WHEELER

Application No. R-64696

Permit No. R10163

10

**WATER RESOURCES DEPT.
SALEM, OREGON**

RECEIVED

JAN 10 1983

WATER RESOURCES DEPT.
SALEM, OREGON