


Basket Butte Road Res.
T 8S R 26E section 3

Bell spr. Trough & pond
T85 R24E section 3

PAID
JUN 1983
WATER RESOURCES DEPT
SALEM, OREGON

Application No. R-64710
Permit No. B10165

C C C Spr

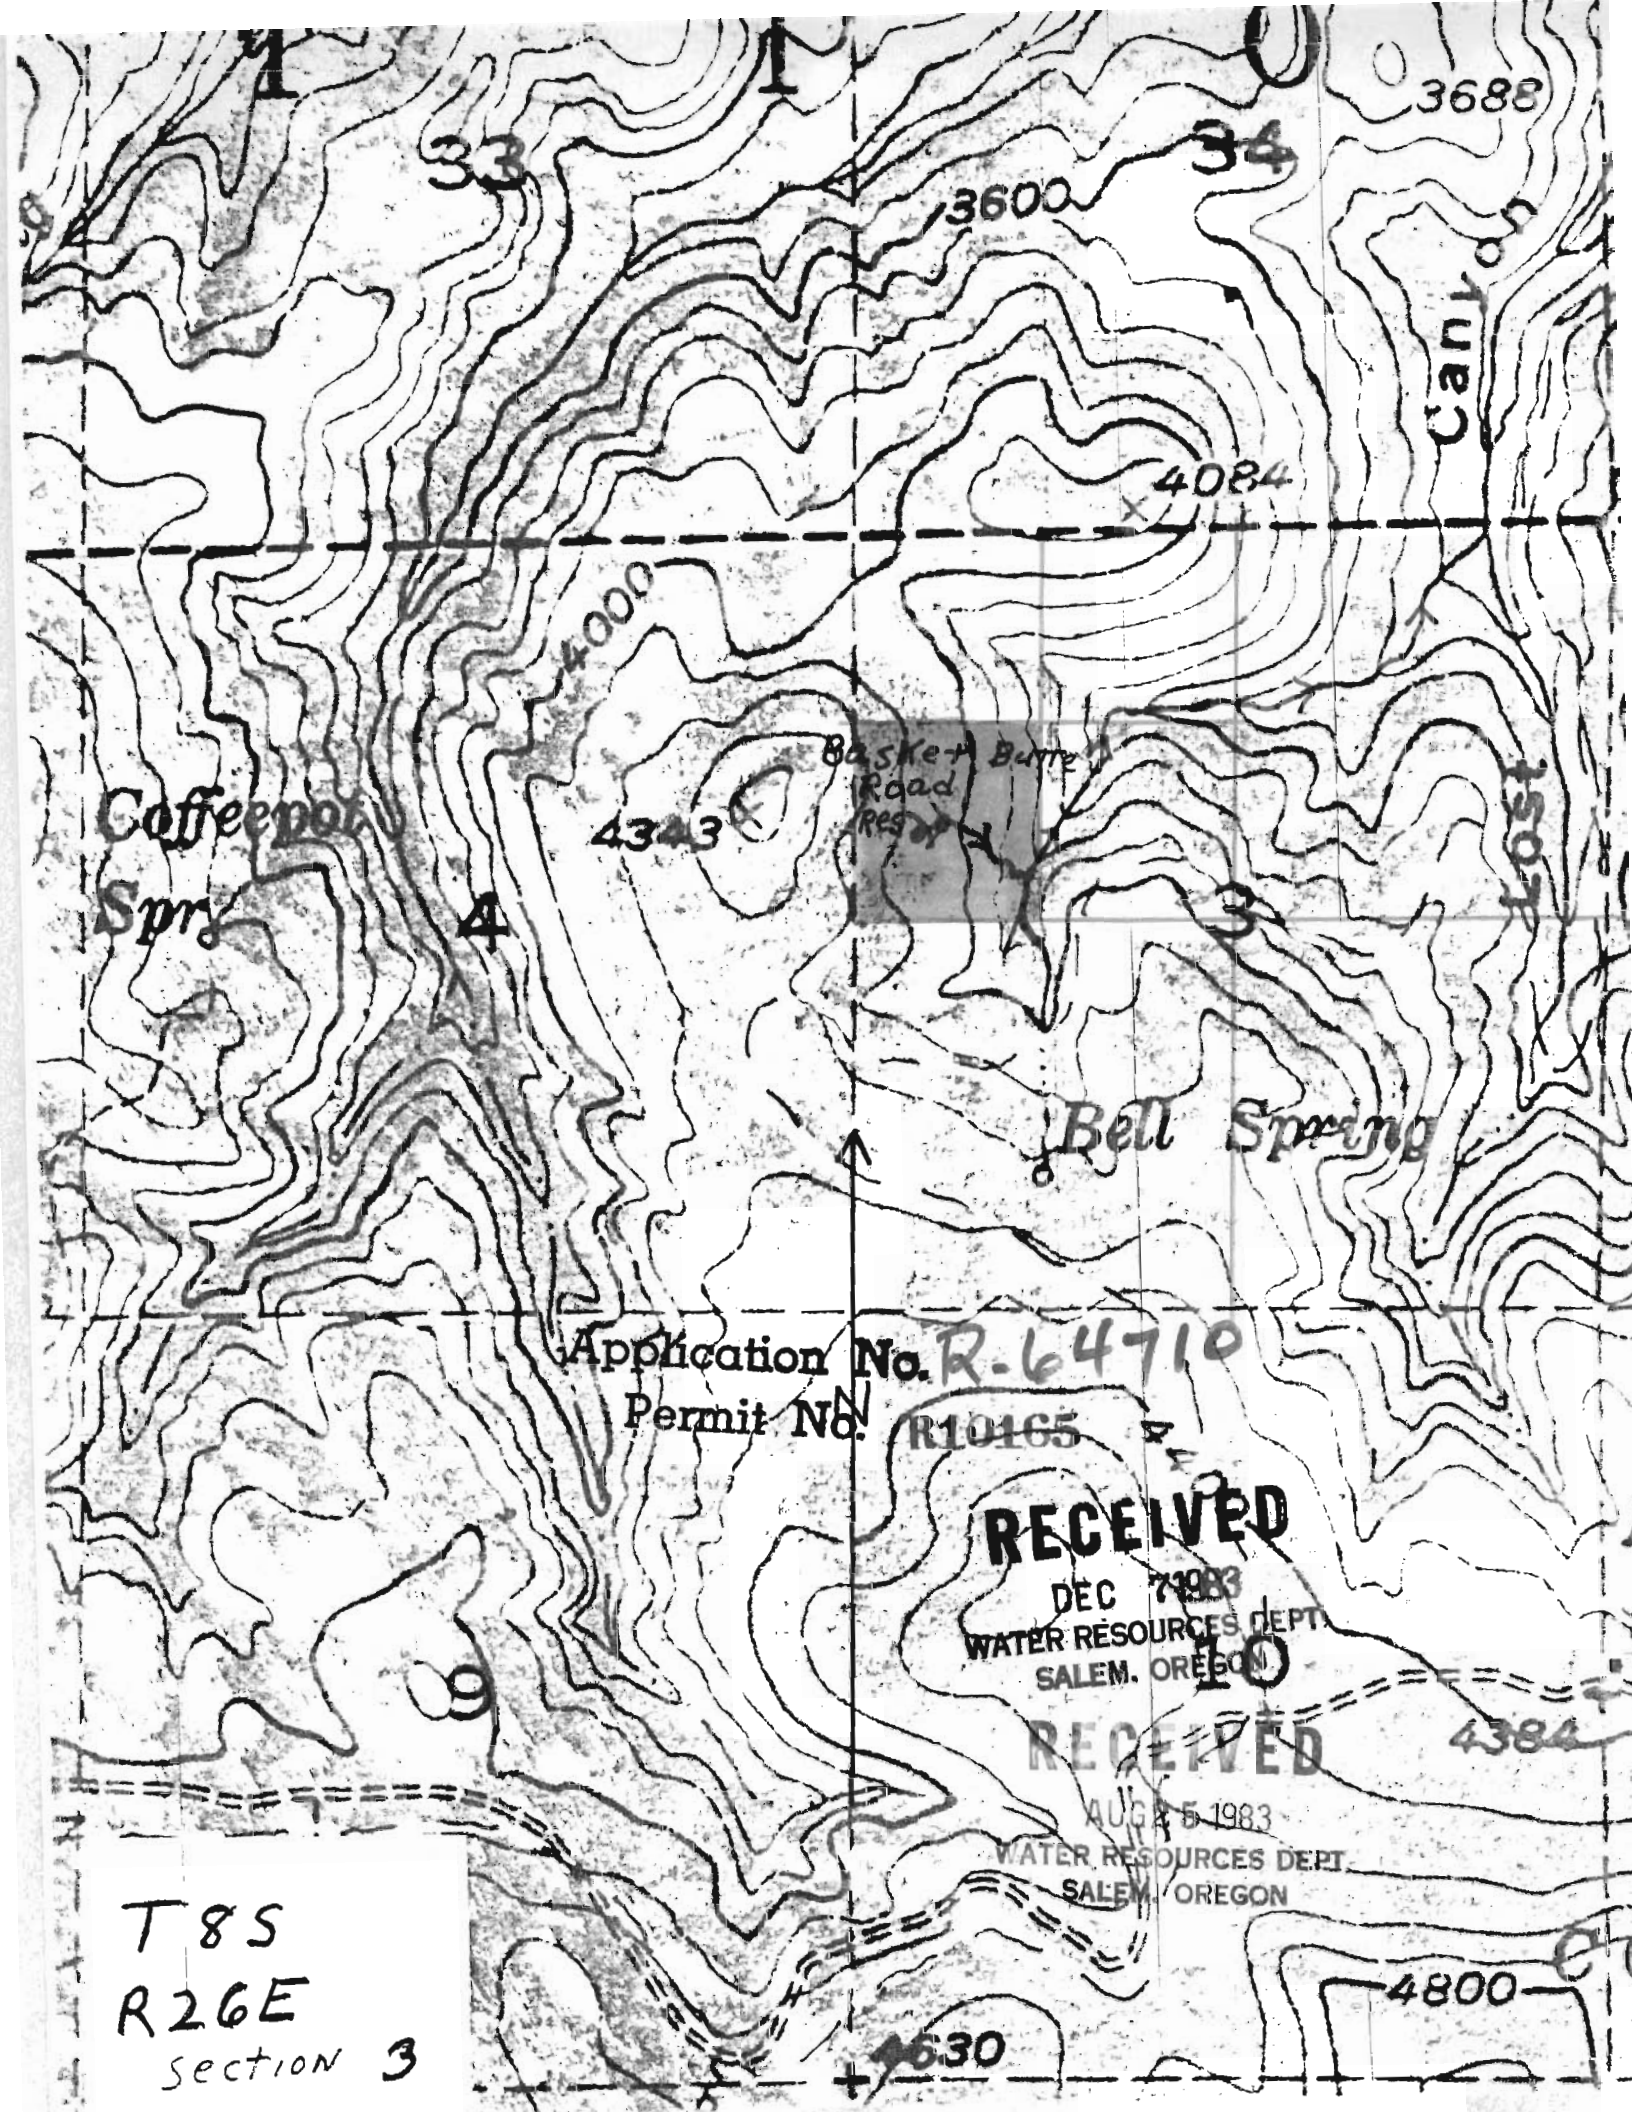


Application No. R-64710
Permit No. R10165

RECEIVED
DEC 7 1983
WATER RESOURCES DEPT.
SALEM, OREGON

RECEIVED
AUG 5 1983
WATER RESOURCES DEPT.
SALEM, OREGON

T8S
R26E
Section 3

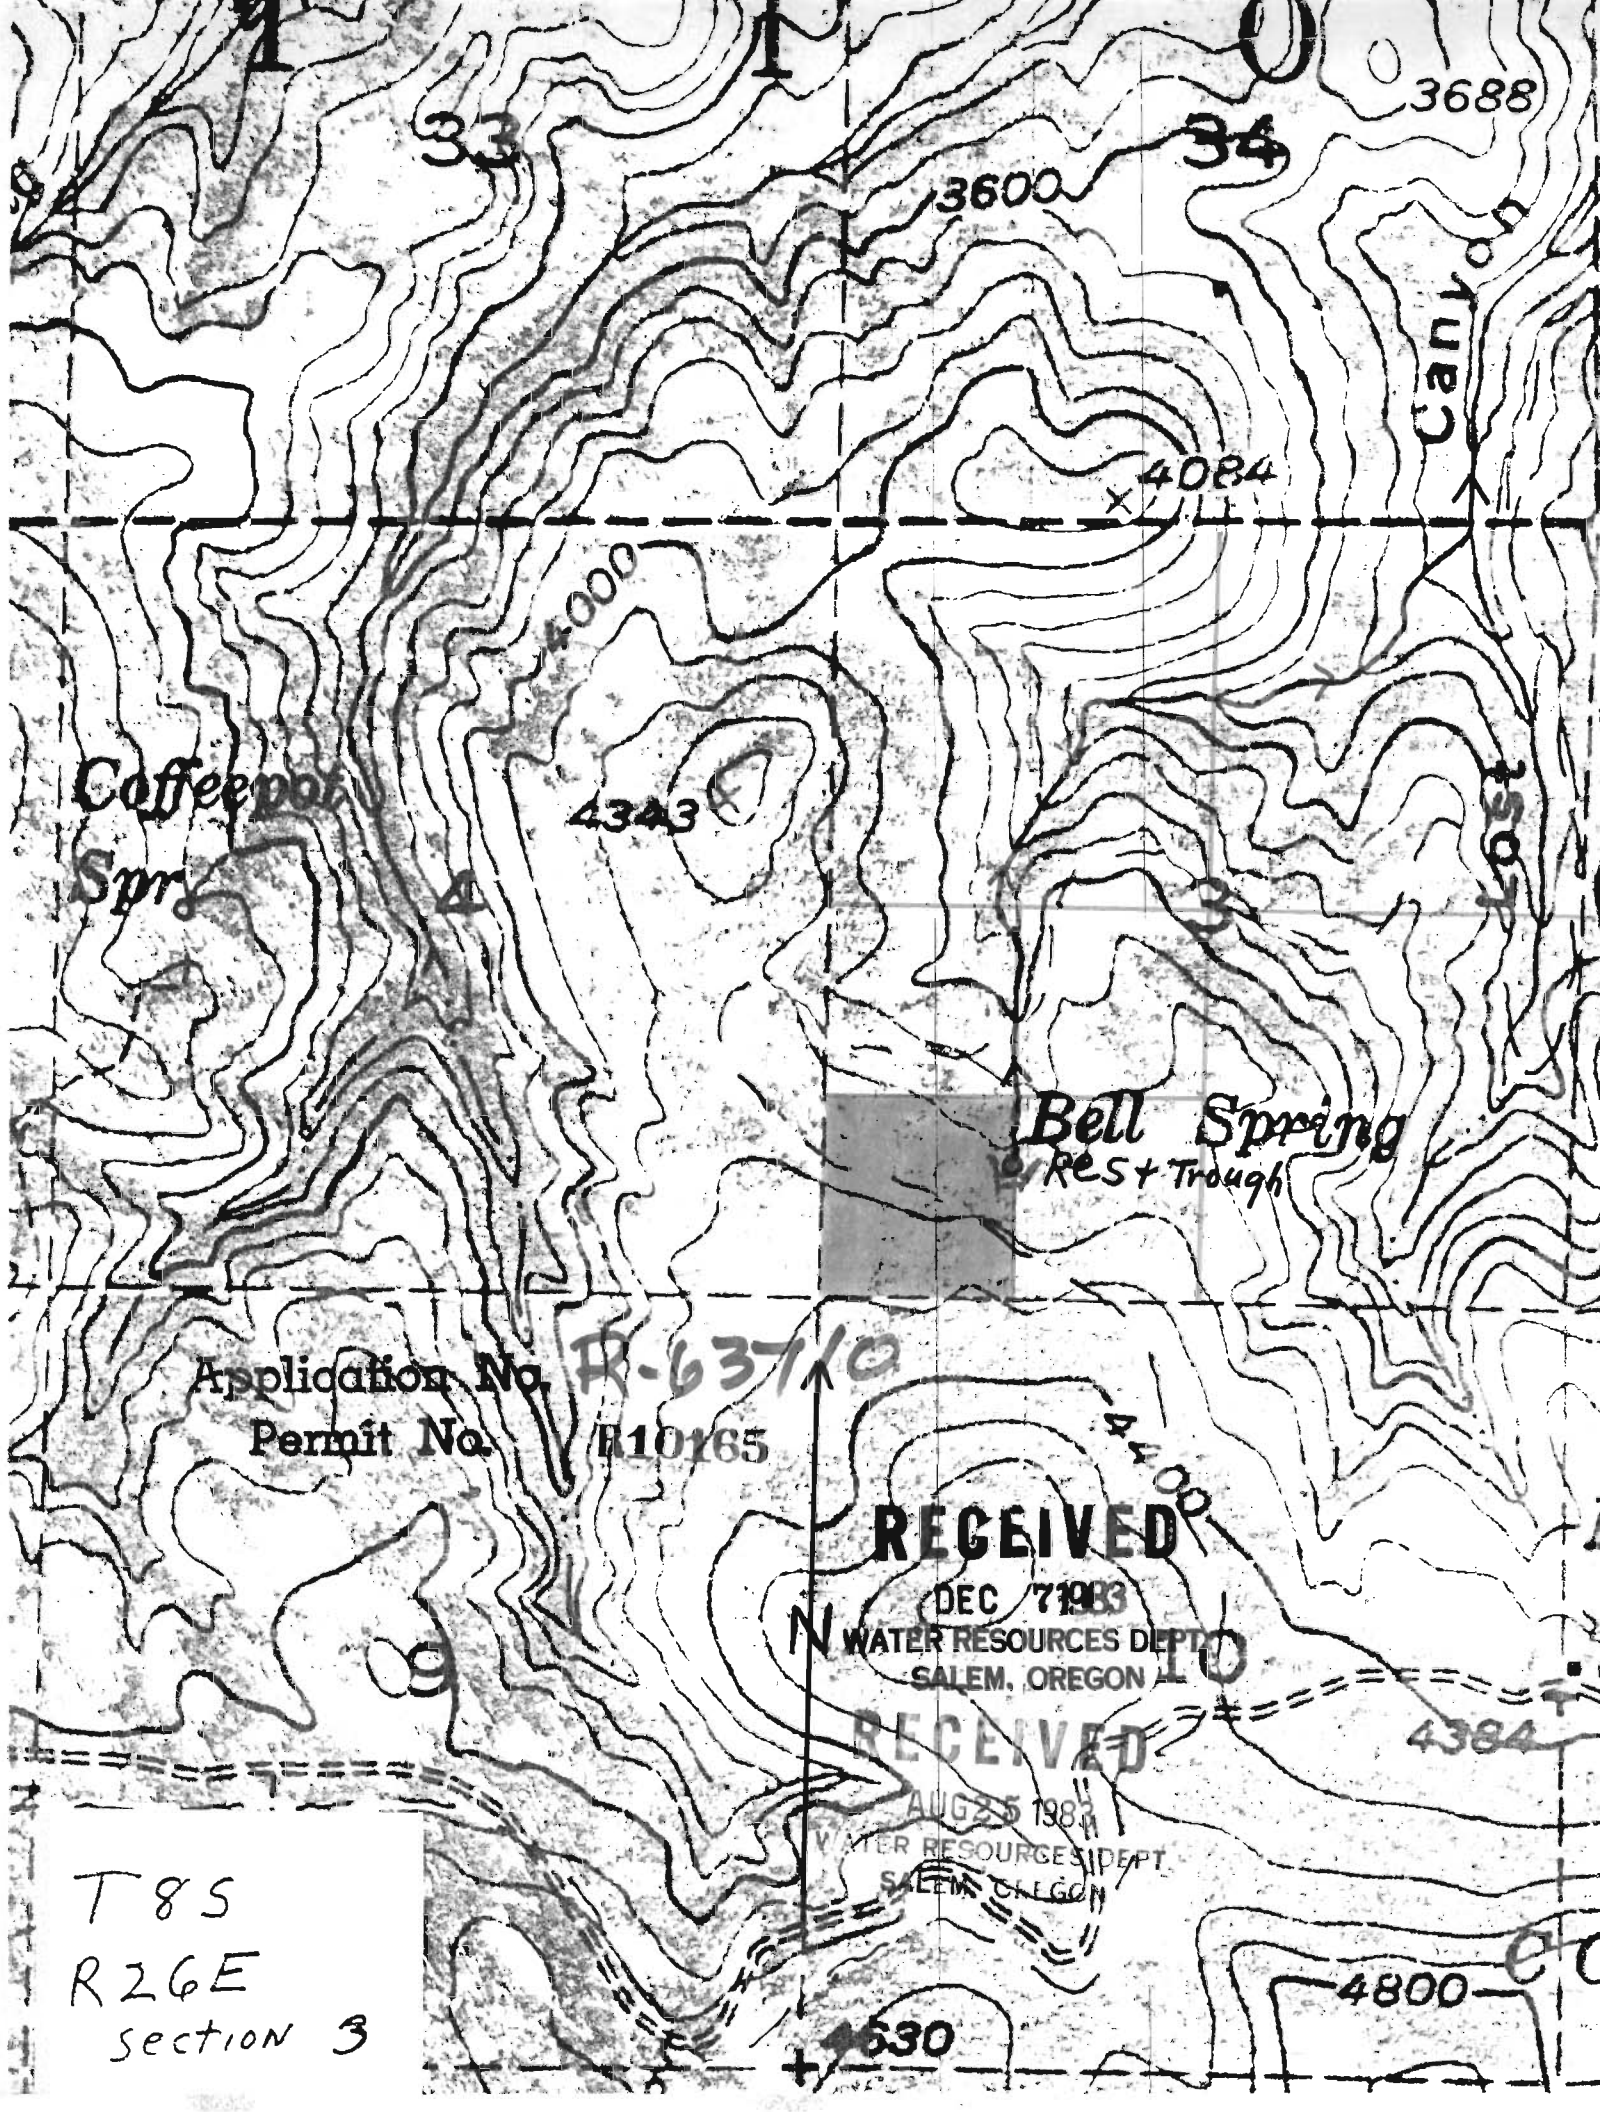

Coffeepot
Spry

Bell Spring
RES + Trough

Application No. R-63710
Permit No. R10165

RECEIVED

DEC 7 1983

WATER RESOURCES DEPT
SALEM, OREGON

RECEIVED


AUG 25 1983

WATER RESOURCES DEPT
SALEM, OREGON

T85
R26E
section 3

5630

4800

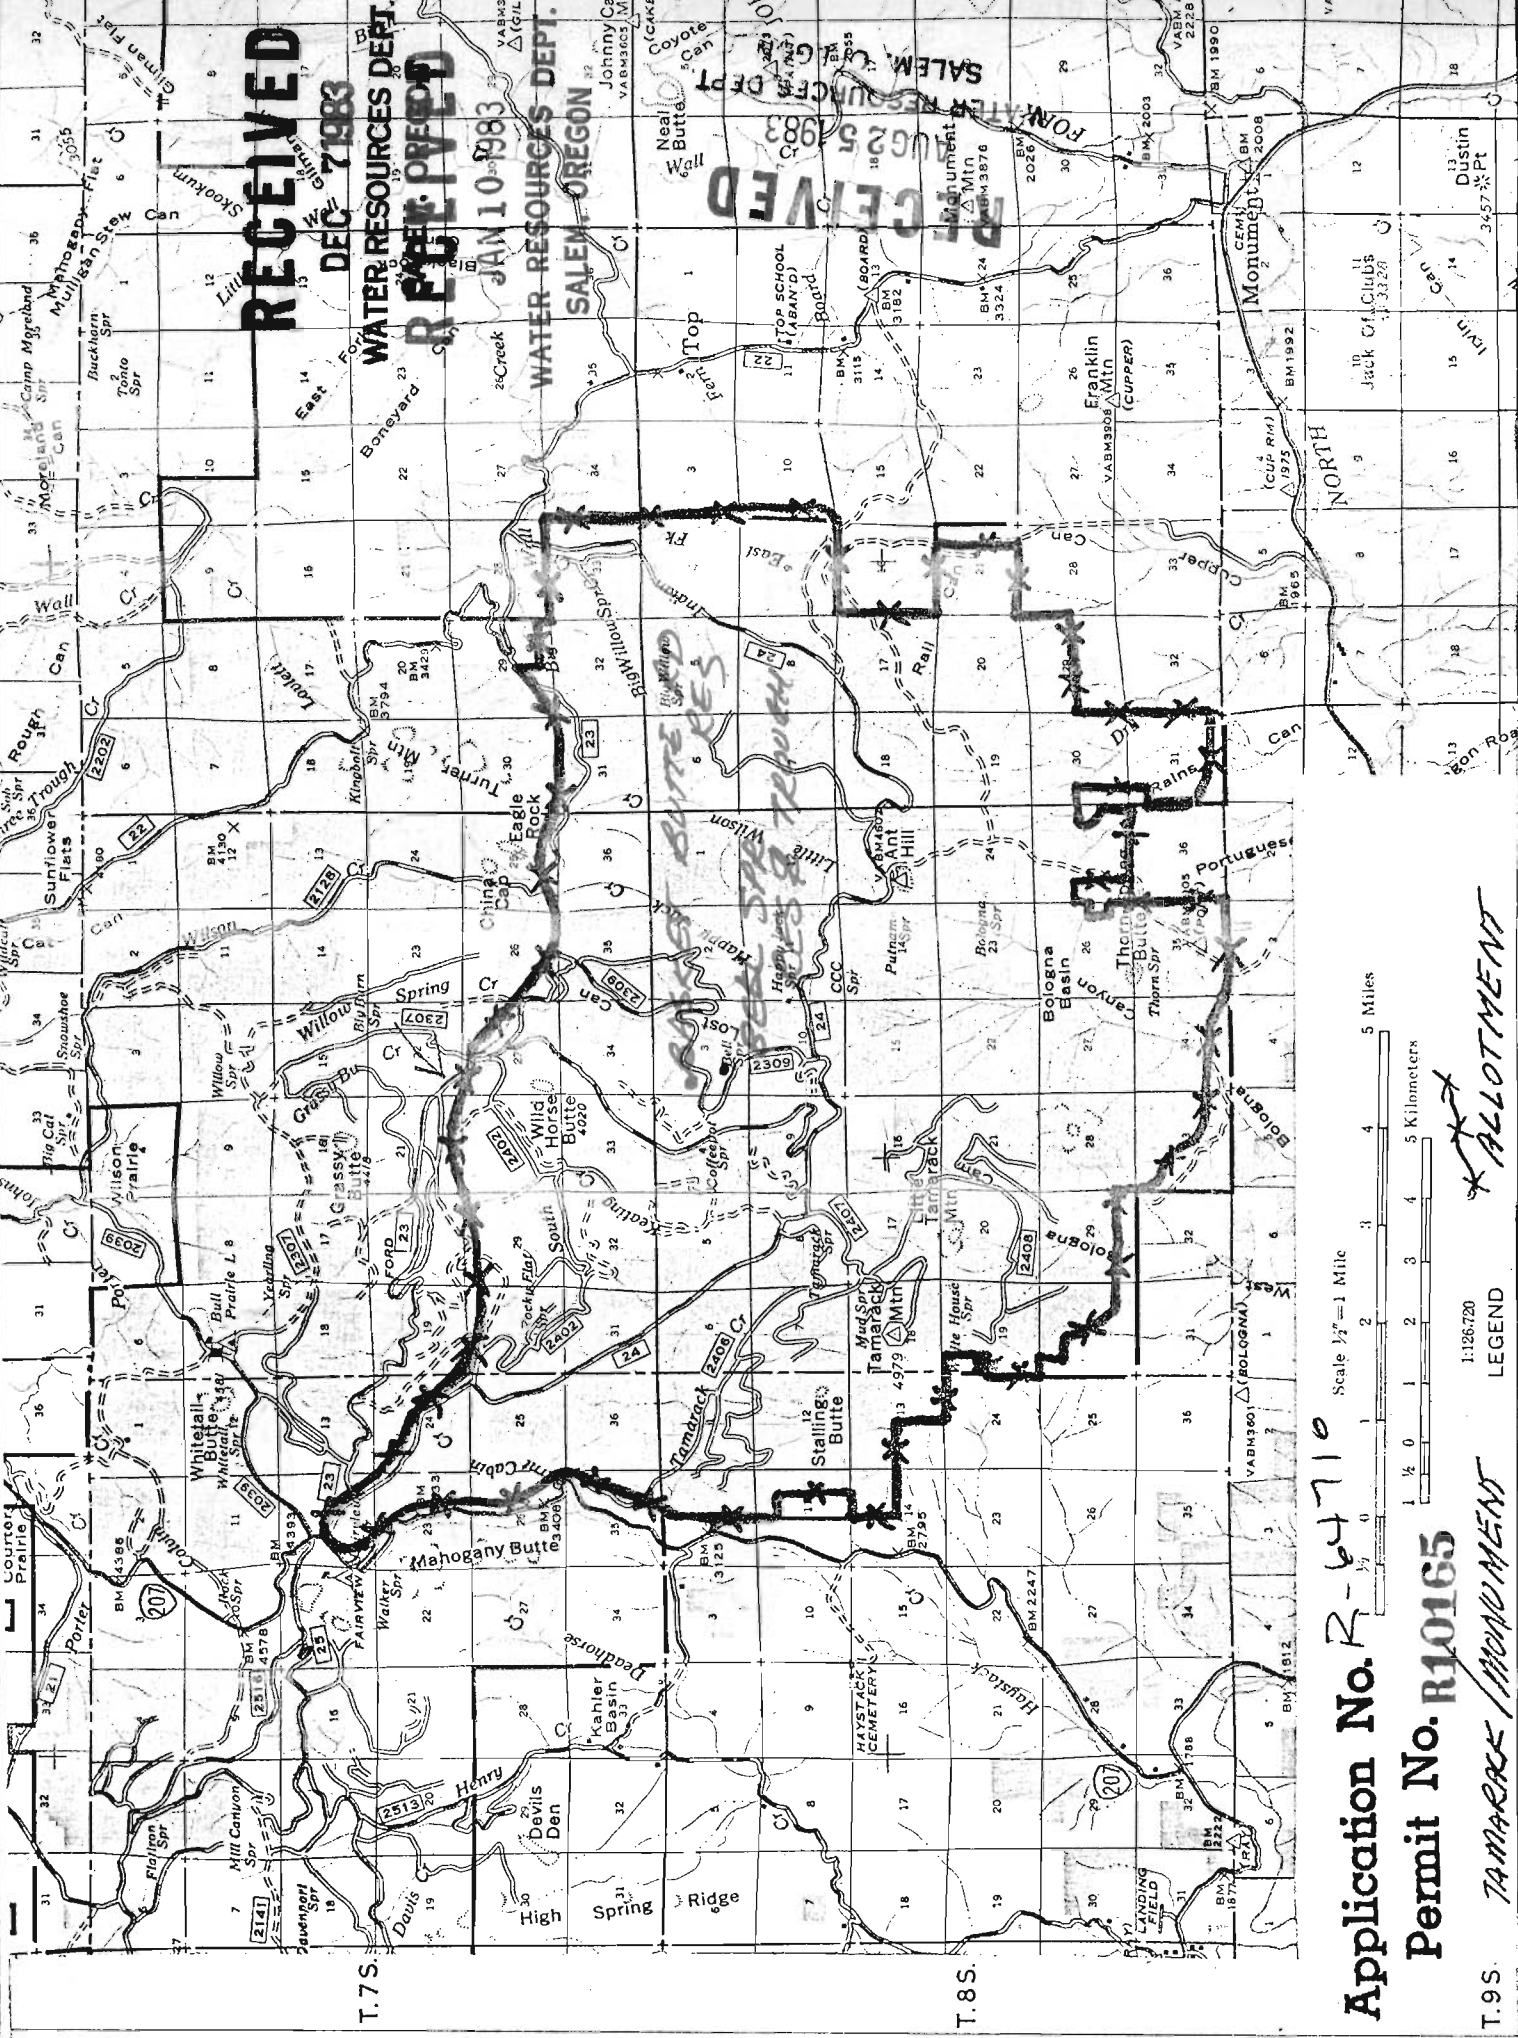

RECEIVED
DEC 7 1983
WATER RESOURCES DEPT.
RECEIVED
JAN 10 1983
WATER RESOURCES DEPT.
SALEM OREGON

RECEIVED
JUG 25 1983
WATER RESOURCES DEPT.
SALEM OREGON

Scale 1/2" = 1 Mile
1 1/2 0 1 2 3 4 5 Miles
1 1/2 0 1 2 3 4 5 Kilometers

Application No. R-64710

Permit No. R10165

T.S. TAMARACK MONUMENT

1:126,720
LEGEND


R. 25 E.

R. 26 E.


R. 27 E.



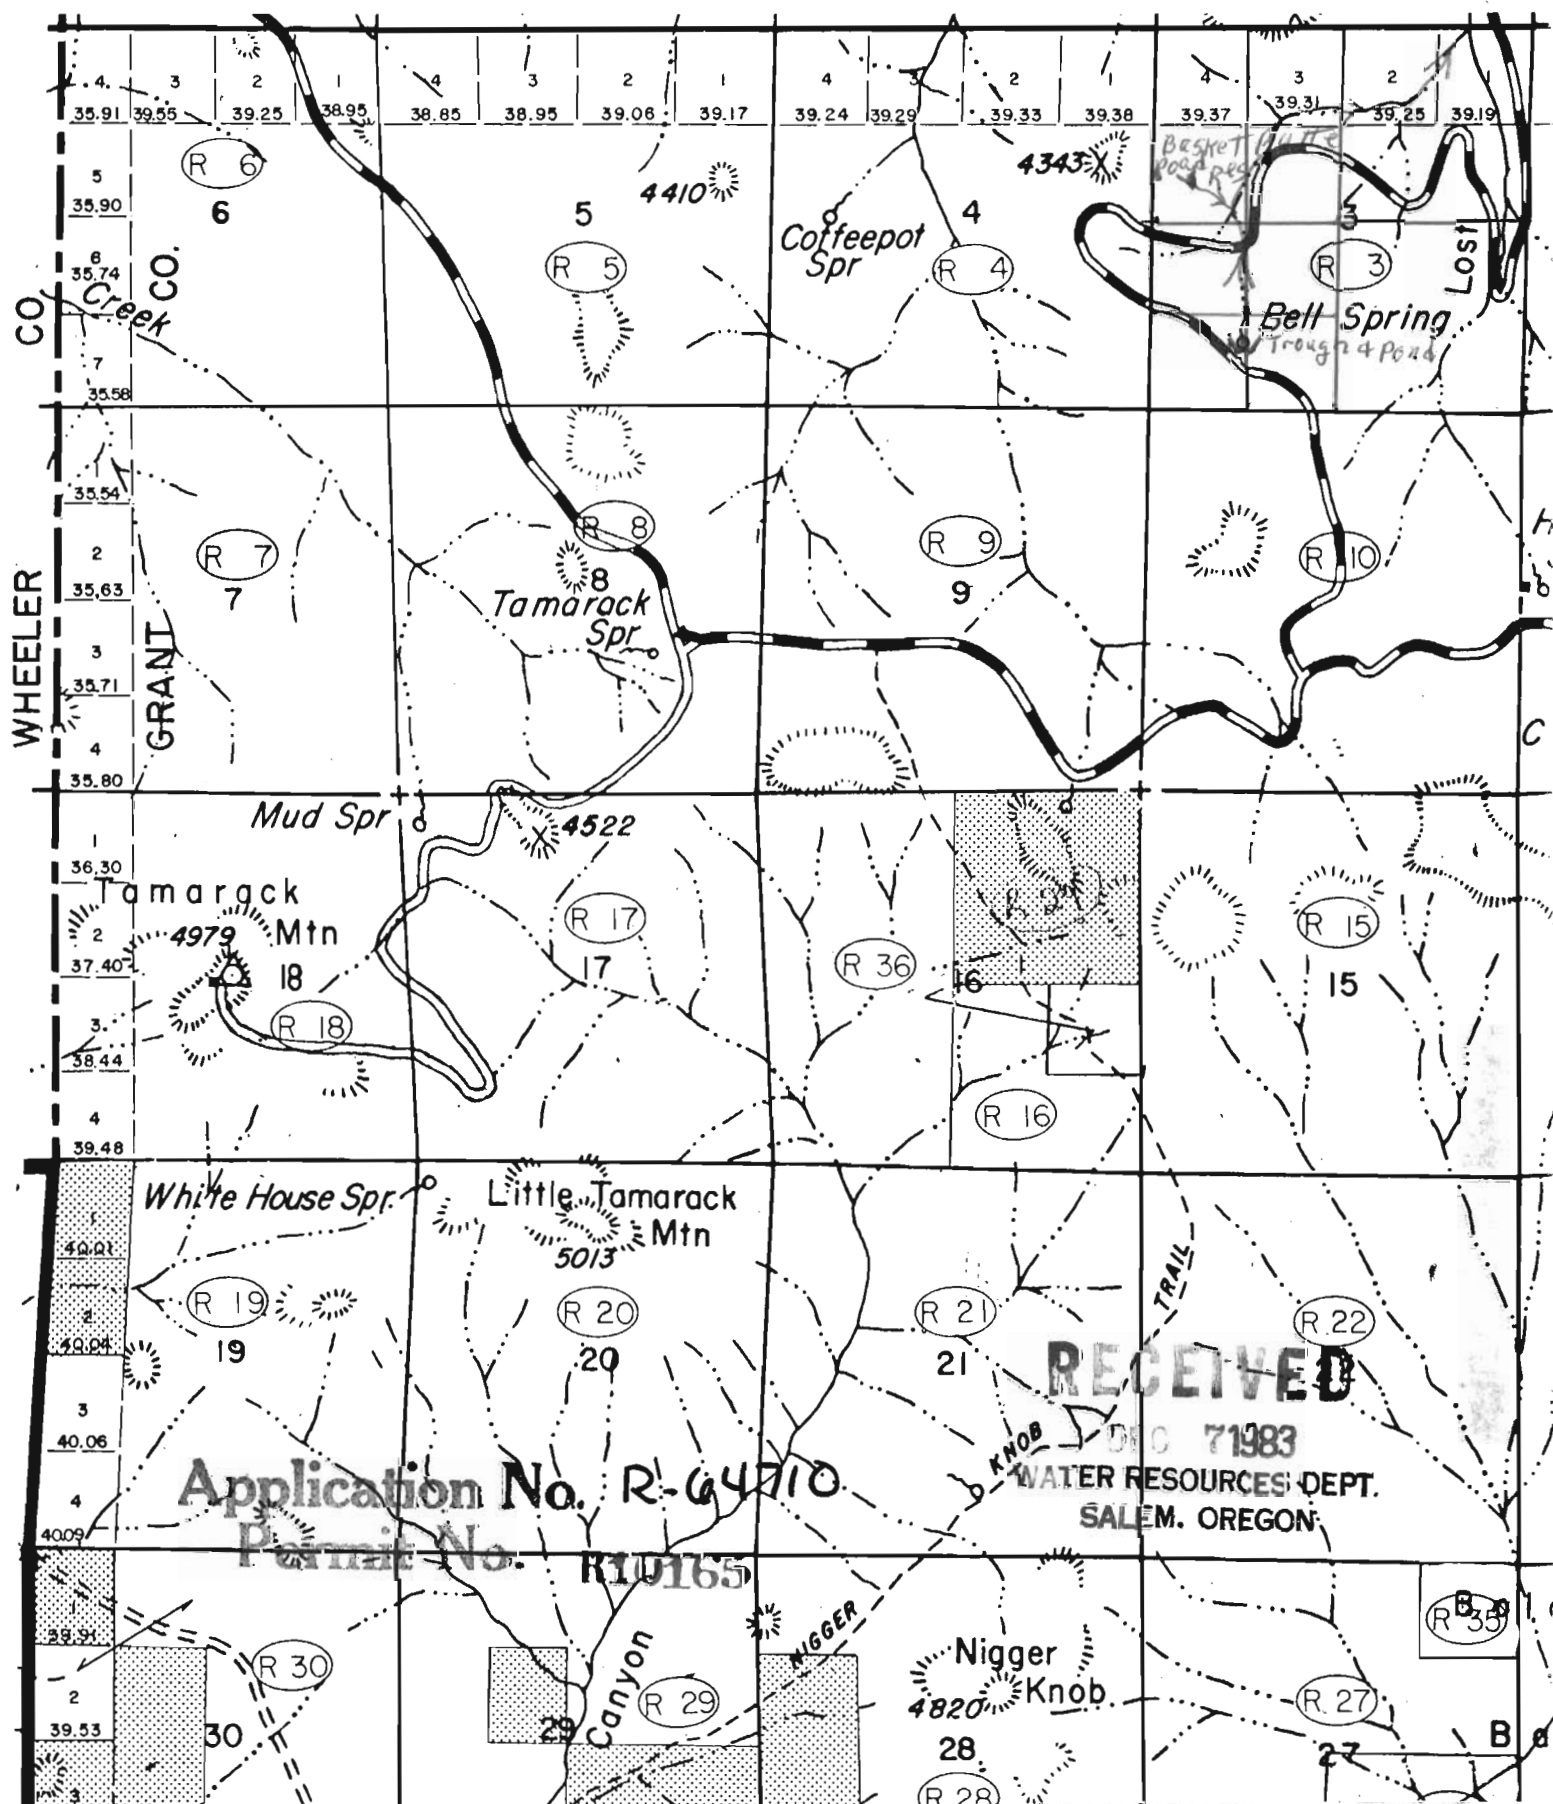

TOWNSHIP 8S, RANGE 26 E, SECTION 3, W.M.

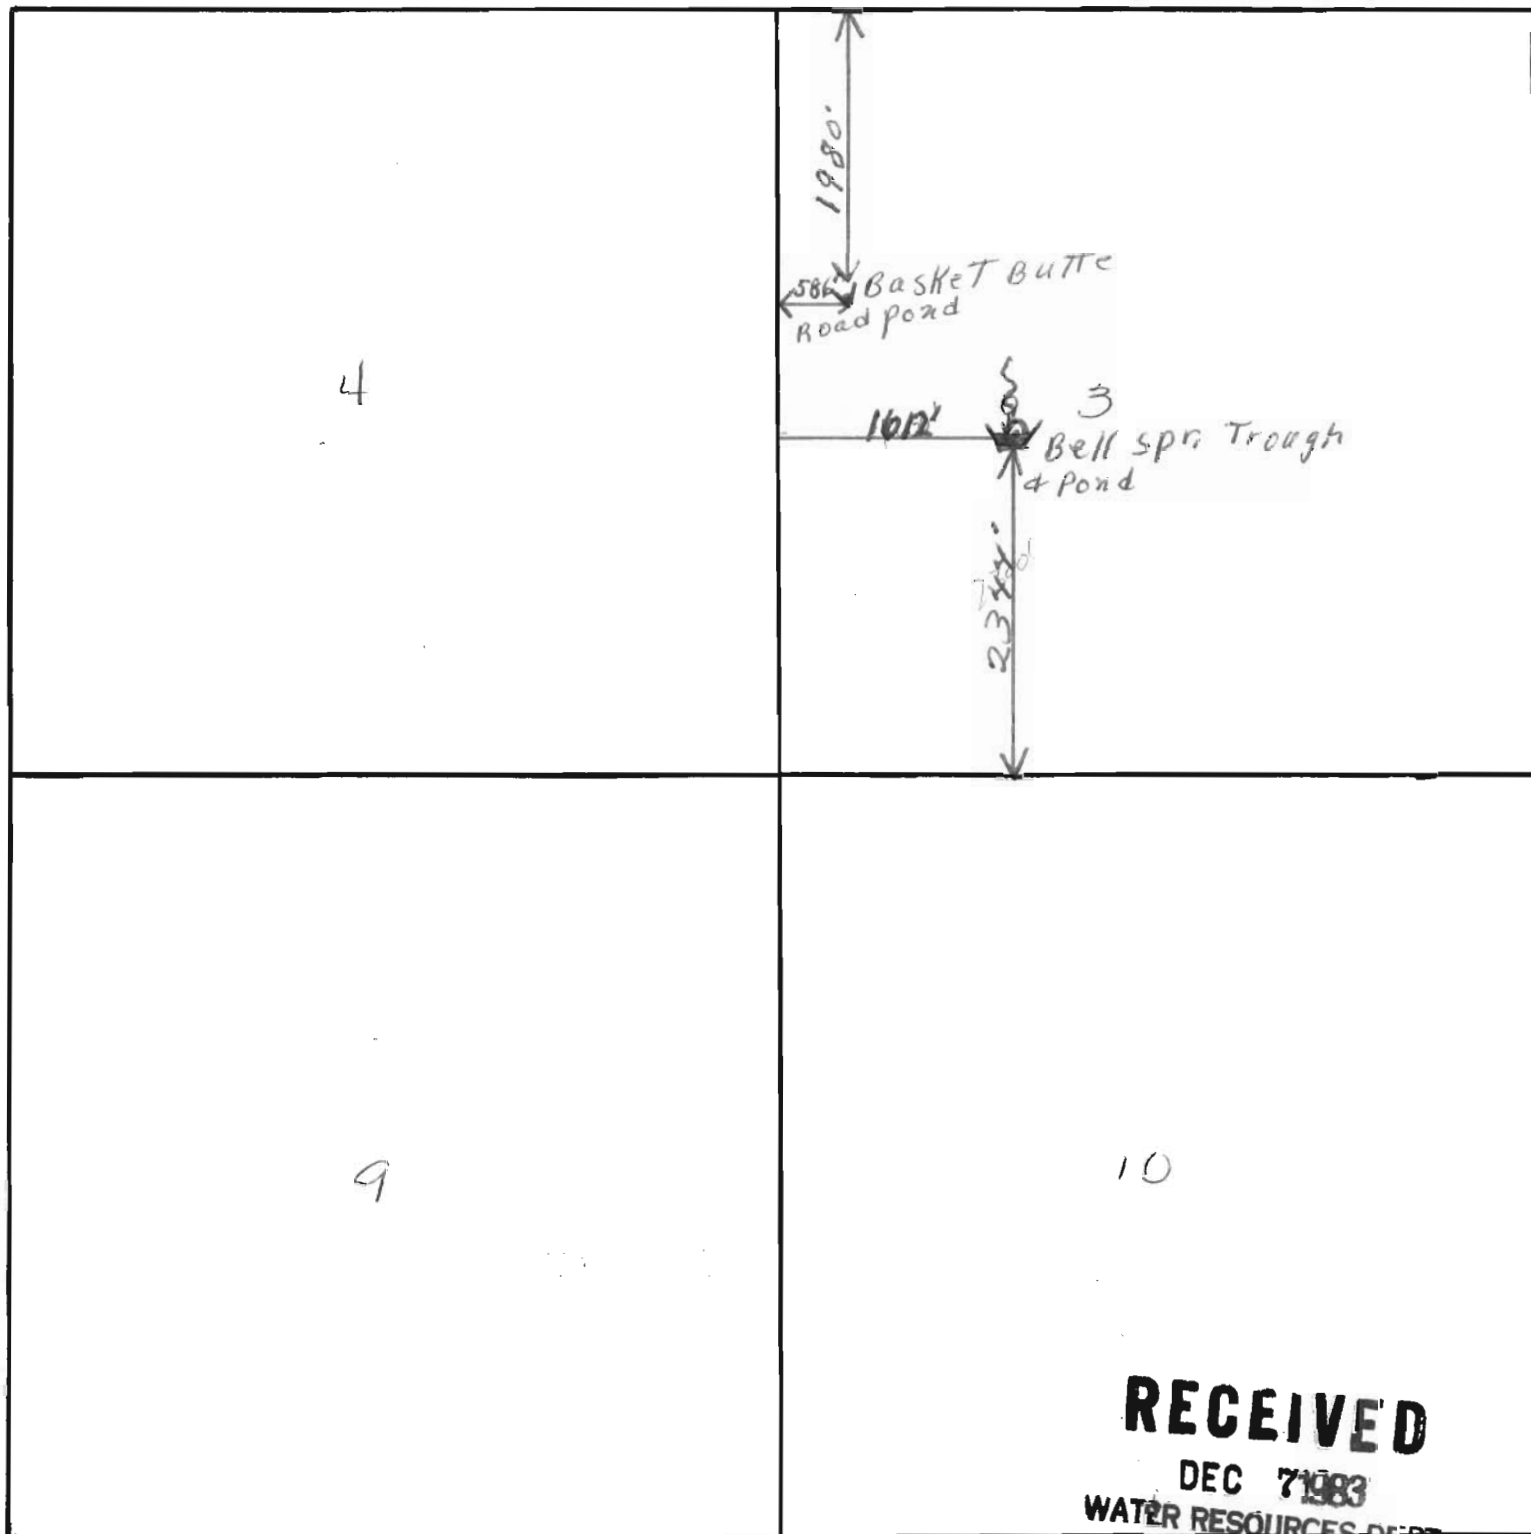

NAME Bell Spring Res. & Trough COUNTY Grant
Application No. R-64710
Permit No. R10165

RECEIVED

AUG 25 1983
WATER RESOURCES DEPT.
SALEM, OREGON

RECEIVED

JAN 10 1983
WATER RESOURCES DEPT.
SALEM, OREGON