


Crooked Crk. & Mac.

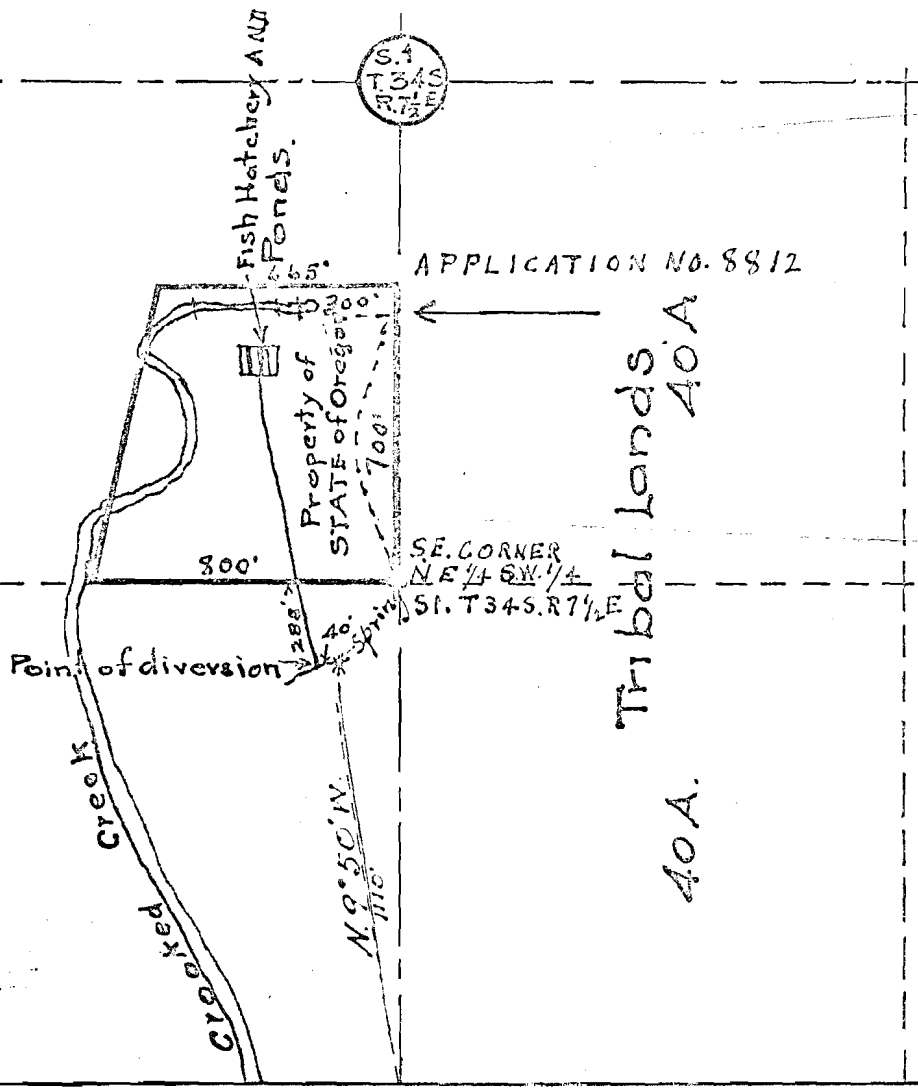

I. C. T. Darley, of Klamath Falls, Oregon, do hereby certify that this map was made from notes taken during an actual survey made under my direction on Dec. 4, 1922, and that it correctly represents the works described in the accompanying application, together with the location of streams and other ditches in the immediate vicinity.

I. C. T. Darley, Surveyor.

Map accompanying the application of the STATE OF OREGON for the permit to the use of the waters of a certain spring for Fish Hatchery purpose. Located in the SE 1/4 SW 1/4 of Sec. 1, T. 34, S. R. 7 1/2 E. W. M. (Klamath Co.) Ore.

Scale. 1" = 500'

I. C. T. Darley.

Application No. 8812
Filed for record