

COWPIE RESERVOIR
T4S R28E
SECTION 24

Drive-IN Reservoir
T4S R28E SECTION 23


1988 PILED

WATER RESOURCES DEPT
SALEM, OREGON

Application No. R-64716
Permit No. R10166

Bald Mountain
x5175

U M A T I L L A

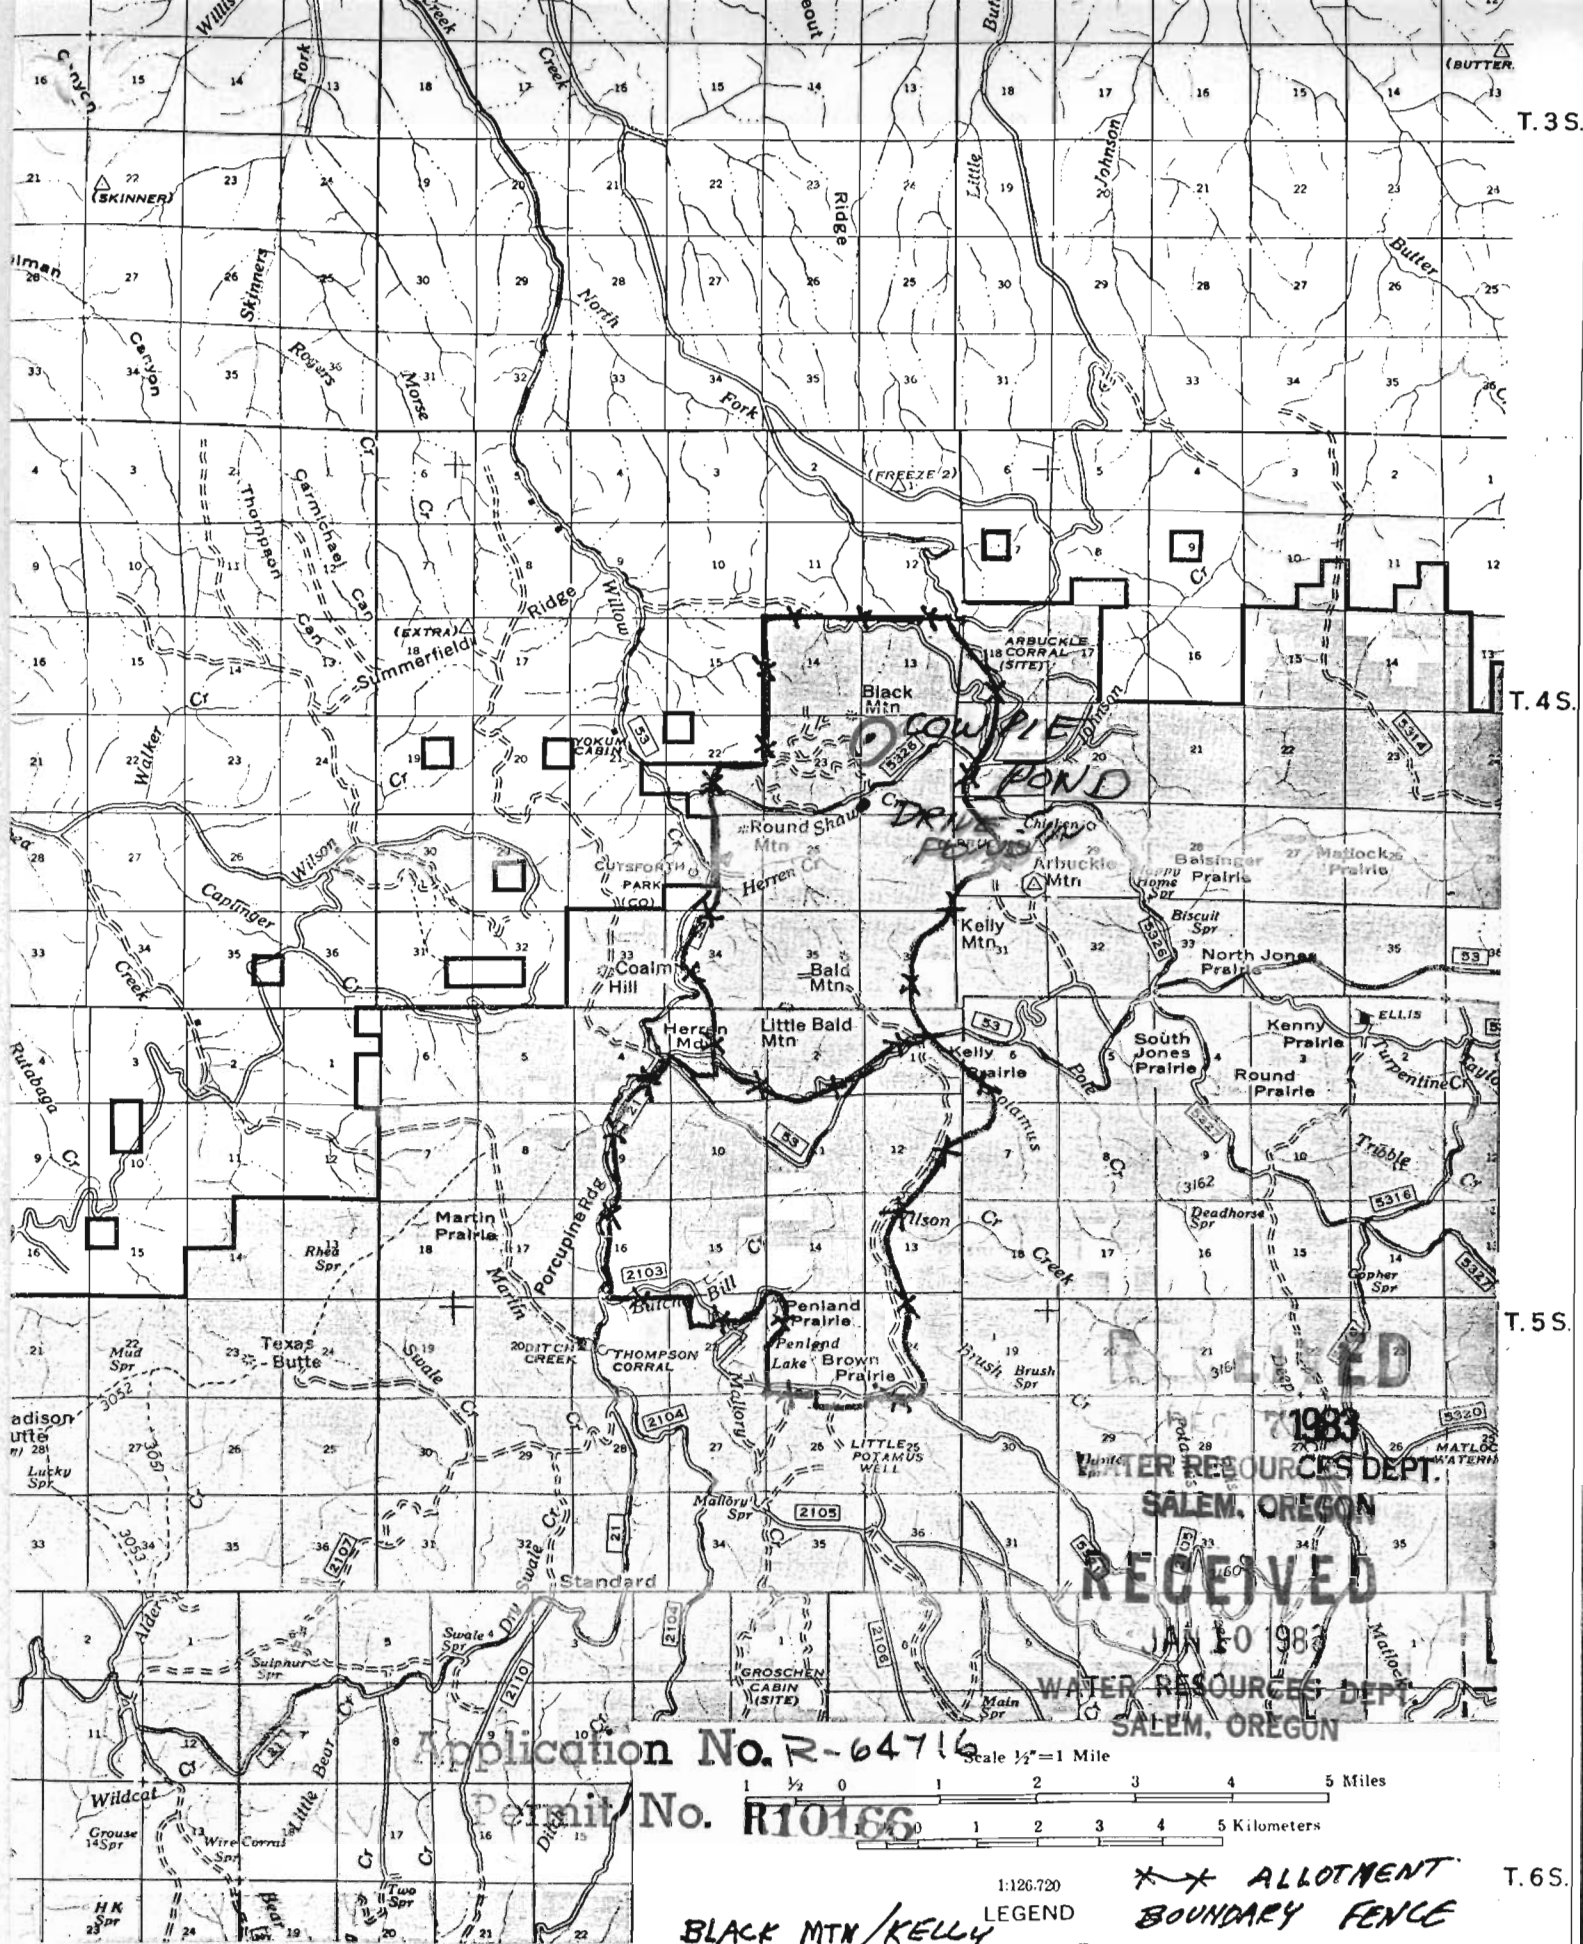

R. 27 E.

R. 28 E.

R. 29 E.

T. 3 S.


T. 4 S.

T. 5 S.

T. 6 S.

EXCH. BDR. ACT. 3/4/25

(FREEZE 2)

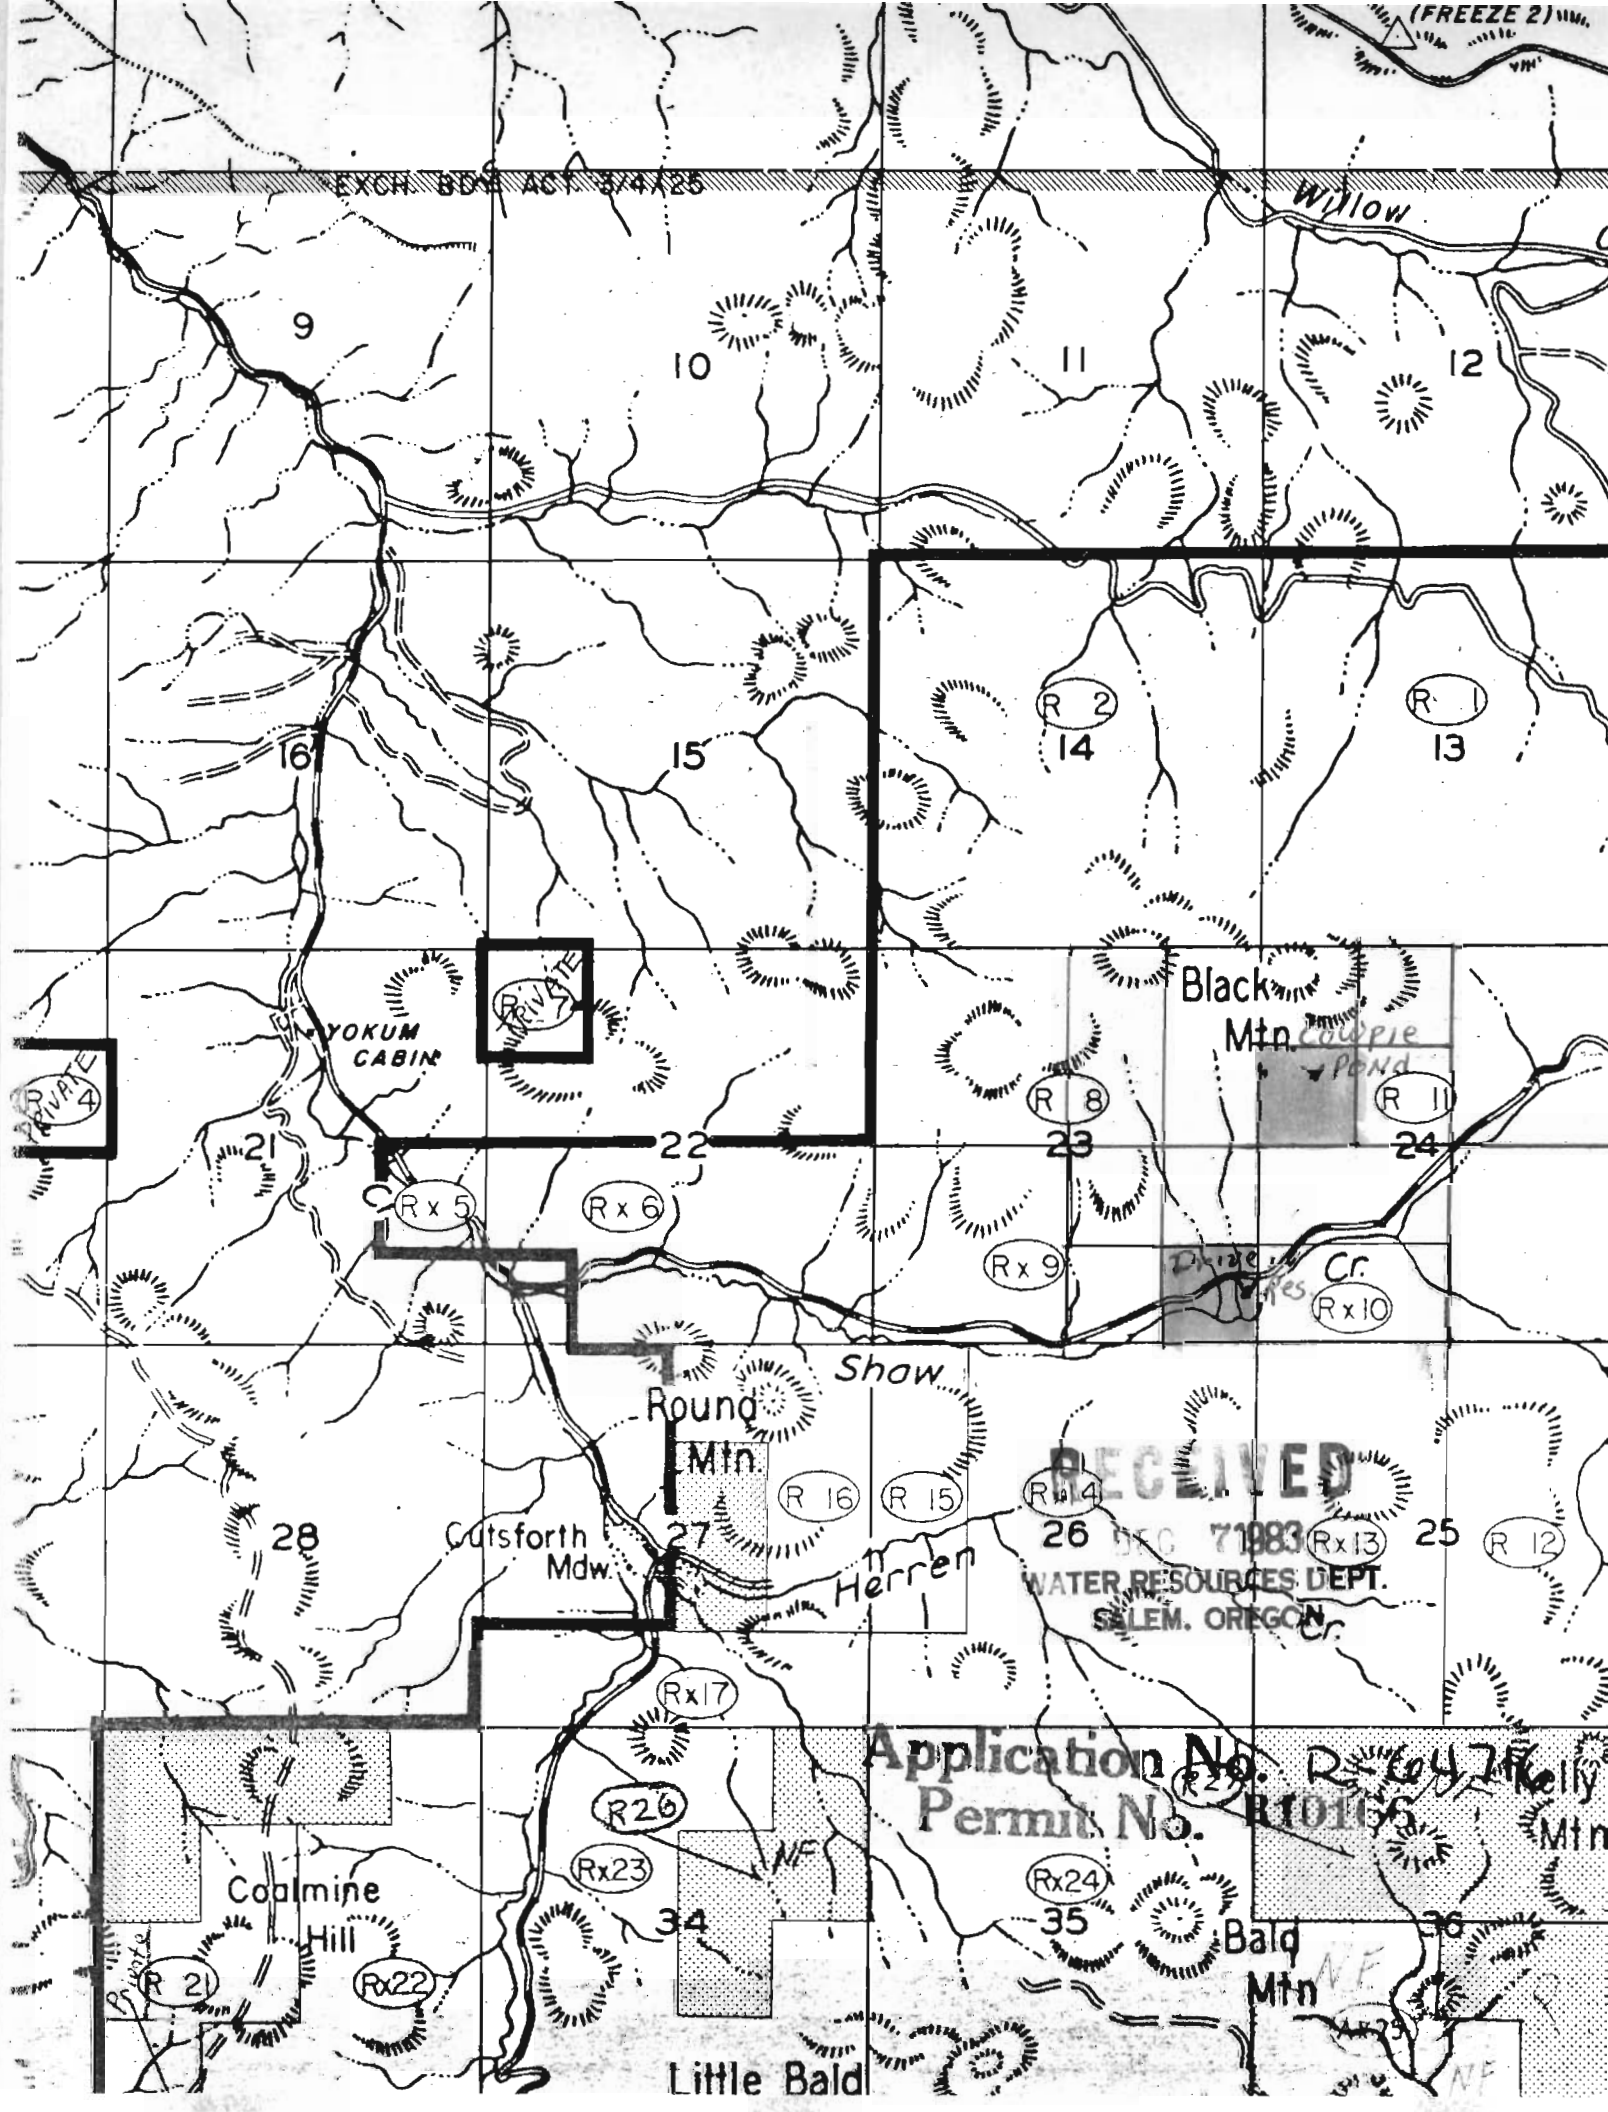

RECEIVED

26 DEC 7 1983
WATER RESOURCES DEPT.
SALEM, OREGON

Application No. R-647 Kelly
Permit No. R10165

Little Bald



R28E

R29E

T4S

T4S

ROADS END POND

WATER JUMP POND

SOGGY TOP POND

COW PIE POND

CLIFFHANGER POND

CREVASSE POND

DRIVE IN POND

IMAGINARY POND

RECEIVED
JAN 10 1983
WATER RESOURCES DEPT
SALEM, OREGON


RECEIVED

JAN 10 1983

WATER RESOURCES DEPT
SALEM, OREGON

Application No. R-64716
Permit No. R10166

TOWNSHIP 4S, RANGE 28E, SECTION 24, W.M.

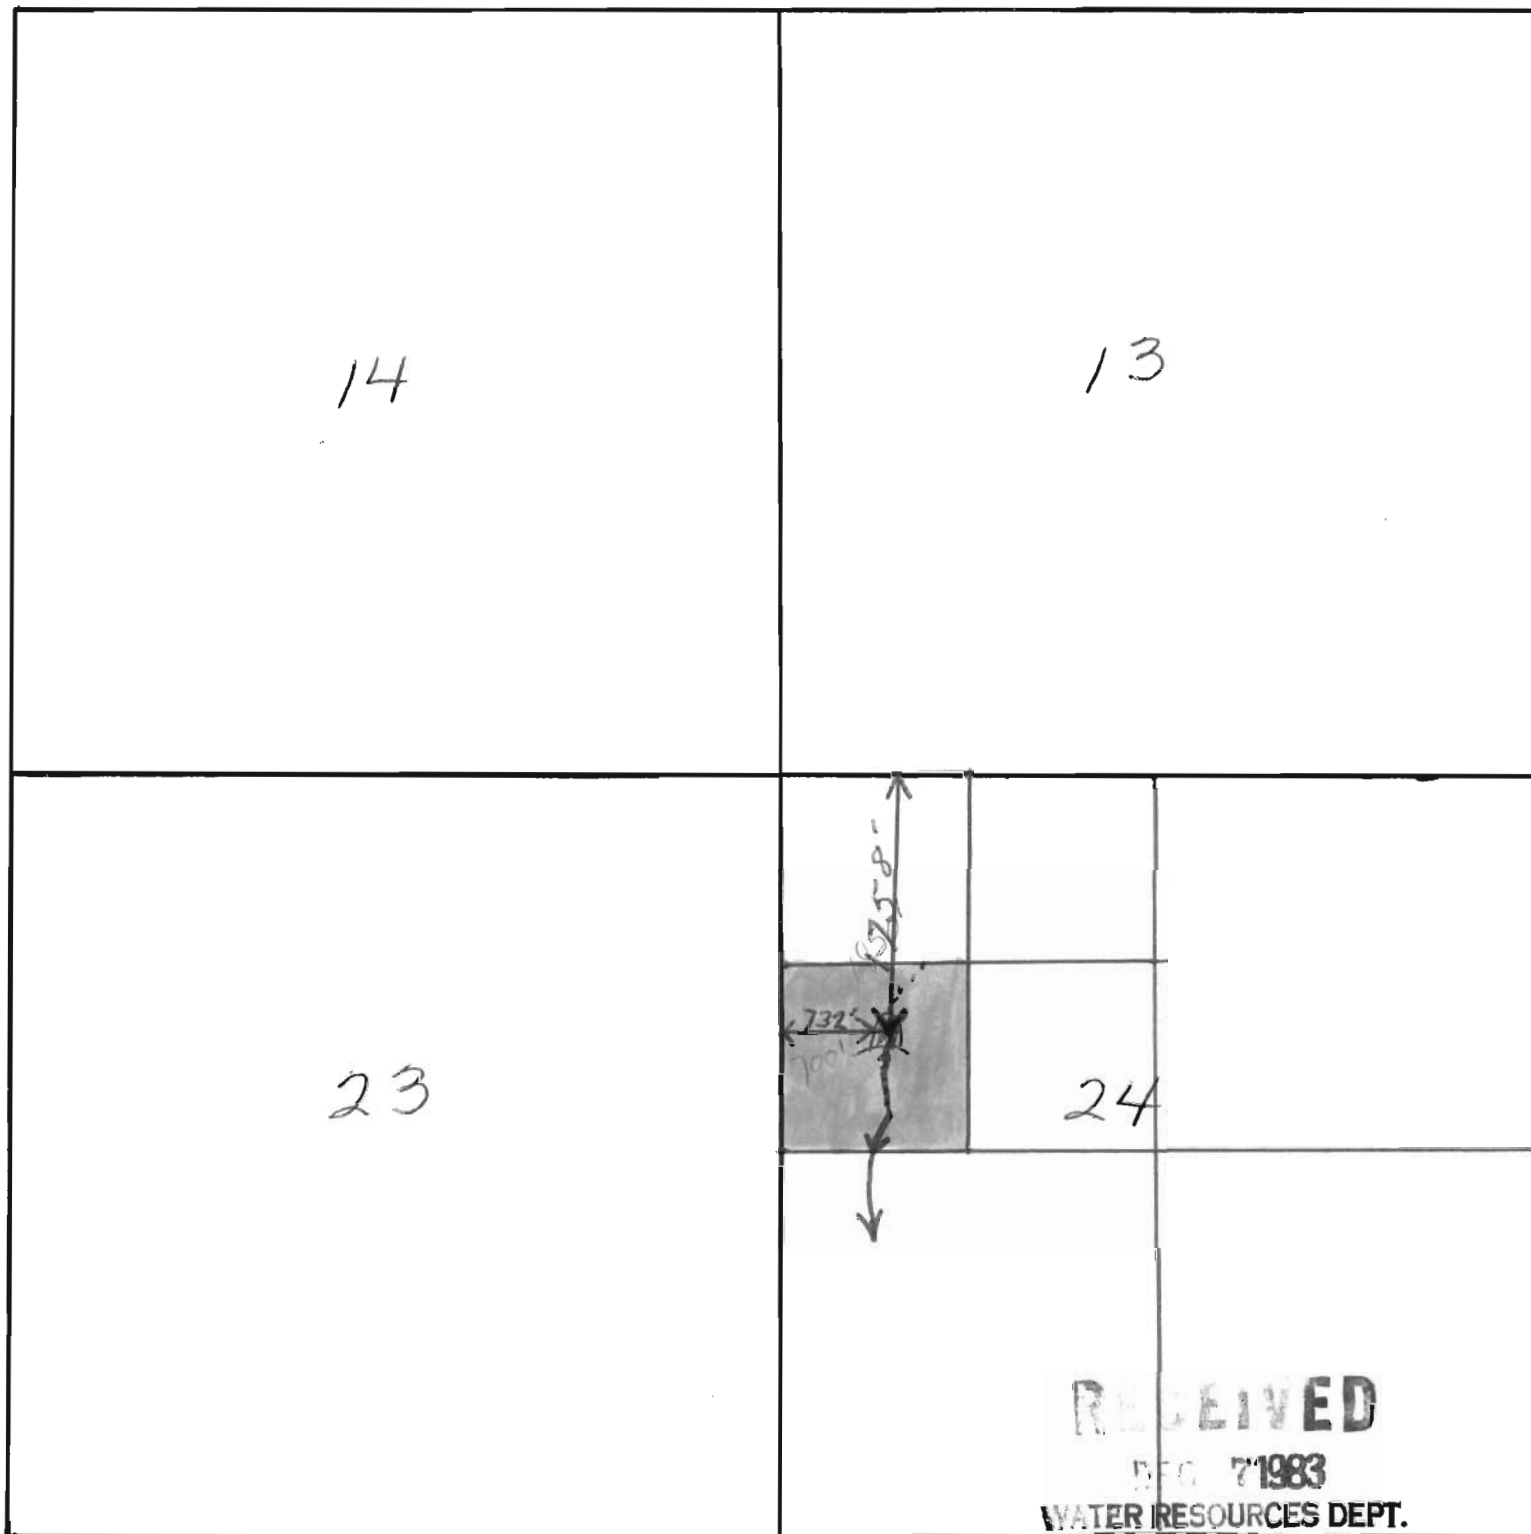

NAME COWPIE POND

COUNTY NOBROW

Application No. R-64716 5A


Permit No. R10166

RECEIVED

JAN 10 1983

WATER RESOURCES DEPT.
SALEM, OREGON

TOWNSHIP 45, RANGE 28E, SECTION 23, W.M.

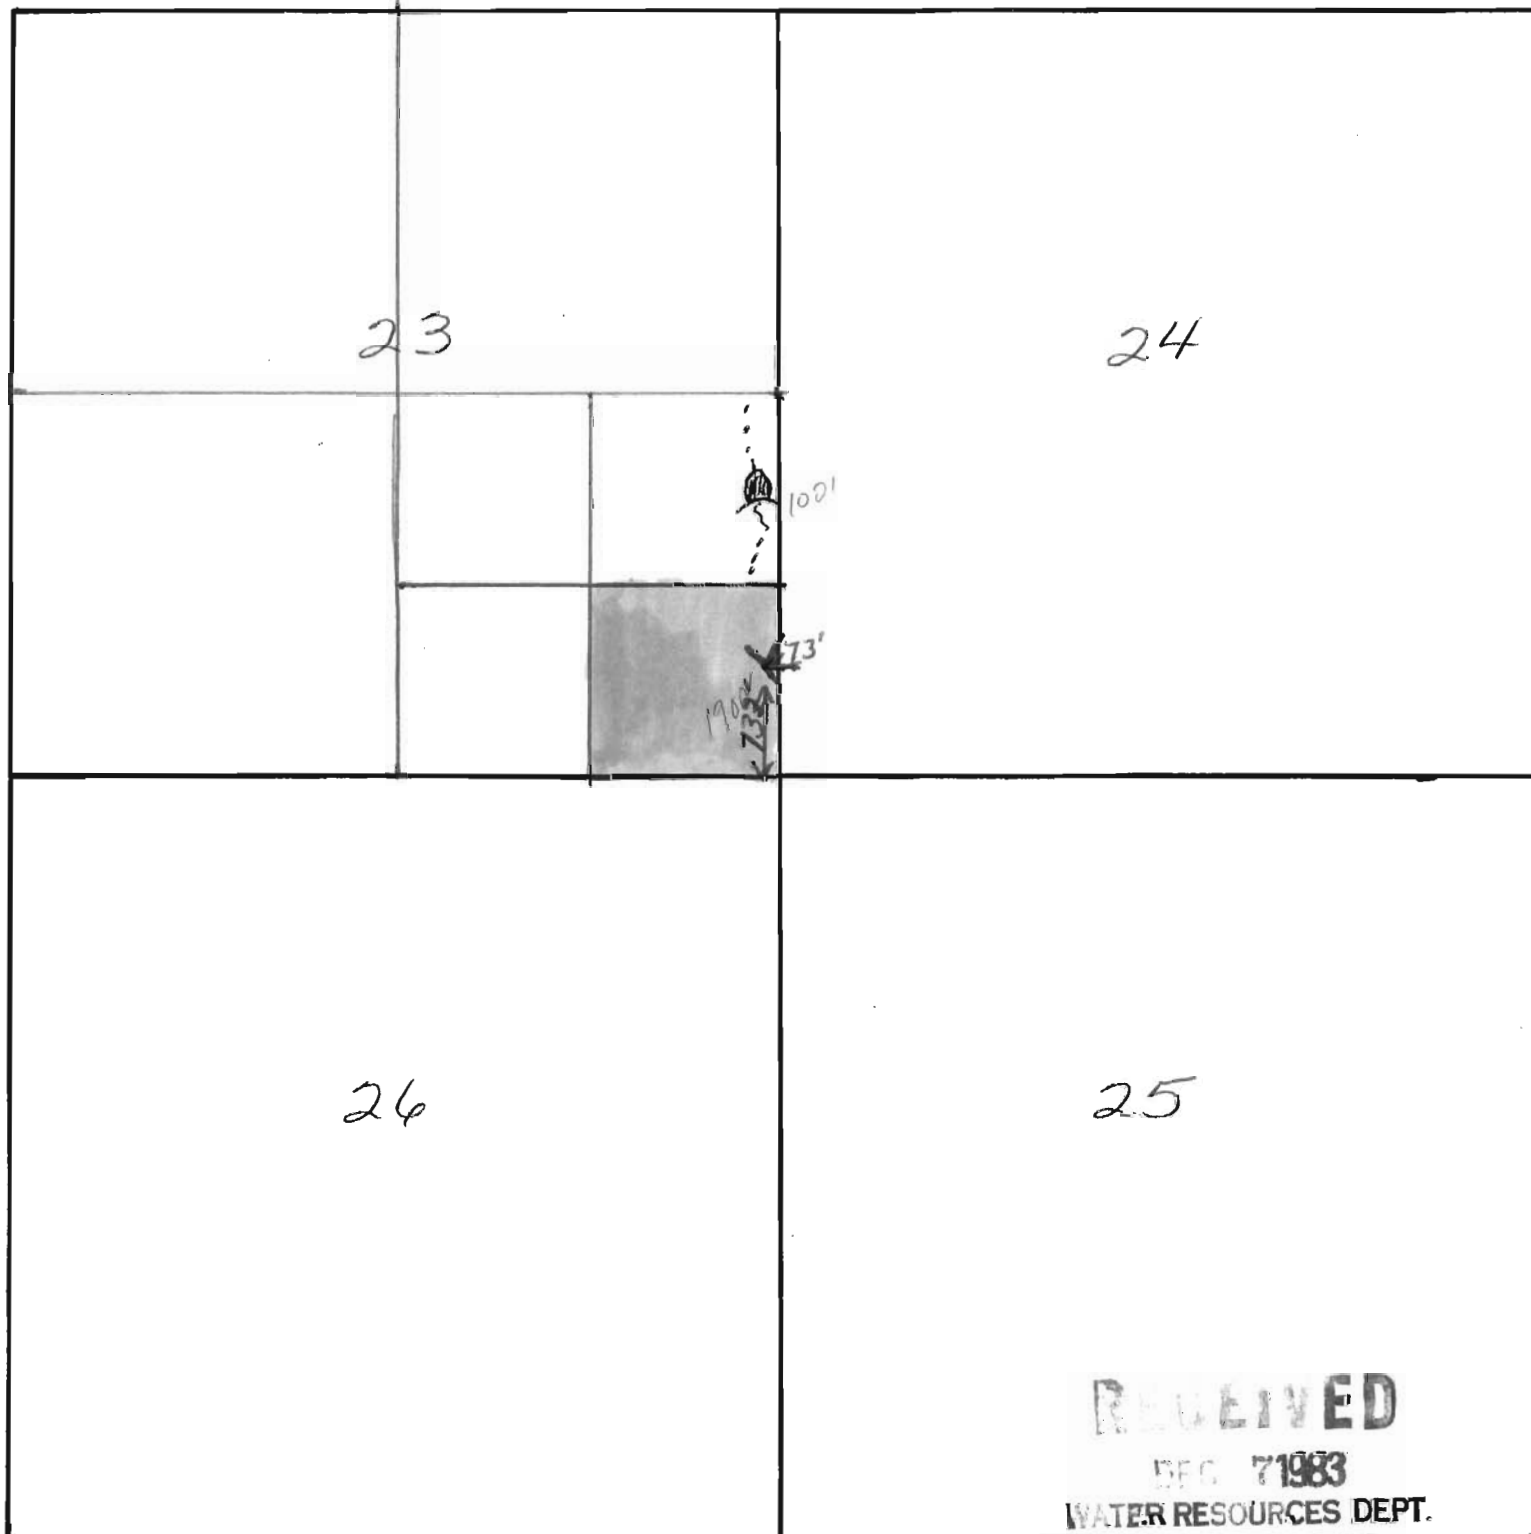

NAME DRIVE-IN RES.

COUNTY CLATSOP

Application No. R-64716 5B

Permit No. R10166

RECEIVED

JAN 10 1983

WATER RESOURCES DEPT.
SALEM, OREGON