

Mud Reservoir
T7S R24E Section 10

BM

4668

N A T I O N

16

4400

15

1983

WATER RESOURCES DEPT.
SALEM, OREGON

Creek


4000

Application No. R-64718
Permit No. R10167

22


4310

23

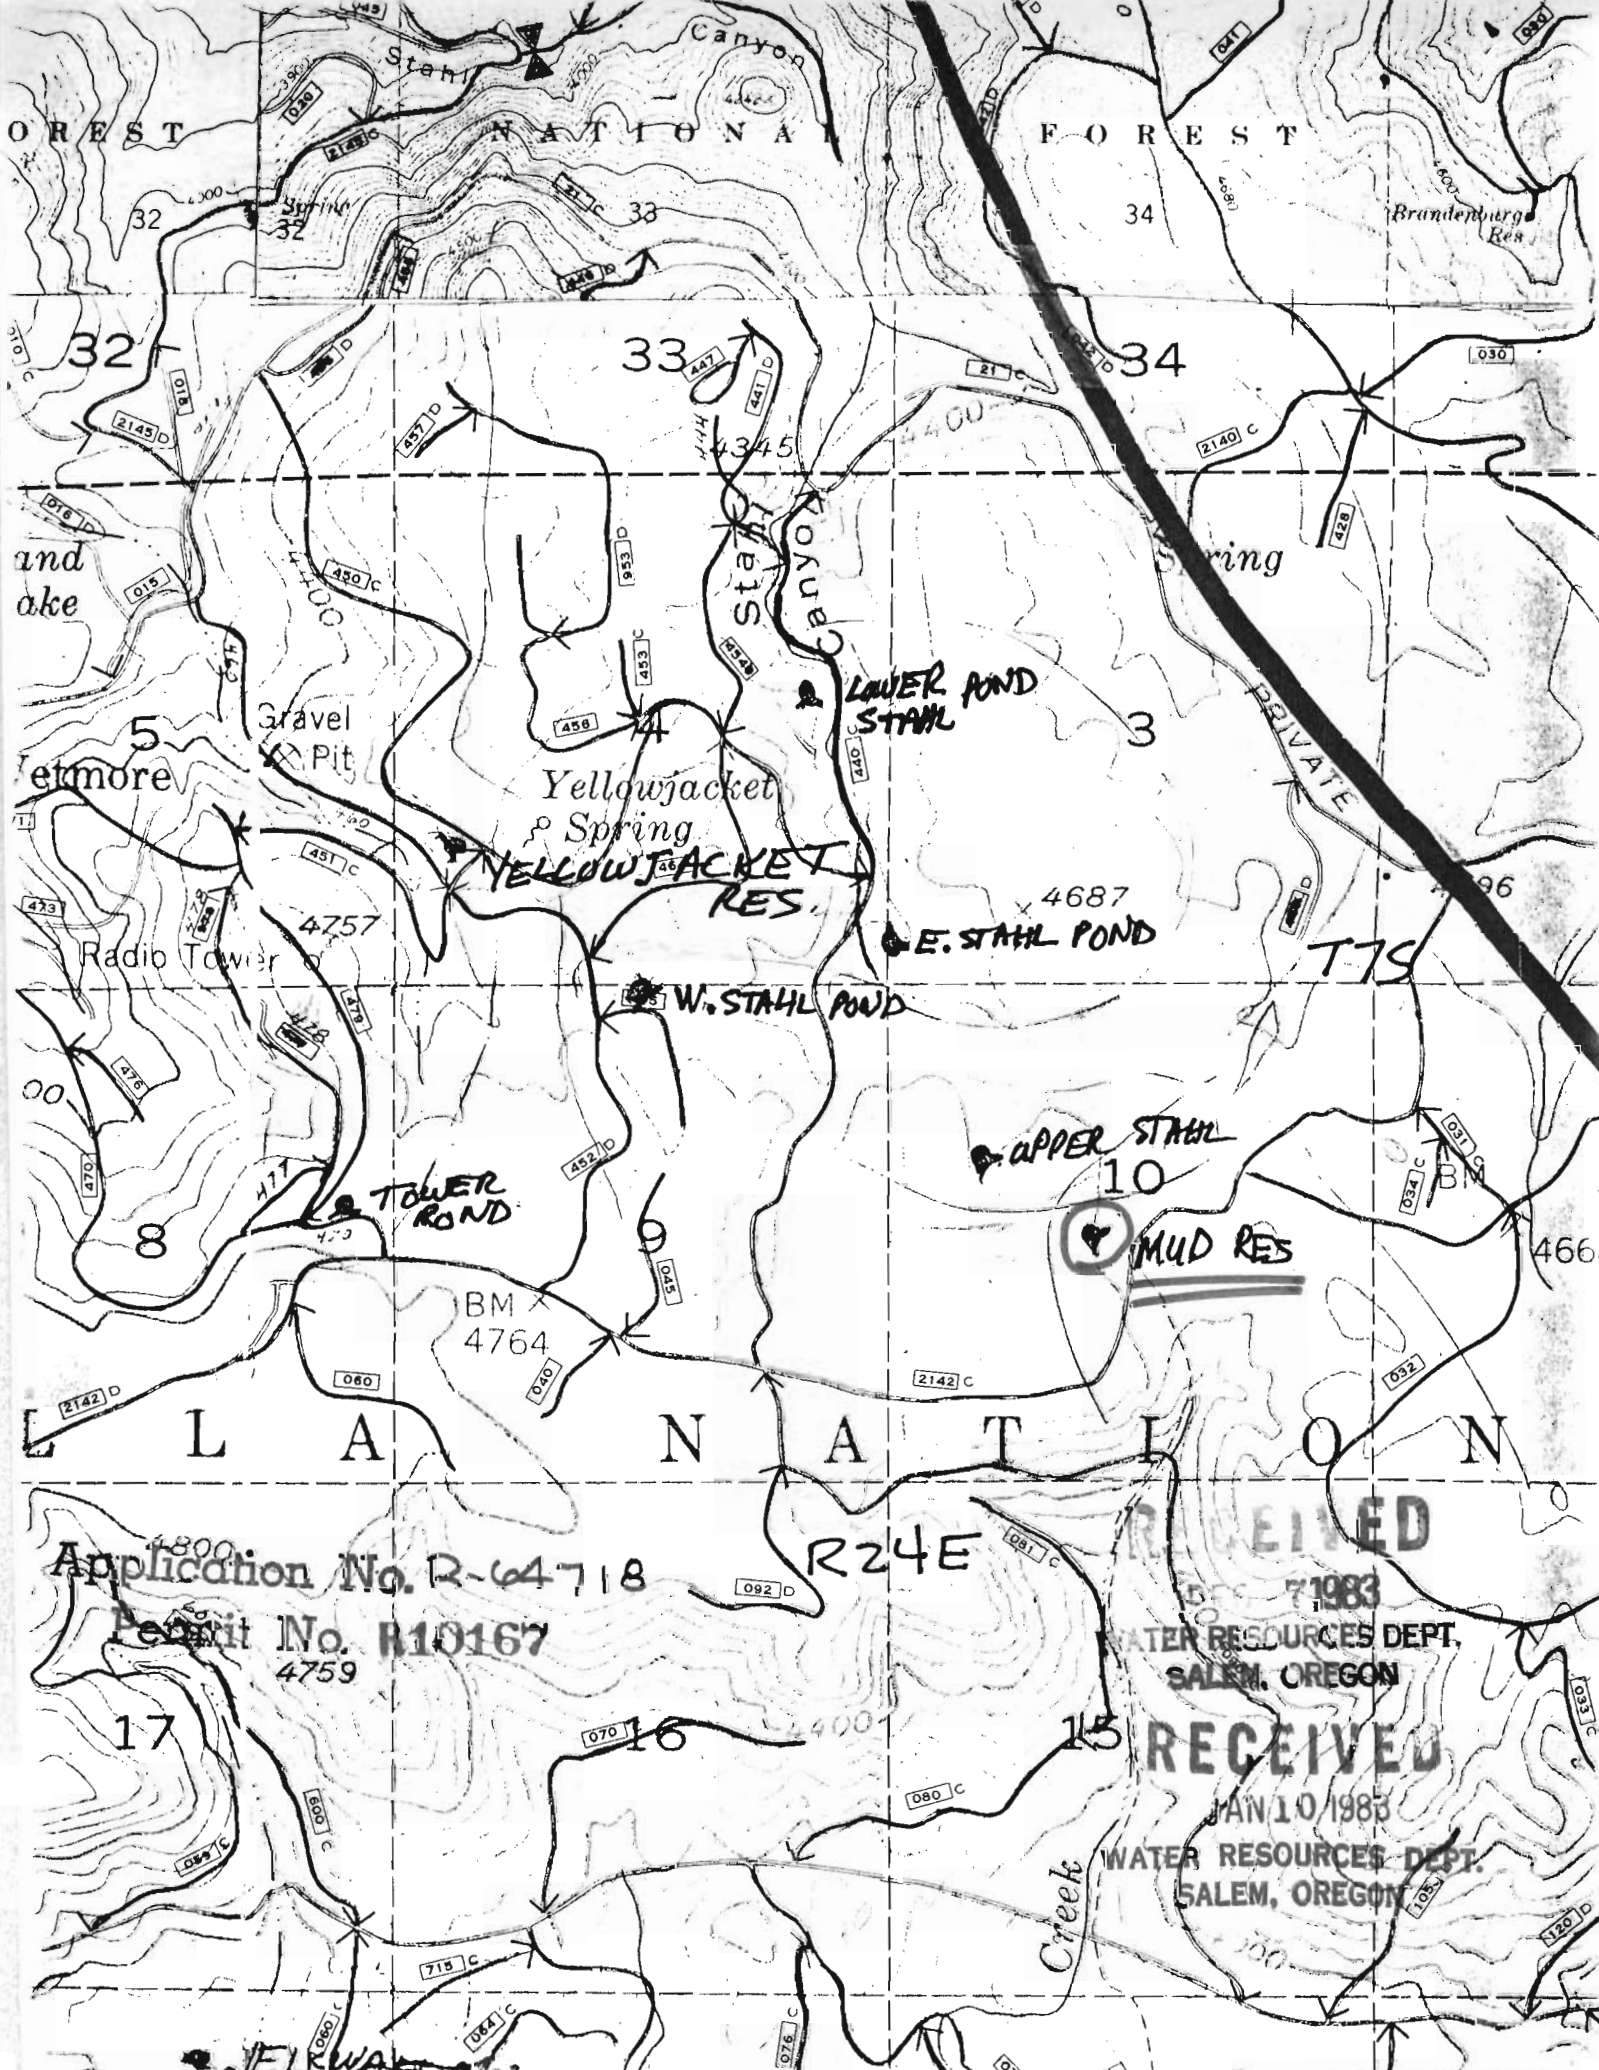

Application No. R-64718
Permit No. R10167
4759

RECEIVED
JAN 10 1983
WATER RESOURCES DEPT.
SALEM, OREGON

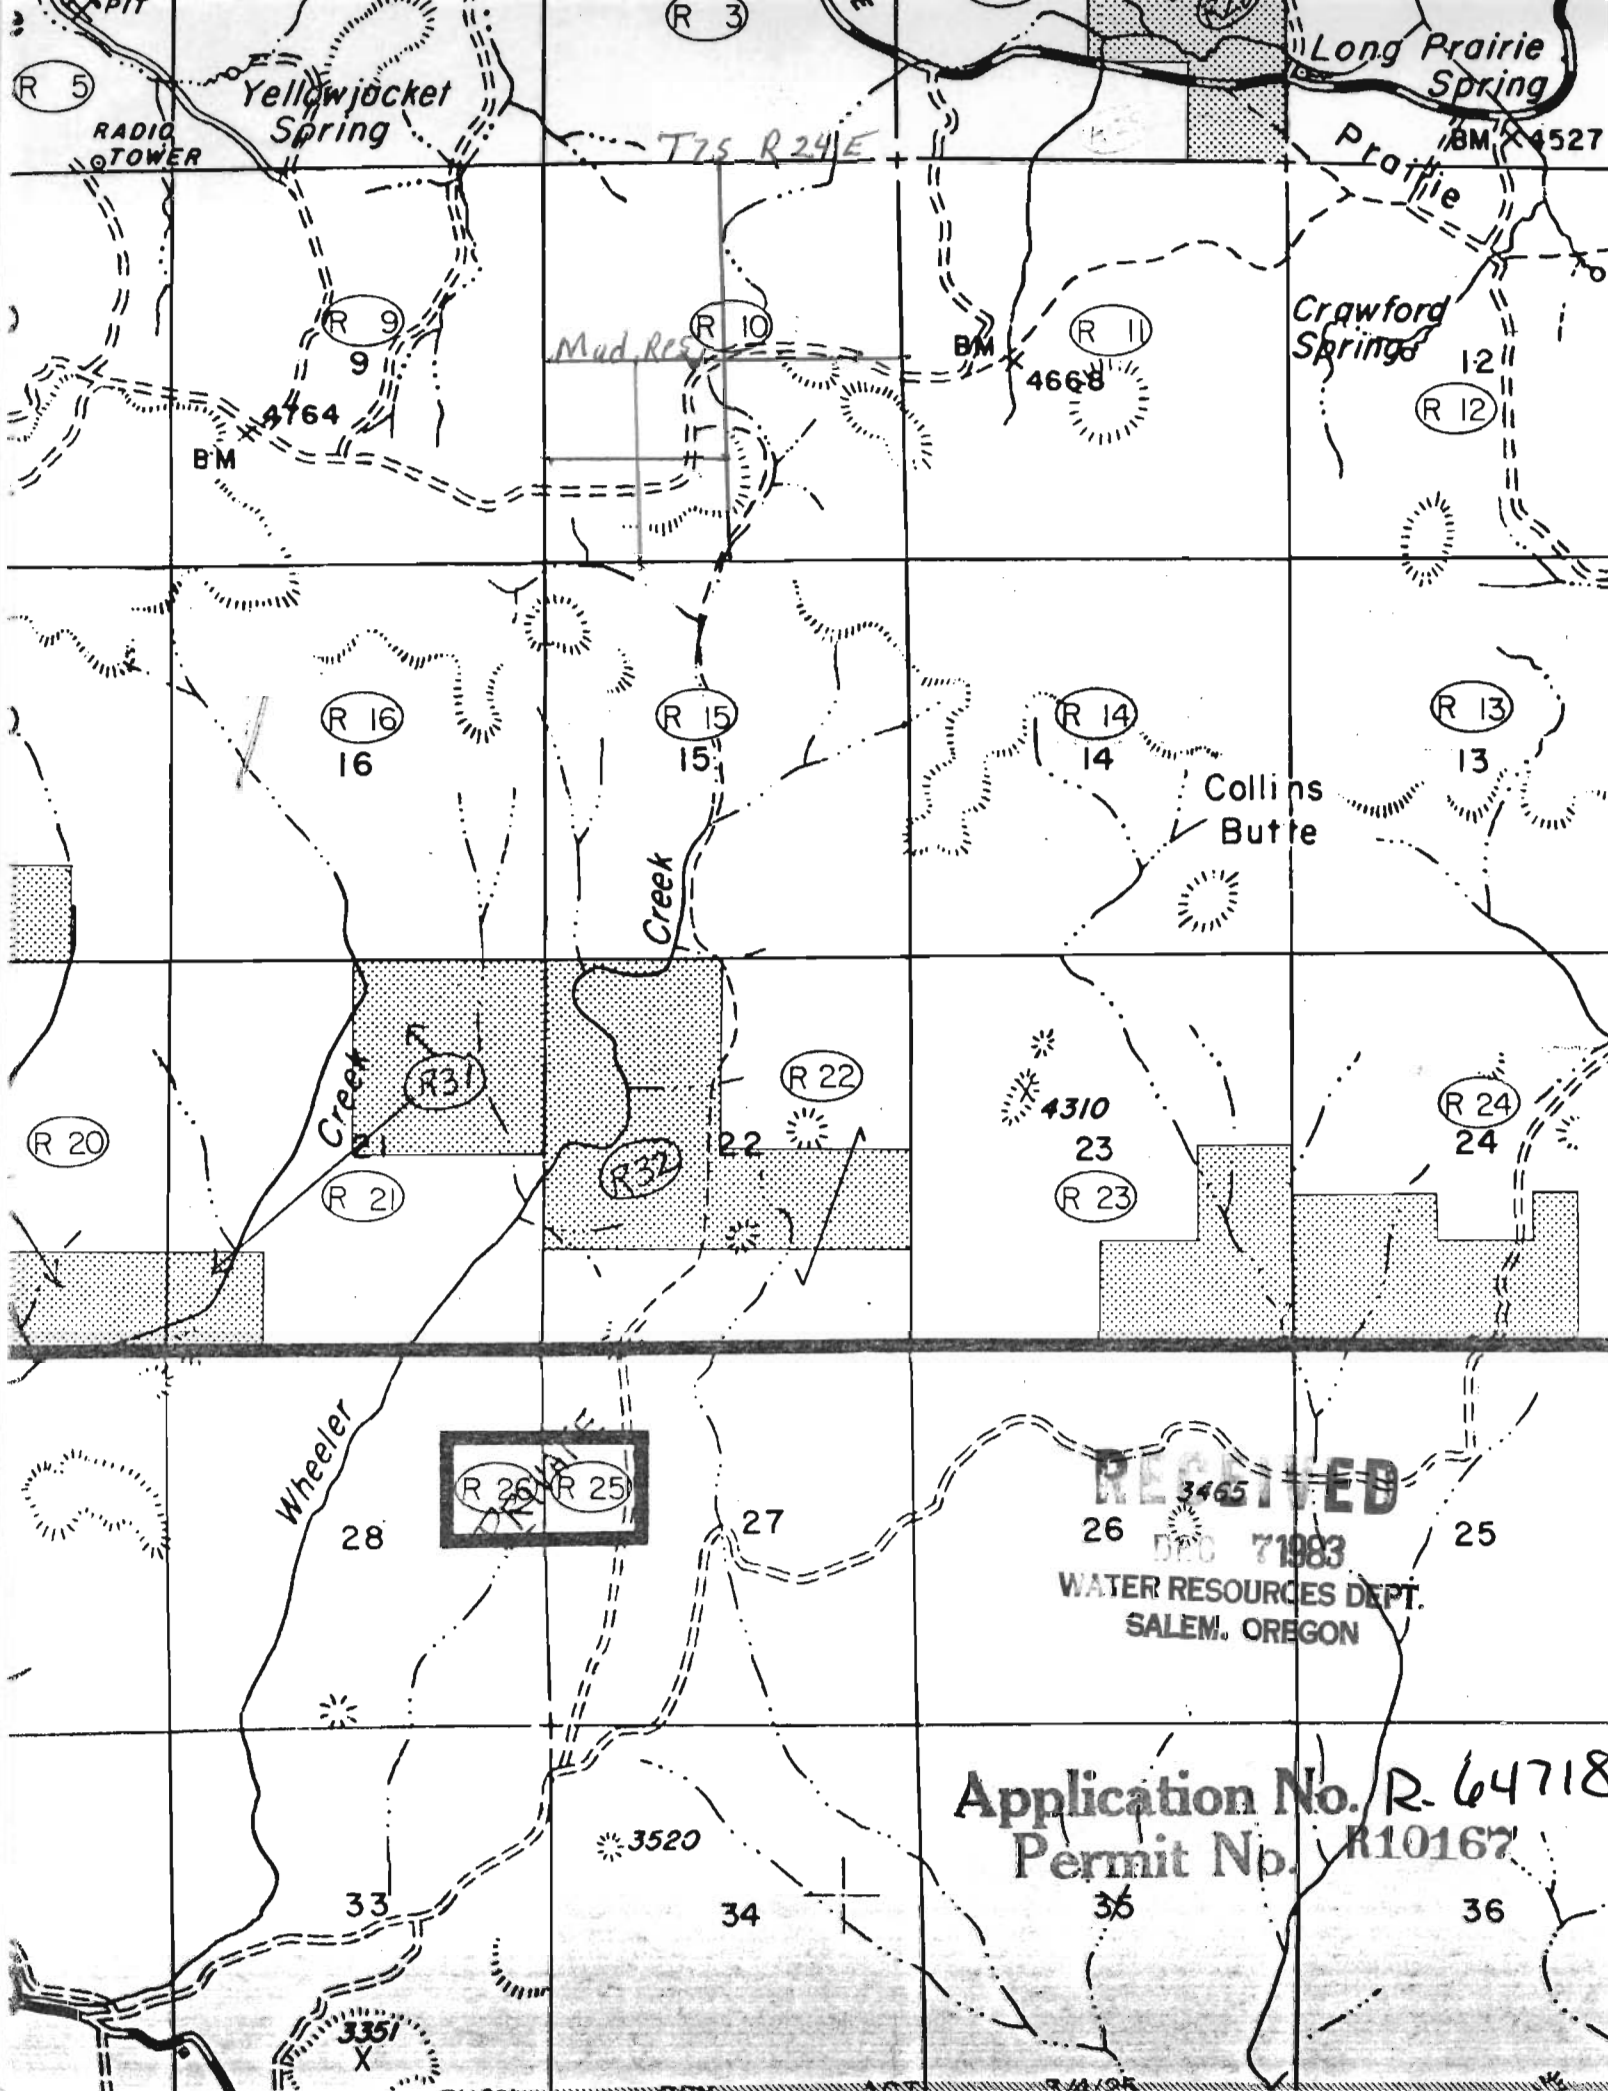

RECEIVED

3465
DEC 7 1983
WATER RESOURCES DEPT.
SALEM, OREGON

Application No. R. 64718
Permit No. R10167

Township 7S Range 24E Section 10 W.M.

4

3

RECEIVED

DEC 7 1983

WATER RESOURCES DEPT.
SALEM, OREGON

9

2620'

2150'

10

NAME Mud Reservoir County Wheeler

Application No. R-64718
Permit No. R10167

TOWNSHIP 7S, RANGE 24E, SECTION 10, W.M.

4

3

9

10

7001

23501

NAME MUD RES.

COUNTY WHEELER

Application No. R-64718

Permit No. R10167

RECEIVED

JAN 10 1983

WATER RESOURCES DEPT.
SALEM, OREGON