


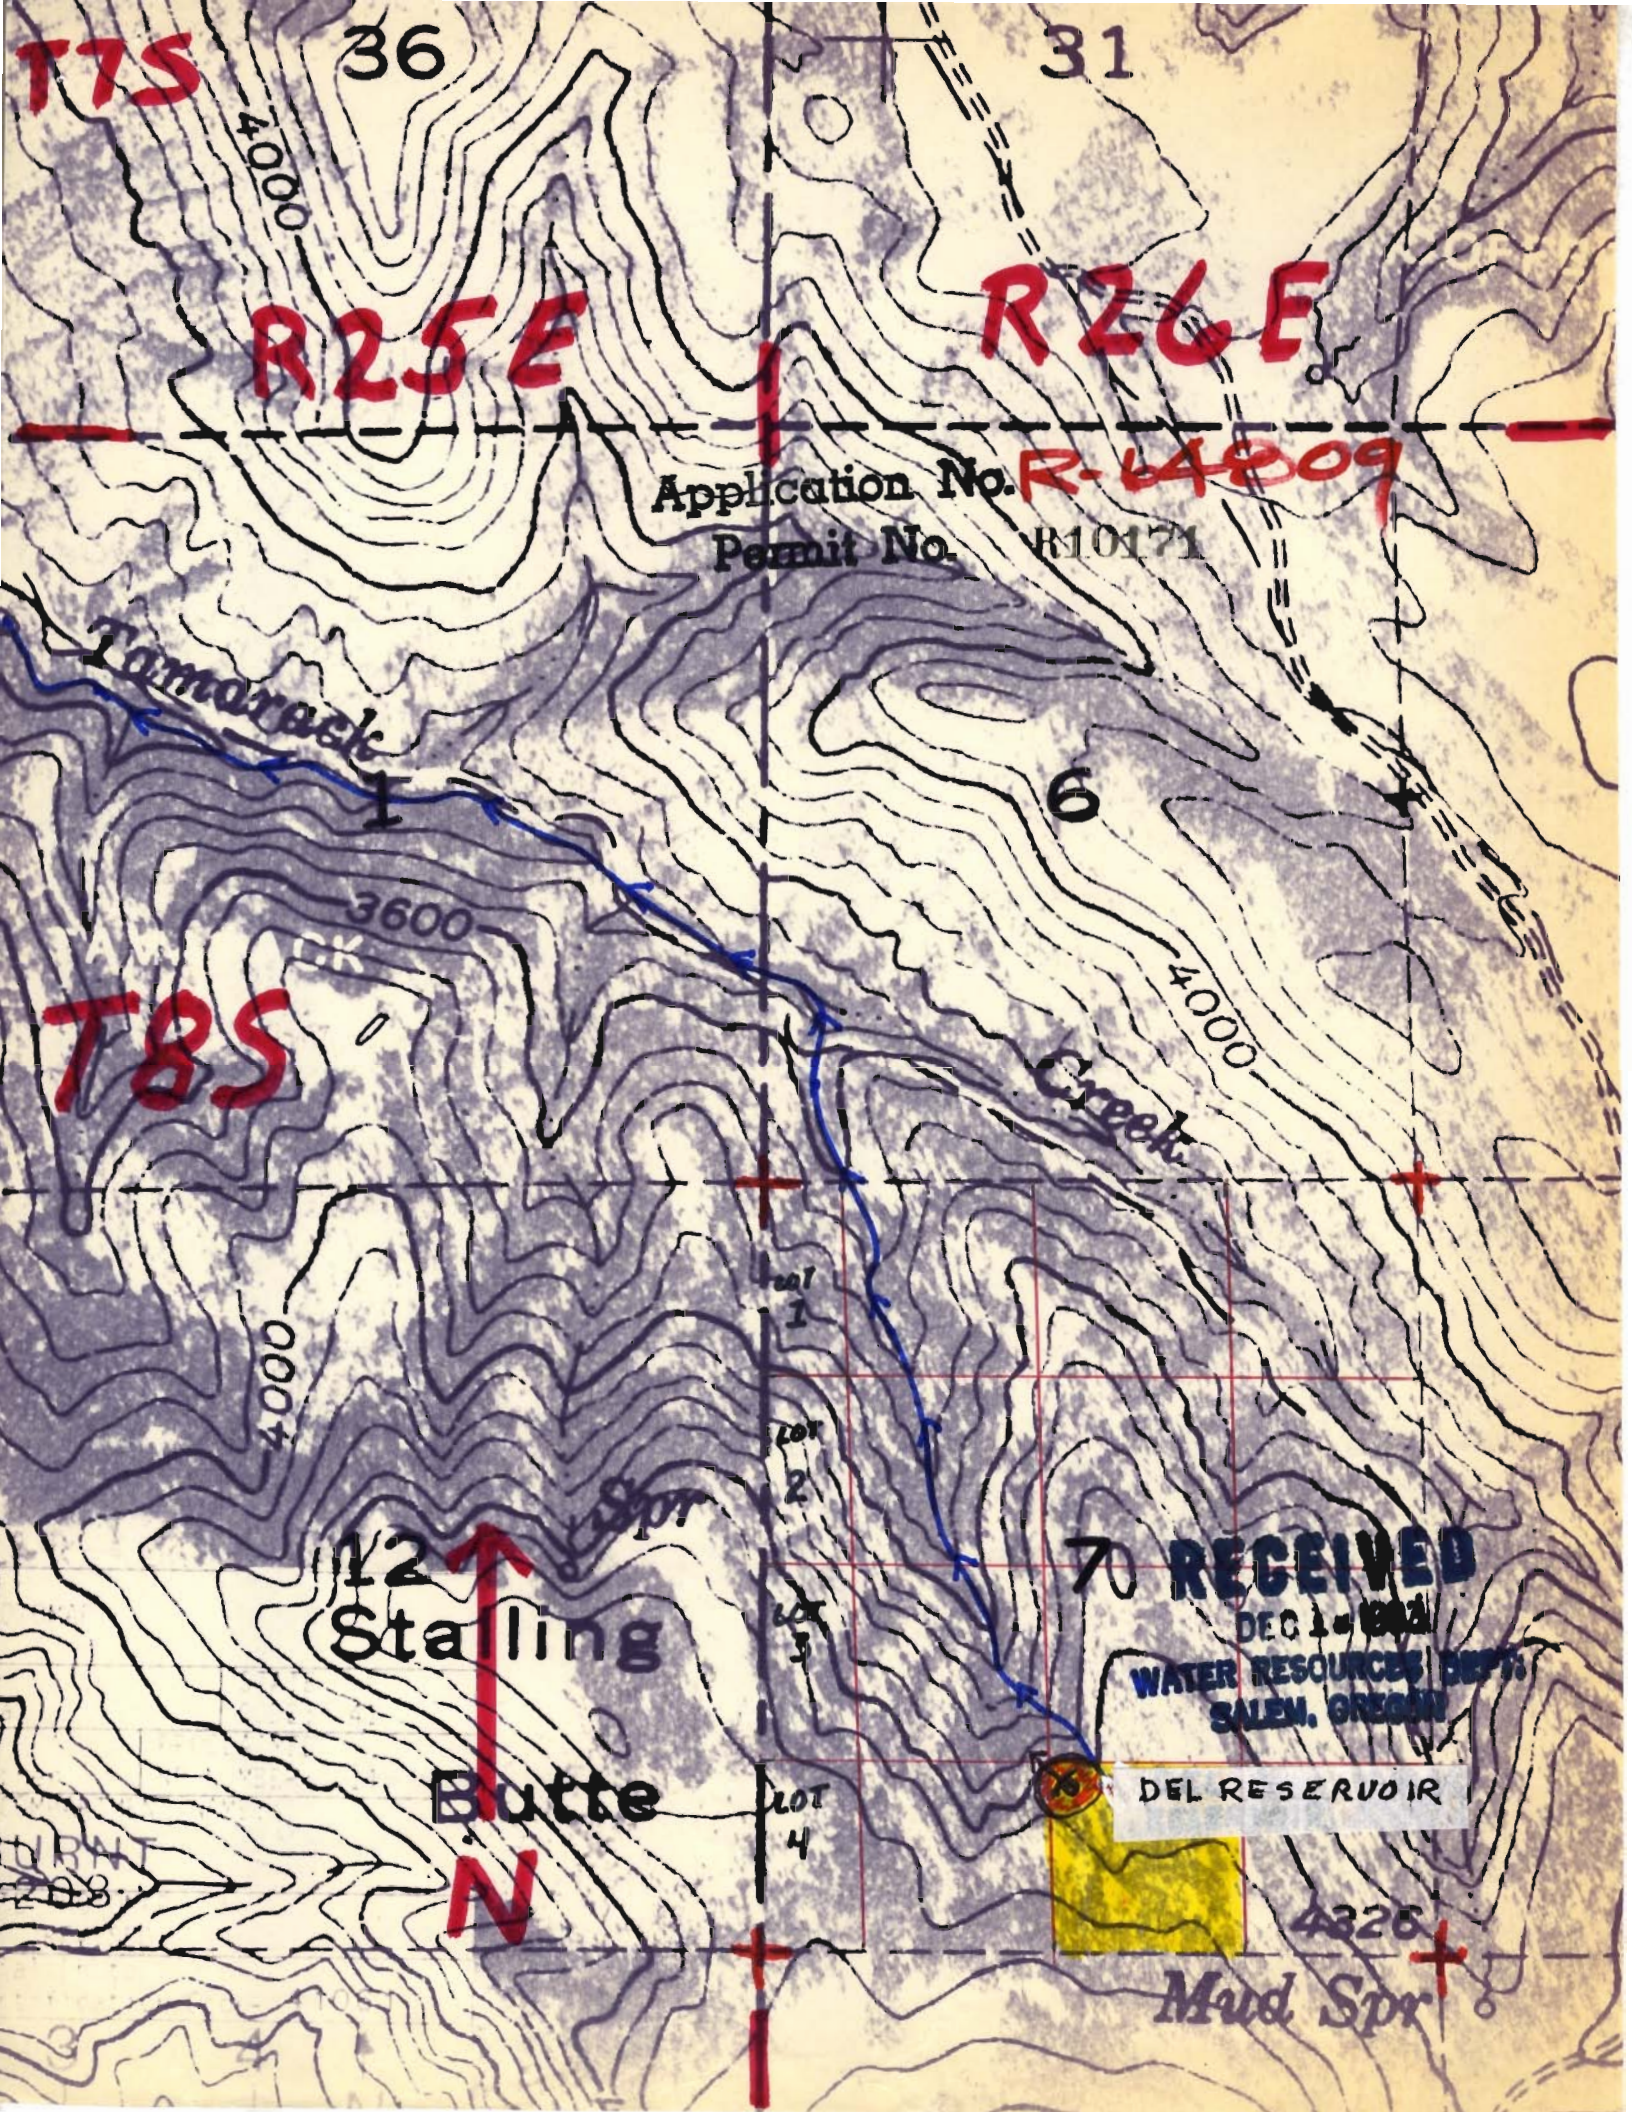

T7S

36

31

R25E

R26E

Application No.

R-64809

Permit No.

R10171

Tamarack

T8S

3600

6

4000

Creek

4000

lot 1

lot 2

lot 3

lot 4

12 Stalling

Butte

N

70 RECEIVED

DEC 1 1981

WATER RESOURCES DEPT.
SALEM, OREGON

DEL RESERVOIR

4326

Mud Spr

