


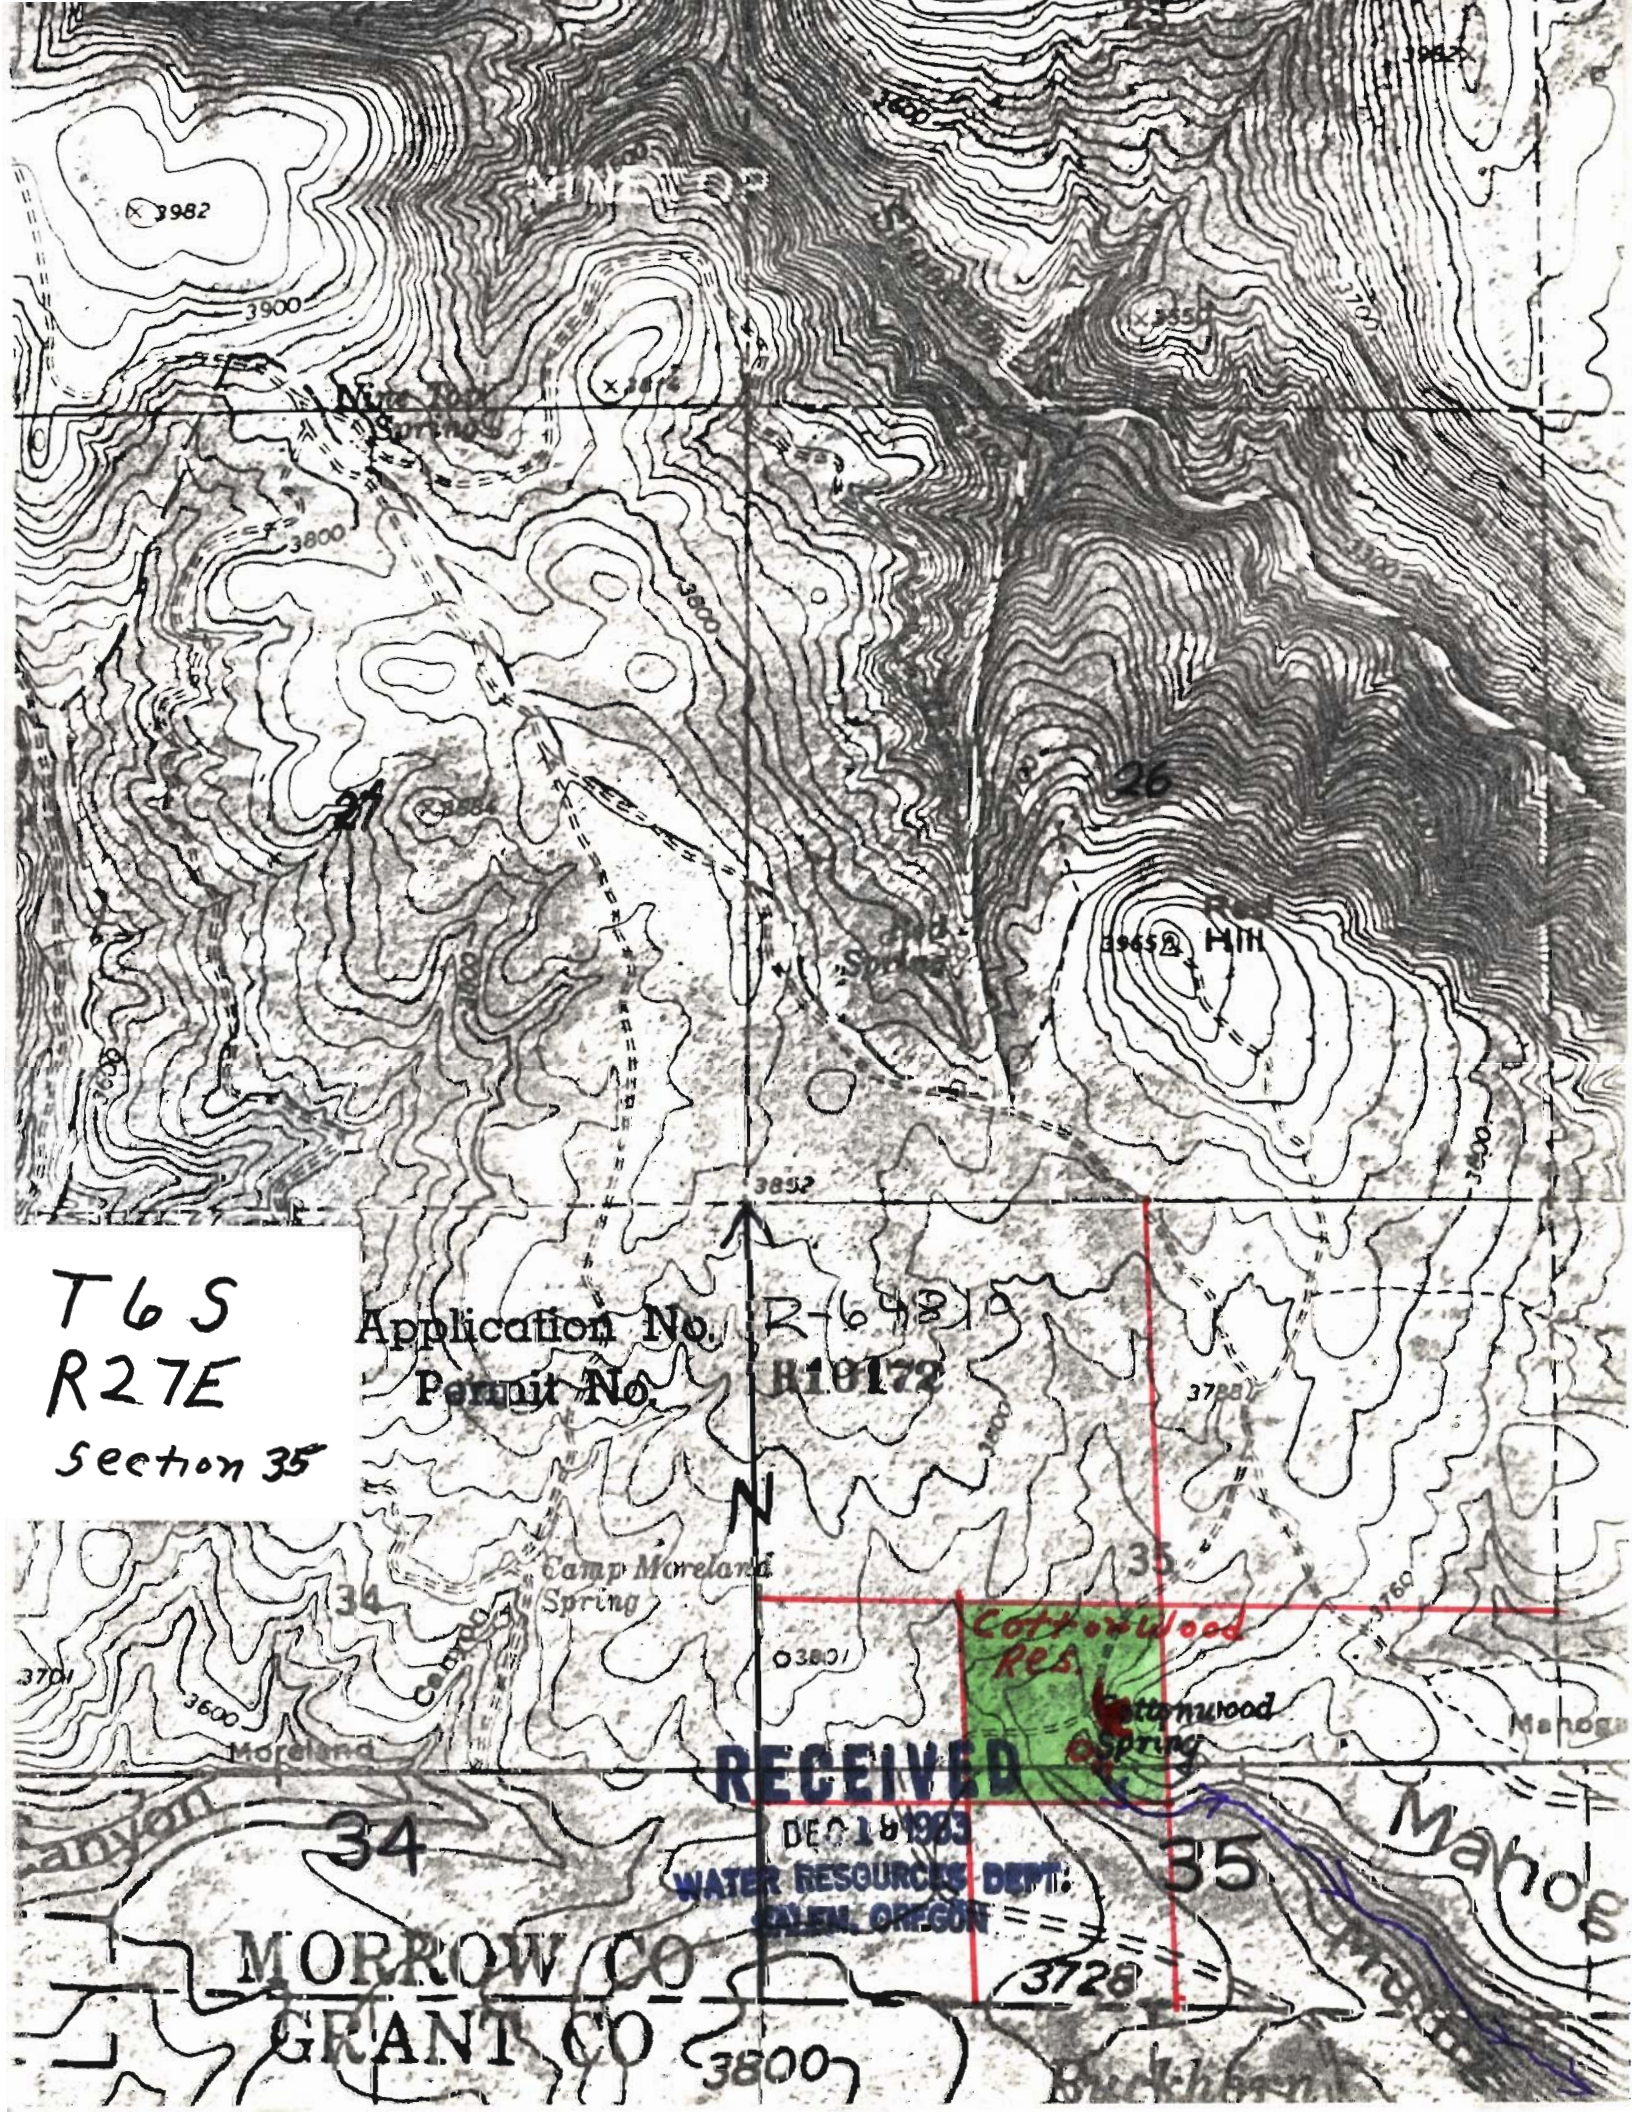

T6S
R27E
Section 35

Application No. R-648
Permit No. R10172

N

Camp Moreland
Spring

Cottonwood
Res.
Cottonwood
Spring

RECEIVED

DEC 18 1983

WATER RESOURCES DEPT.
ELEM. OREGON

MORROW CO
GRANT CO

Mahog

3728

3800

Buckhorn

RECEIVED


JAN 21 1983

WATER RESOURCES DEPT.
SALEM, OREGON.

T. 5 S.

T. 6 S.

T. 7 S.

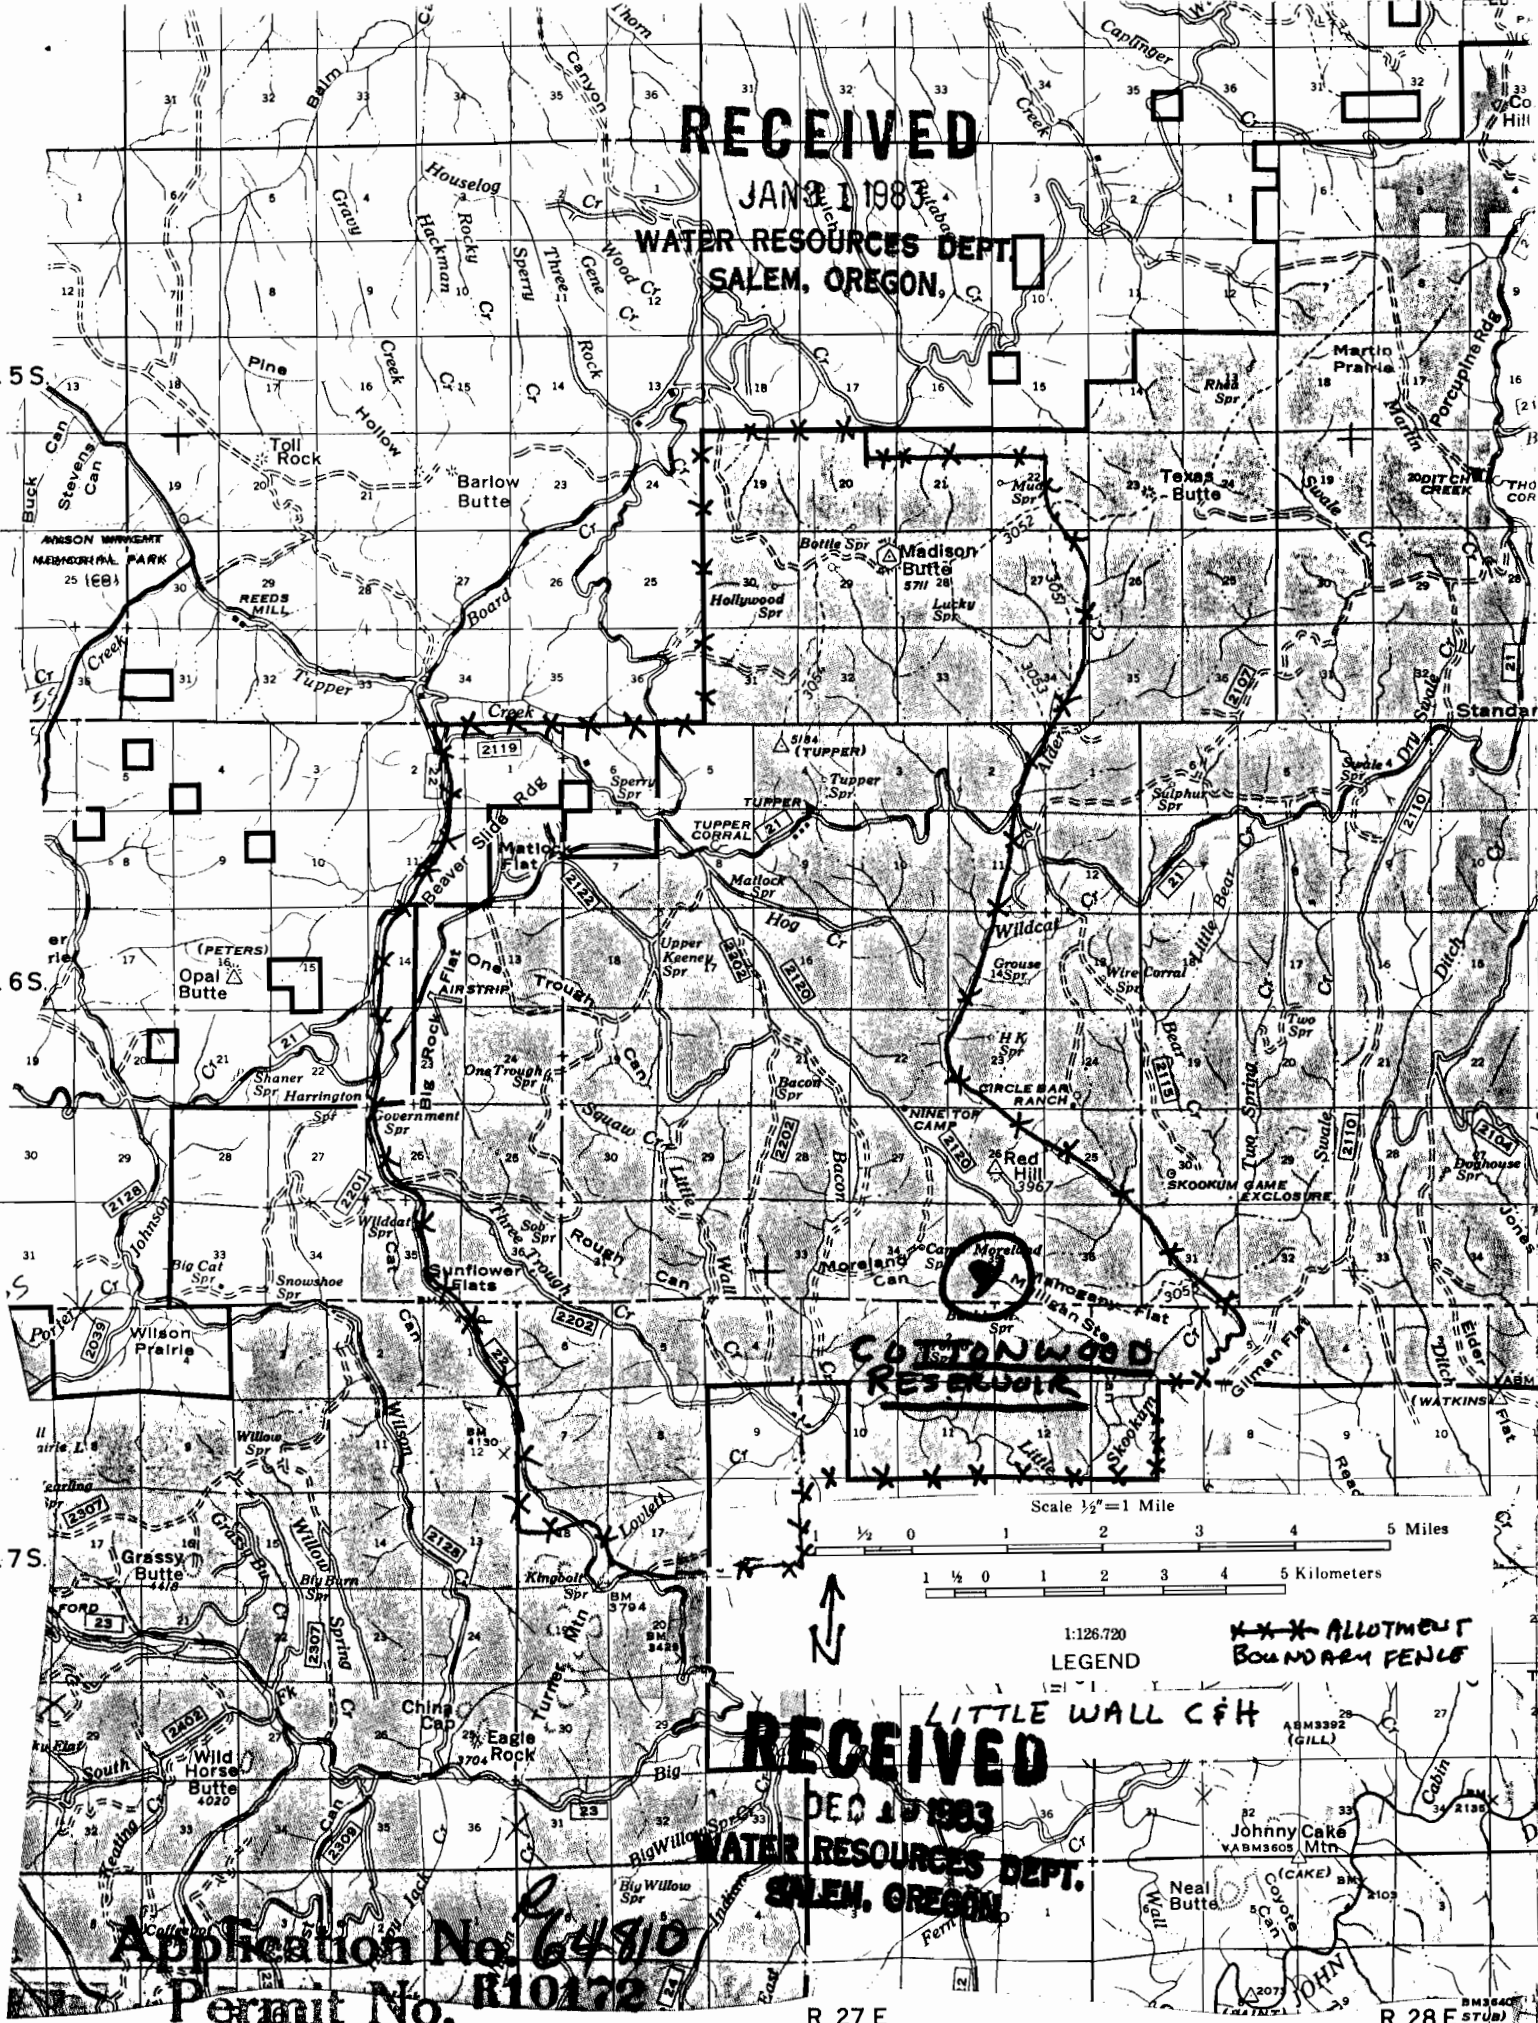

Application No. 64810

Permit No. R10172

R. 27 E.

R. 28 E.