


RECEIVED

JAN 31 1983

WATER RESOURCES DEPT.
SALEM, OREGON

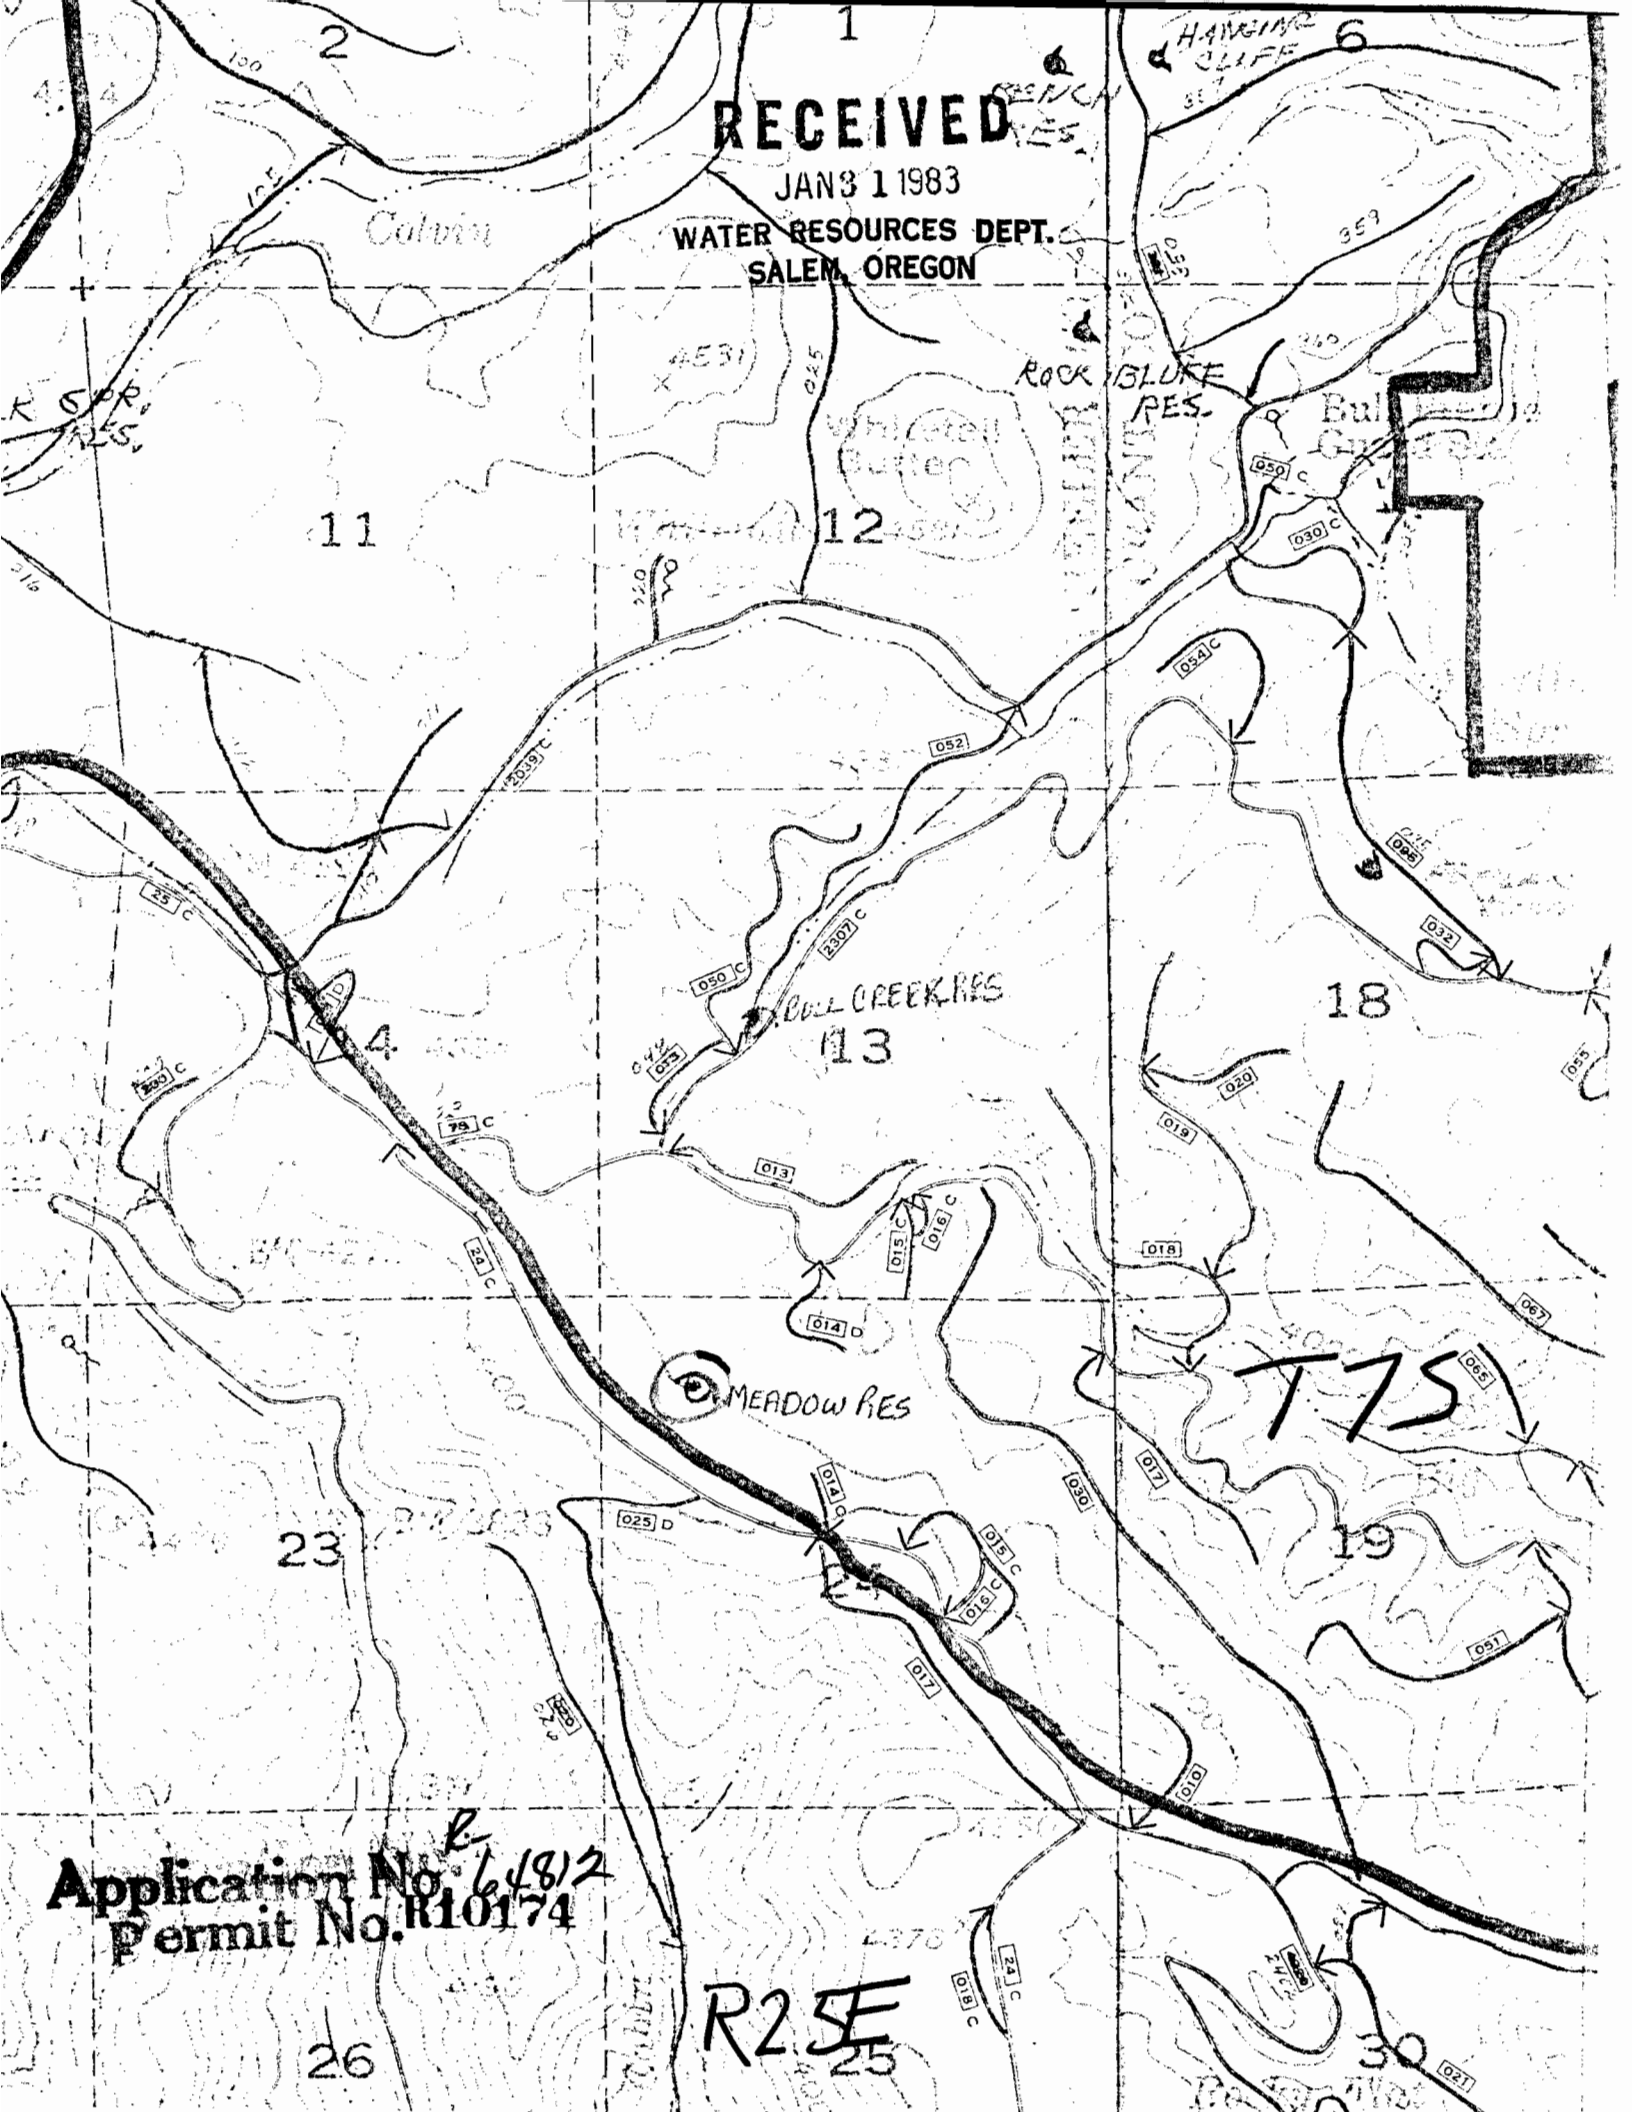

Application No. 64812
Permit No. R10174

R2 SE
25

TOWNSHIP 7S, RANGE 25E, SECTION 24, W.M.

RECEIVED

JAN 31 1983

WATER RESOURCES DEPT
SALEM, OREGON

14

13

879 FT SOUTH

1026 FT. EAST

23

24

NAME MEADOW RESERVOIR

COUNTY GRANT

Application No. 64812
Permit No. R10174