


RECEIVED

JAN 31 1983

WATER RESOURCES DEPT.
SALEM, OREGON

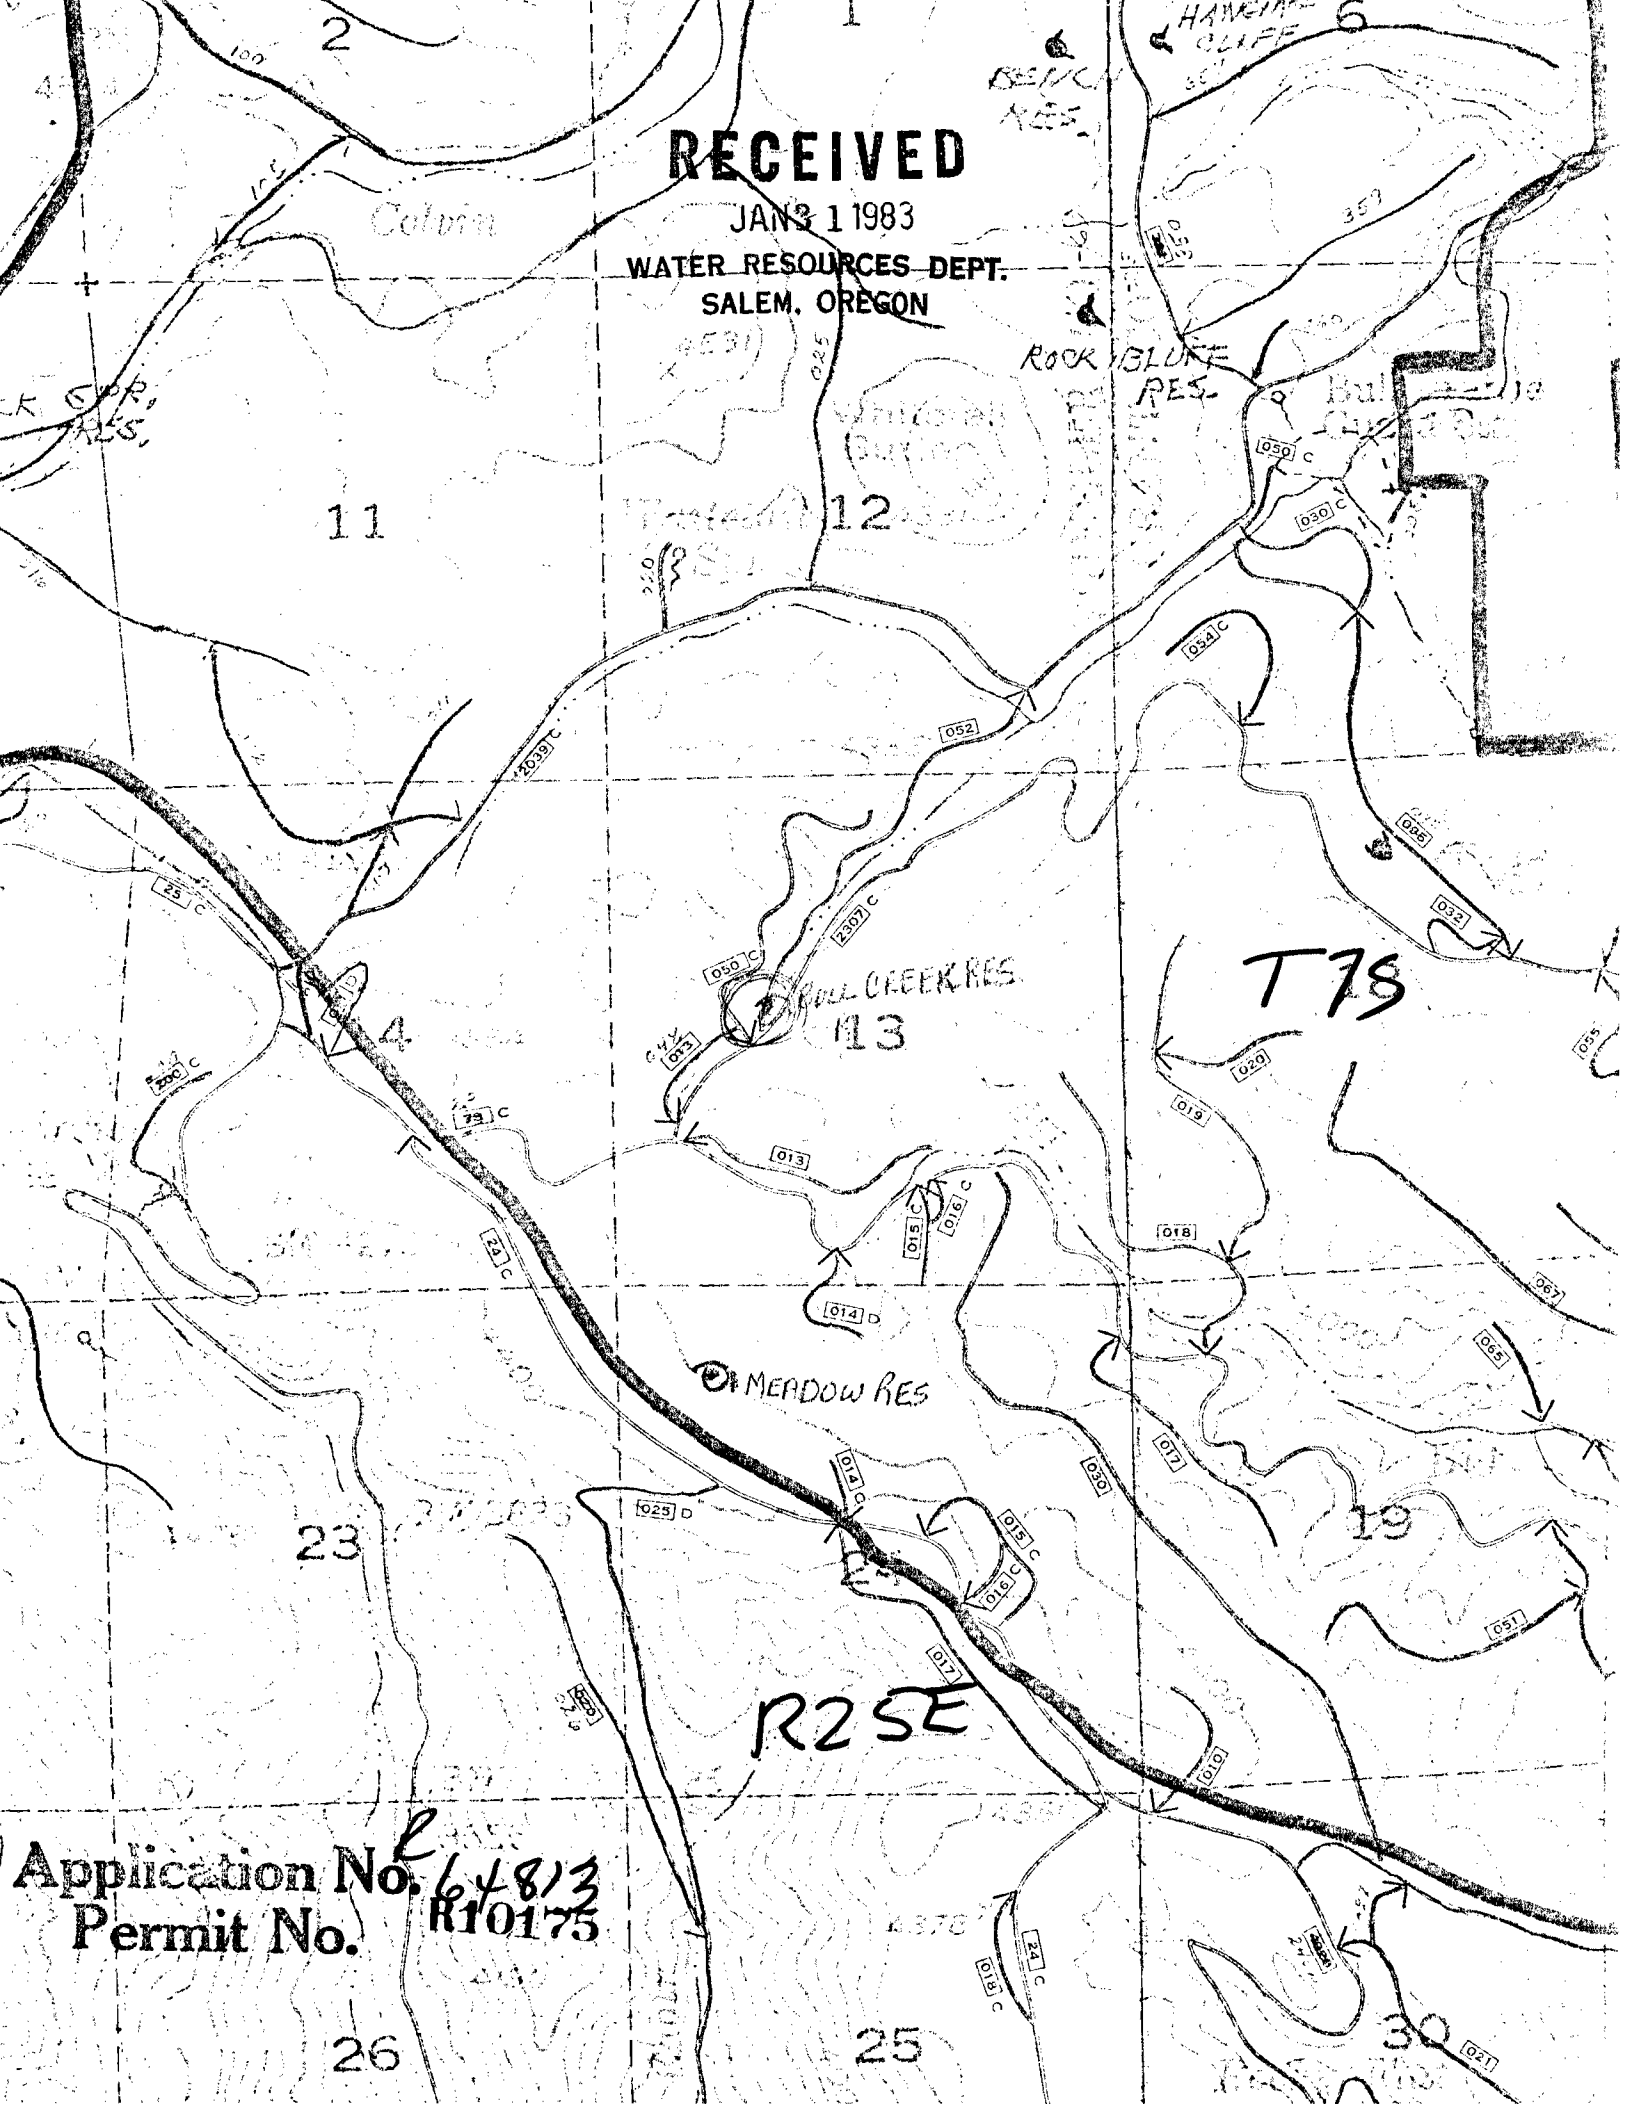

11

12

13

T78

R2SE

23

19

MEADOW RES

BULL CREEK RES

ROCK BLUFF RES.


HAWK CLIFF

Application No. 64813


26

25

30

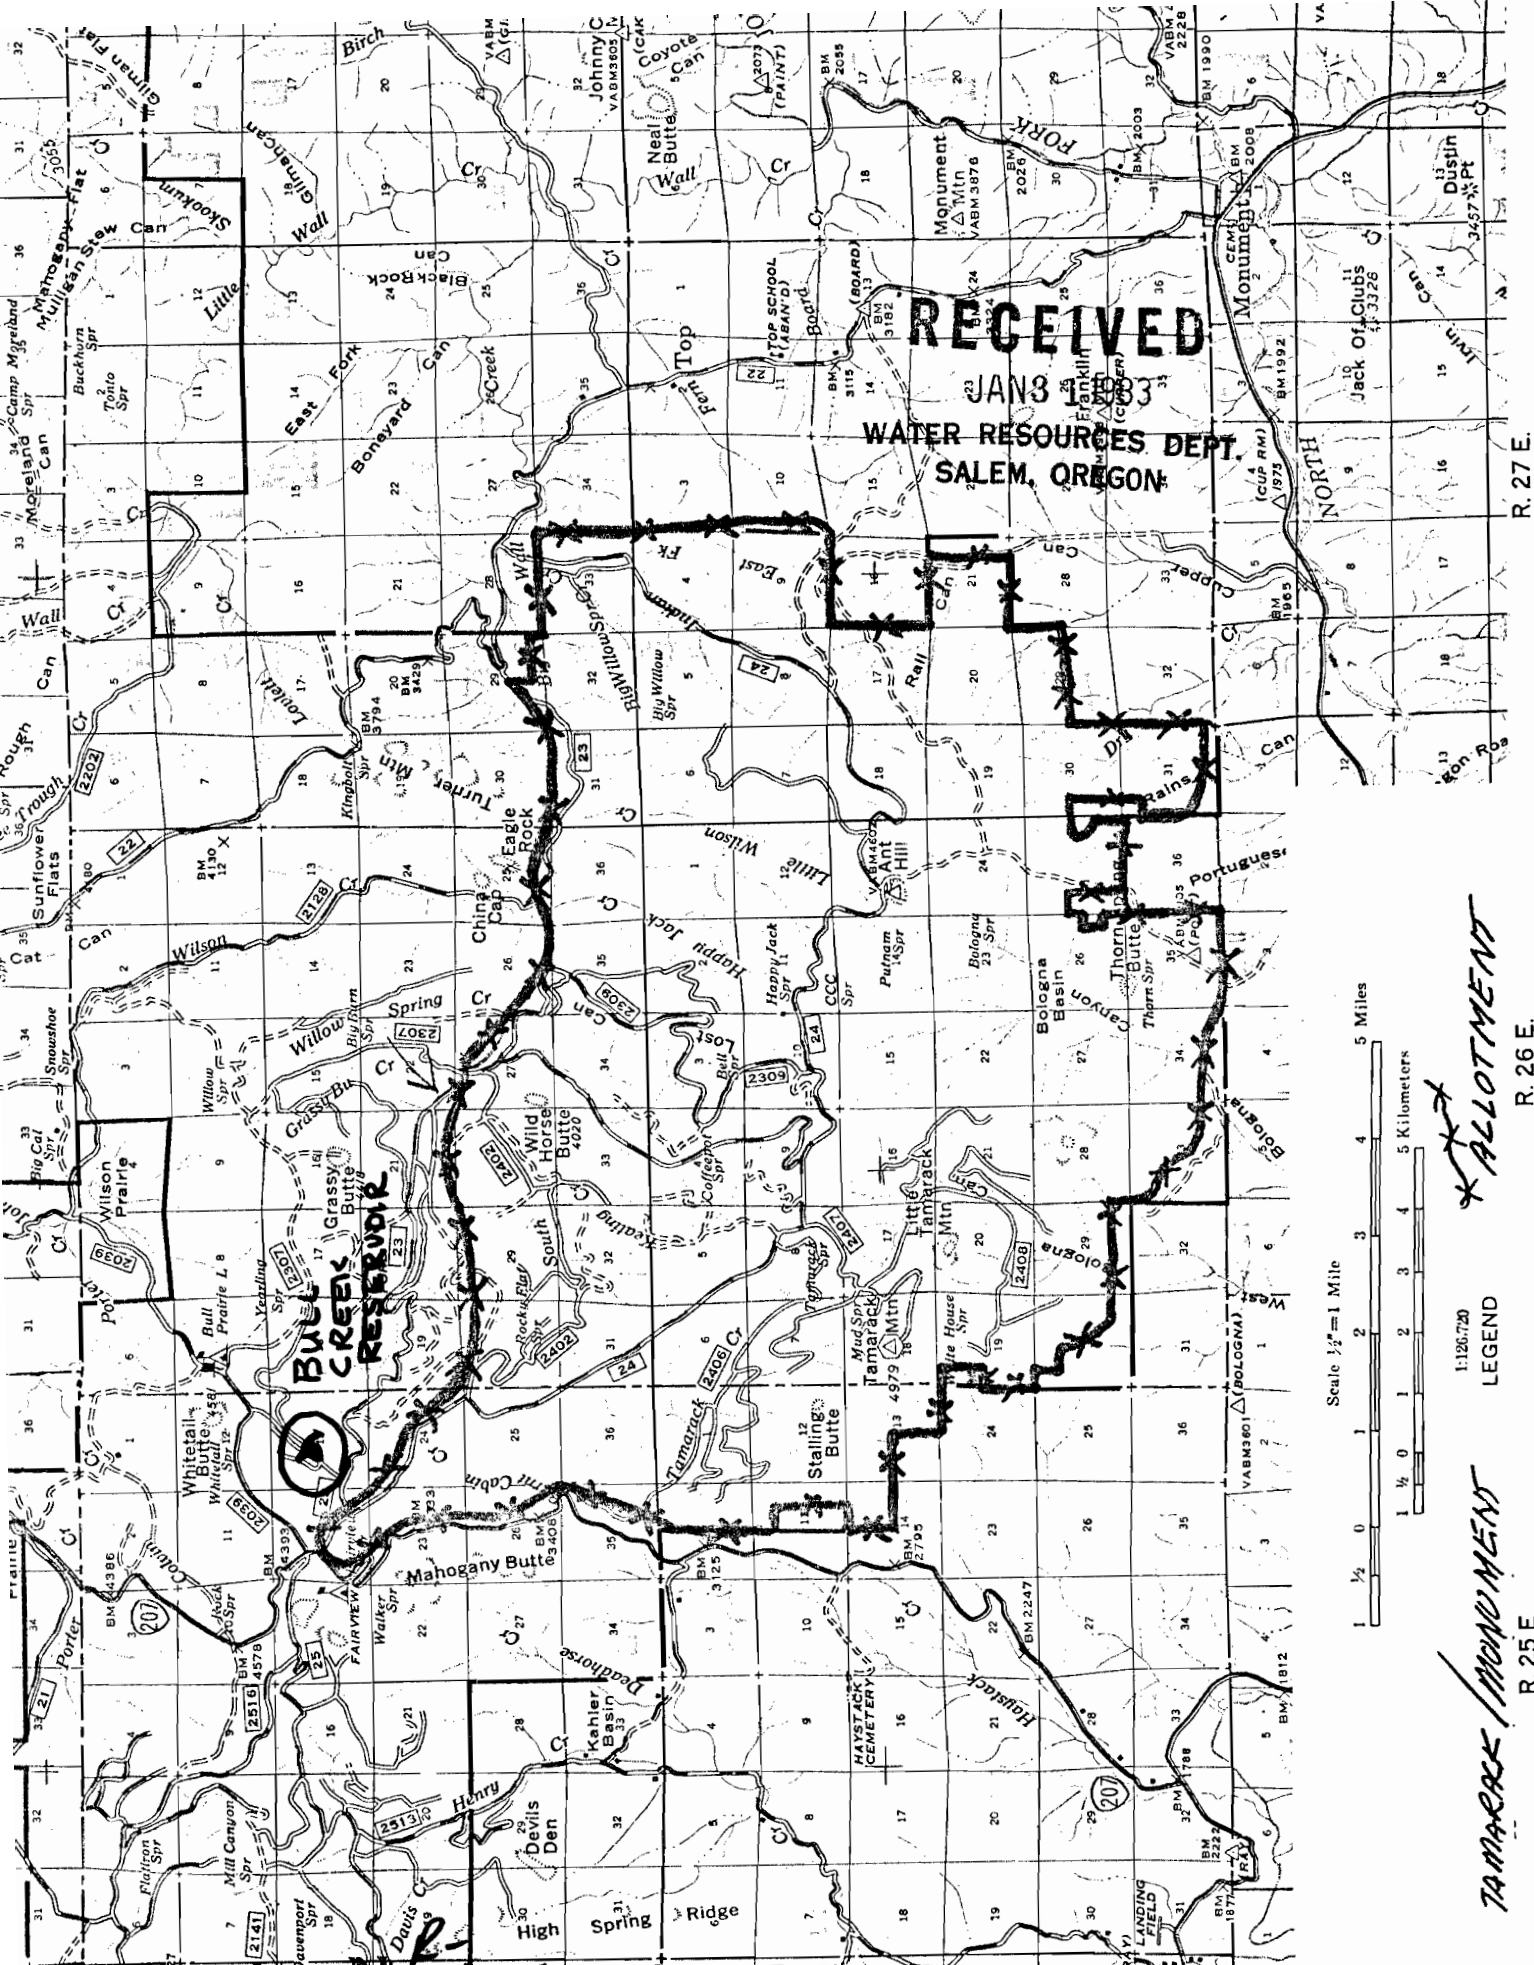

RECEIVED
JAN 3 1983
WATER RESOURCES DEPT.
SALEM, OREGON

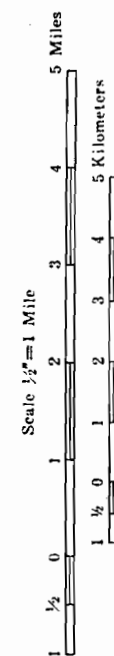

Application No. 64813
Permit No. R10175

T.95 TAMARACK MONUMENT R.25 E.
T.85 T.95
R.26 E.

TOWNSHIP 7S, RANGE 25E, SECTION 13, W.M.

RECEIVED

JAN 3 1 1983

WATER RESOURCES DEPT.
SALEM, OREGON

14

16 1/2 FT EAST

13

2930 FT. NORTH

23

24

NAME BULL CREEK RESERVOIR

COUNTY WHEELER

Application No. ^R64813
Form No. R10175