


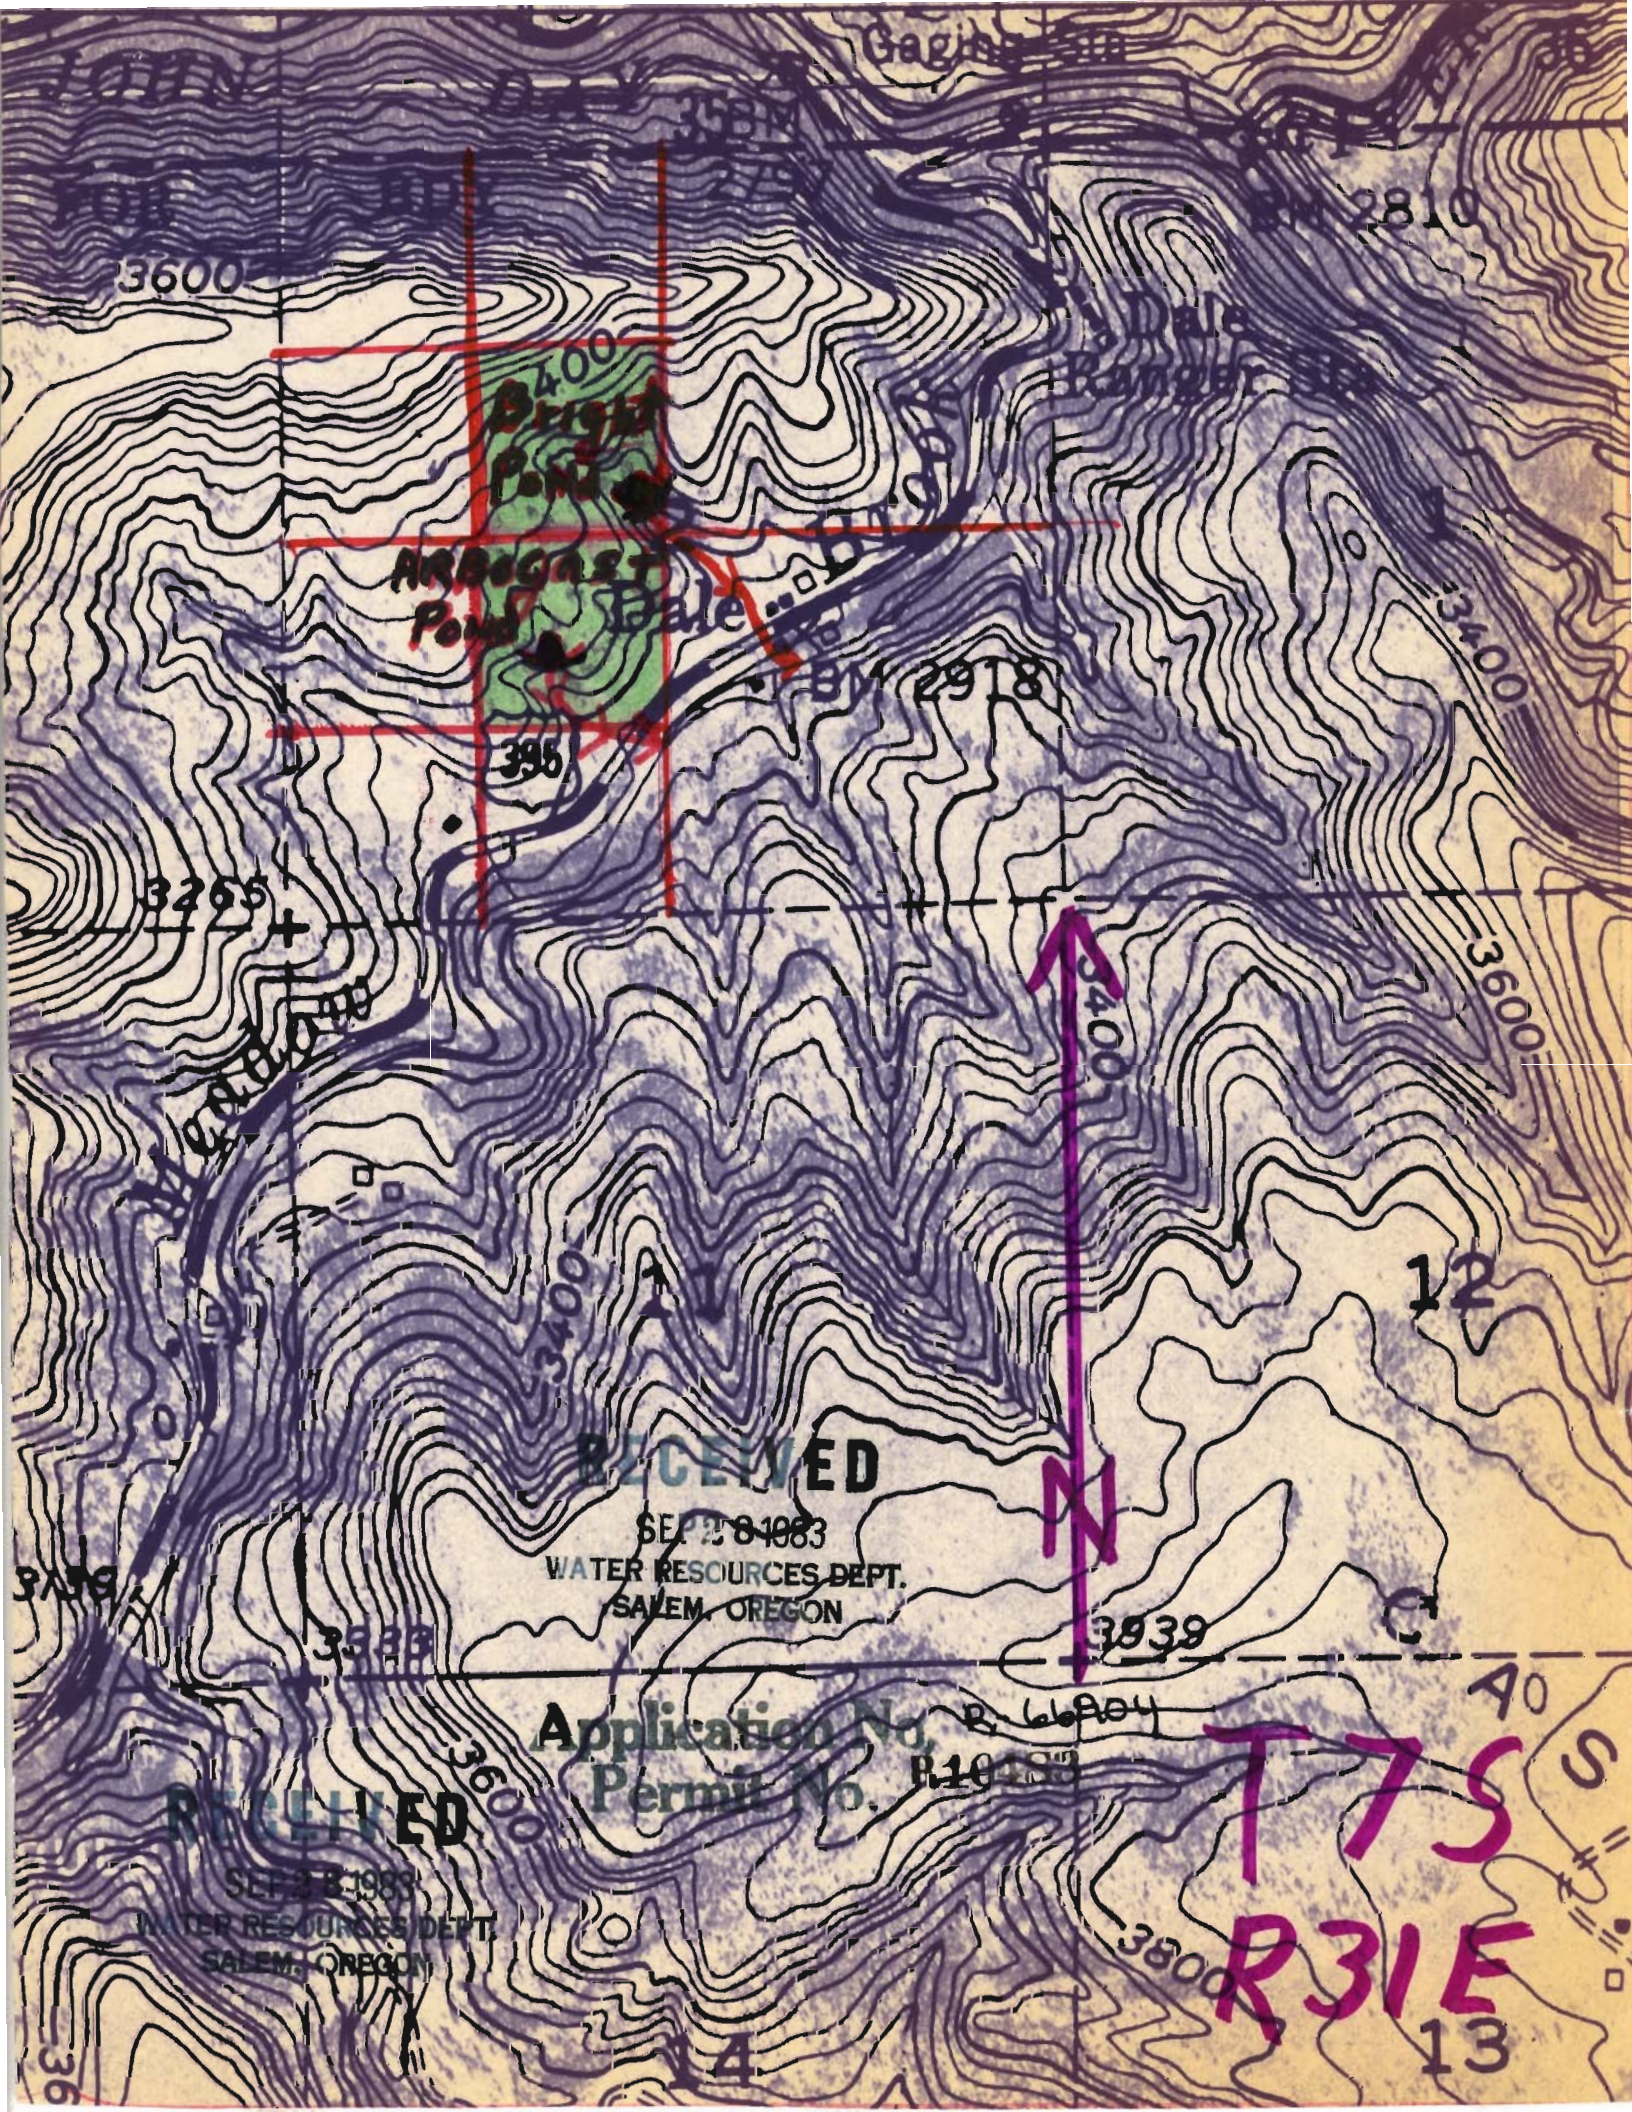

JOHN

DAY

Gage

3600

Bright Pond

Arbogast Pond

335

3265

3400









RECEIVED

SEP 28 1983

WATER RESOURCES DEPT.
SALEM, OREGON

Application No. R 66804

Permit No. R10183

RECEIVED

SEP 28 1983

WATER RESOURCES DEPT.
SALEM, OREGON

N

T7S

R31E

13