


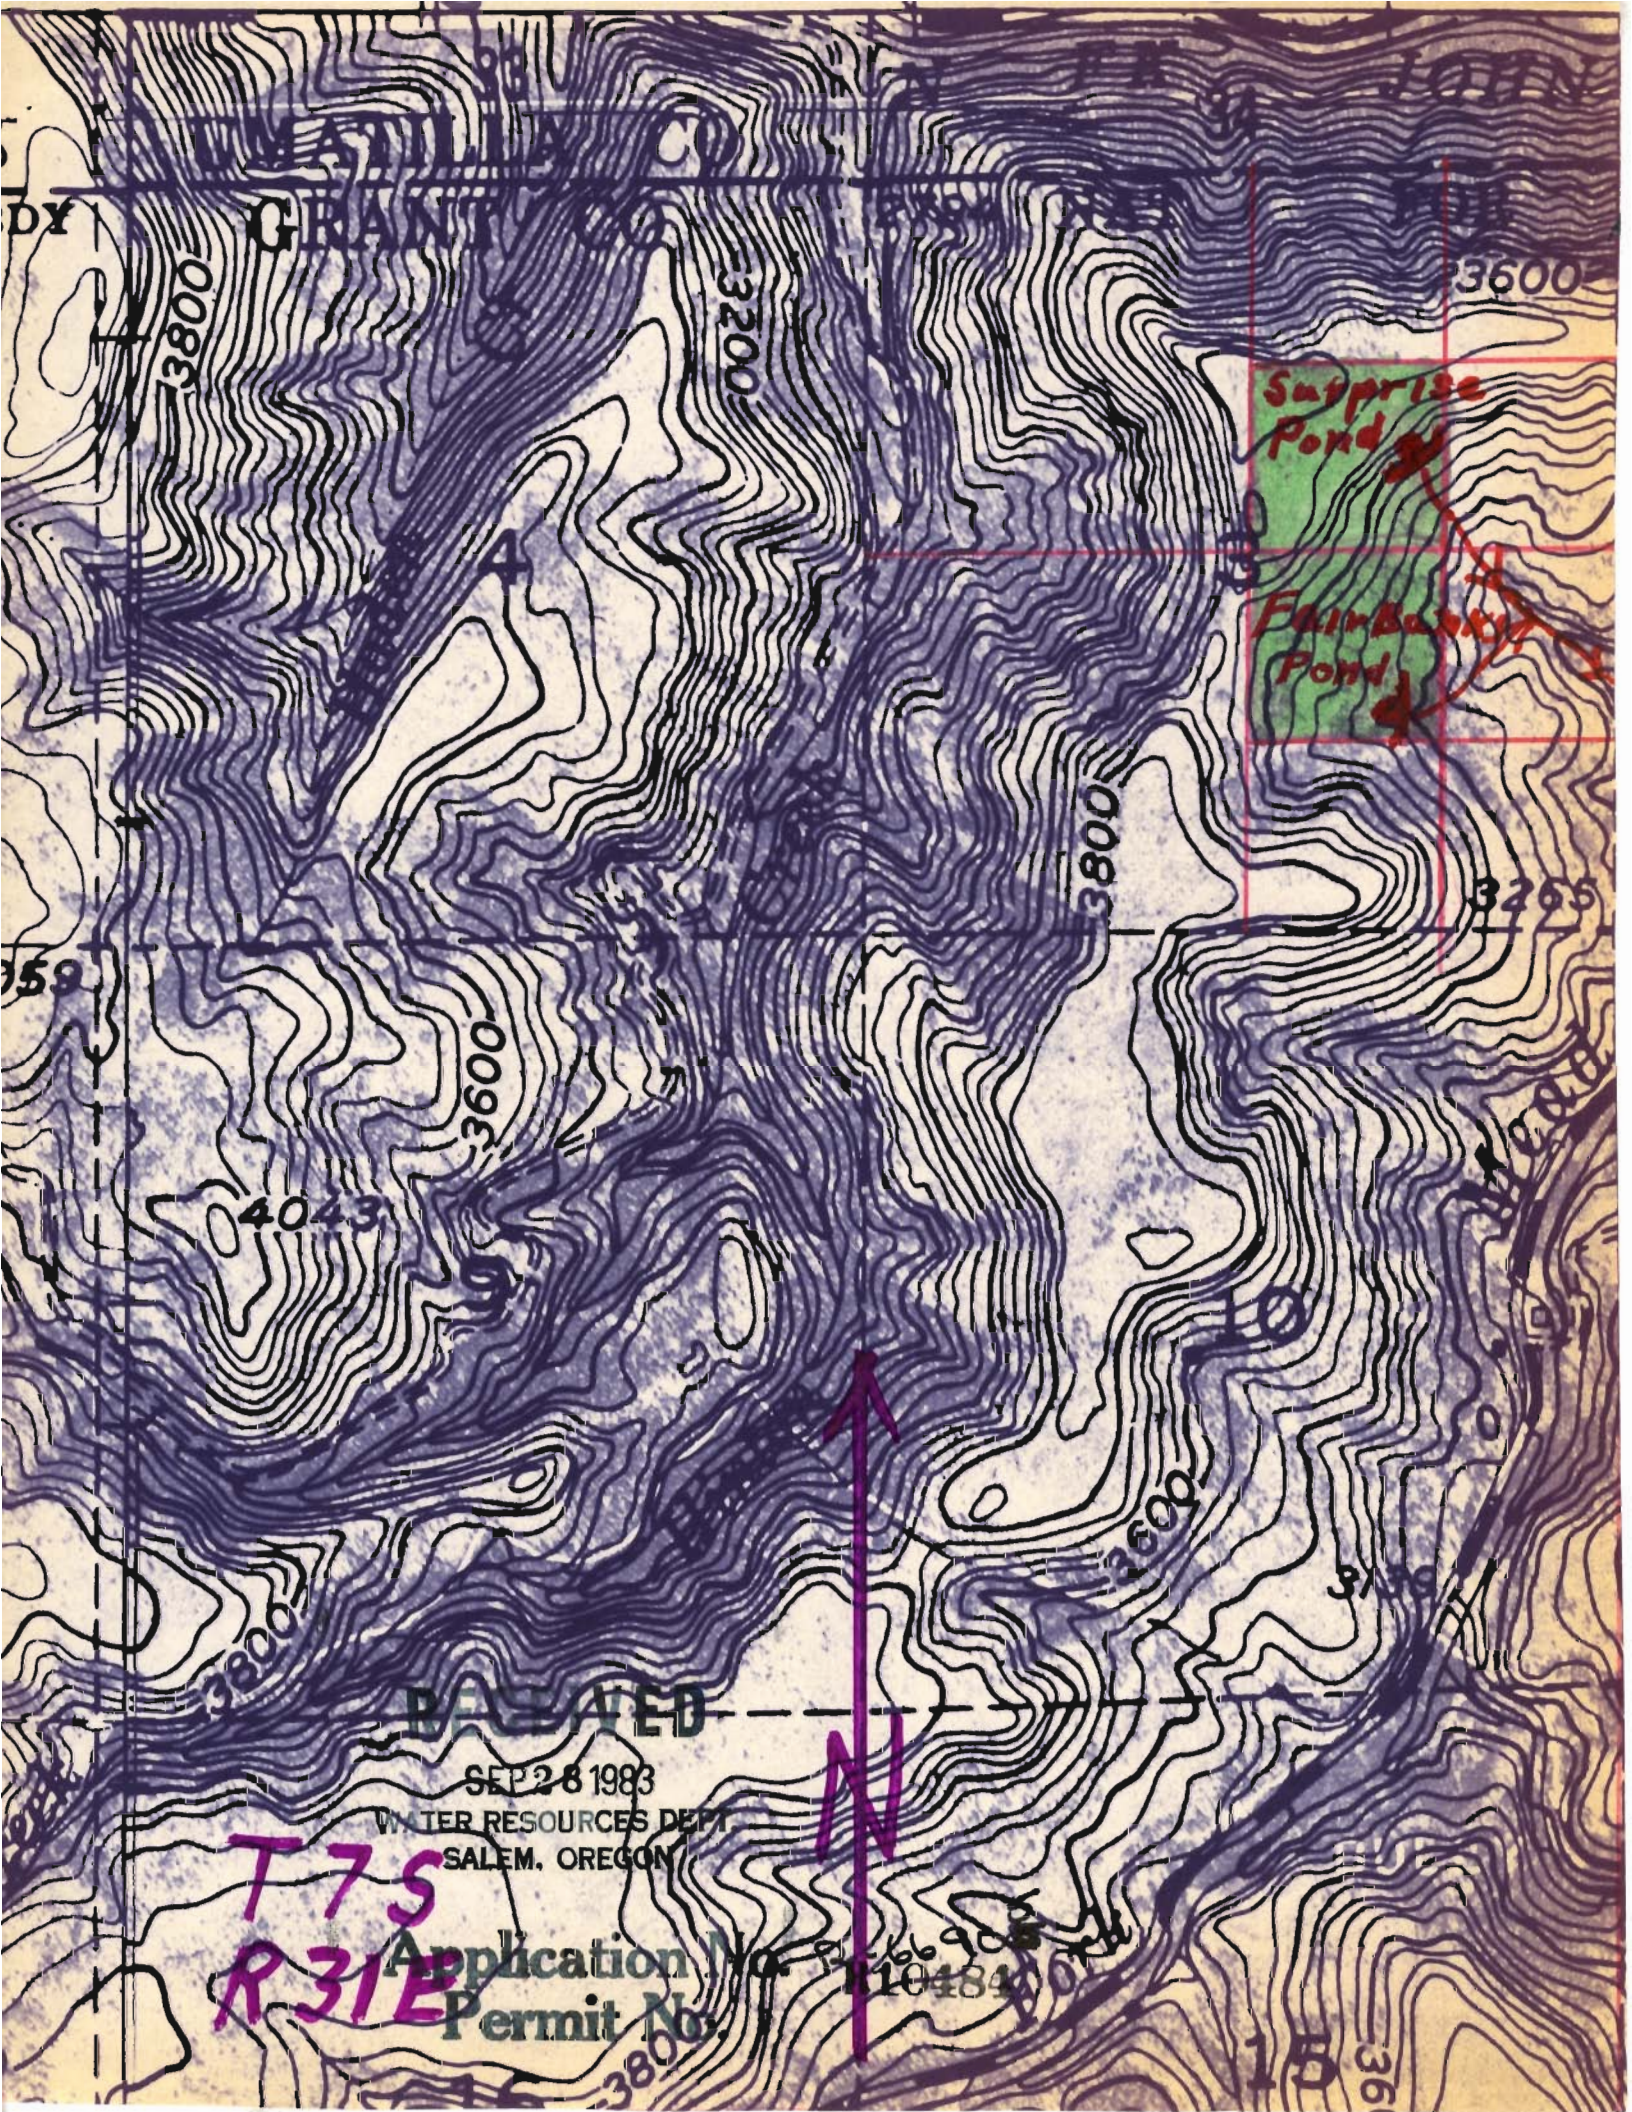

3800

3200

3600

Surprise Pond

Fairbank Pond

3800

3265

3600

4043

3800

3600

3400

RECEIVED

SEP 28 1983

WATER RESOURCES DEPT
SALEM, OREGON

T7S
R31E

Application No. 92-66908-1
Permit No. 104840

N

3600