


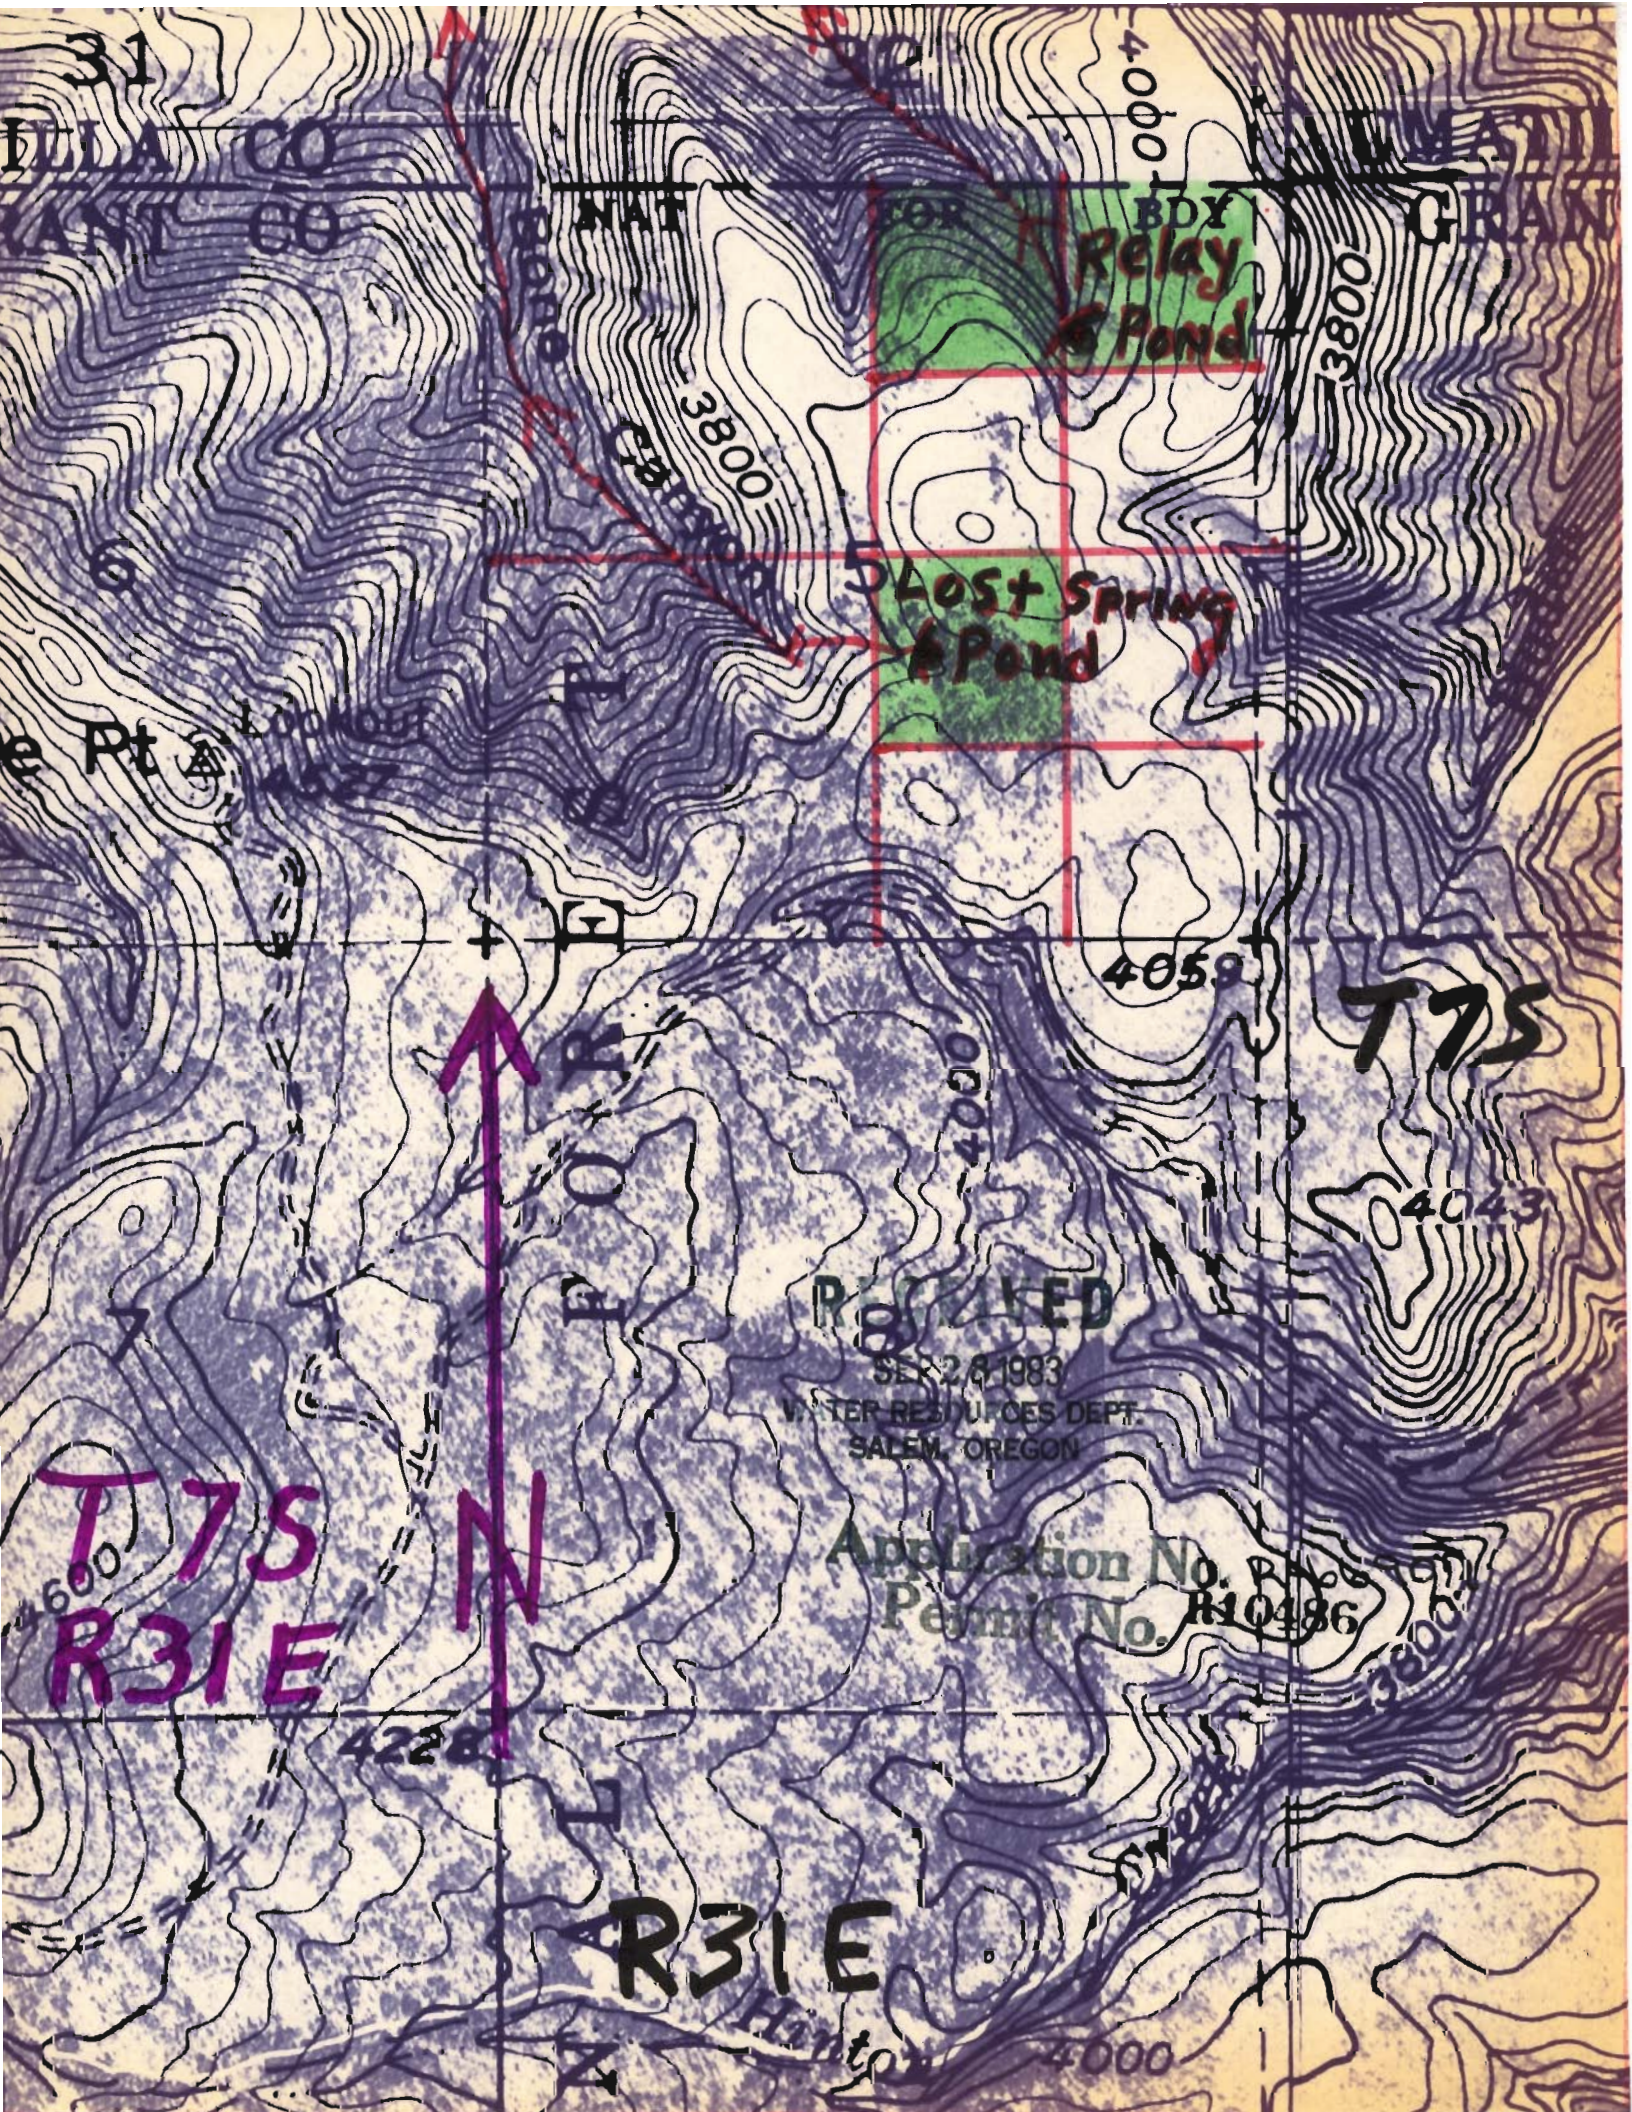

31
DELA CO
KANT CO

NAT

FOR

BDY

W MATTL
GRAN

Relay
Pond

Lost Spring
Pond

e Pt

T75

RECEIVED

SEP 28 1983

WATER RESOURCES DEPT.
SALEM, OREGON

Permit No. R410486

T75
R31E

N

R31E

Hinton