


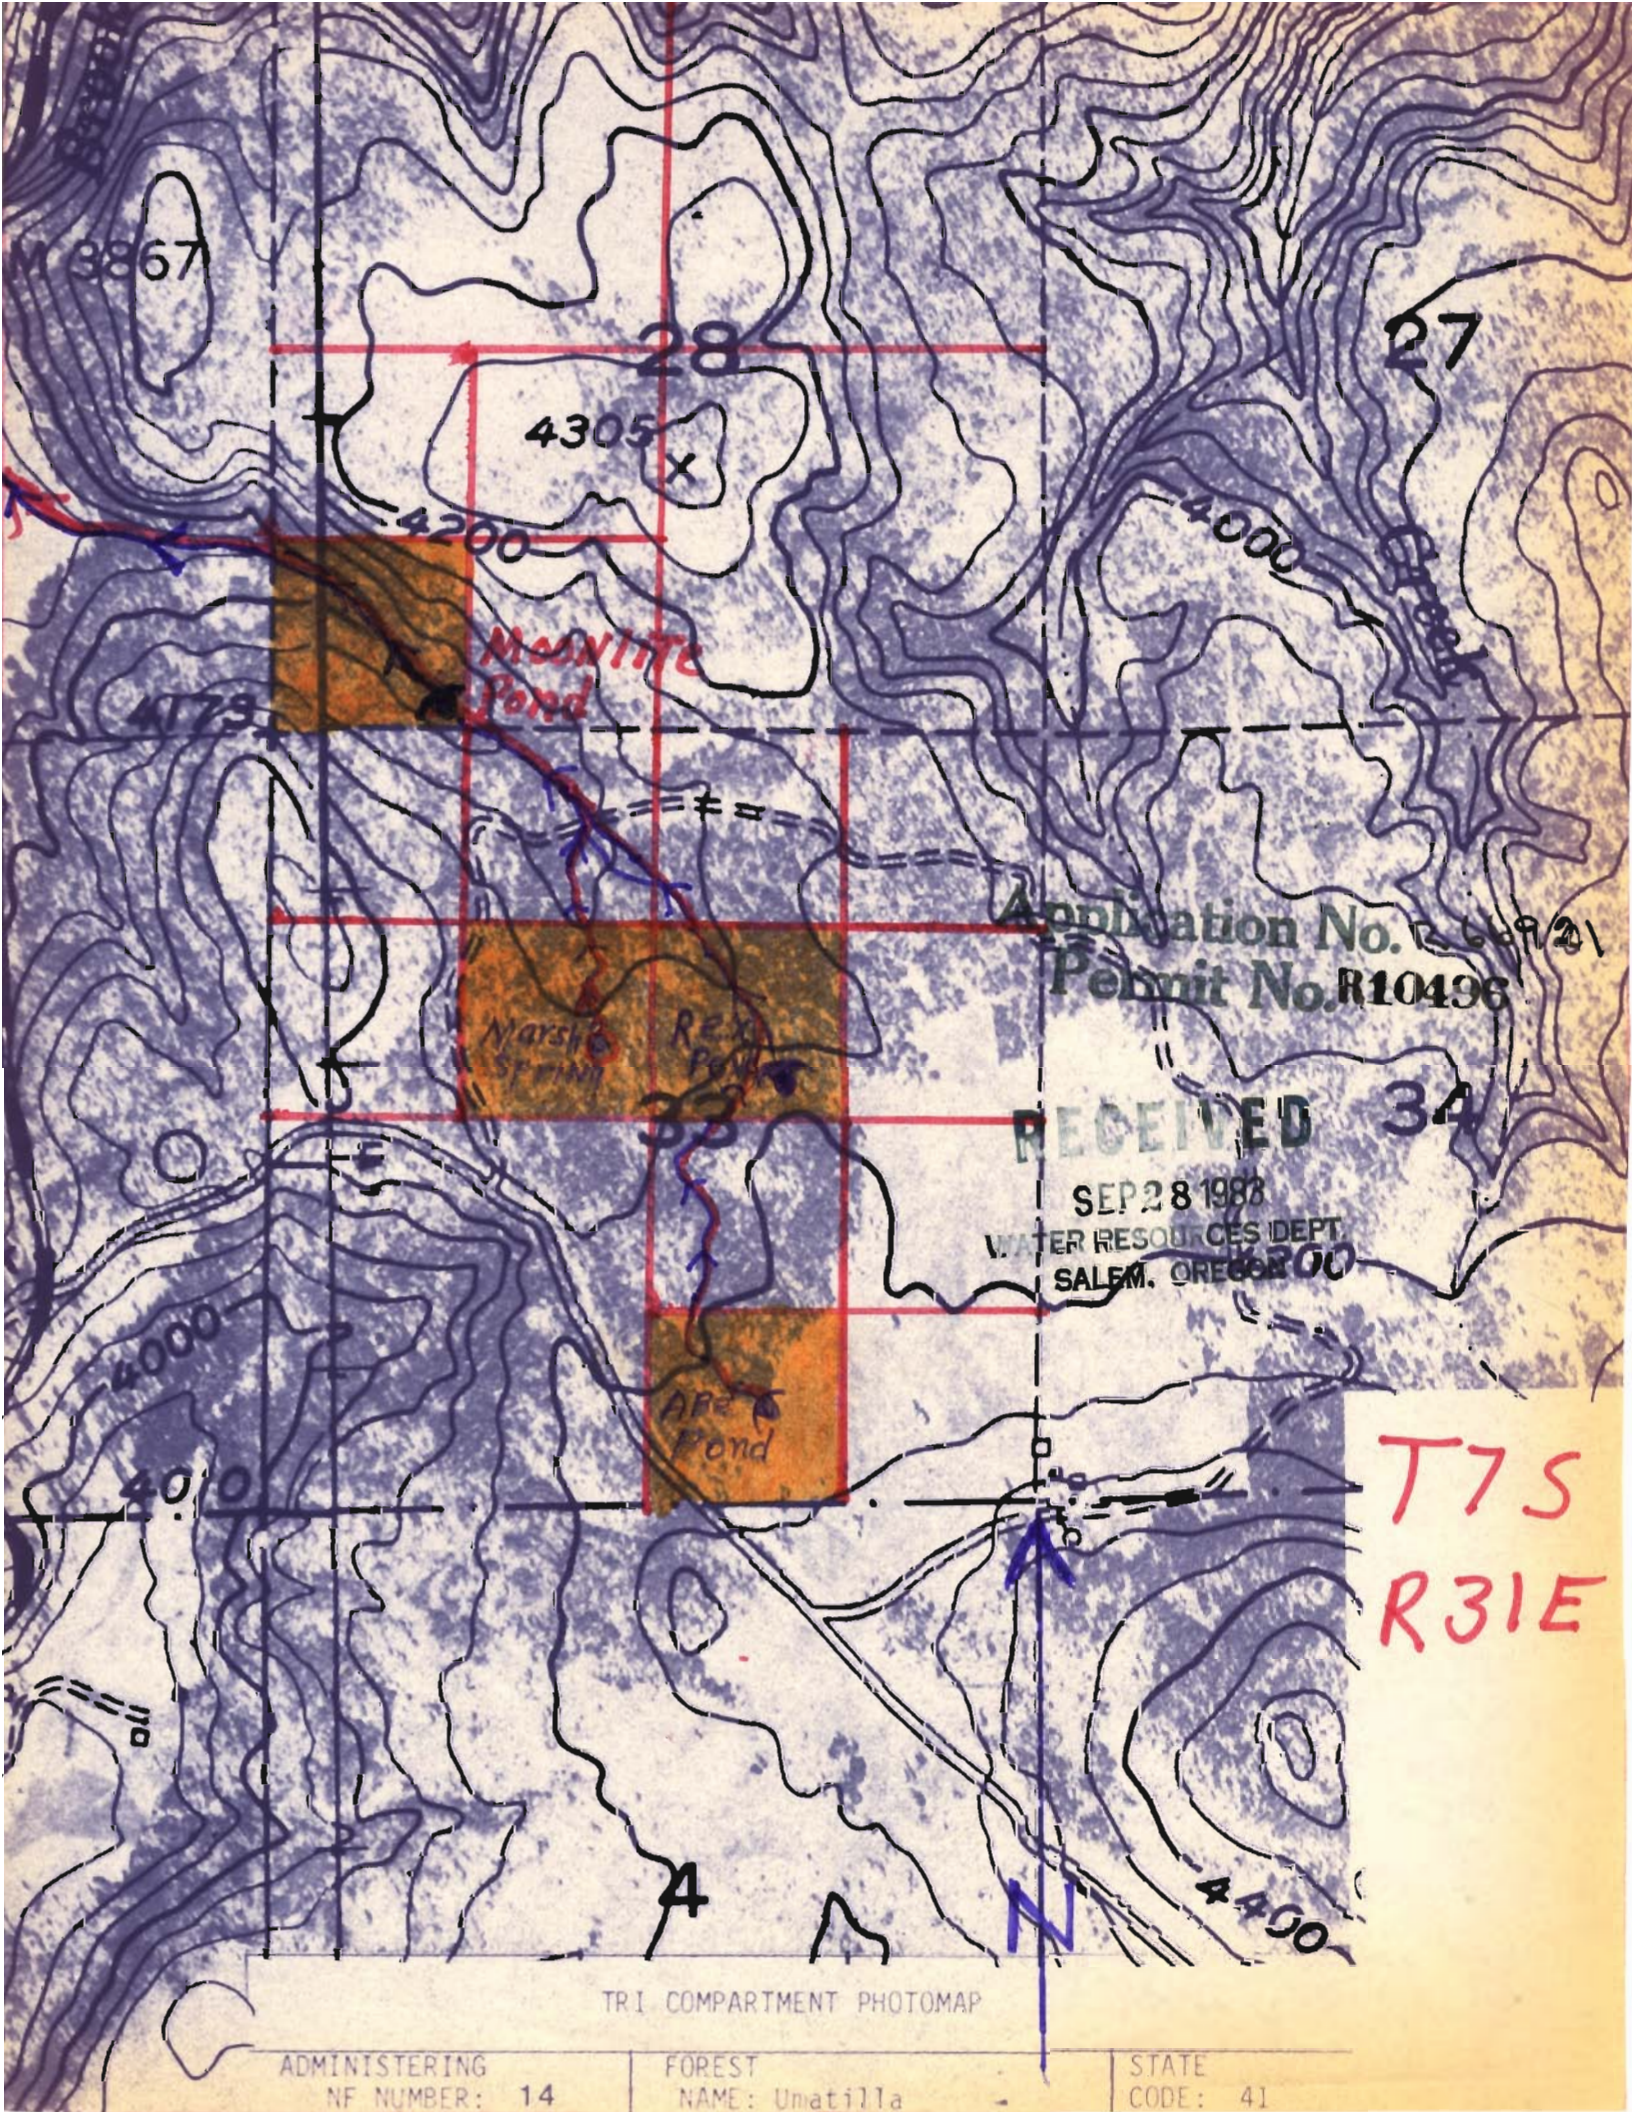

3867

28

27

4305

x

4200

4000

Creek

MOONLITE
Pond

4775

Application No. R 64921
Permit No. R10496

NARSIE
SPRING

REX
Pond

RECEIVED

34

SEP 28 1988

WATER RESOURCES DEPT
SALEM, OREGON

4000

4000

ARE
Pond

T7S
R31E

4

N

4400

TRI COMPARTMENT PHOTOMAP

ADMINISTERING
NF NUMBER: 14

FOREST
NAME: Umatilla

STATE
CODE: 41