

Application No. R-68655
Permit No. R106112

N A L F O R E S

Chance Pond

T15

Scale ↑
4" = 1 Mi N

R36E

RECEIVED


JAN 1 1986


WATER RESOURCES DEPT
SALEM, OREGON

33

Pack Rat
Spring

34

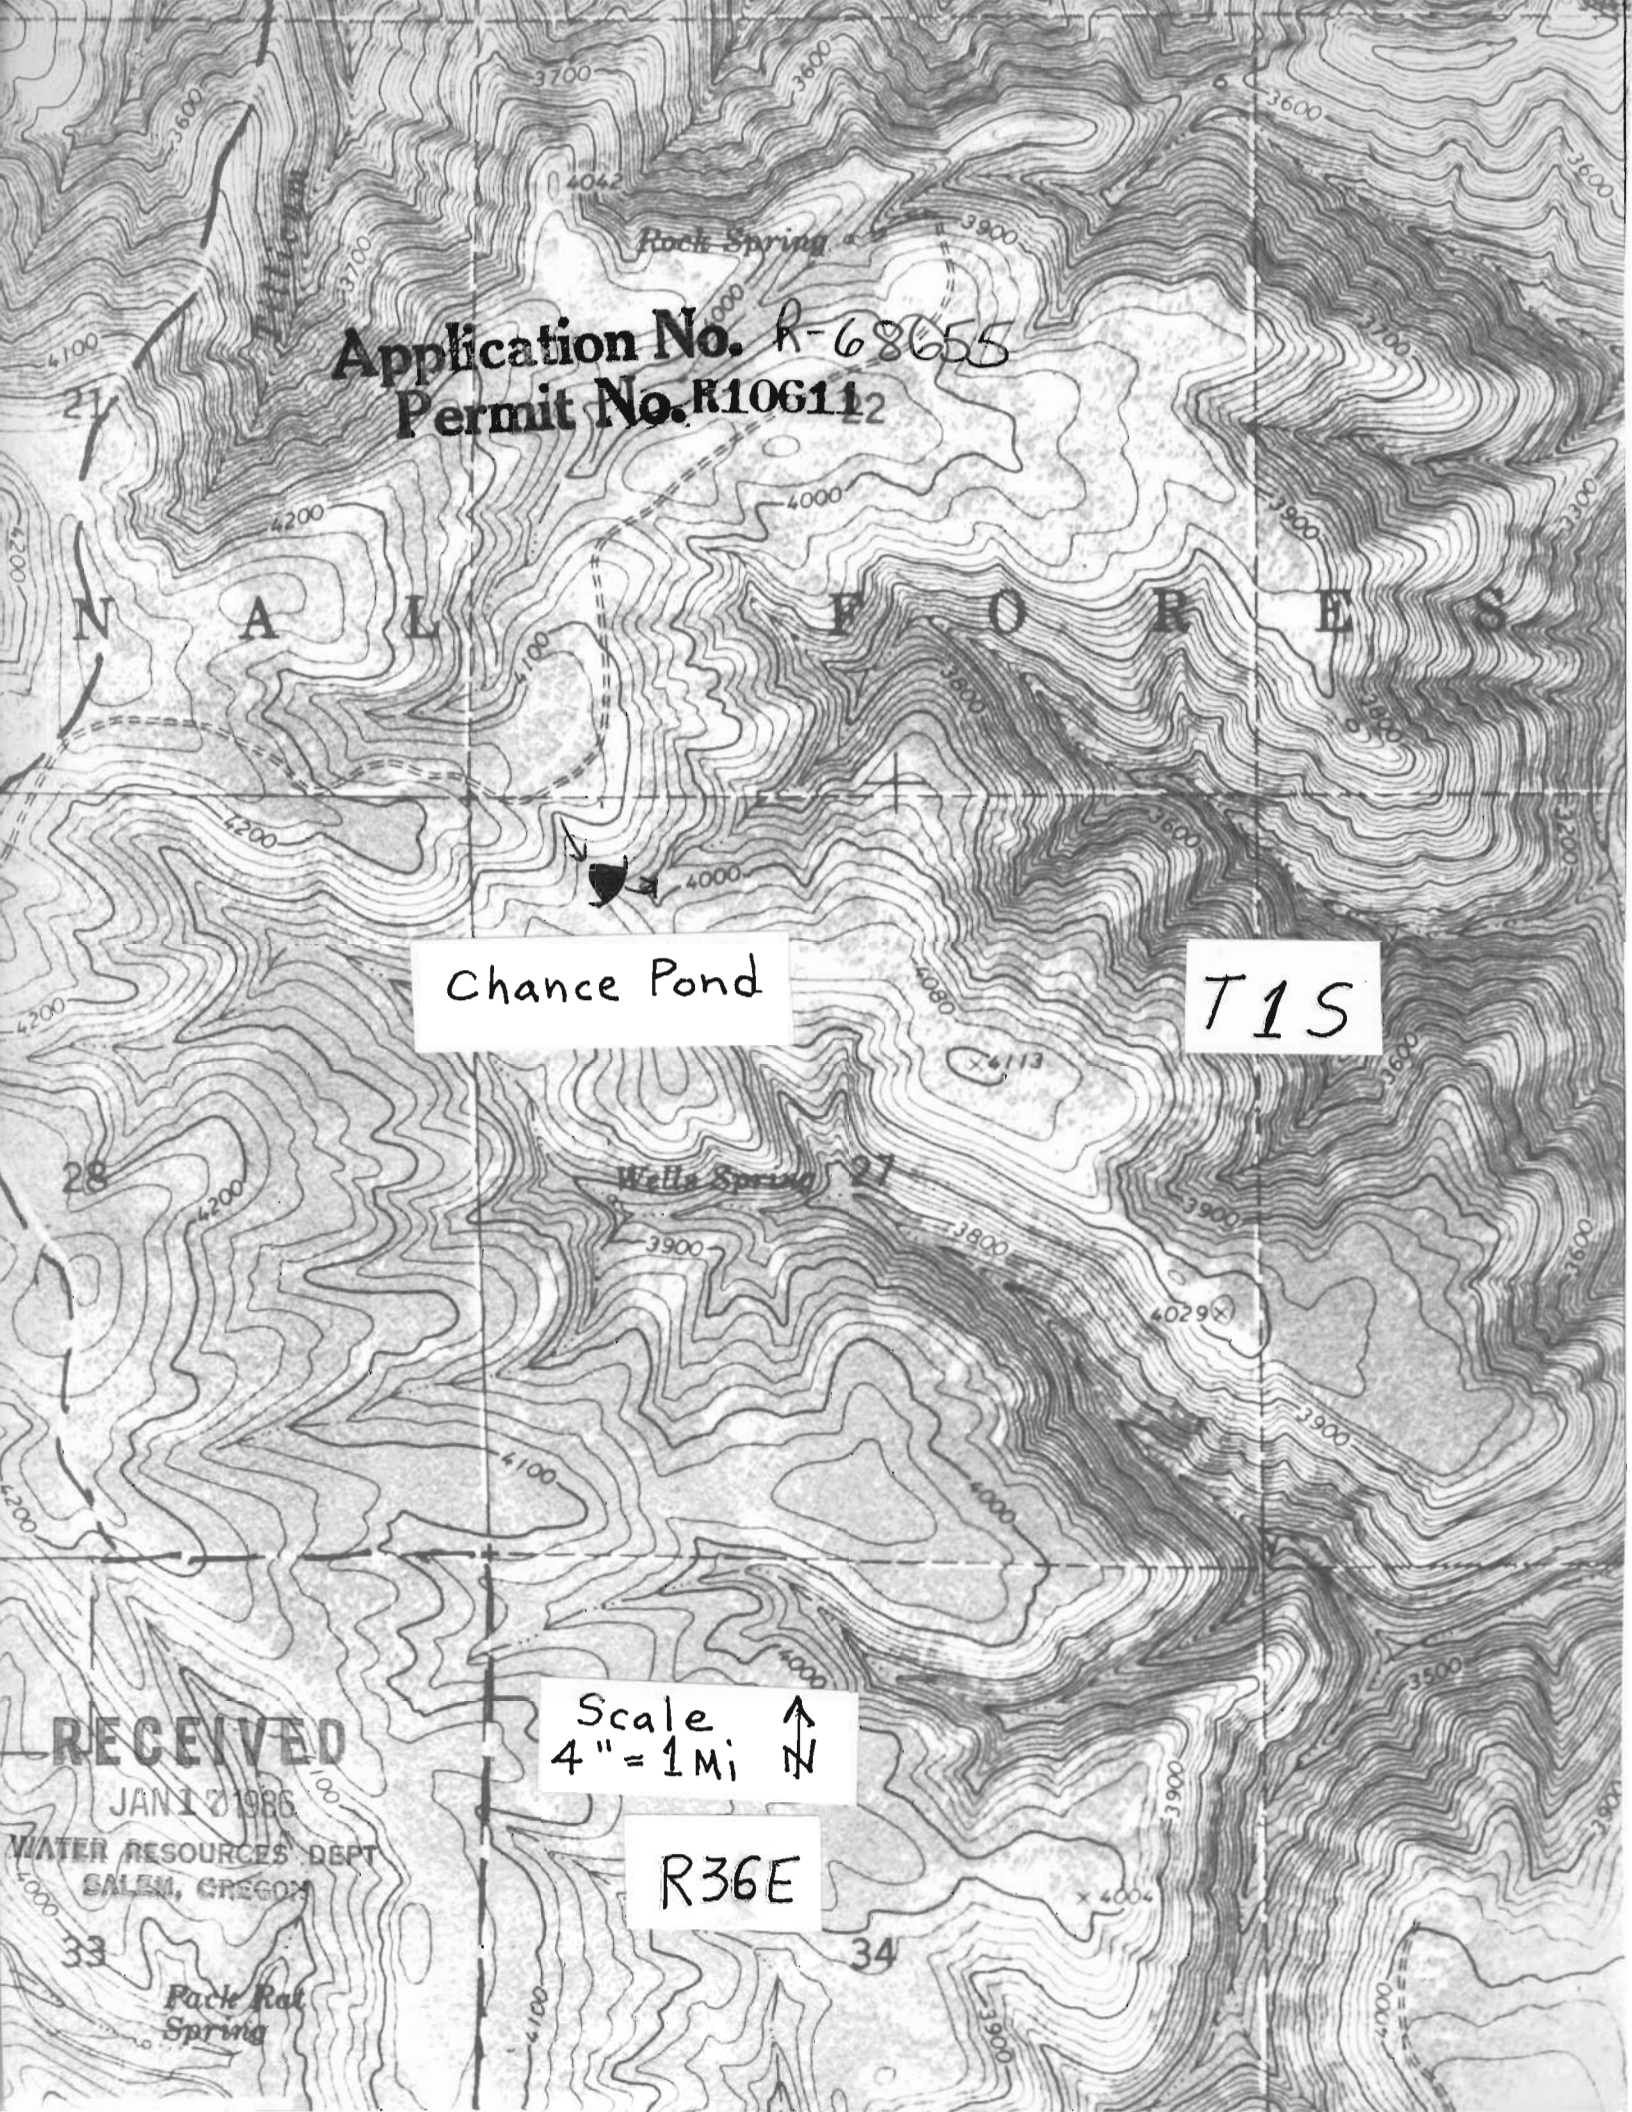

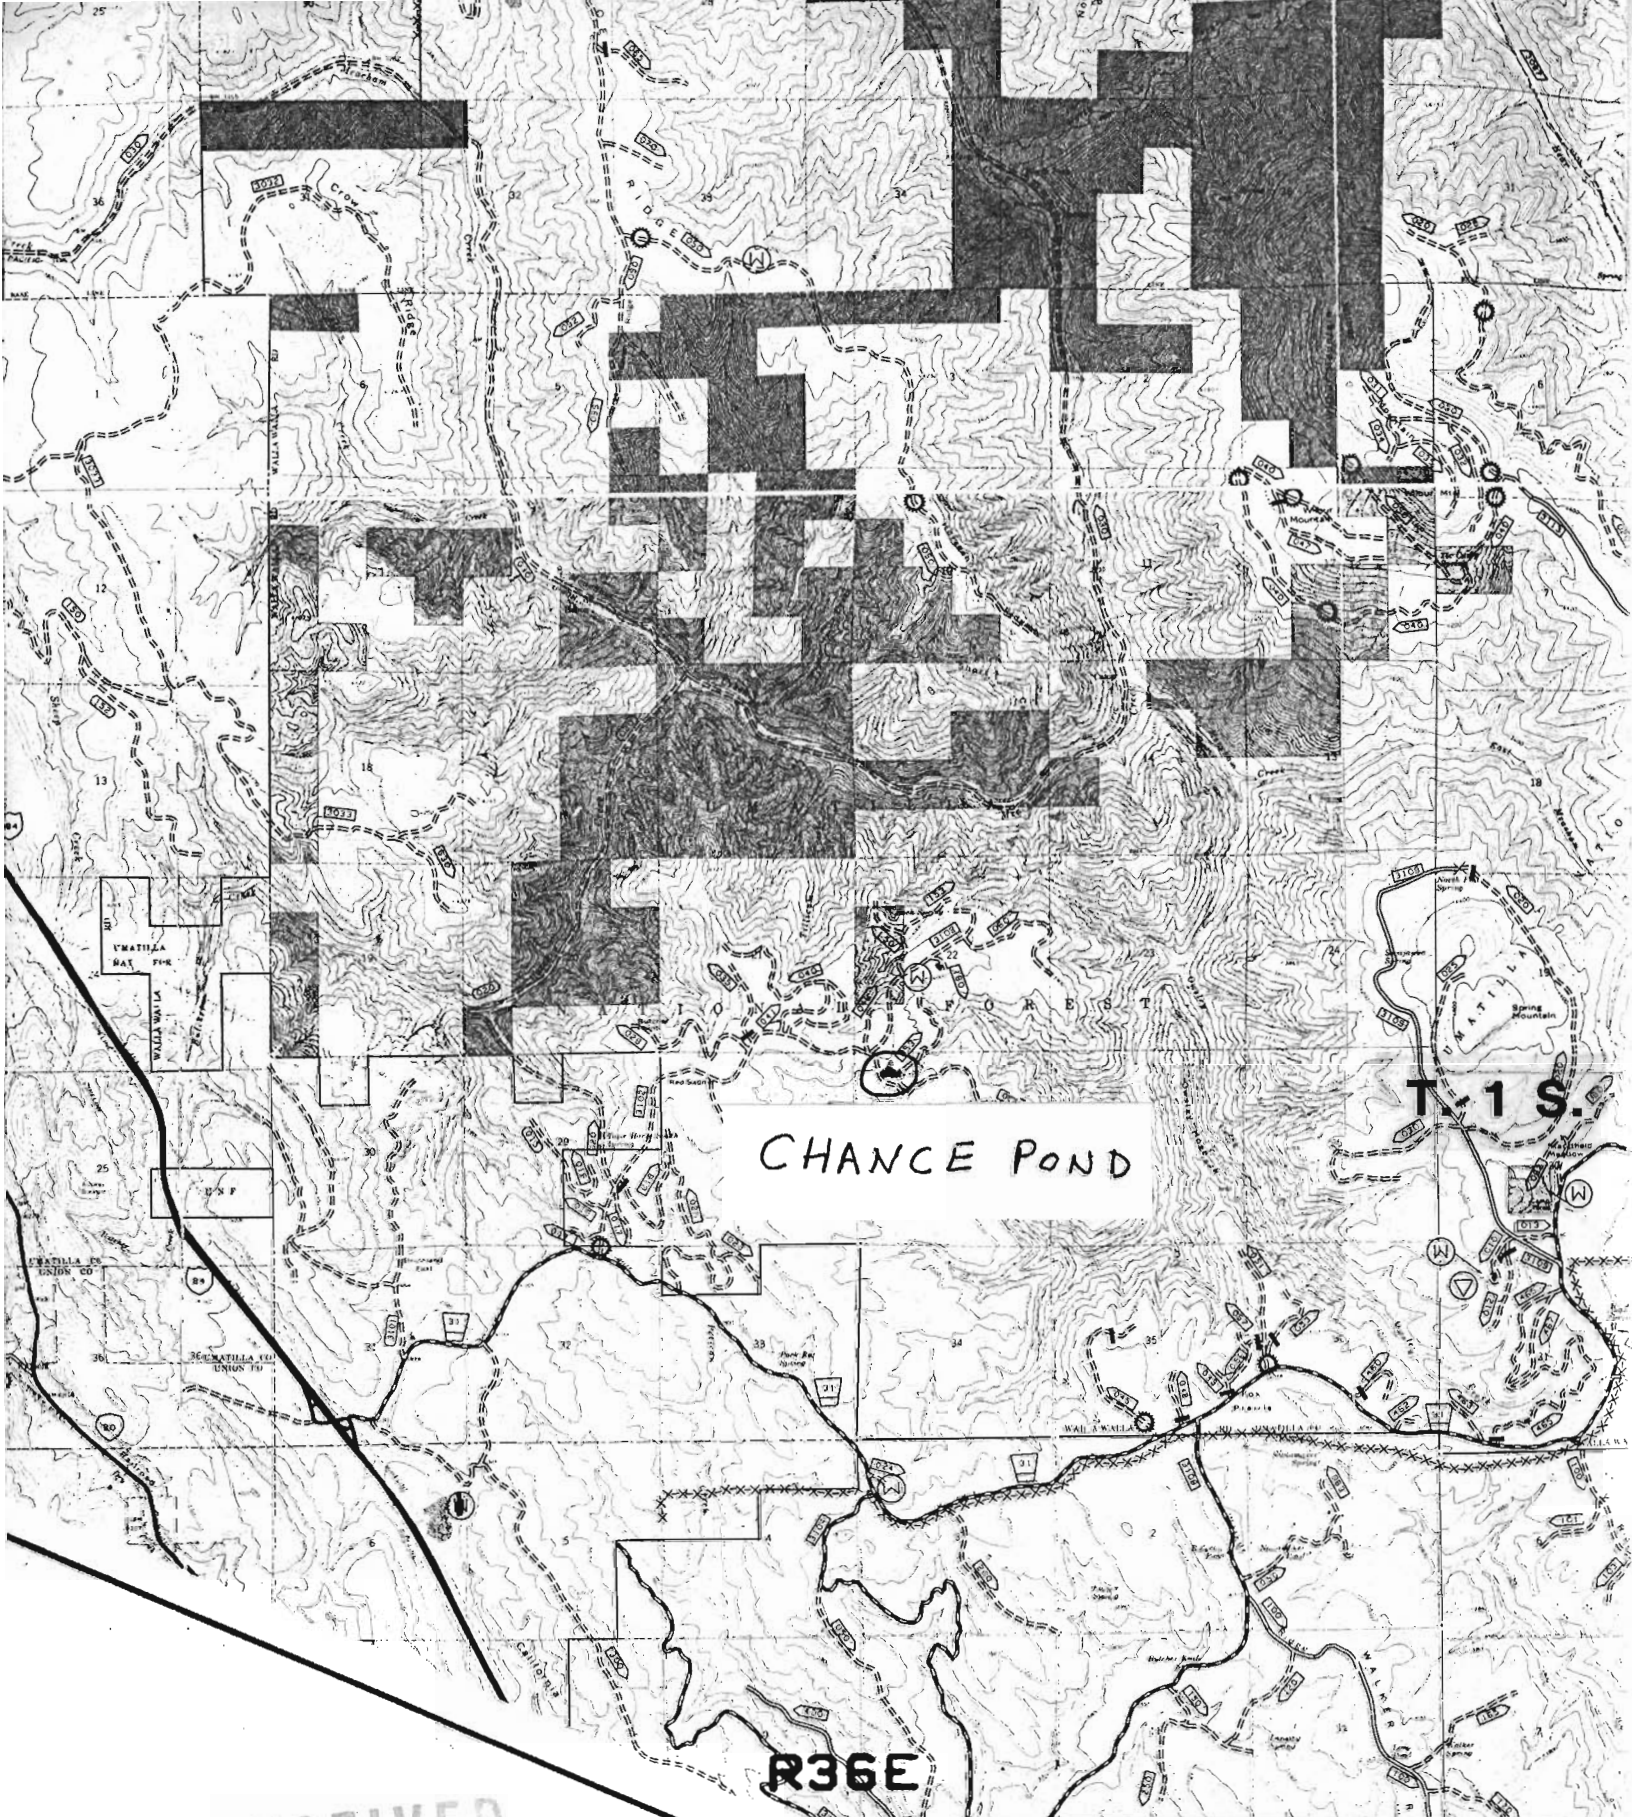

CHANCE POND

T-1 S.

R36E

RECEIVED

JAN 17 1986

WATER RESOURCES DEPT
SALEM, OR

Application No. R-68653
Permit No. R10611

UMATILLA NATIONAL FOREST
WALLA WALLA RANGER DISTRICT

WATER RIGHTS & INVENTORY USES - 1985
Chance Pond