


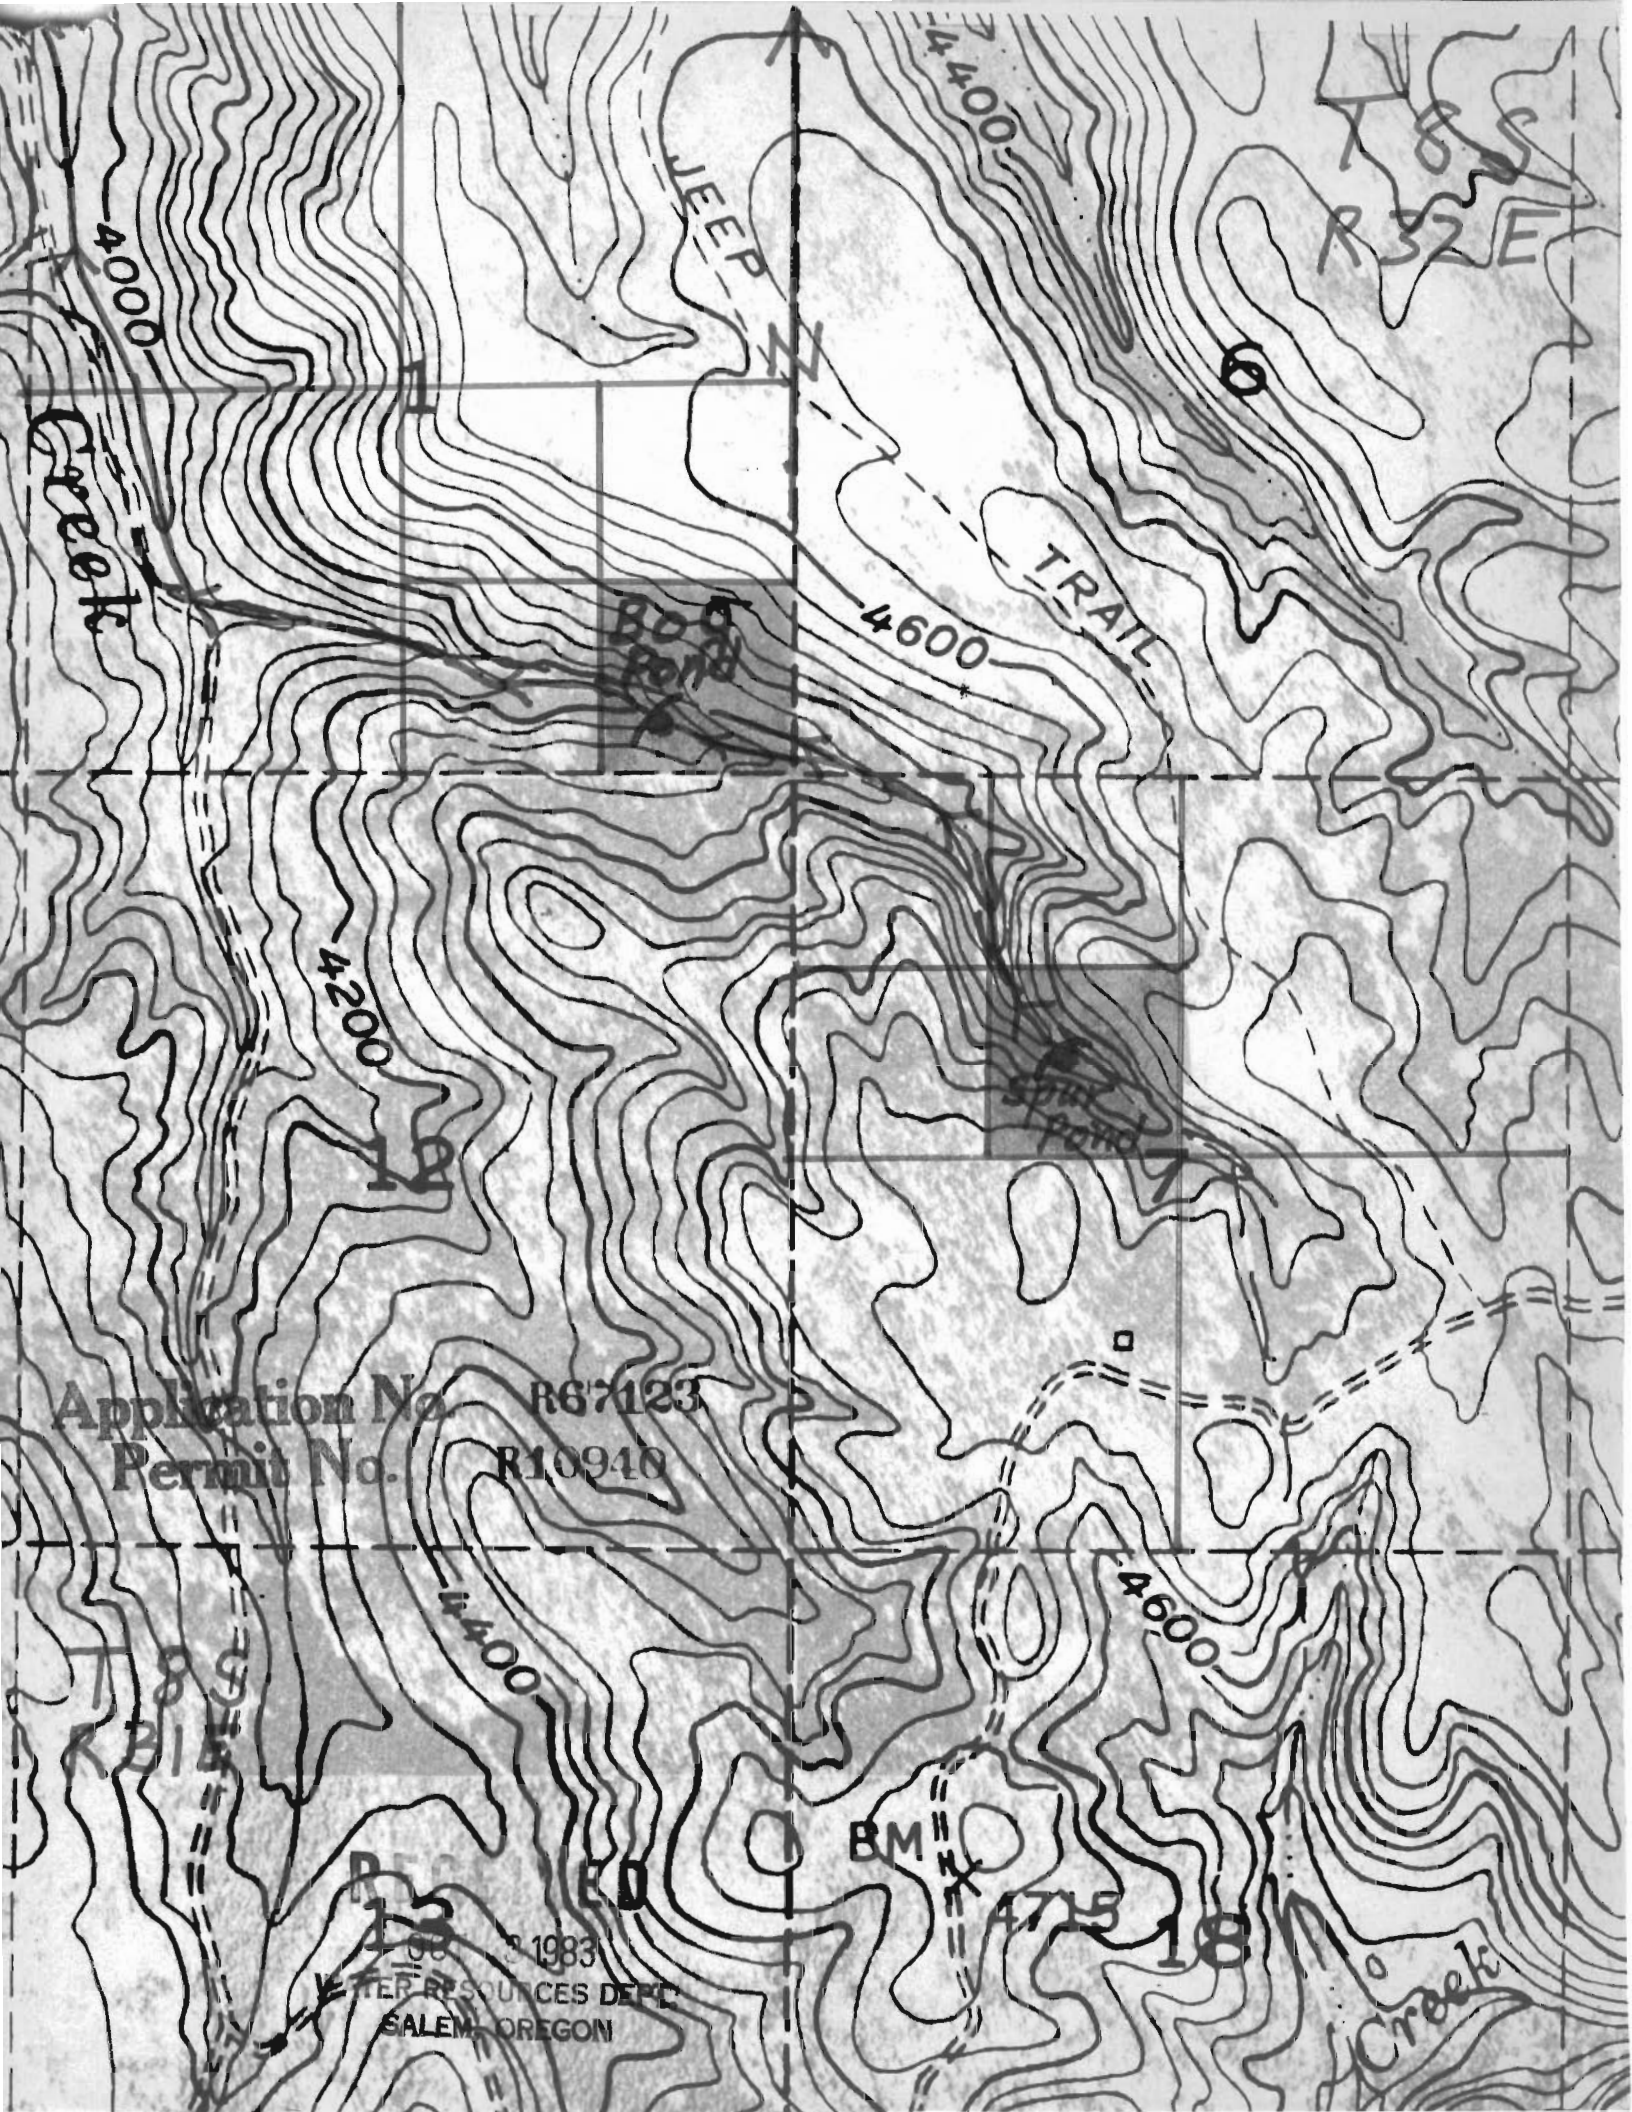

T8S
R32E

JEEP
N

TRAIL

Boo Pond

Spur pond

Creek

Application No. R67123
Permit No. R10940

BM

T8S
R32E

Creek

REC'D

1983

WATER RESOURCES DEPT.
SALEM, OREGON