


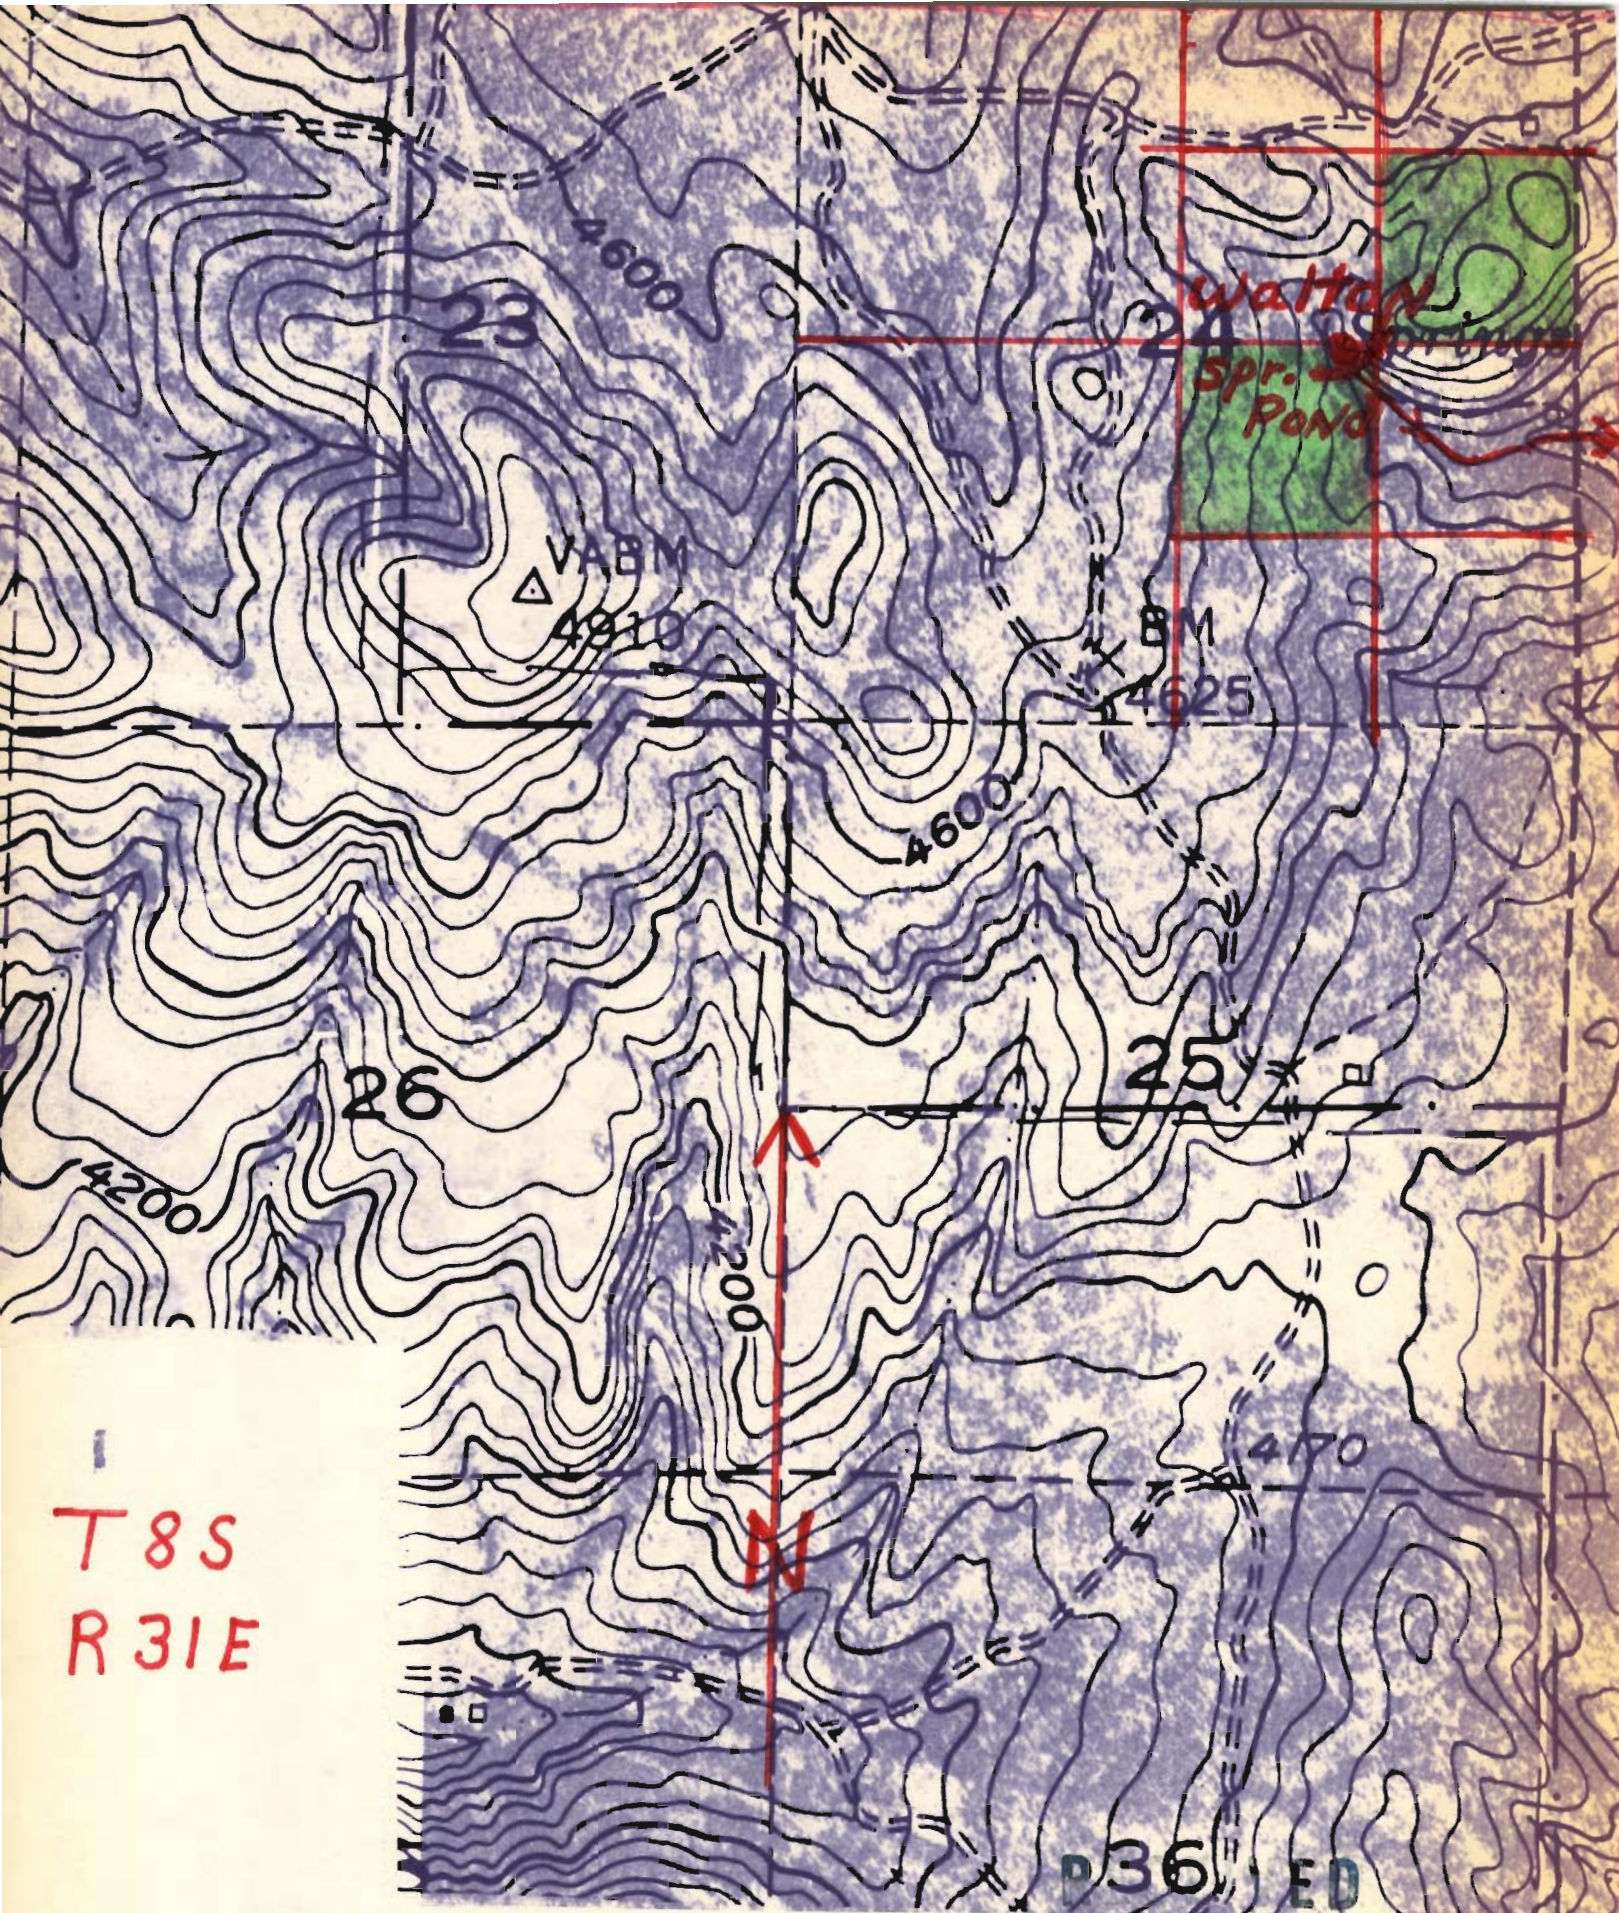

Application No.
Permit No.

R67126
R10942

OCT 3 1983
WATER RESOURCES DEPT.
SALEM, OREGON