


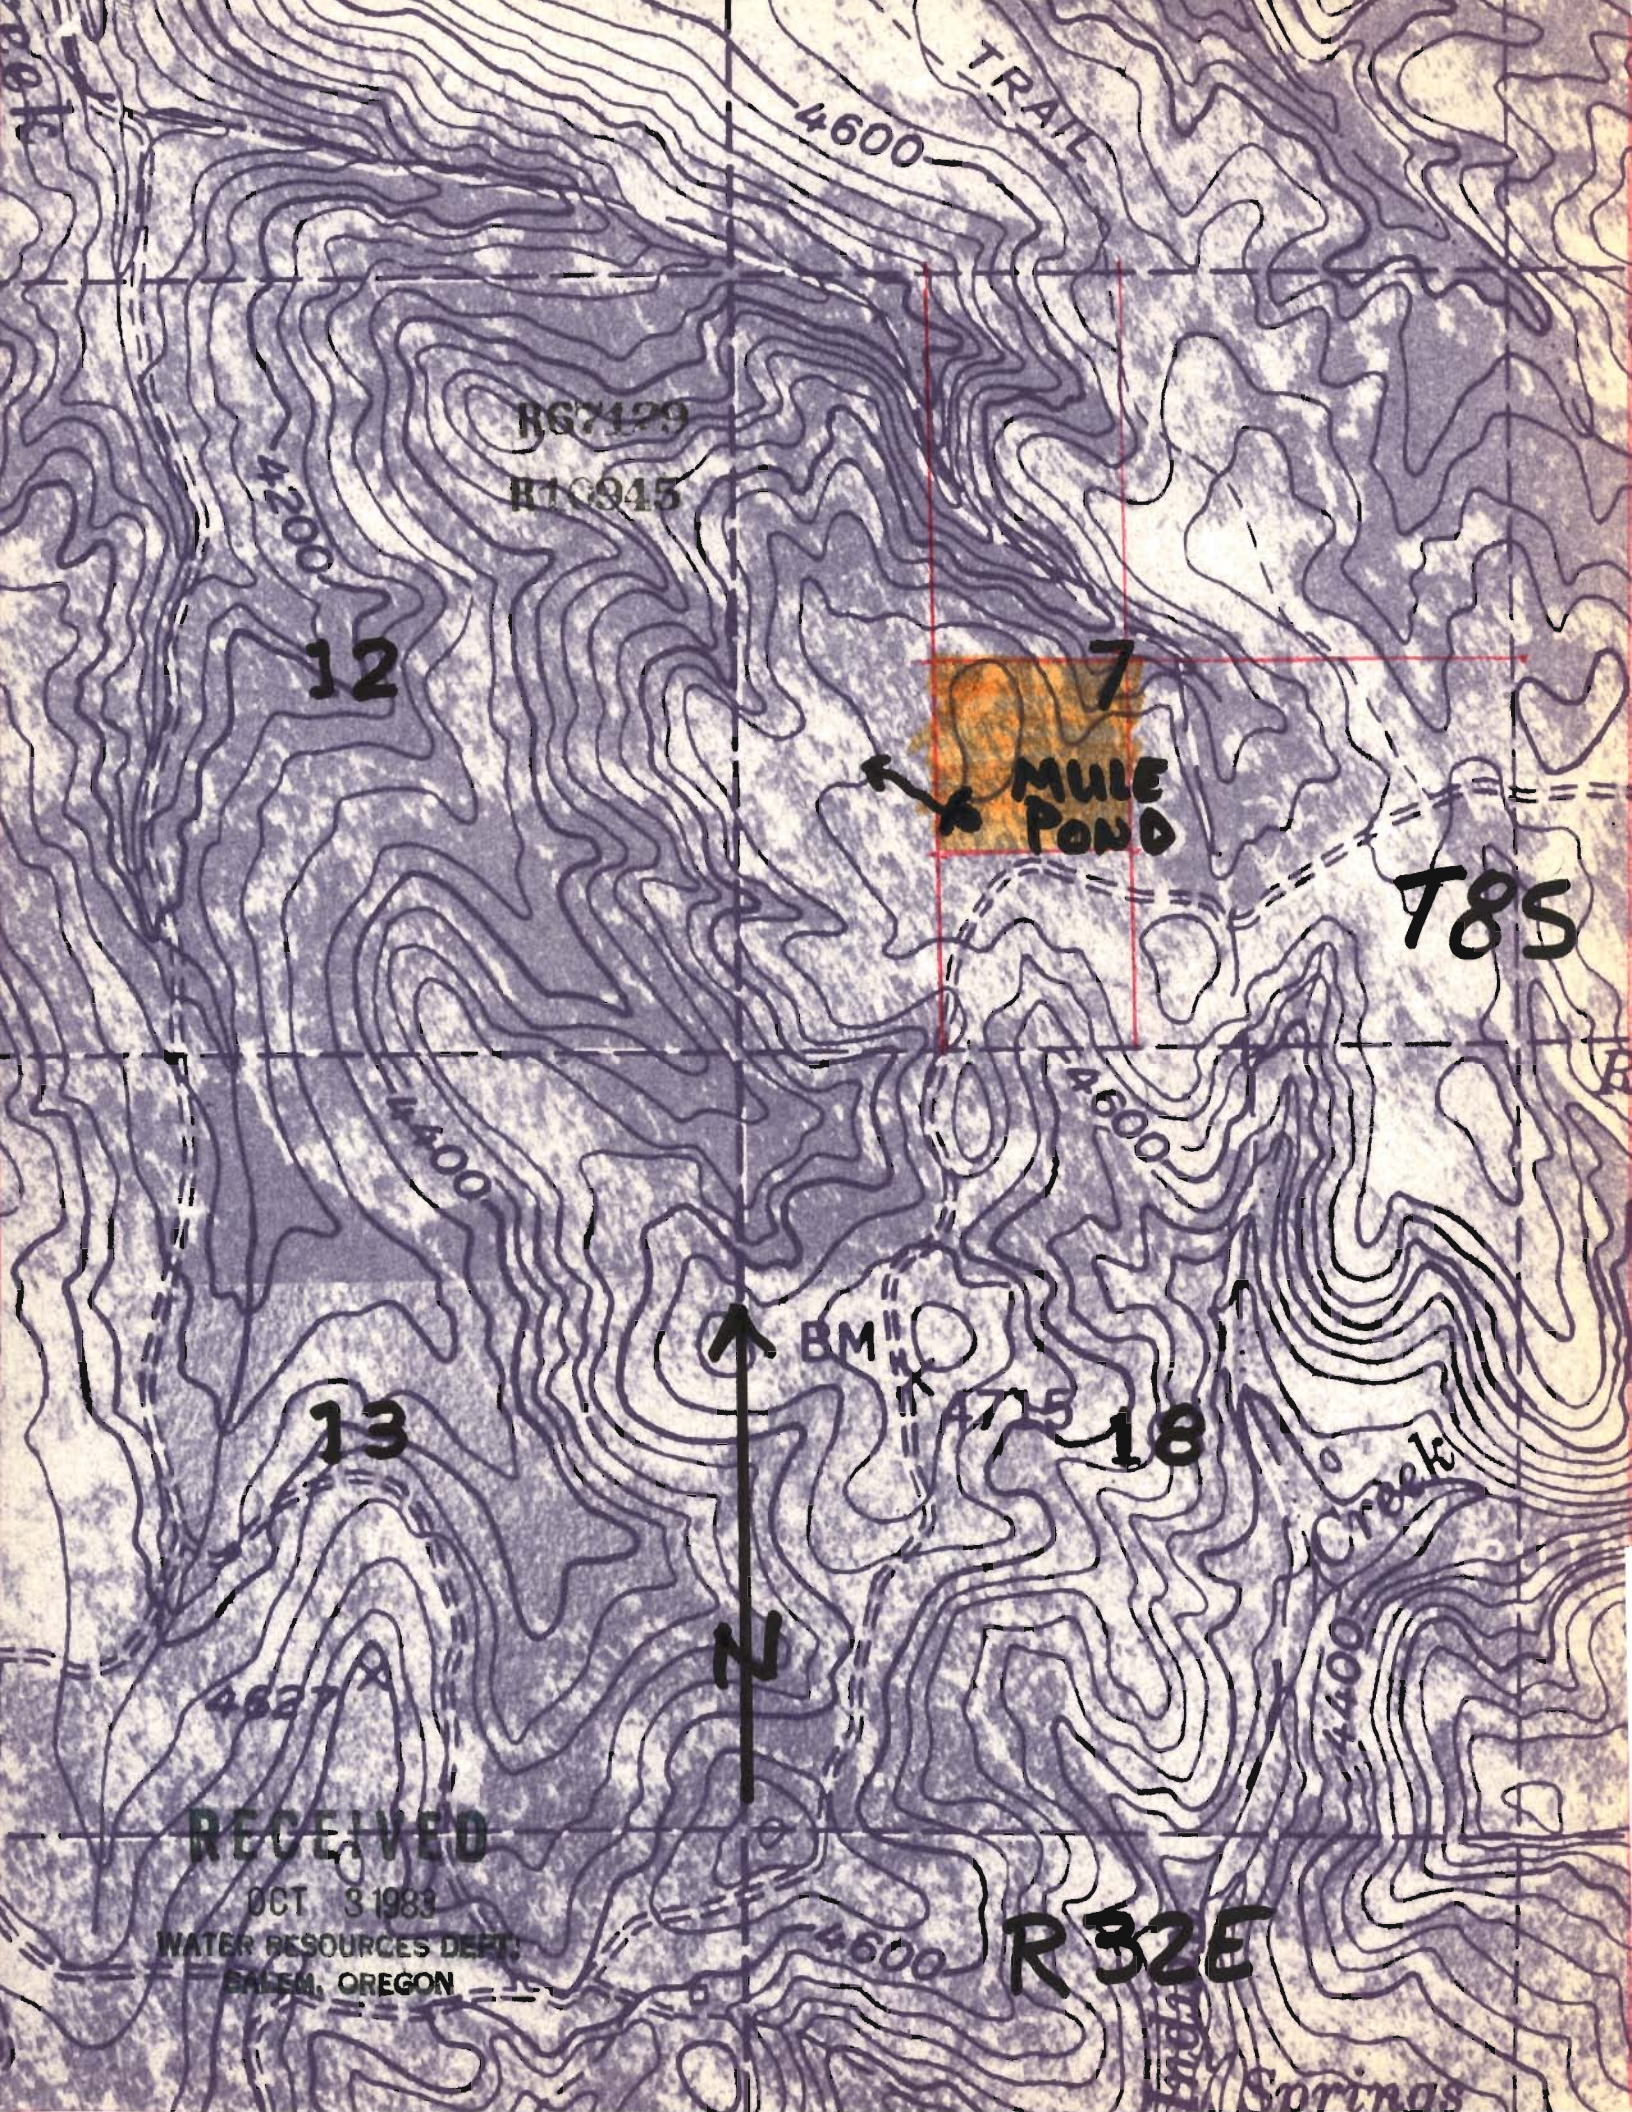

RG7129

R10945

12

7

MULE
POND

T85

13

↑

BM

4715

18

N

RECEIVED

OCT 3 1983

WATER RESOURCES DEPT.
SALEM, OREGON


R32E

Spring

T8S, R32E

R67129

R10945

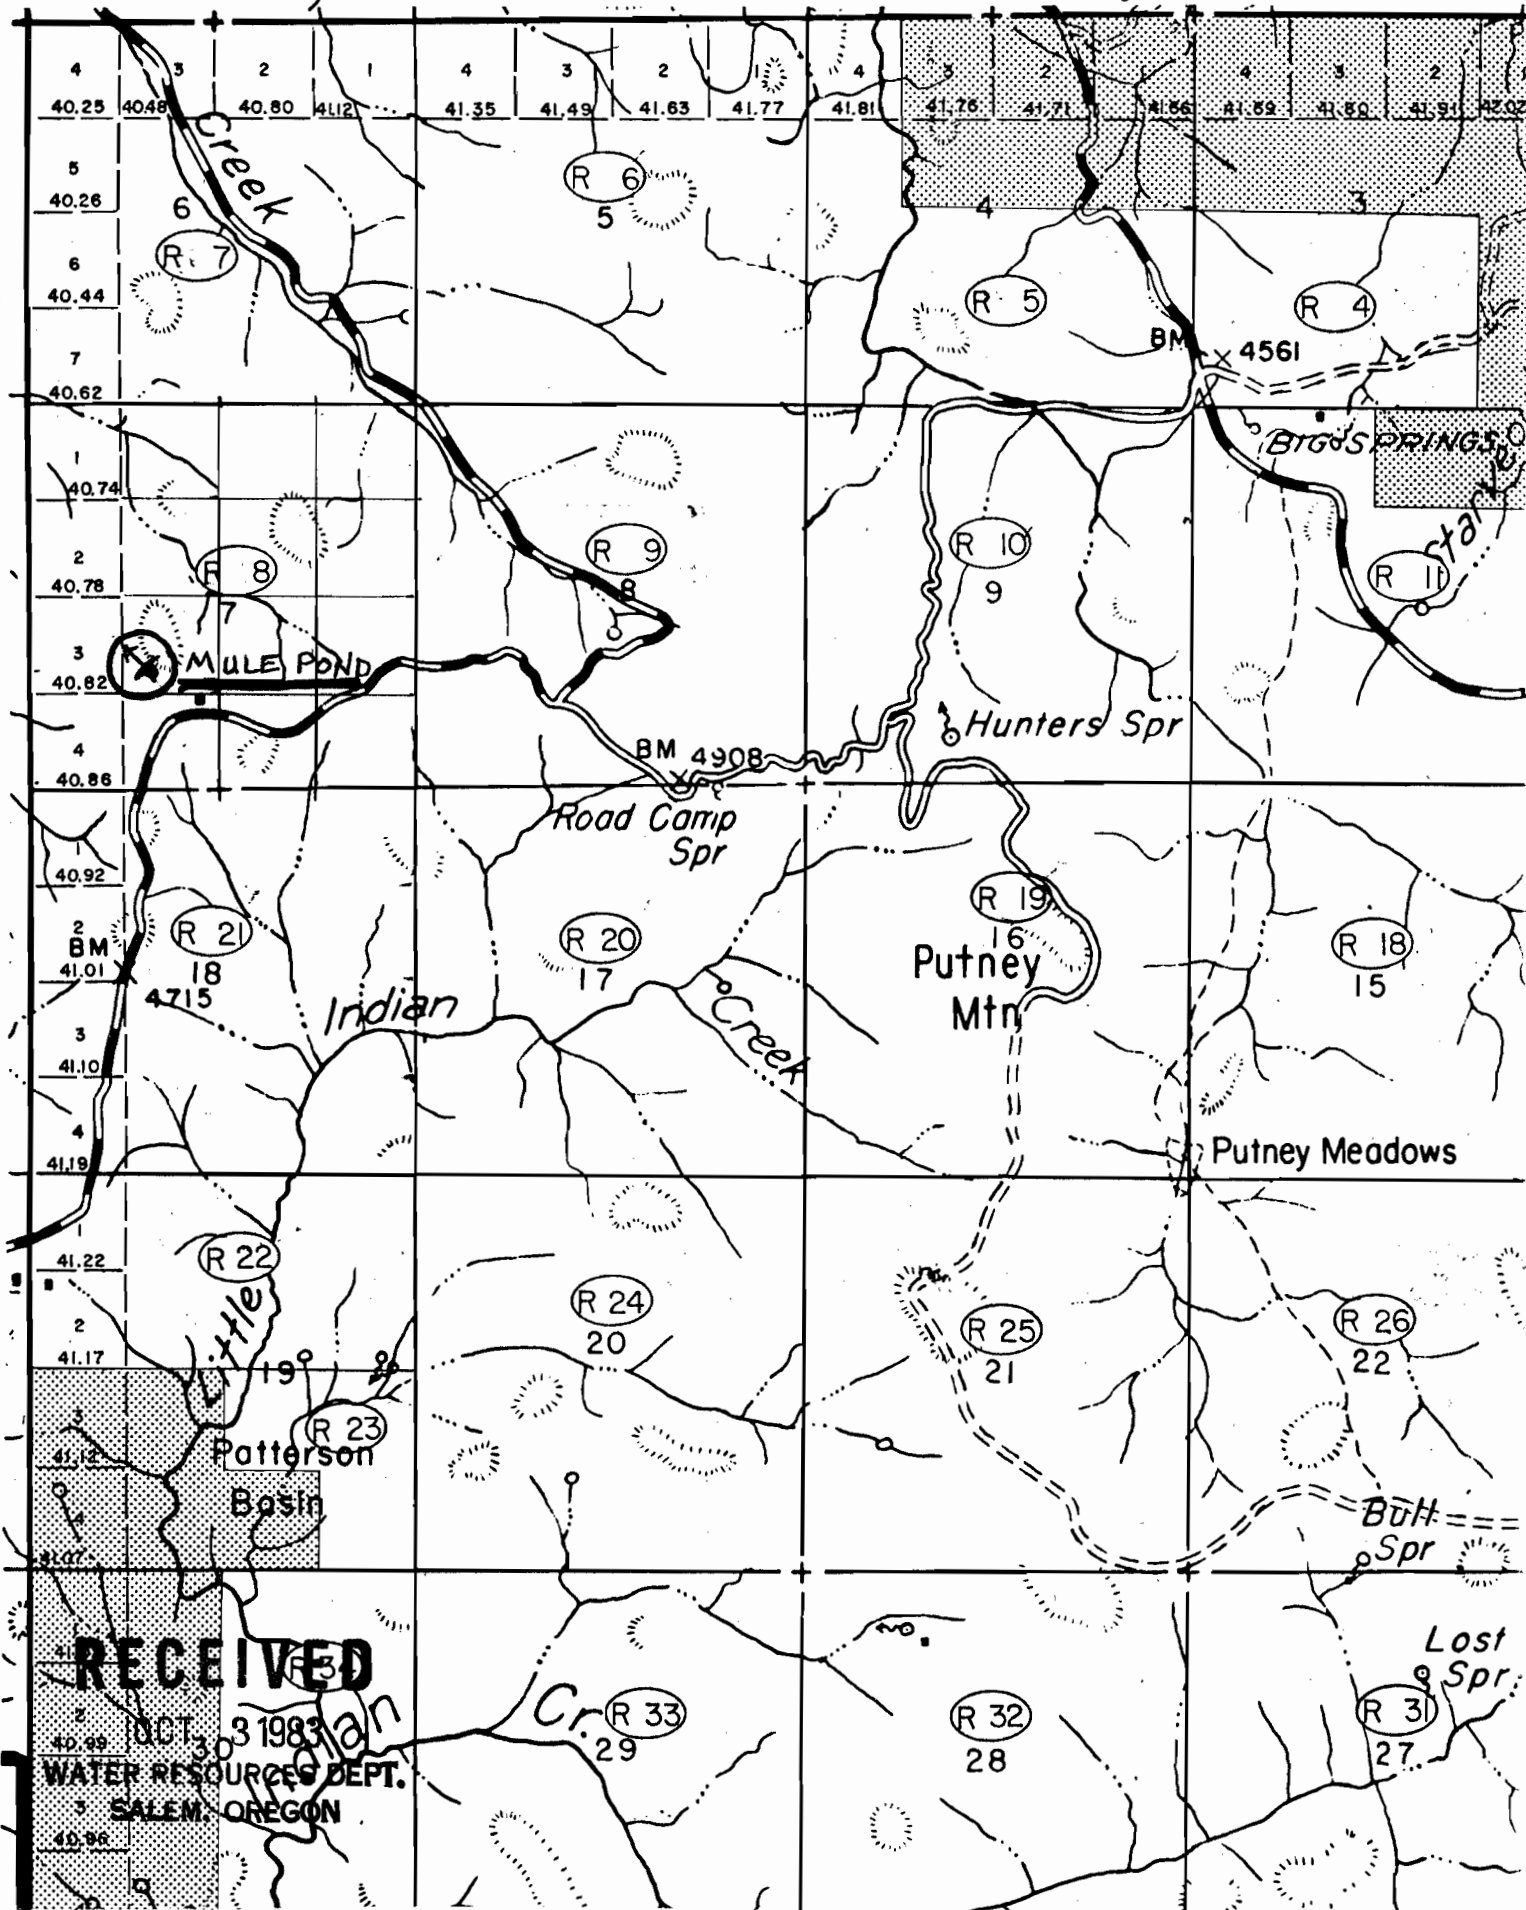

RECEIVED

OCT 30 1983

WATER RESOURCES DEPT.

SALEM, OREGON