


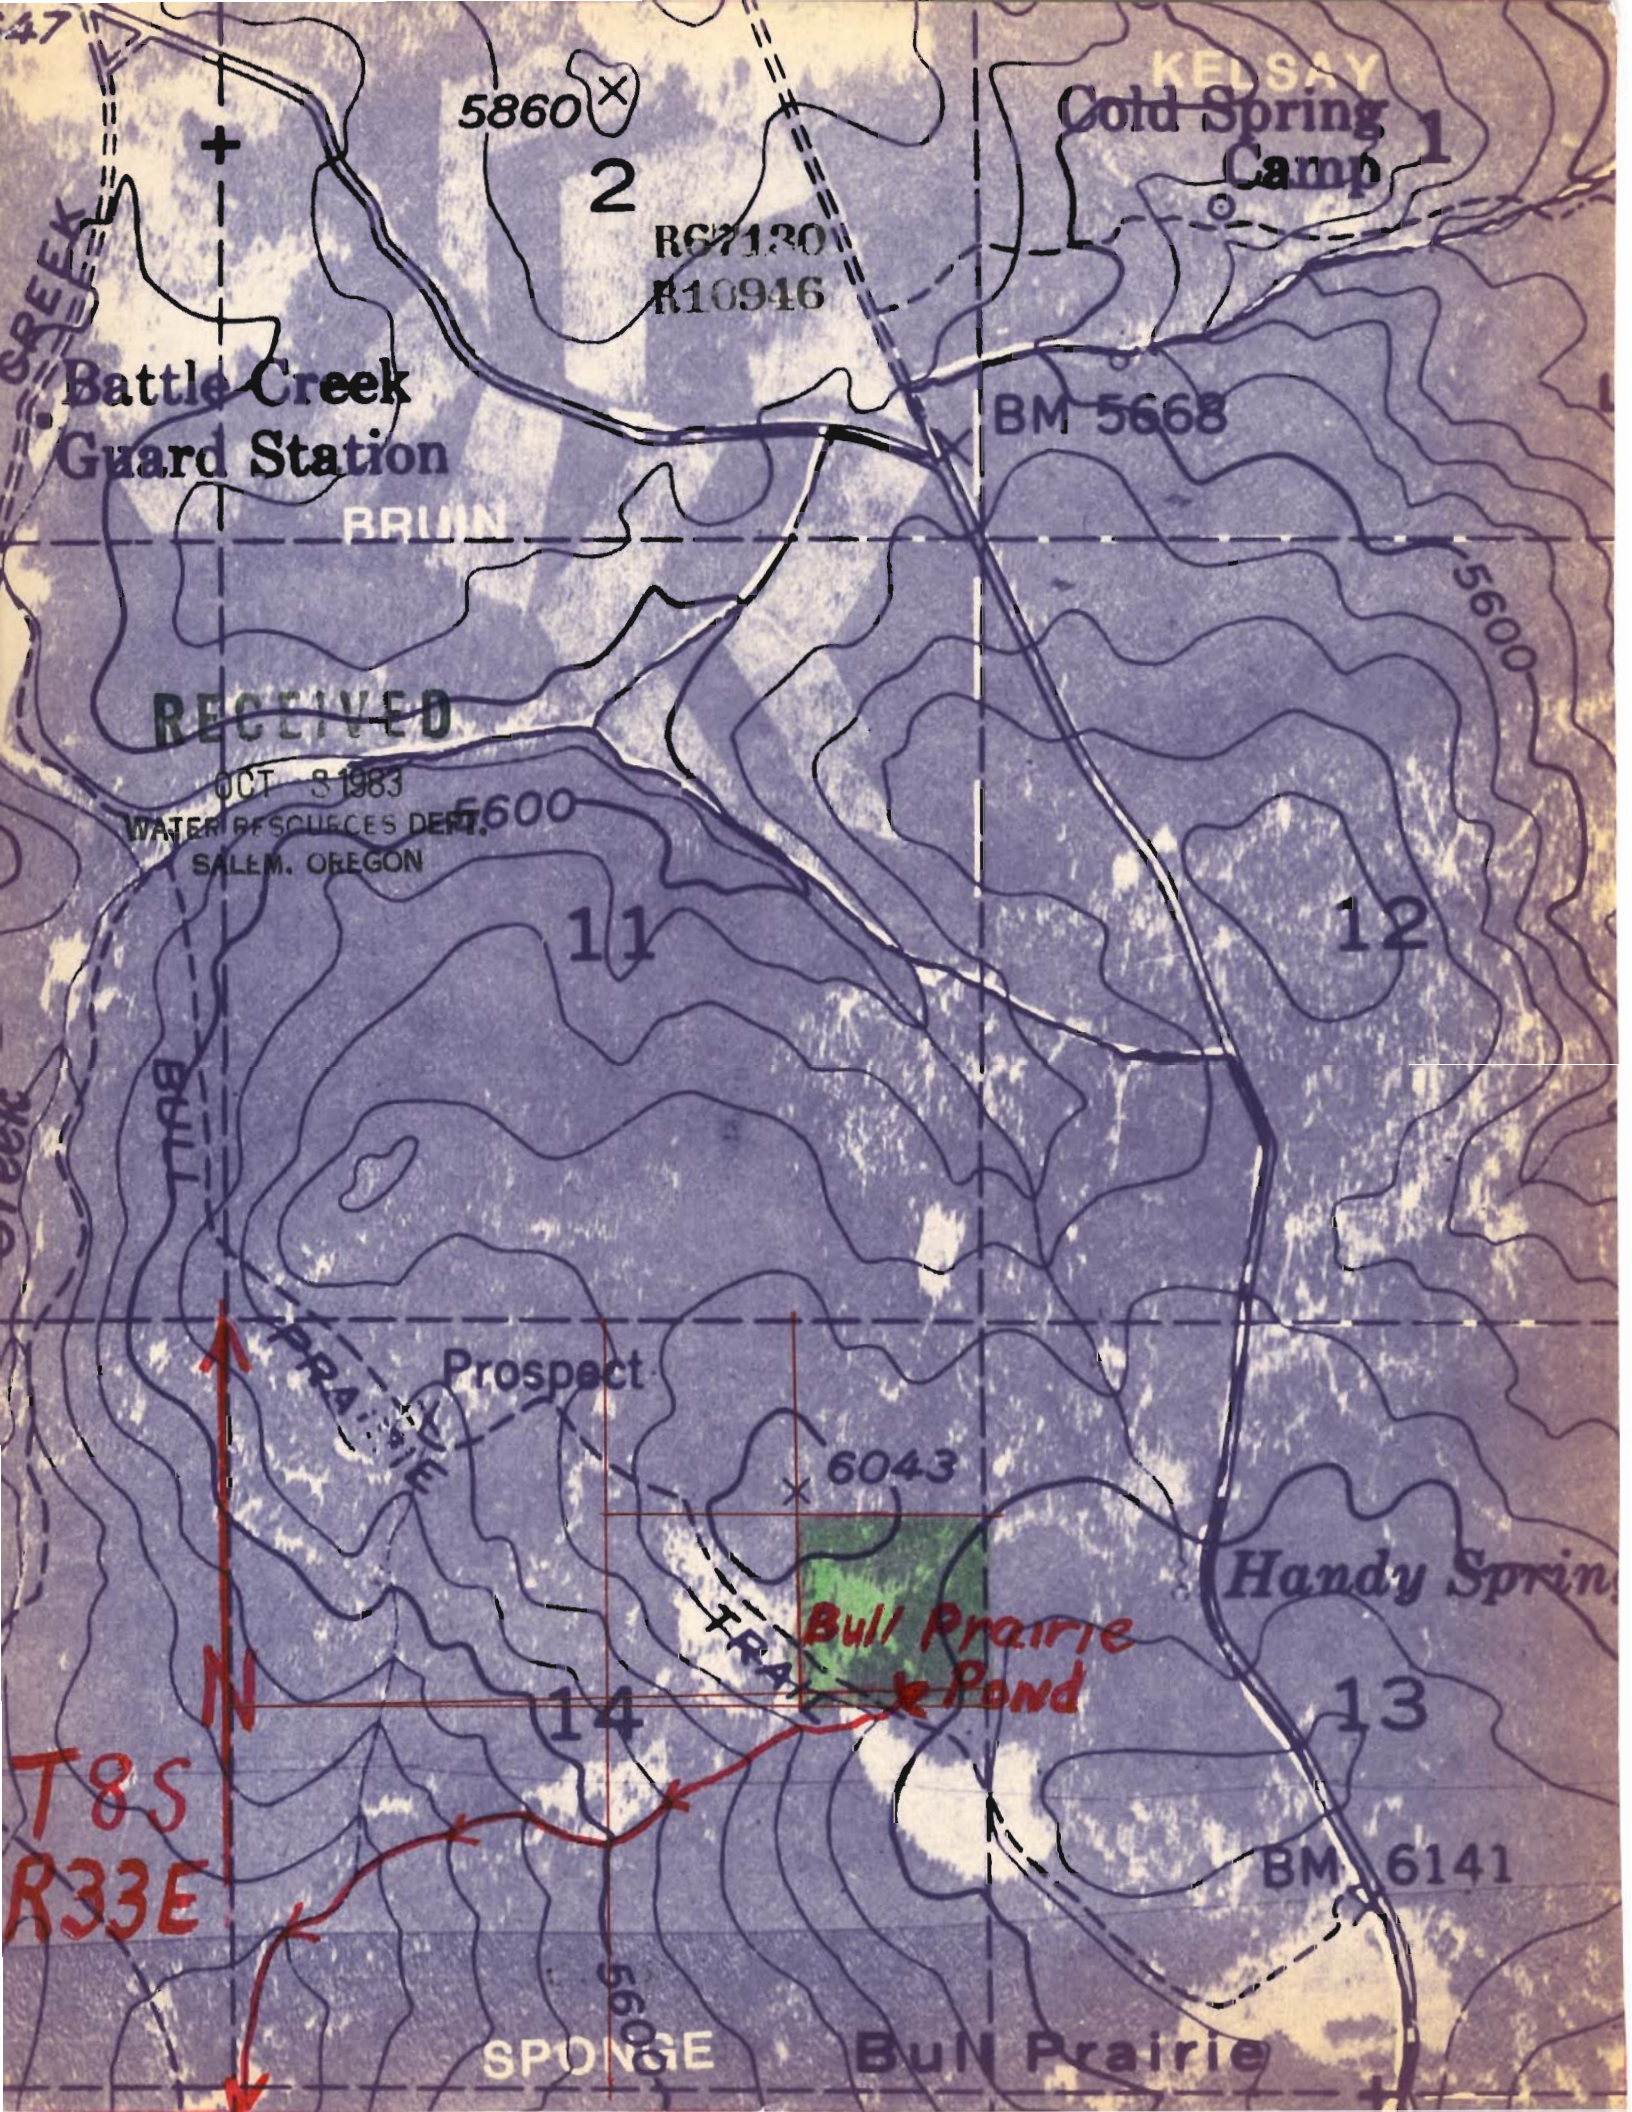

5860 X
2

R67130
R10946

KELSA
Cold Spring
Camp 1

Battle Creek
Guard Station

BM 5668

RECEIVED

OCT 8 1983
WATER RESOURCES DEPT.
SALEM, OREGON

5600

11

12

PR
PRAIRIE

Prospect

6043 X

Bull Prairie
& Pond

Handy Spring

14

13

BM 6141

T8S
R33E

SPONGE

Bull Prairie