


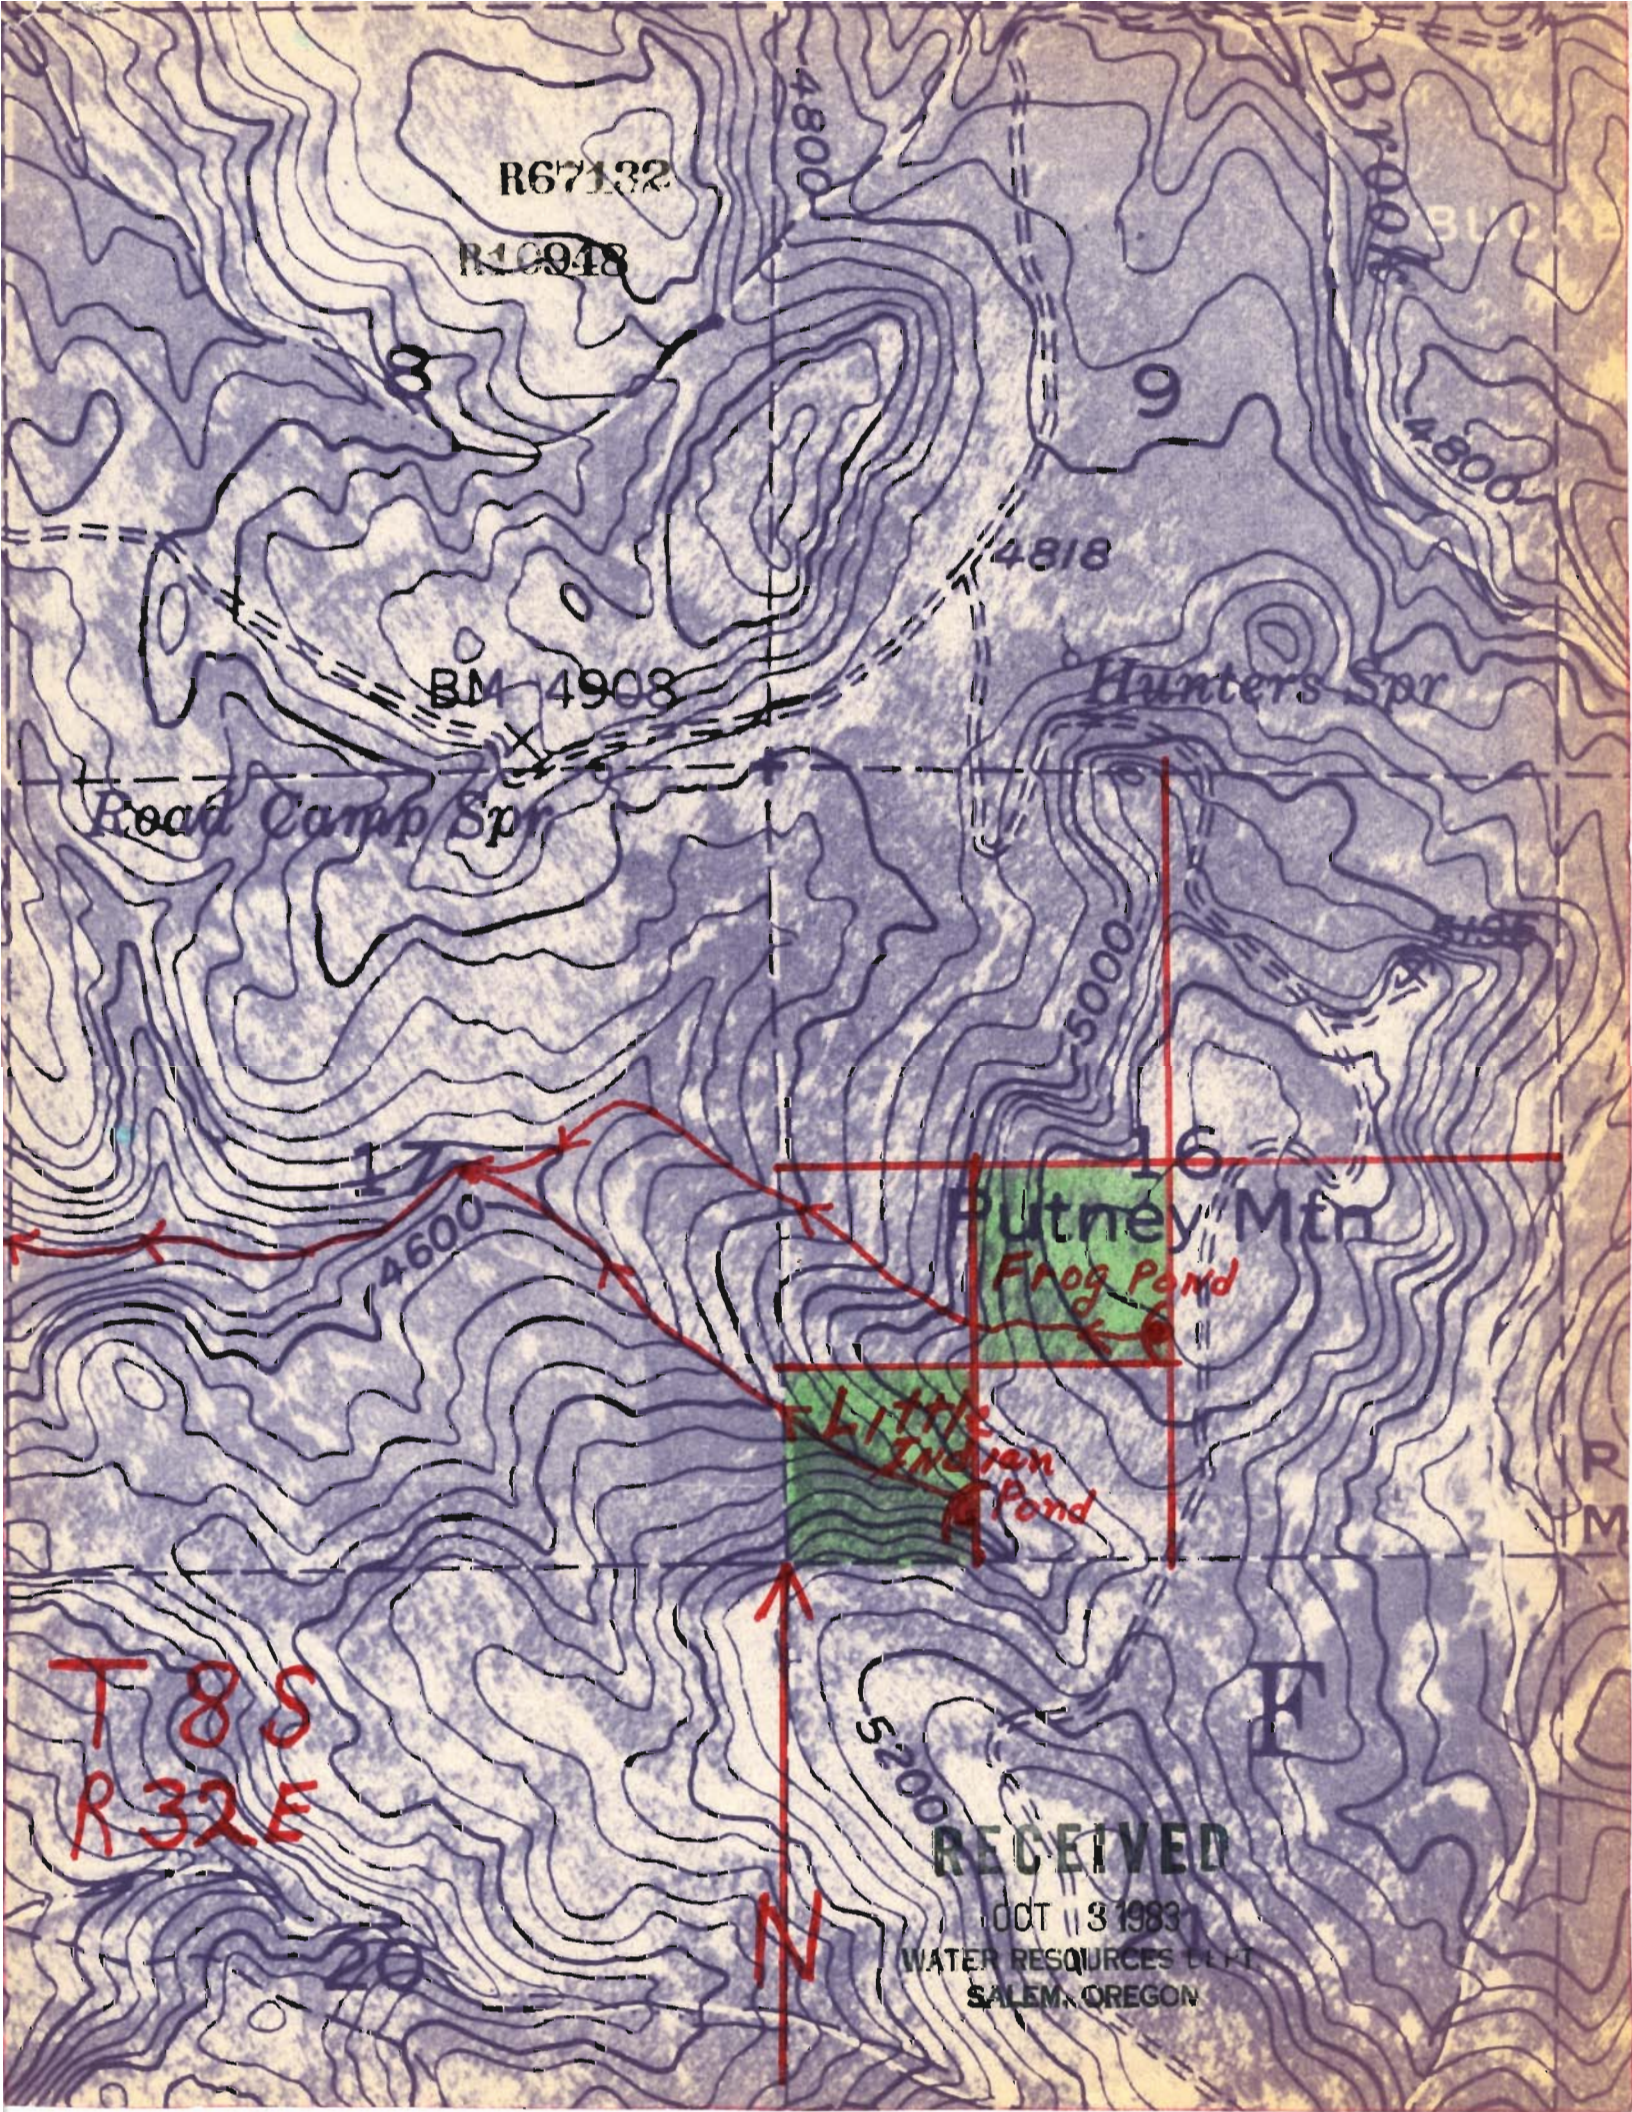

R67132

R10948

BM 4908

Road Camp Spr

Hunters Spr

Putney Mtn

Frog Pond

Little Indian Pond

T 8 S
R 32 E

RECEIVED

OCT 13 1983
WATER RESOURCES UNIT
SALEM, OREGON