


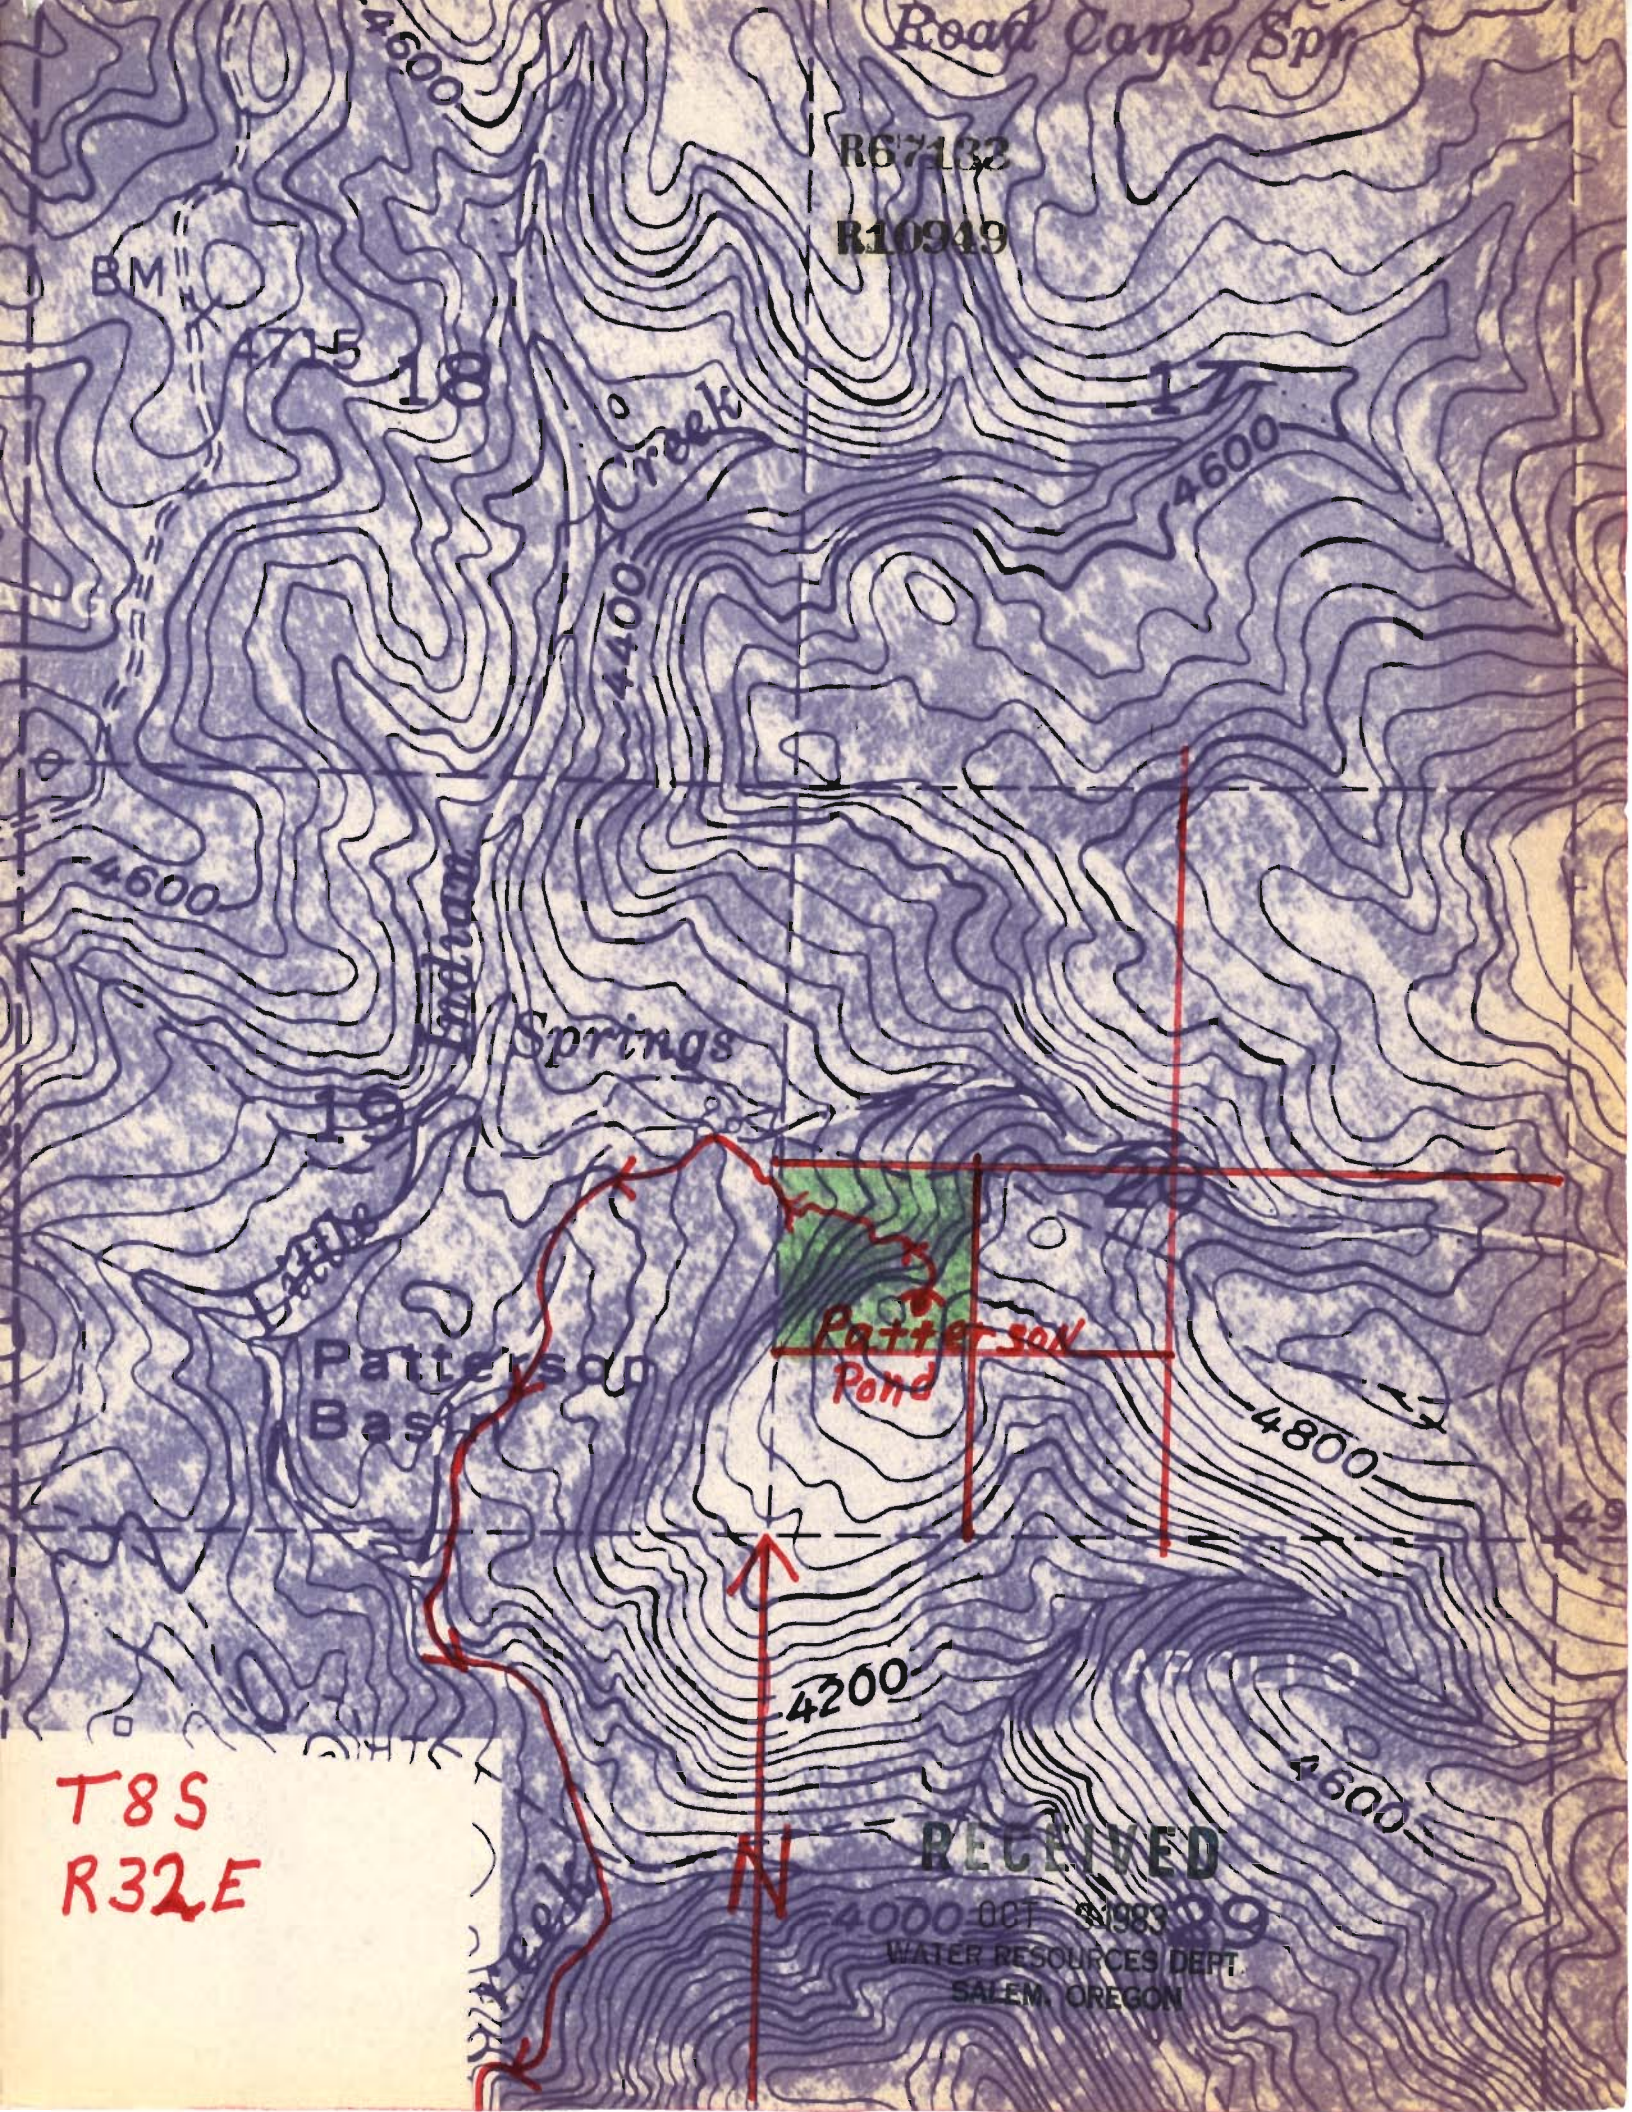

Road Camp Spr

R67132

R10949

BM

4715

18

17

4600

Creek

4400

4600

Indian

Springs

19

Patterson

Basin

Patterson Pond

4800

4200

4600

T8S
R32E

N

RECEIVED

OCT 31 1983

WATER RESOURCES DEPT.
SALEM, OREGON