


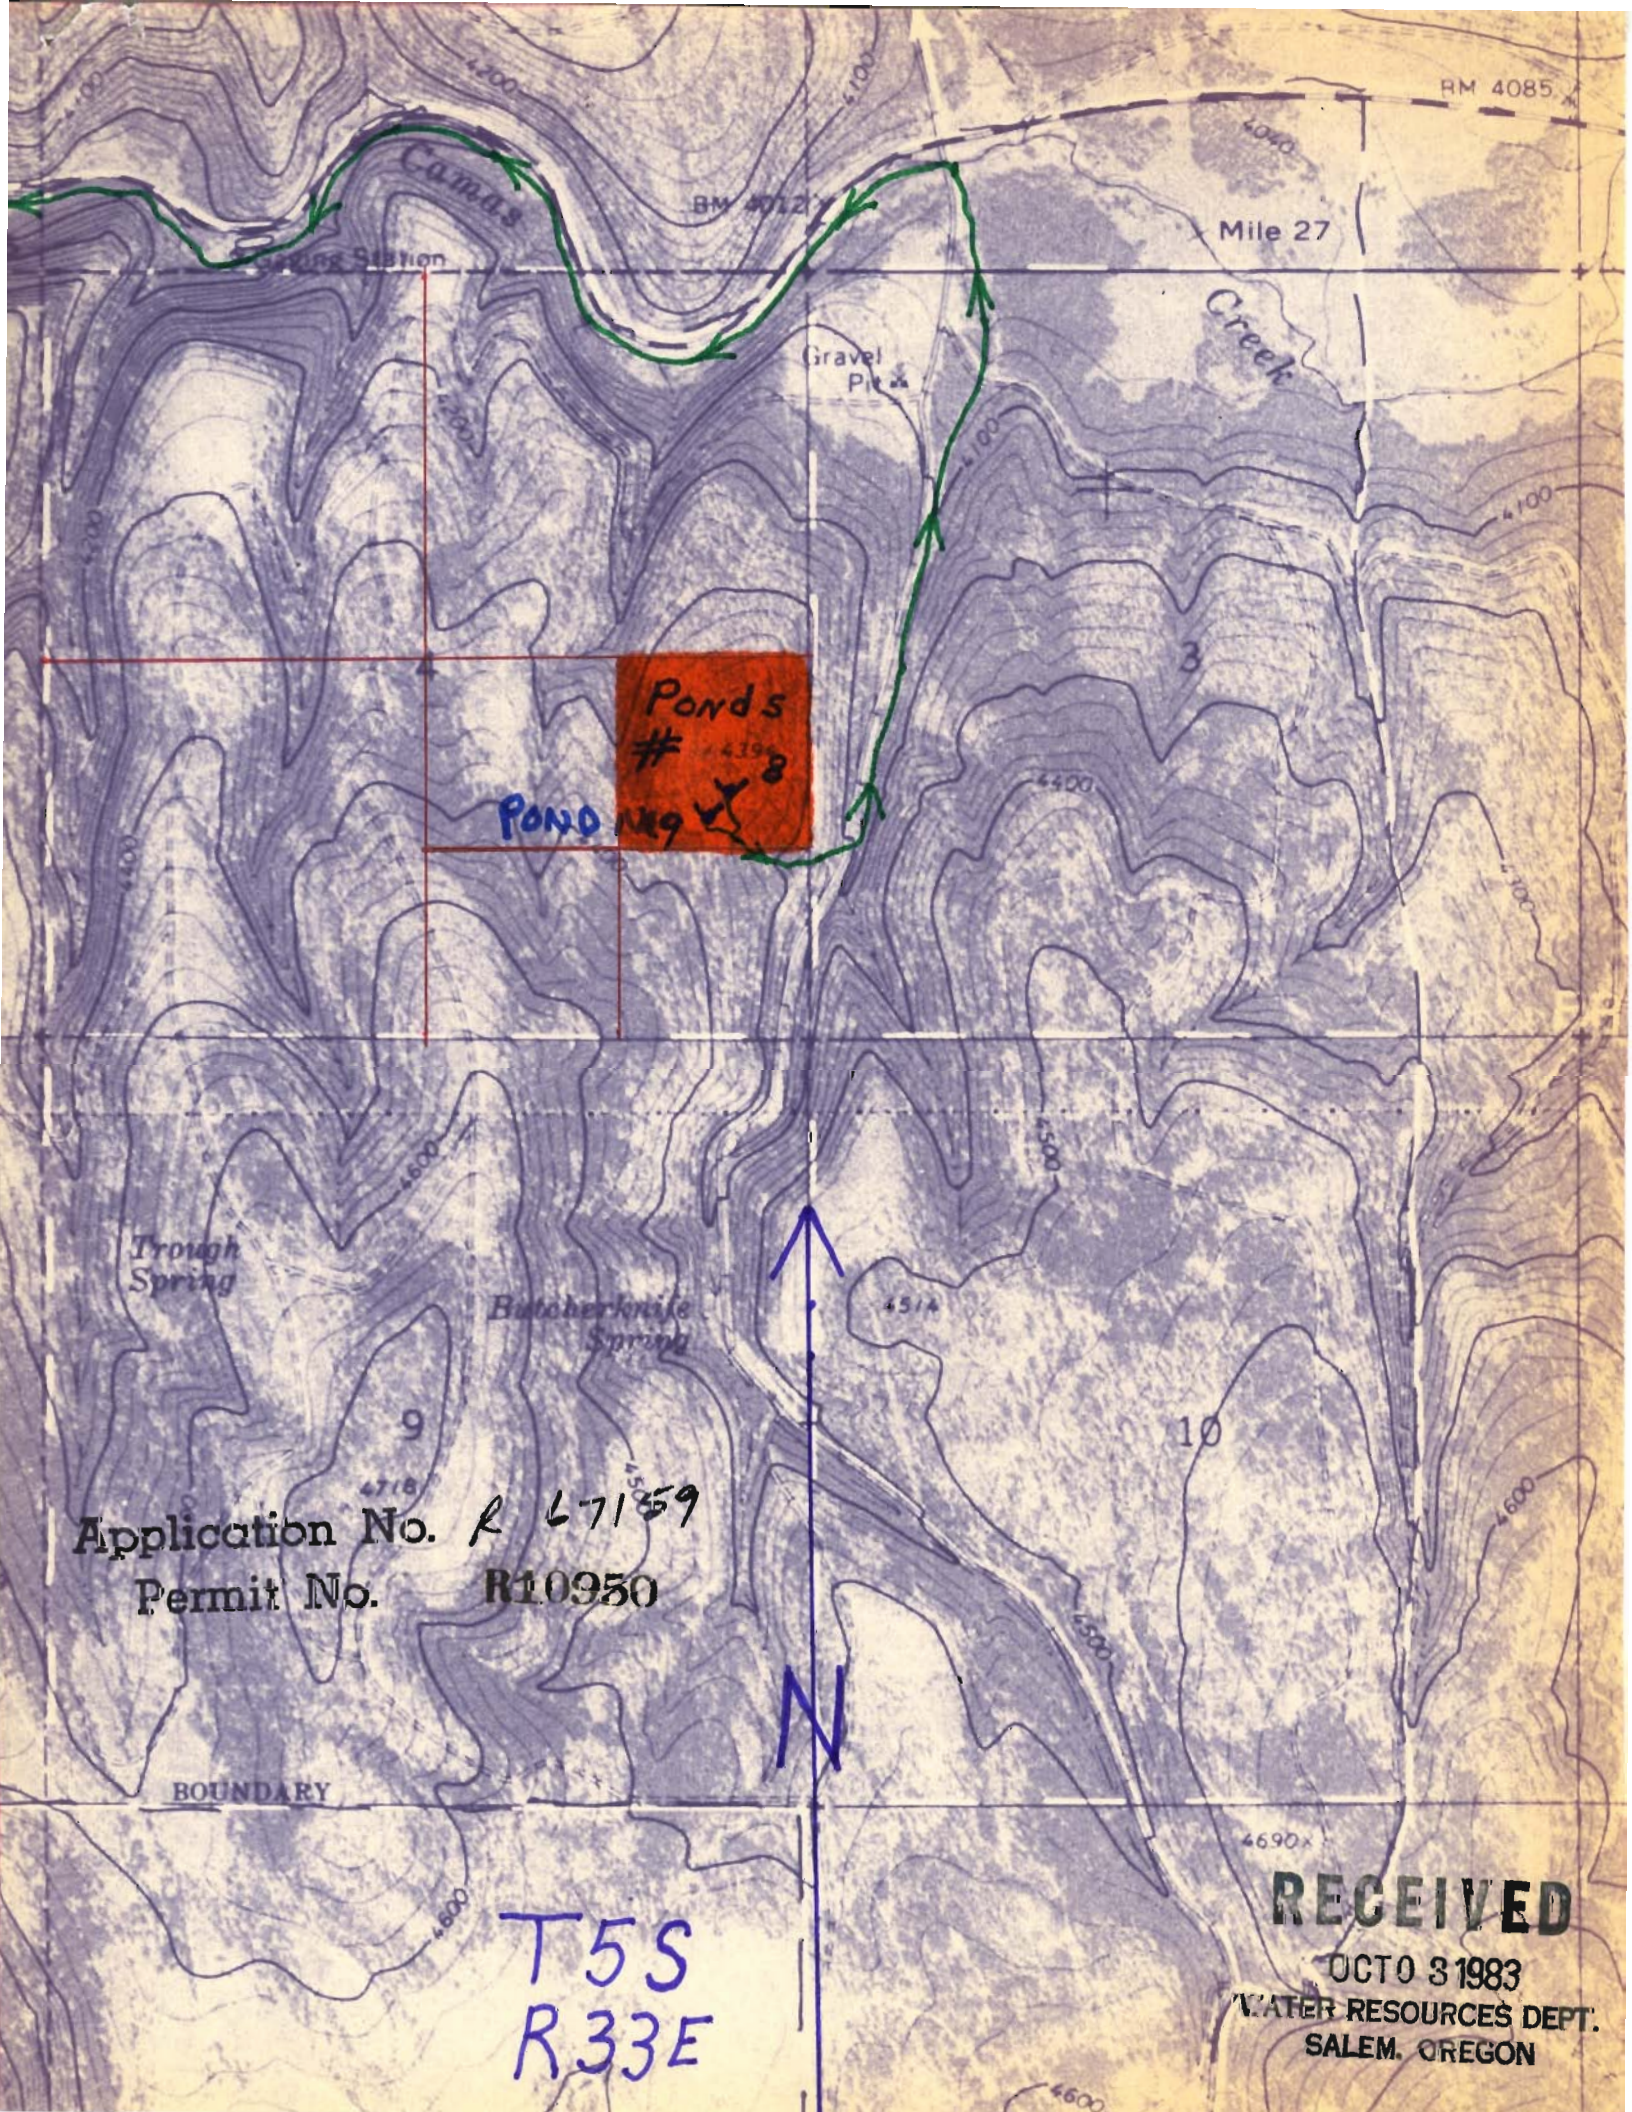

RM 4085

Mile 27

BM 4012

Gravel Pit

Ponds # 4398

POND No 9

Trough Spring

Butcherknife Spring

Application No. R 67159
Permit No. R10950

N

BOUNDARY

T5S
R33E

RECEIVED

OCT 03 1983

WATER RESOURCES DEPT.
SALEM, OREGON