


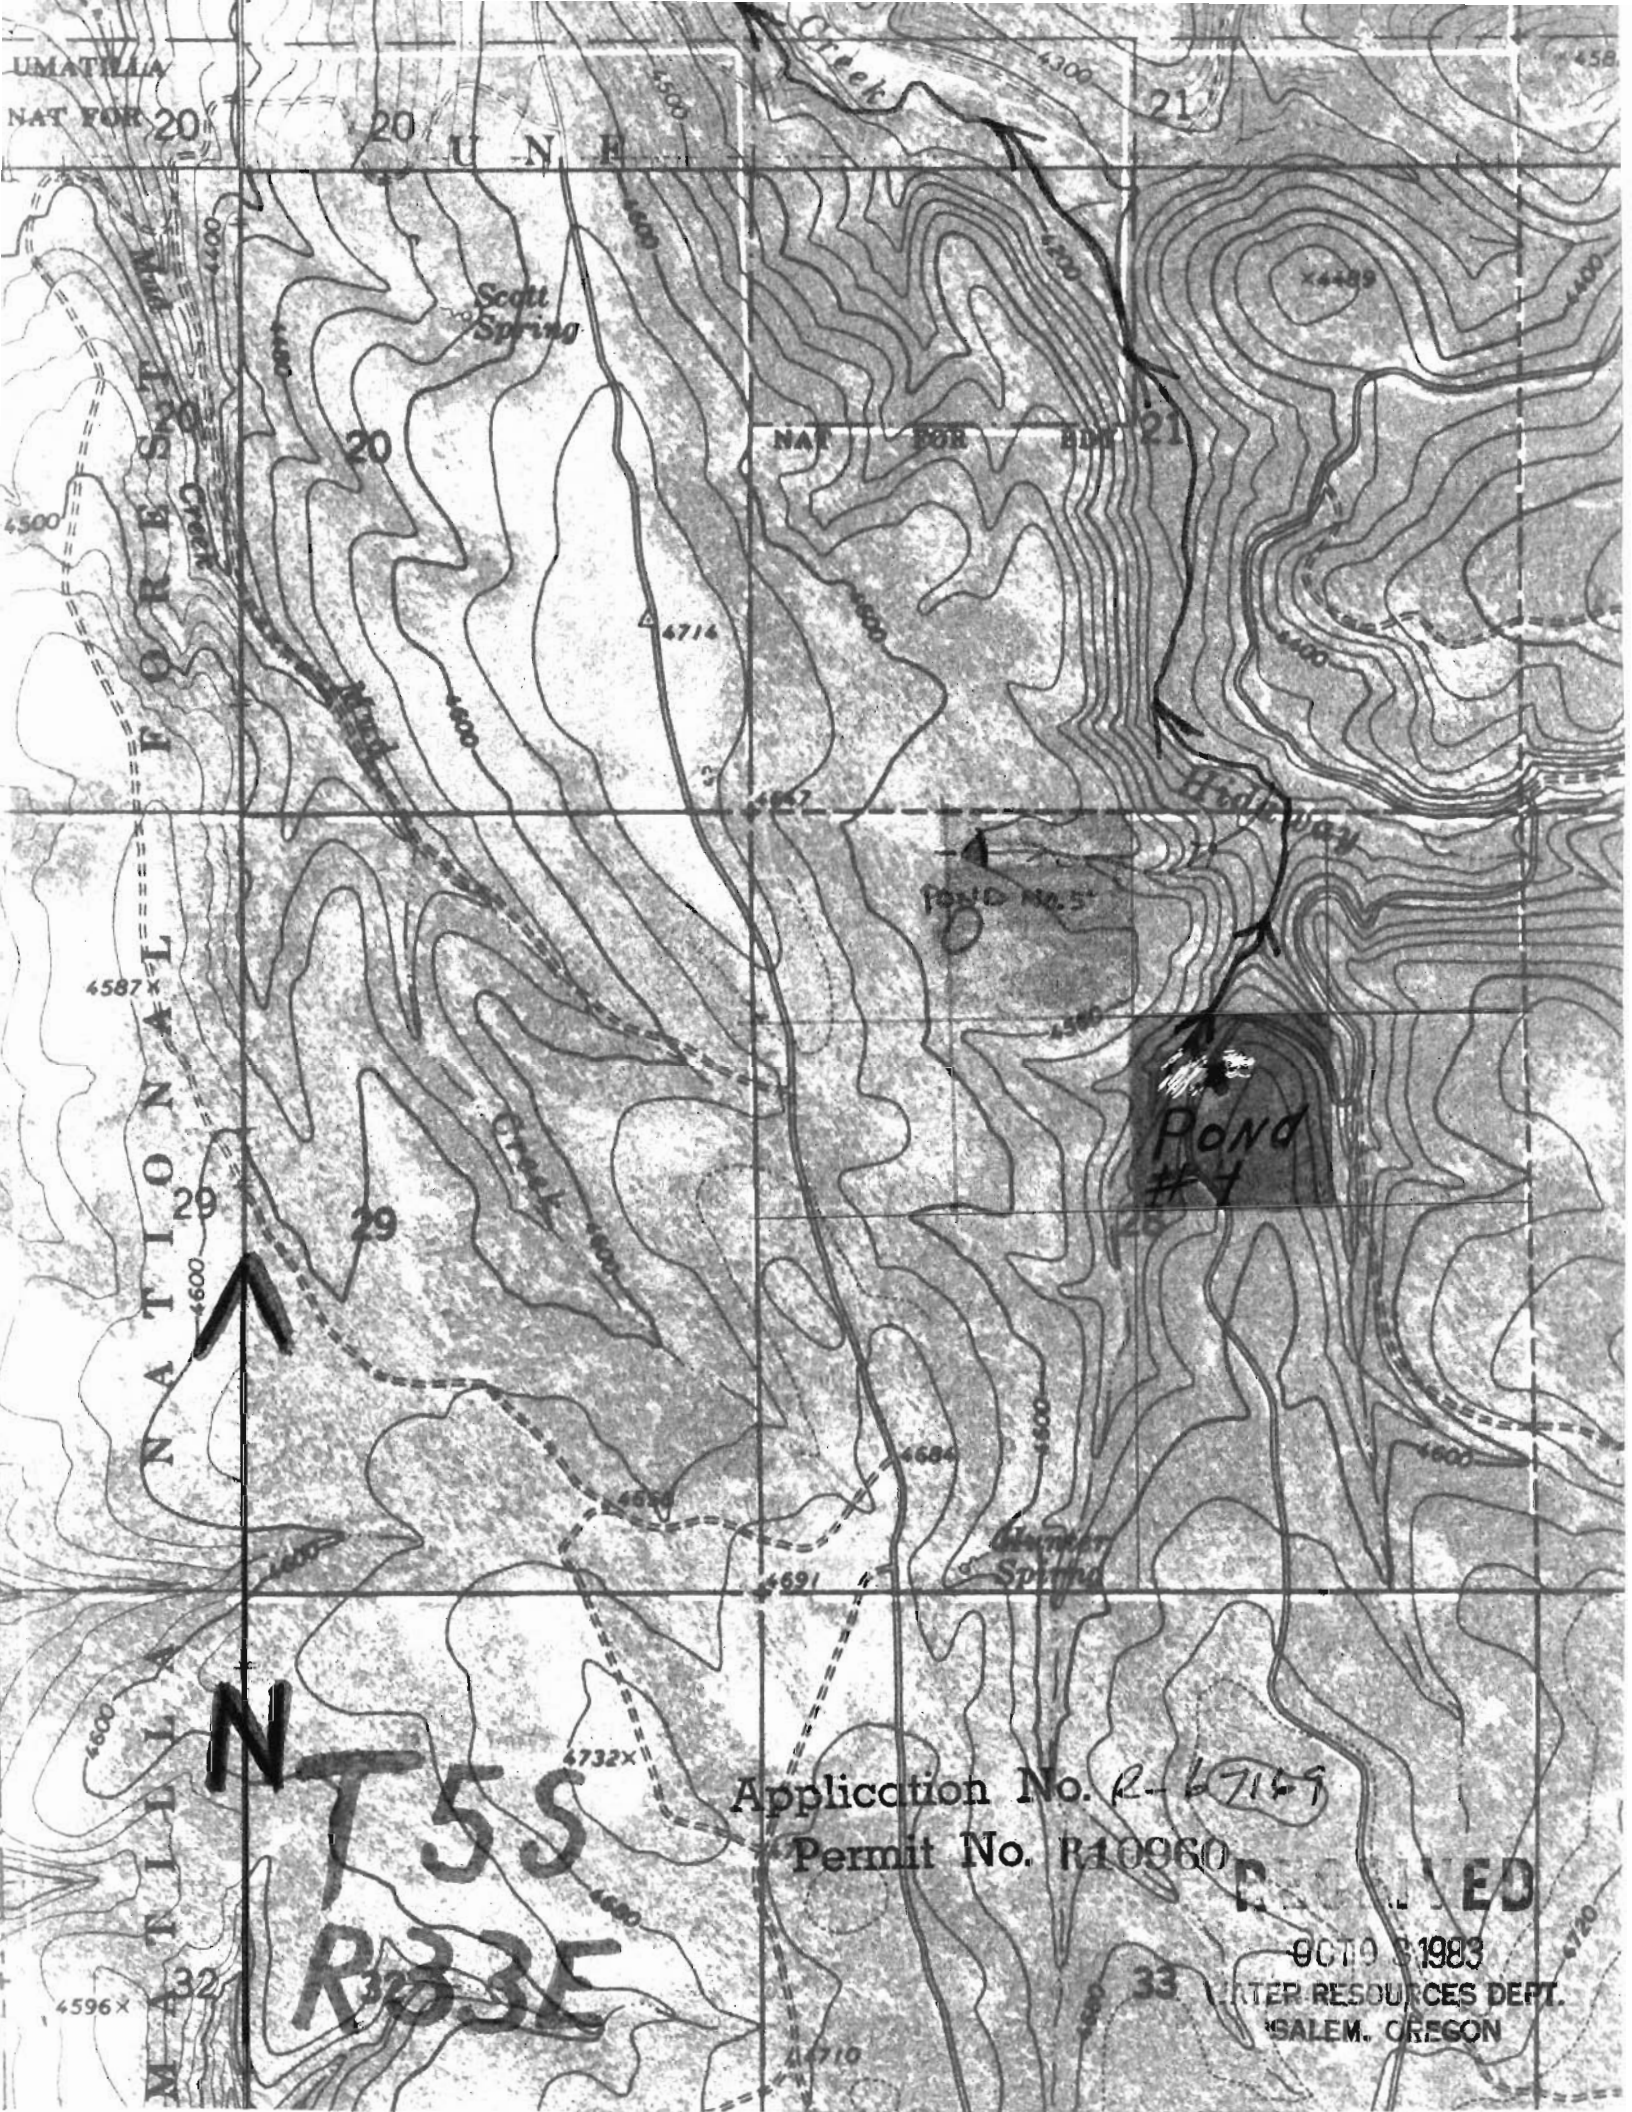

UMATILLA

NAT FOR 20

20 U N E

21

Scott Spring

NAT FOR BDR 21

N A T I O N A L F O R E S T

4587x

20

29

N

T5S
R33E

Application No. R-67149

Permit No. R10960

RESERVED

9010 31983

WATER RESOURCES DEPT.
SALEM, OREGON

4596x

32

33

4710