

HAROLD FRICK

3/4" pipe
crossed
Extension

330'

Proposed Extension
3/4" pipe
ELLA DEHART PROPERTY

Proposed Extension
3/4" pipe

NE 1/4 SE 1/4
SE 1/4 SE 1/4

COLUMBIA RIVER HIGHWAY
25 Year crossing permit
dated 11/10/45
150'

SCHMIDT

WILE
ANDERSON

A.S. KOLSTAD
Purchase

WATER RIGHT

Re Permit No 5452 0.05 cfs per sec
Ella DeHart has assigned of same
as follows:

A.L. ANDERSON	for Domestic use
SCHMIDT	" " "
HAROLD FRICK	" " "
W.R. McWILLIAMS	" " "

FOR HOMES
AS SHOWN ON
THIS PLAT IN
SE 1/4 OF SE 1/4
AND NE 1/4 OF SE 1/4
SEC 27. T3N R10
E1/4M.


6/10/37
A.S. KOLSTAD
ELLA DEHART PROPERTY
CONTRACT
to buy

T3N R10 E1/4M
SCALE 1"=200'

file April 8407
5452

1320

NE 1/4 of SE 1/4 of Sec 27 T3 N RIDGEM
OWNER MISS ELLA DeHart P.O. Land, Ore

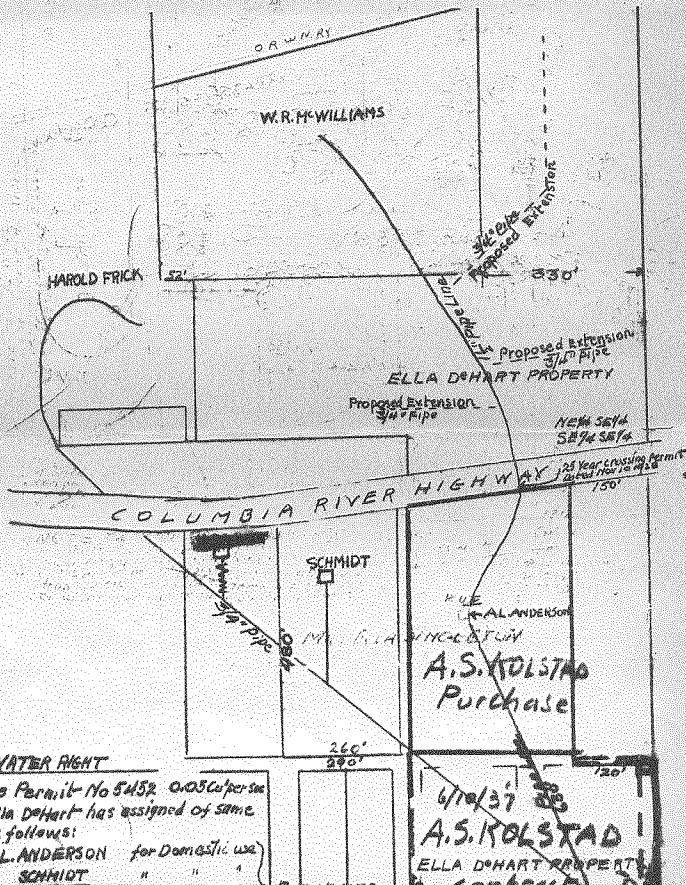


WATER RIGHT

Re Permit No 5452 0.03 cfs per sec
Ella DeHart has assigned of same
as follows:

- A.L. ANDERSON for Domestic use
- SCHMIDT " " "

6/10/37
A.S. KOLSTAD
 ELLA DeHART PROPERTY
 BY CONTRACT

COLUMBIA RIVER HIGHWAY

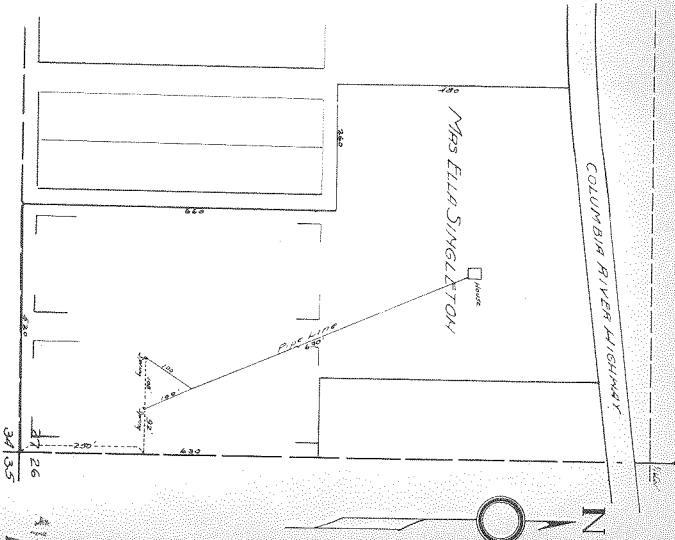

PLAT

Accompanying application for
permit to appropriate water
for domestic use by

MRS ELLA SINGLETON

In the S.E. 1/4 Sec 27, T. 3 N, R. 10 E, M. 1 N
HOOD RIVER - OREGON;
Scale 1" = 200' May 20th 1922

CERTIFICATE of SURVEYOR

I, W. R. Gault, of Hood River, Oregon,
hereby certify that this plat was
made from notes taken during an
actual survey made under my super-
vision on May 18th, 1922, and that it
correctly represents the works dis-
cussed; the accompanying application,
together with the location of streams
and other details in the immediate
vicinity.

W. R. Gault
Registered Professional Engineer
Oregon No. 545
Registered Dec. 8th, 1919.

Application No. 5407
Permit No. 5452