


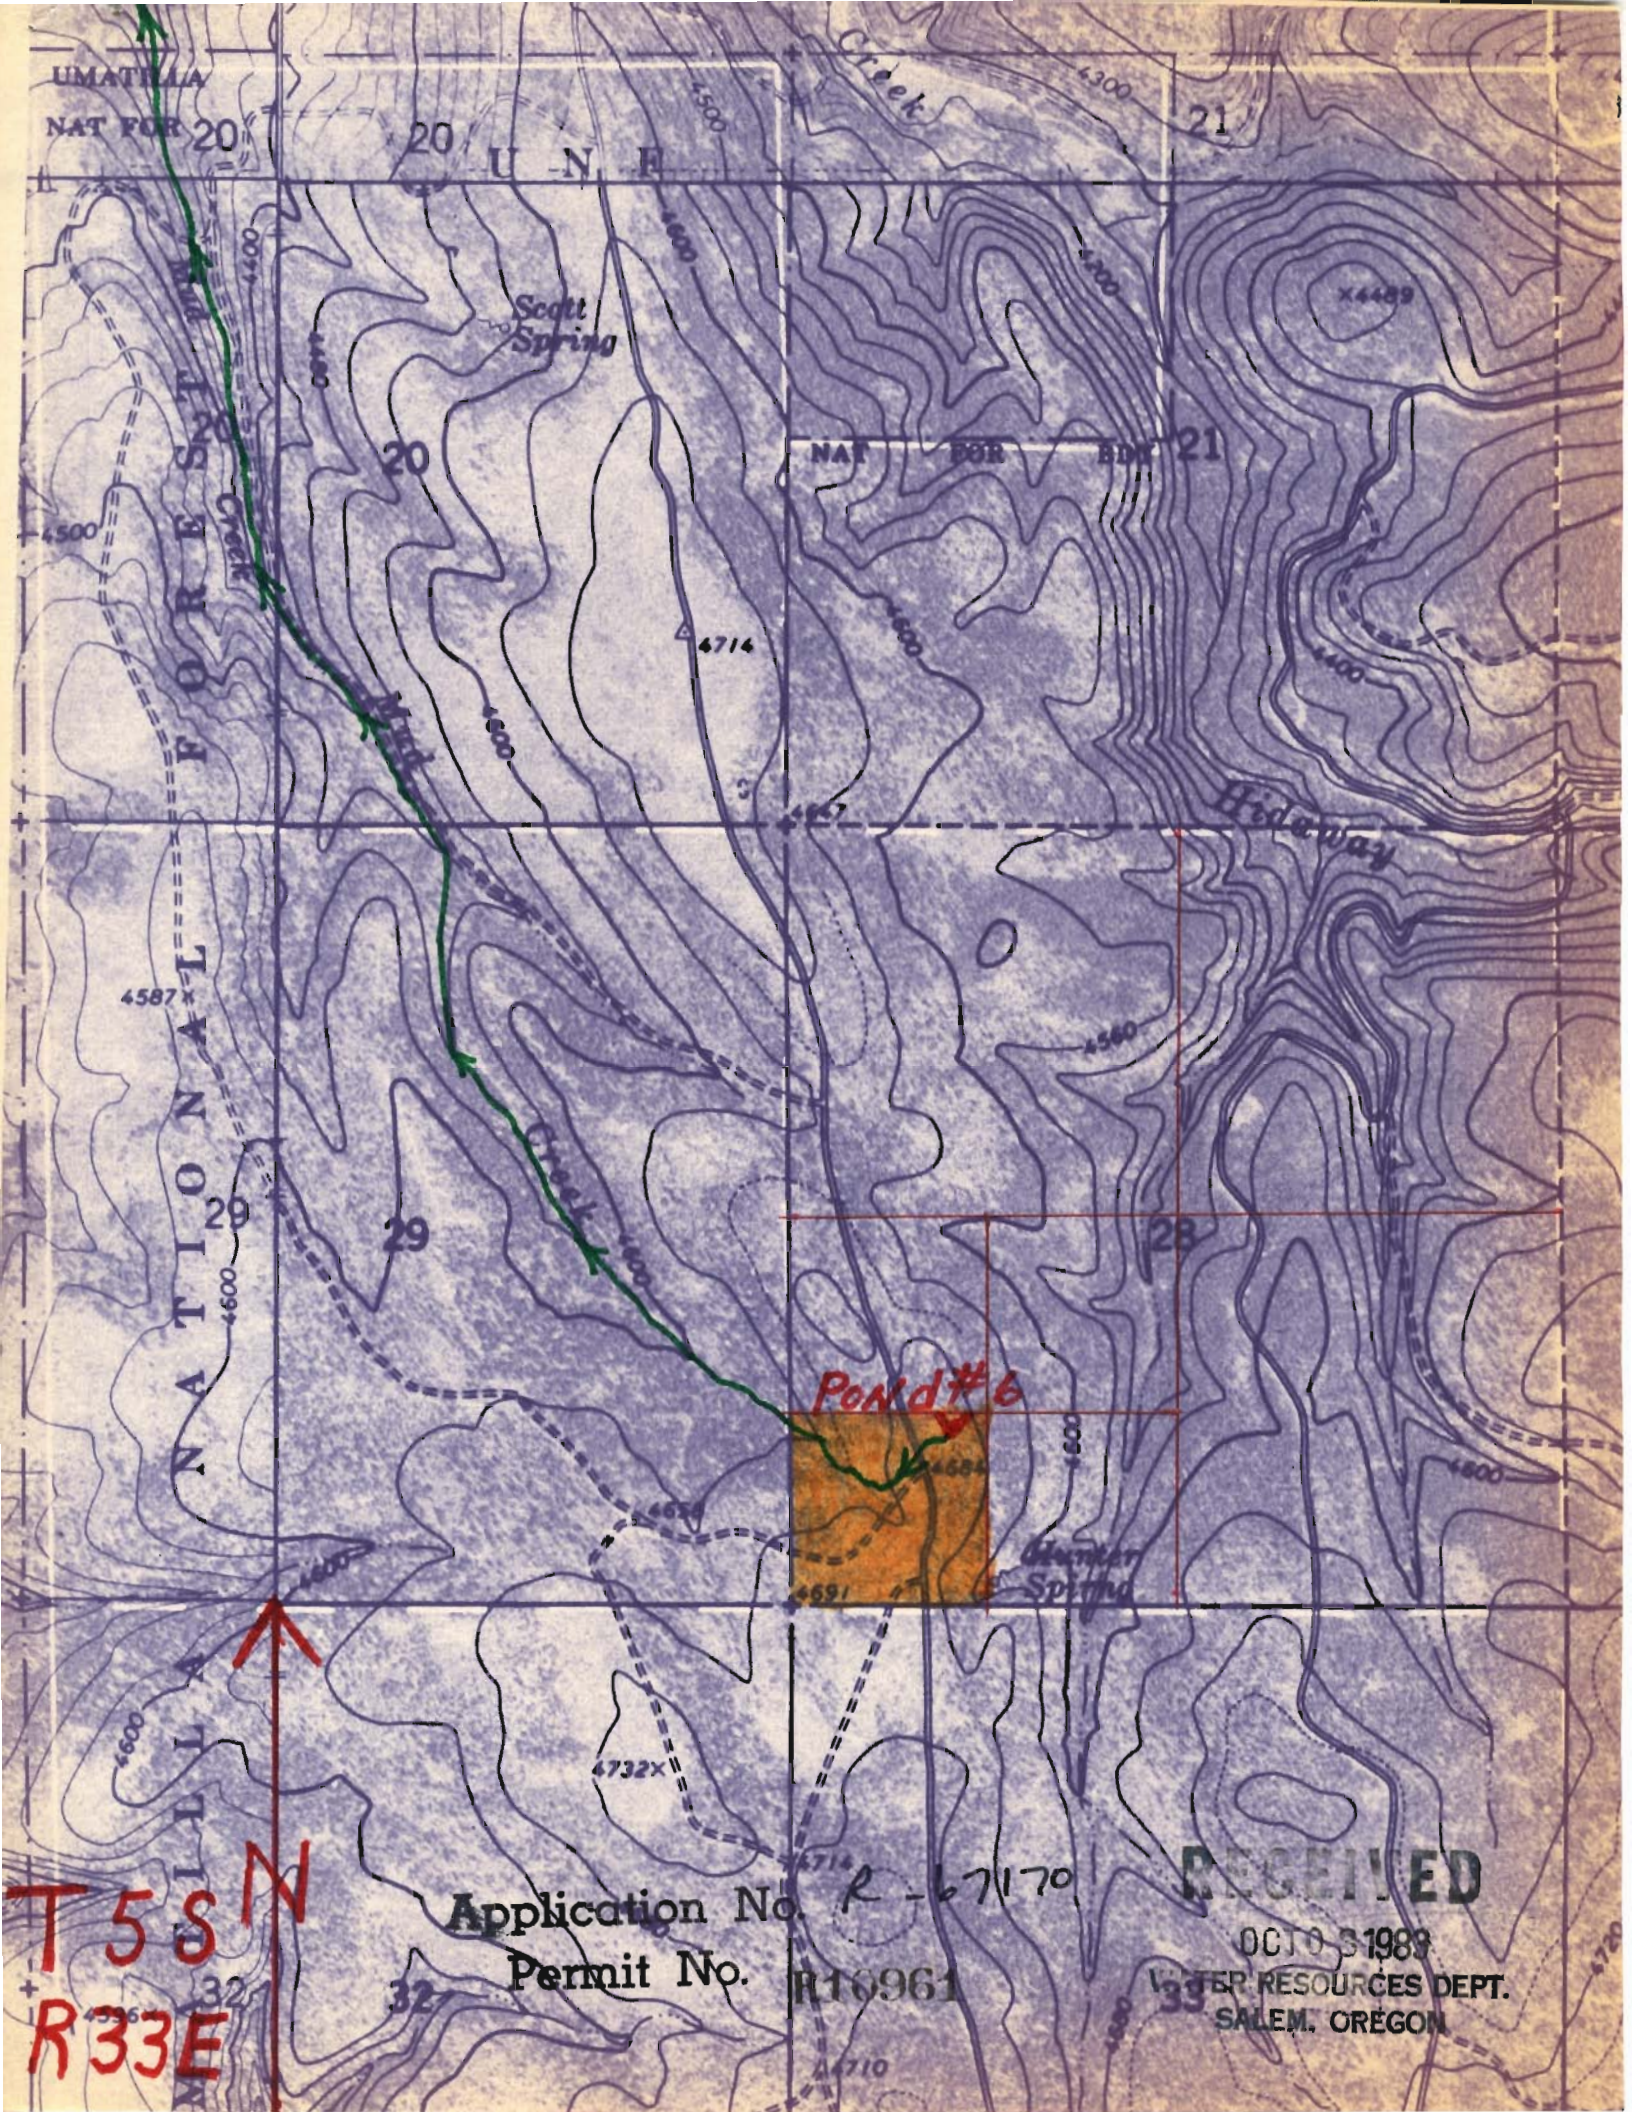

UMATILLA
NAT FOR 20

U N E

N A T I O N A L F O R E S T

Scott
Spring

NAT FOR EDC 21

Hedaway

Pond #6

Hunter
Spring

T58N
R33E

Application No. R-67170
Permit No. R16961

RECEIVED

OCT 31 1983

WATER RESOURCES DEPT.
SALEM, OREGON