


RECEIVED

OCT 03 1983
WATER RESOURCES DEPT.
SALEM, OREGON

Application No. R-67245
Permit No. R10968

25
Pond#
4768 x

T4S N
R33E

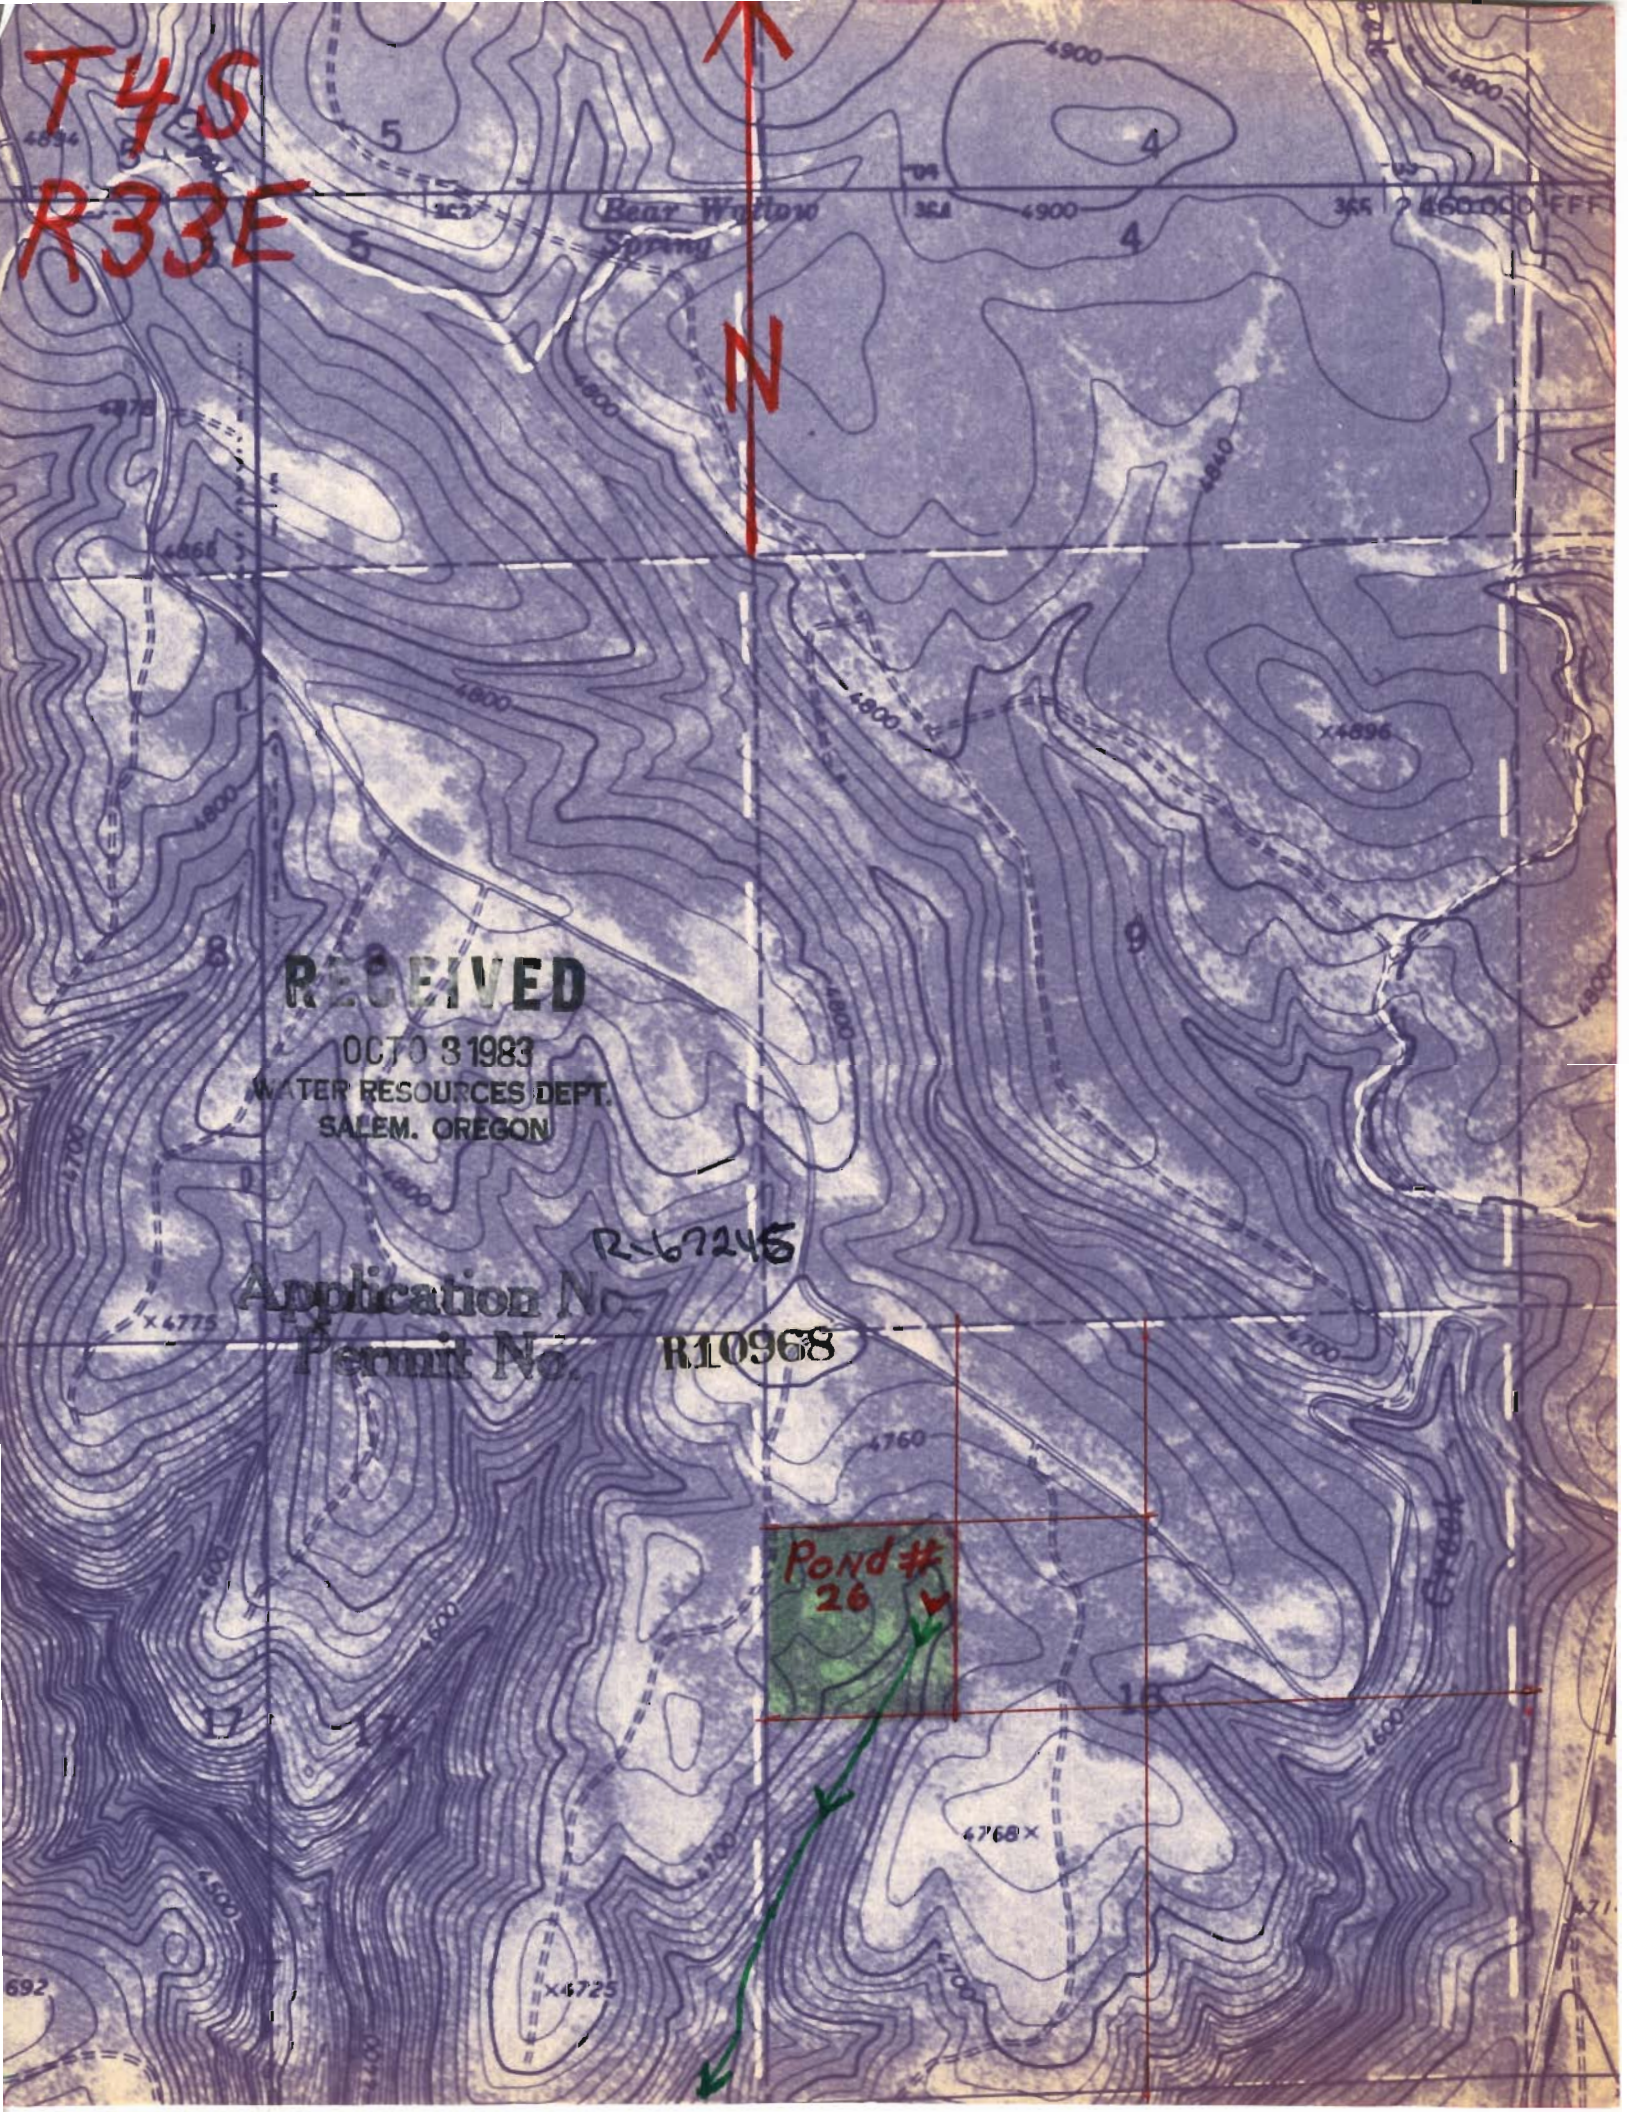

T4S
R33E

N

RECEIVED

OCT 03 1983
WATER RESOURCES DEPT.
SALEM, OREGON

R-67245

Application No.

Permit No.

R10968

Pond #
26

Creek

T4S
R33E

Bear Wallow
Spring

RECEIVED

OCT 03 1983
WATER RESOURCES DEPT.
SALEM, OREGON

Application No. R-57245
Permit No. R10968

Pond
31