


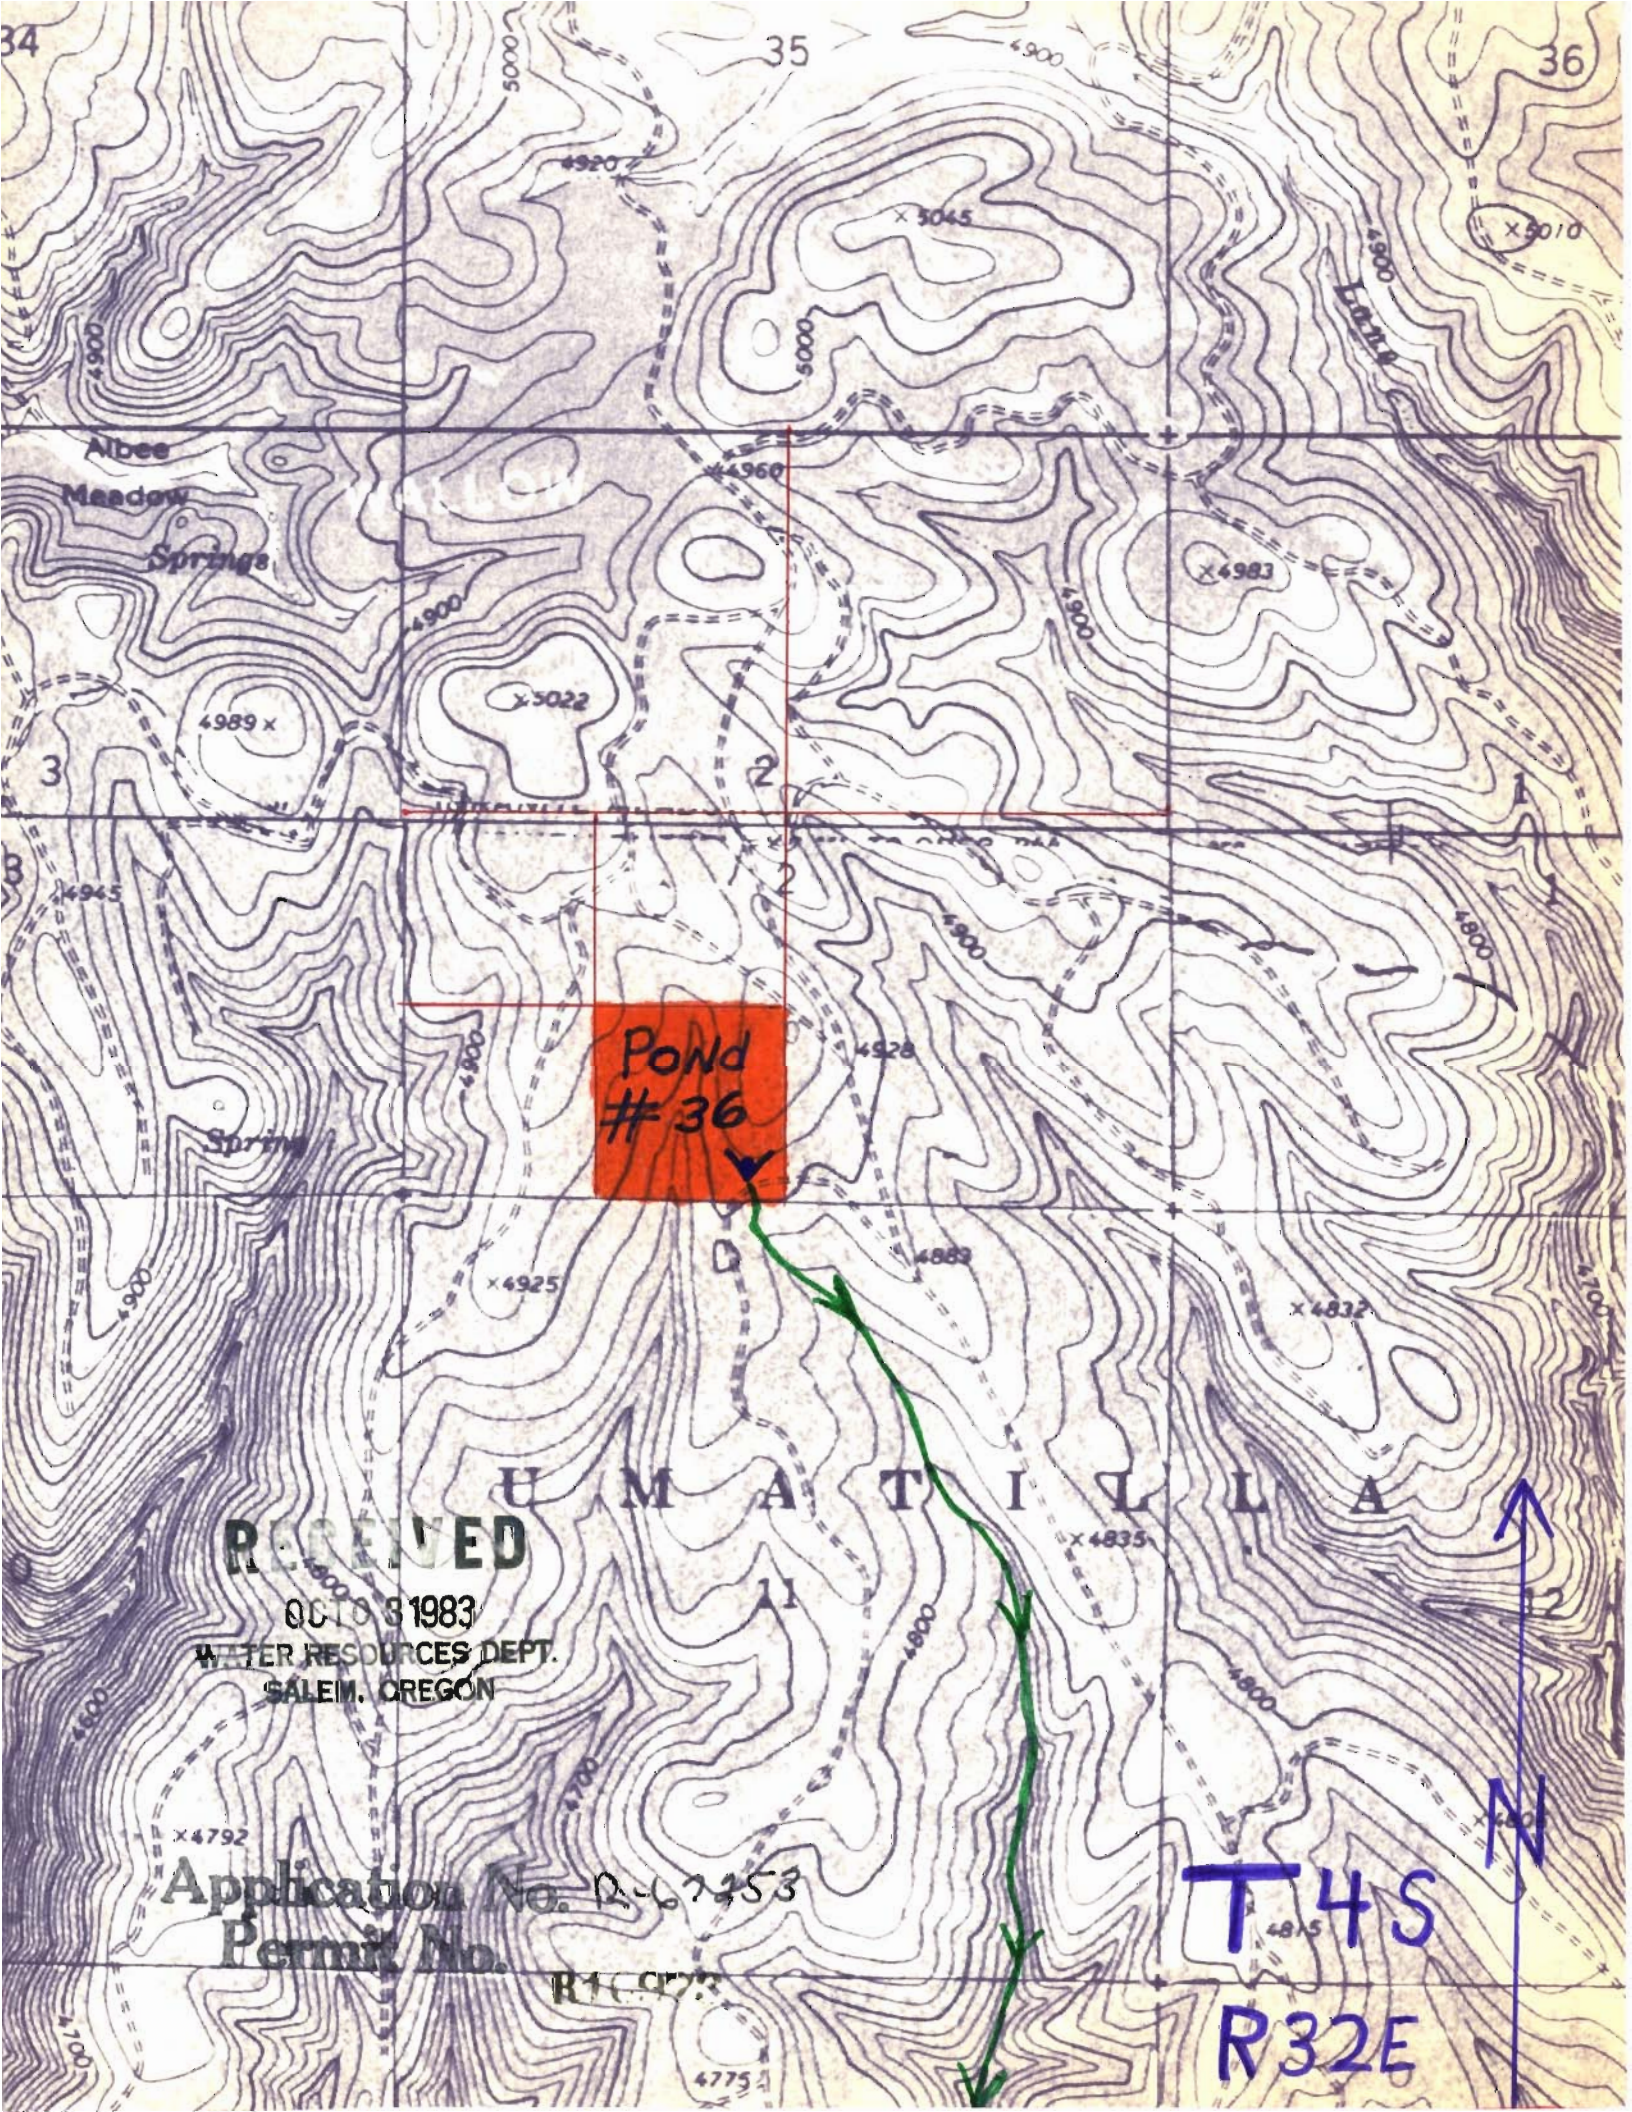

Pond
#36

RECEIVED

OCT 8 1983
WATER RESOURCES DEPT.
SALEM, OREGON


T4S
R32E



WALLOW

PROPOSED

OCT 8 1983
WATER RESOURCES DEPT
SALEM, OREGON

Application No. R-67253
Permit No. R10973

POND
#43

N T4S
R32E