


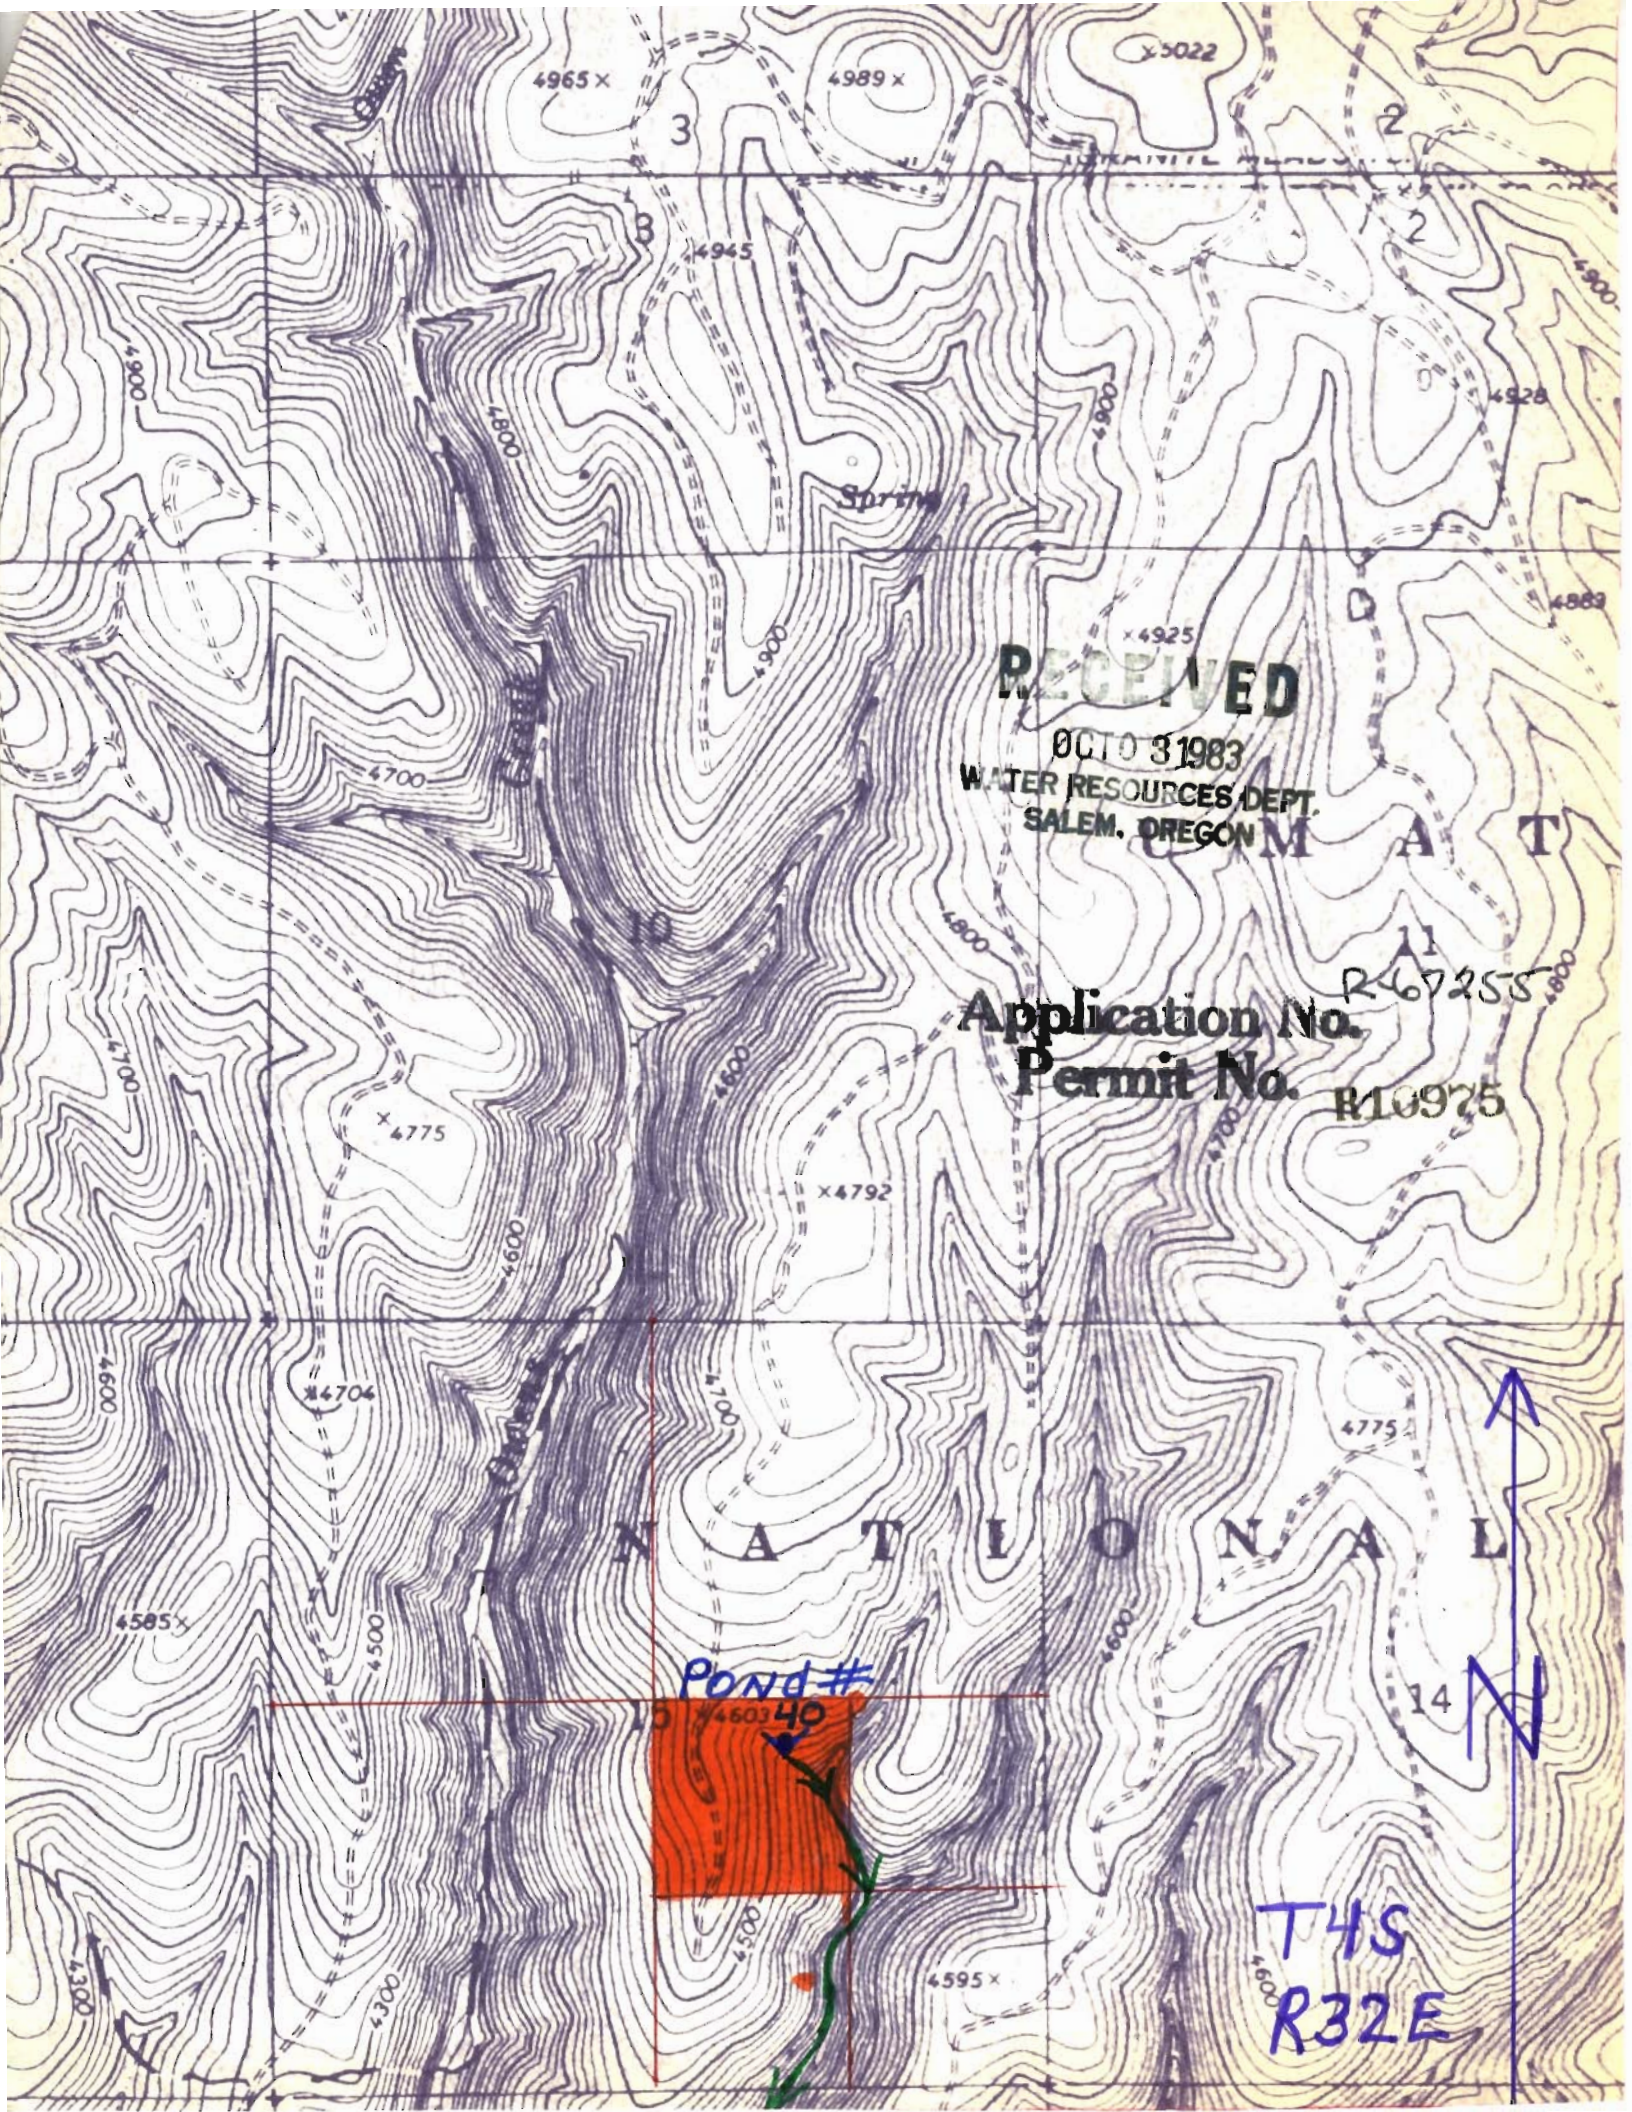

4965 x

4989 x

x 5022

4945

Spring

RECEIVED

OCT 31 1983

WATER RESOURCES DEPT.
SALEM, OREGON

Application No.
Permit No.

R467255

R10975

x 4775

x 4792

x 4706

4775

NATIONAL

Pond #

4603 40

T4S
R32E

14 N