


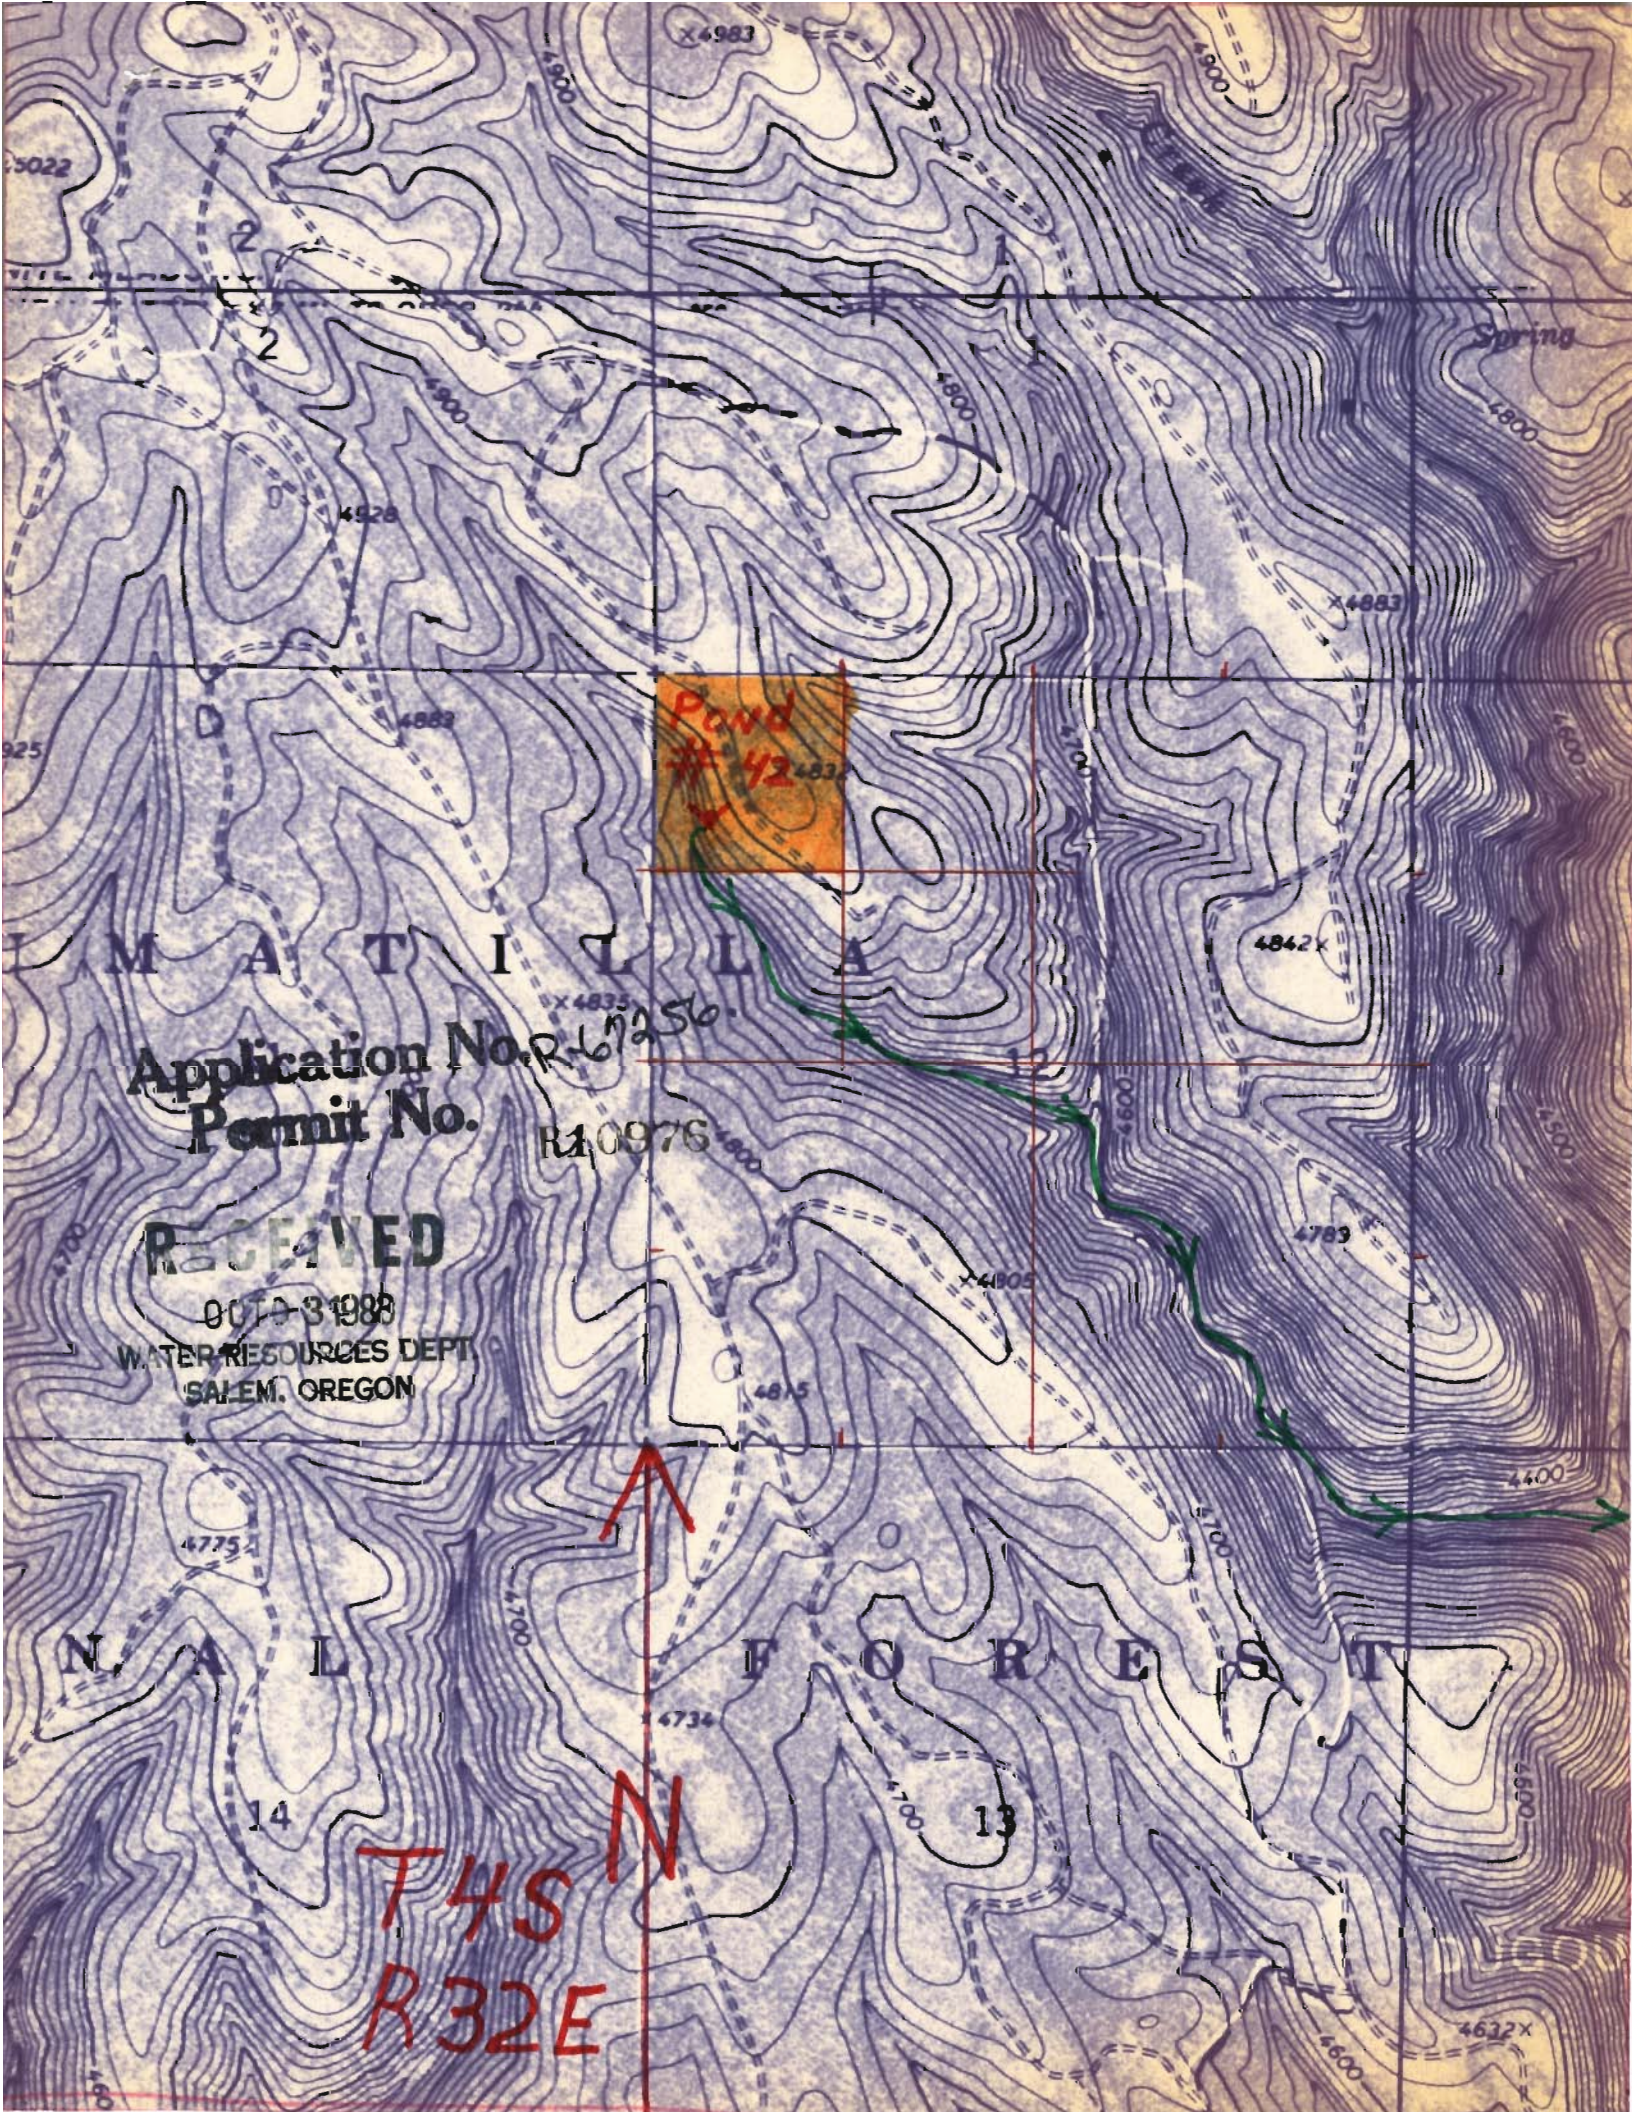

Powd
42

Application No. R-67256
Permit No. R10976

RECEIVED

0010-31988
WATER RESOURCES DEPT
SALEM, OREGON

T4S
R32E

N A L F O R E S T

Spring