


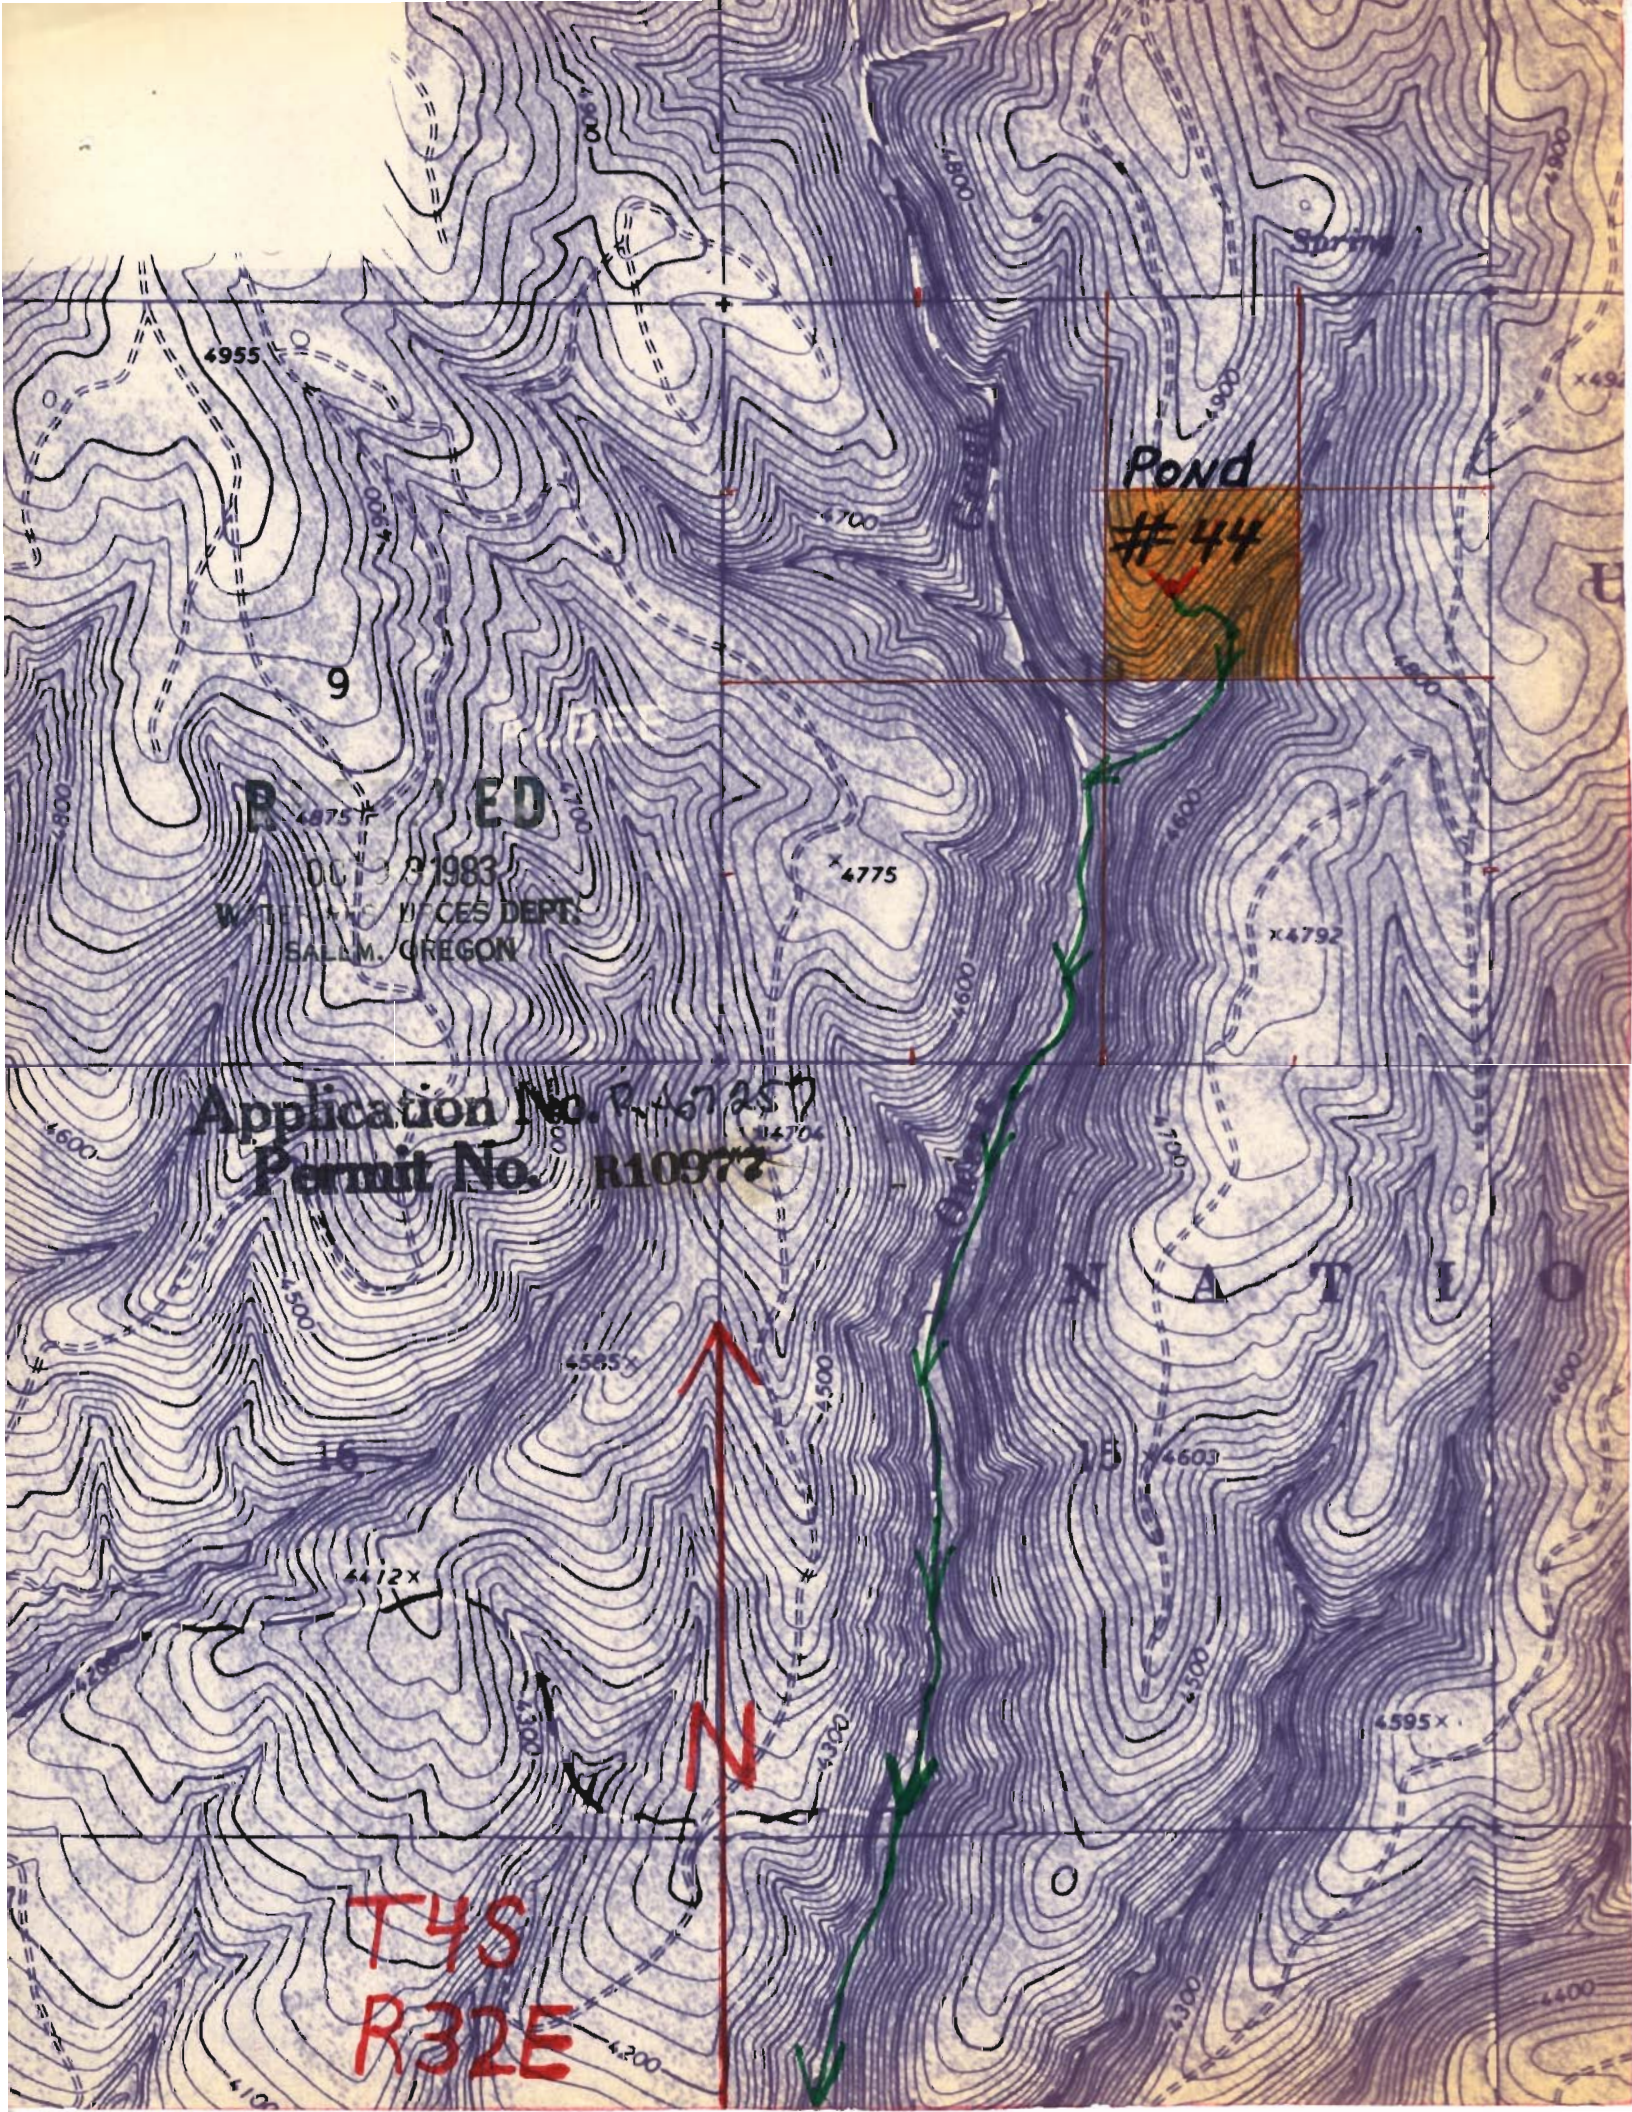

Pond
#44

ED
1983
WATER RESOURCES DEPT.
SALLAM, OREGON

Application No. R-467257
Permit No. R10972

T4S
R32E

T4S
R32E

5106

N

Pond
#45

RECEIVED

DEC 3 1983

WATER RESOURCES DEPT
SALEM, OREGON

Application No.

Permit No. R10972