


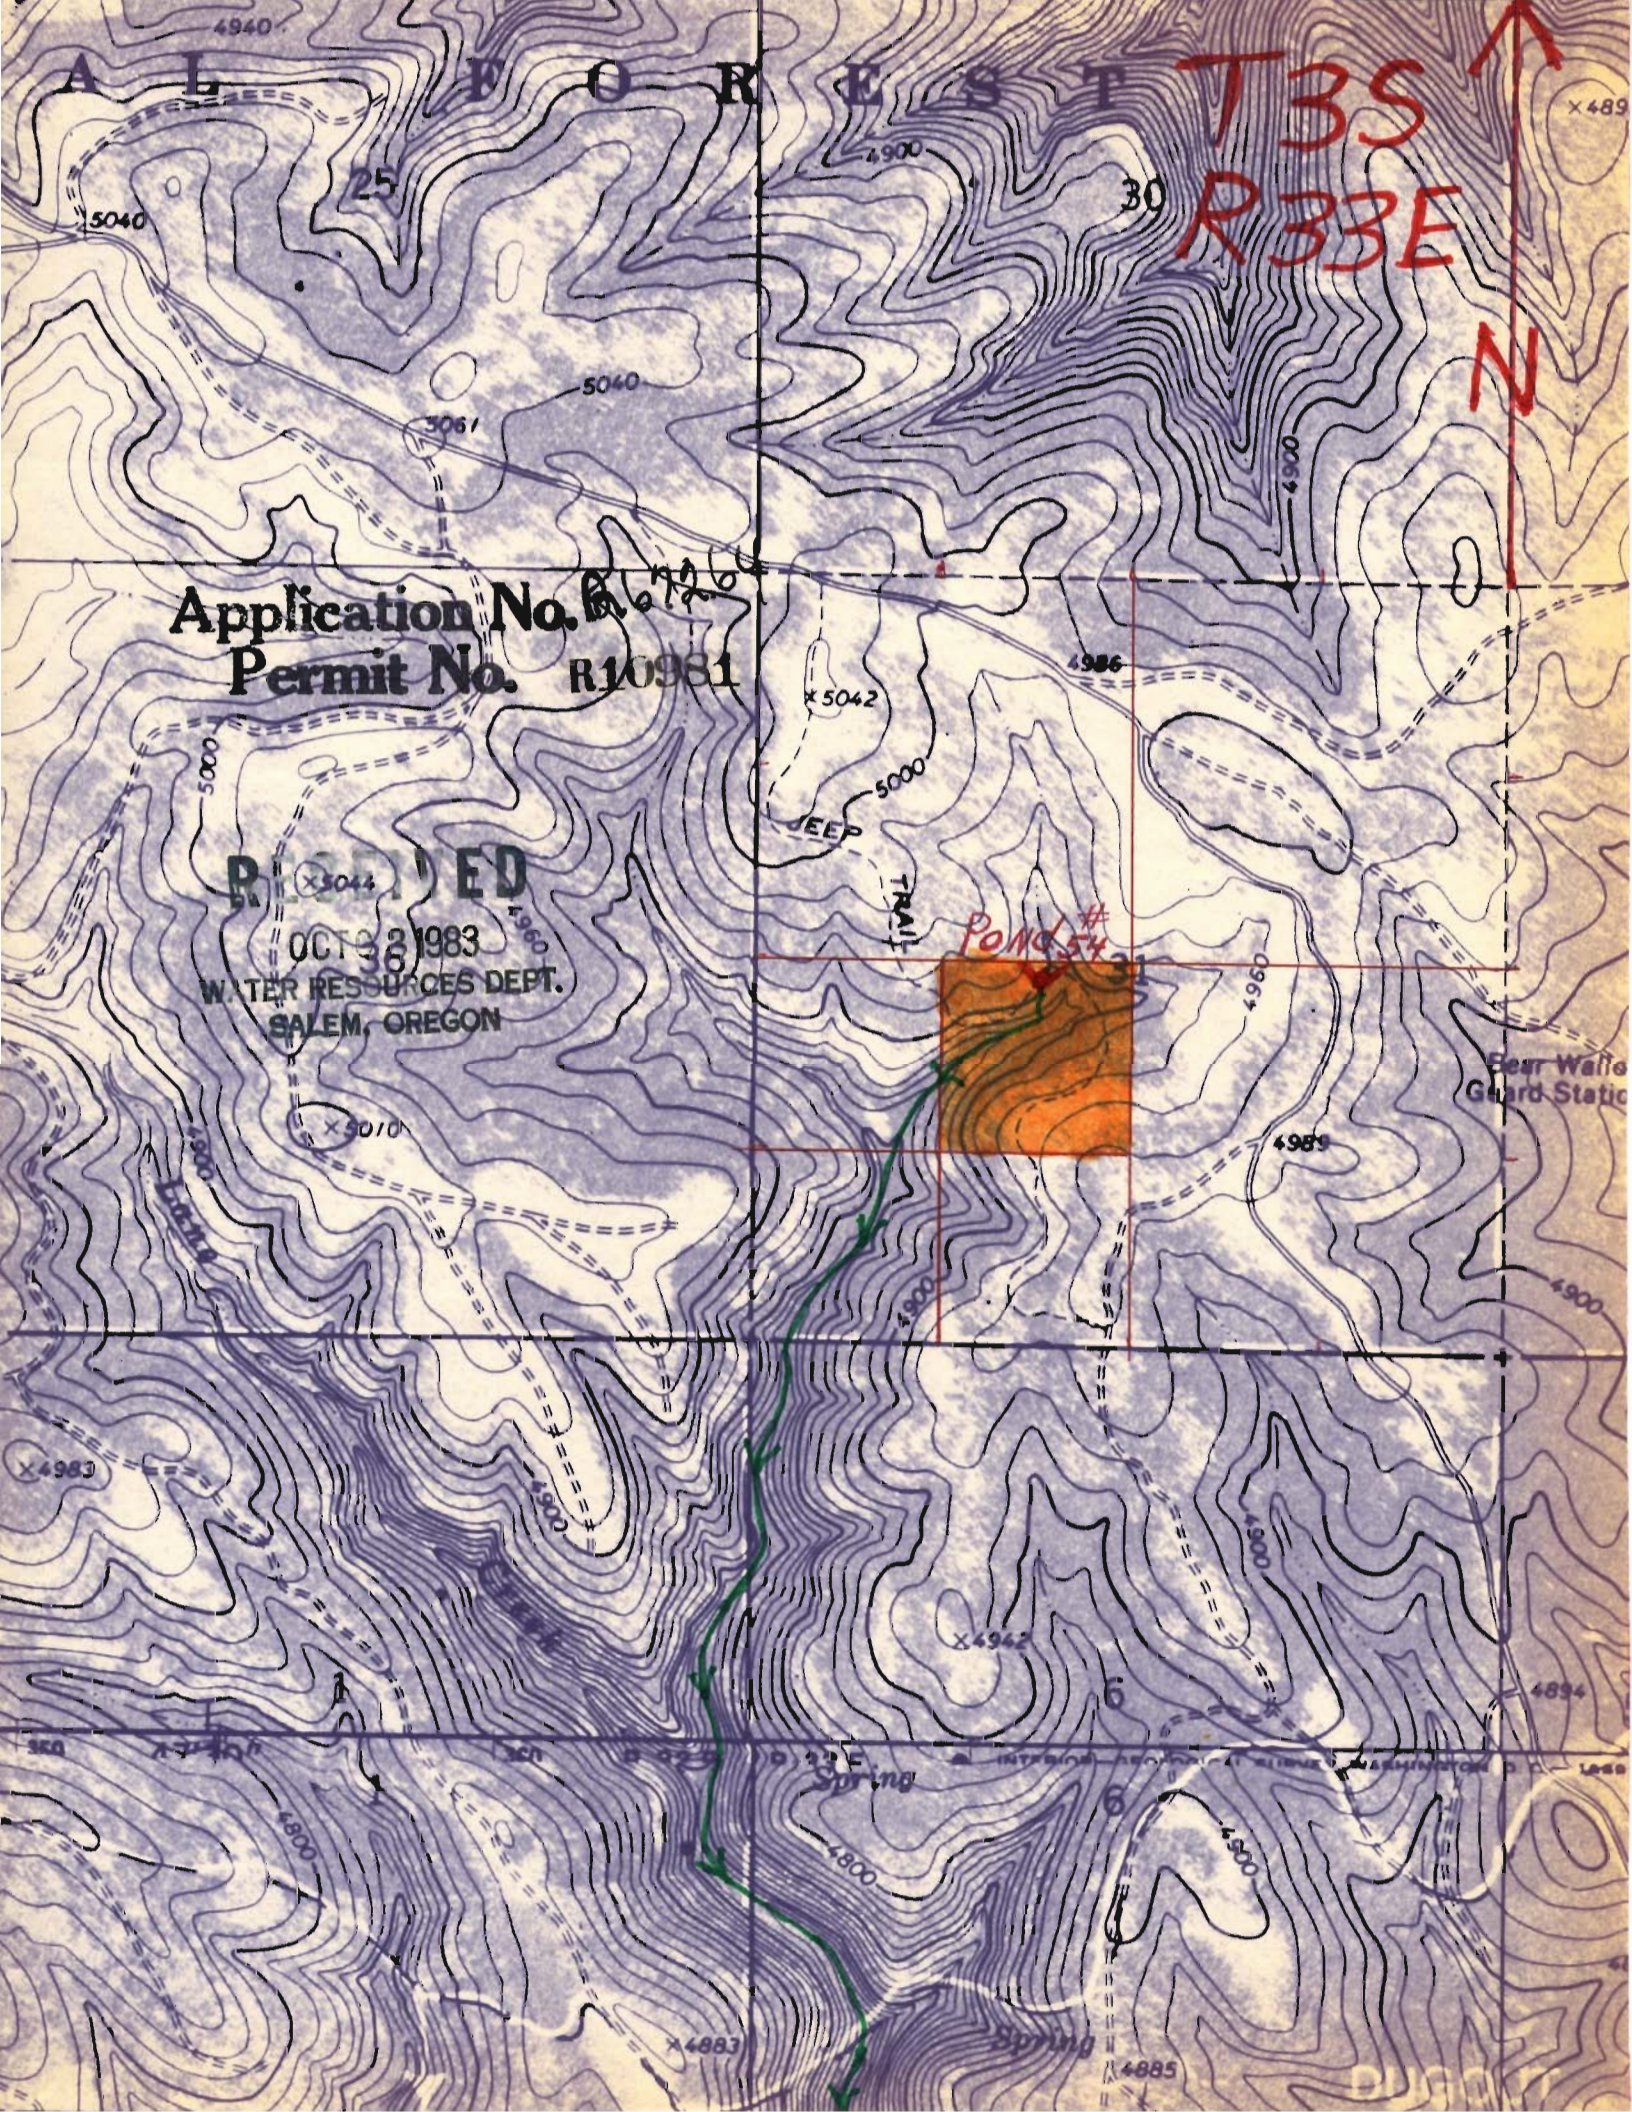

Permit No. R10981

RECEIVED
OCT 23 1983
WATER RESOURCES DEPT.
SALEM, OREGON

POND #54

Bear Waits
Guard Station

Spring

Spring

DUGOUT