


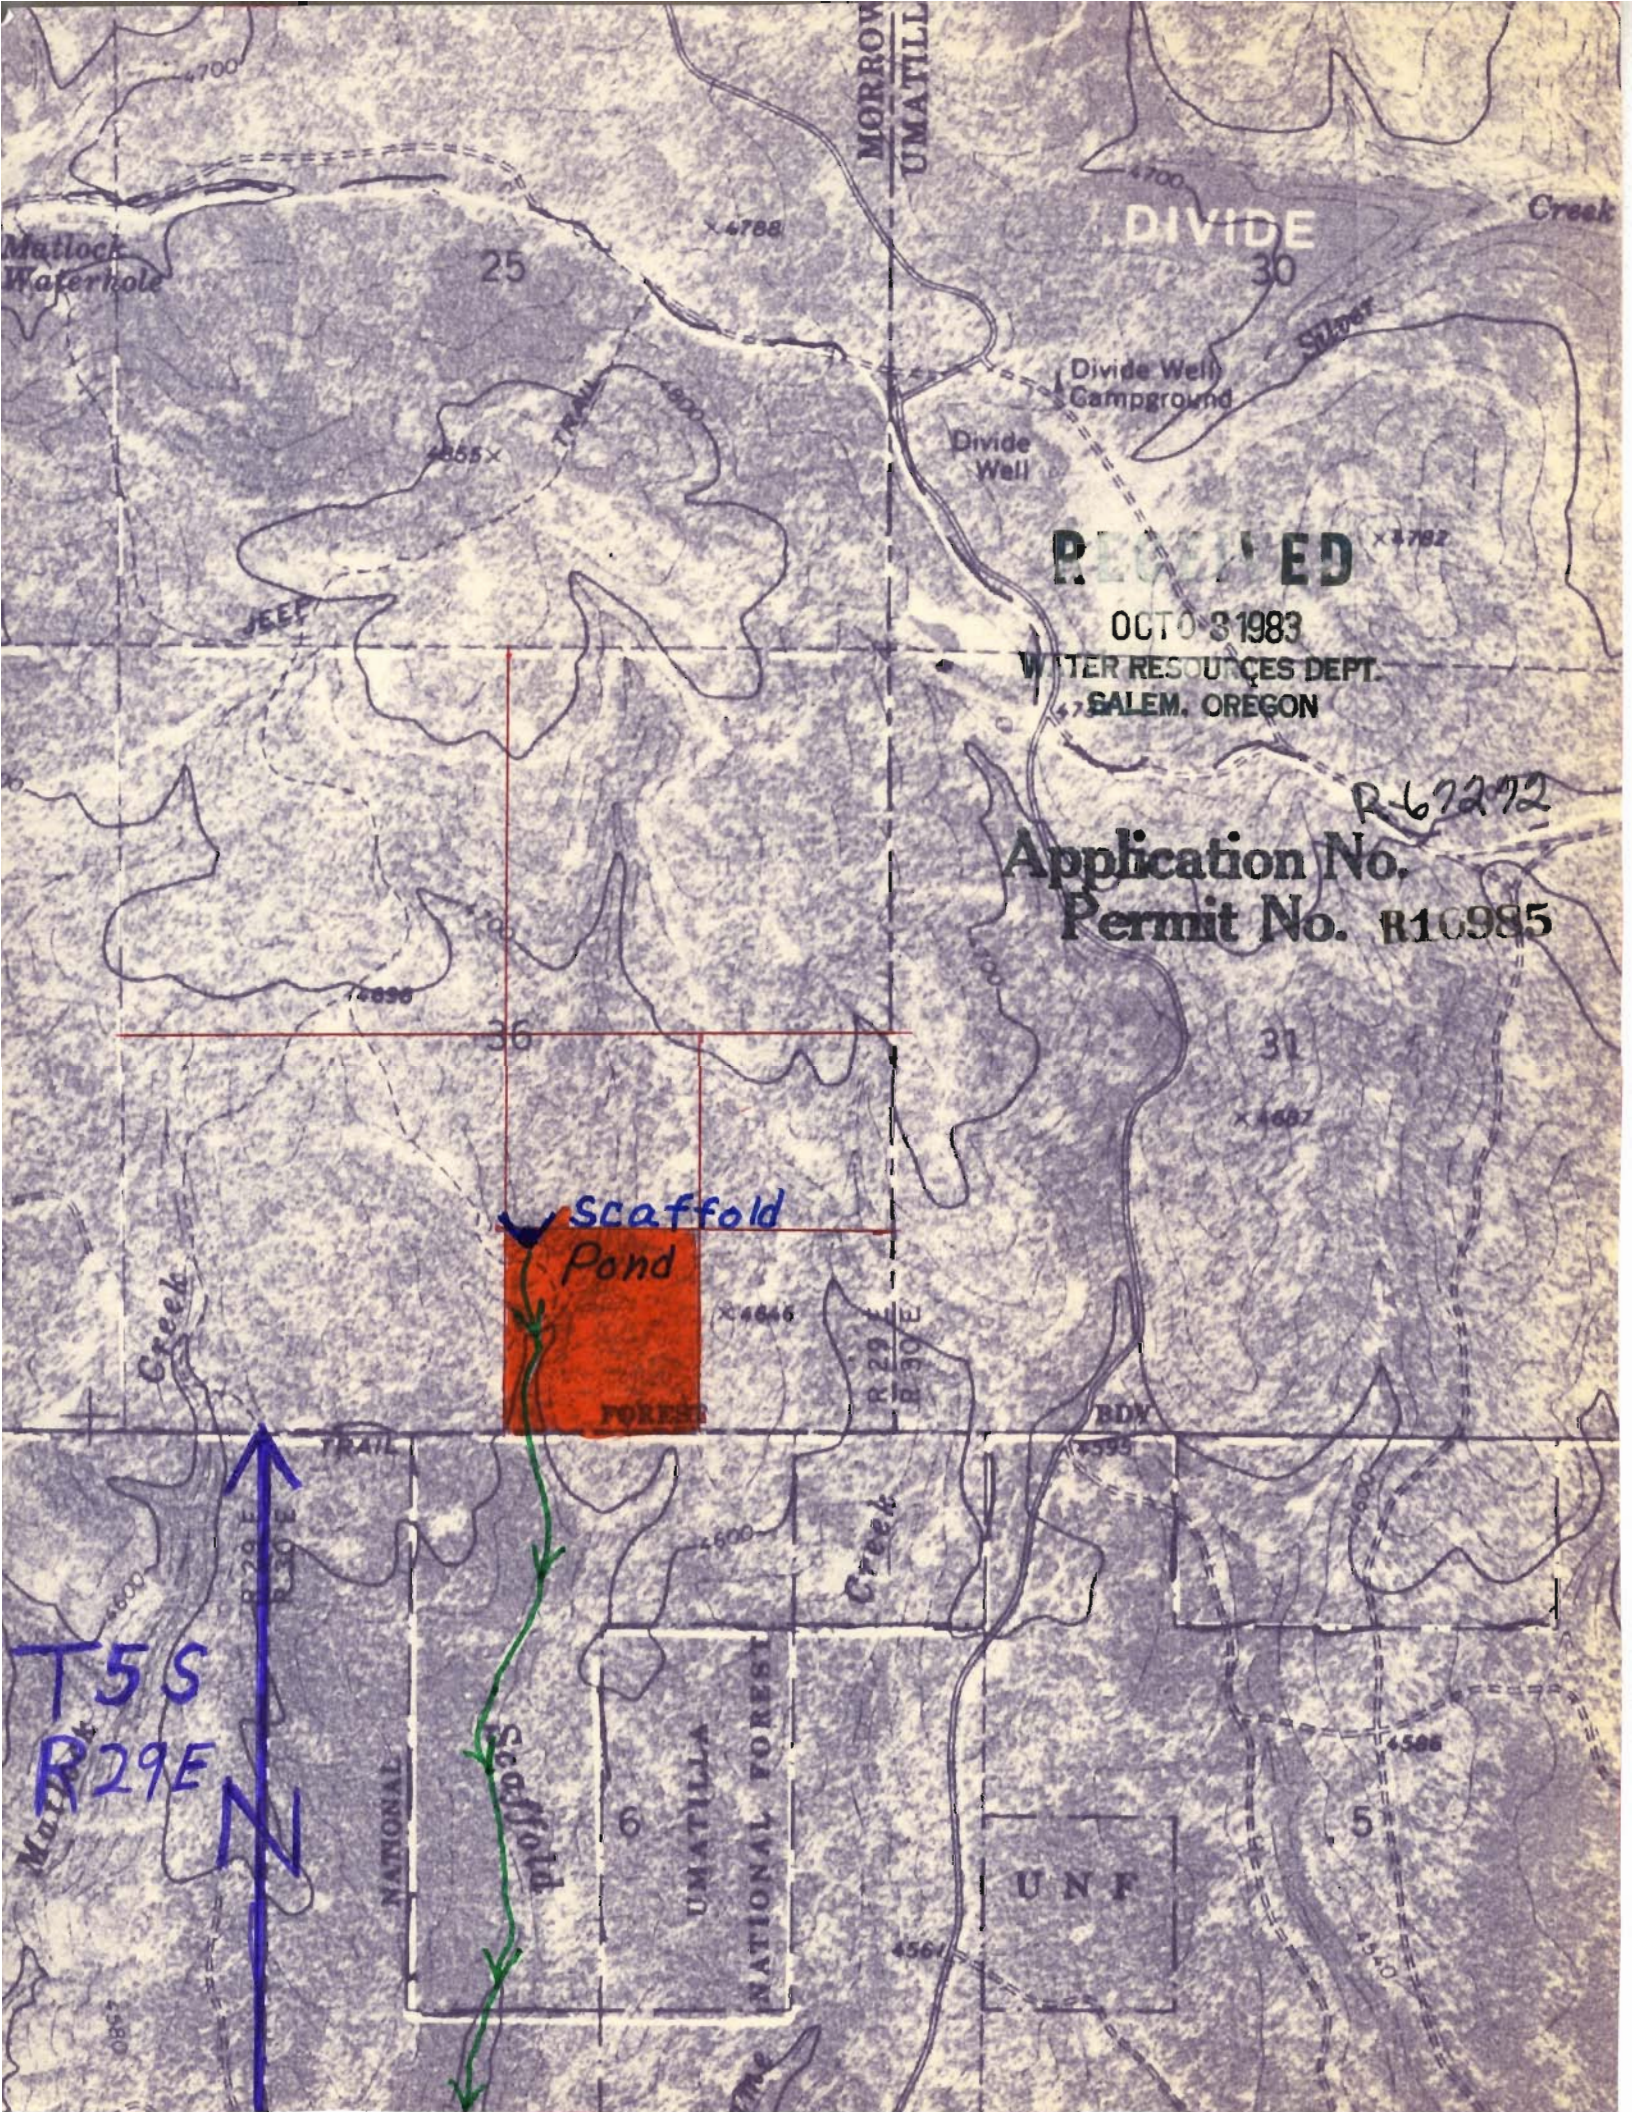

RECEIVED

OCT 3 1983

WATER RESOURCES DEPT.
SALEM, OREGON

R67272

Application No.
Permit No. R10985

Scaffold
Pond

FOREST

T5S
R29E

N

NATIONAL

UMATILLA

NATIONAL FOREST

UNF