


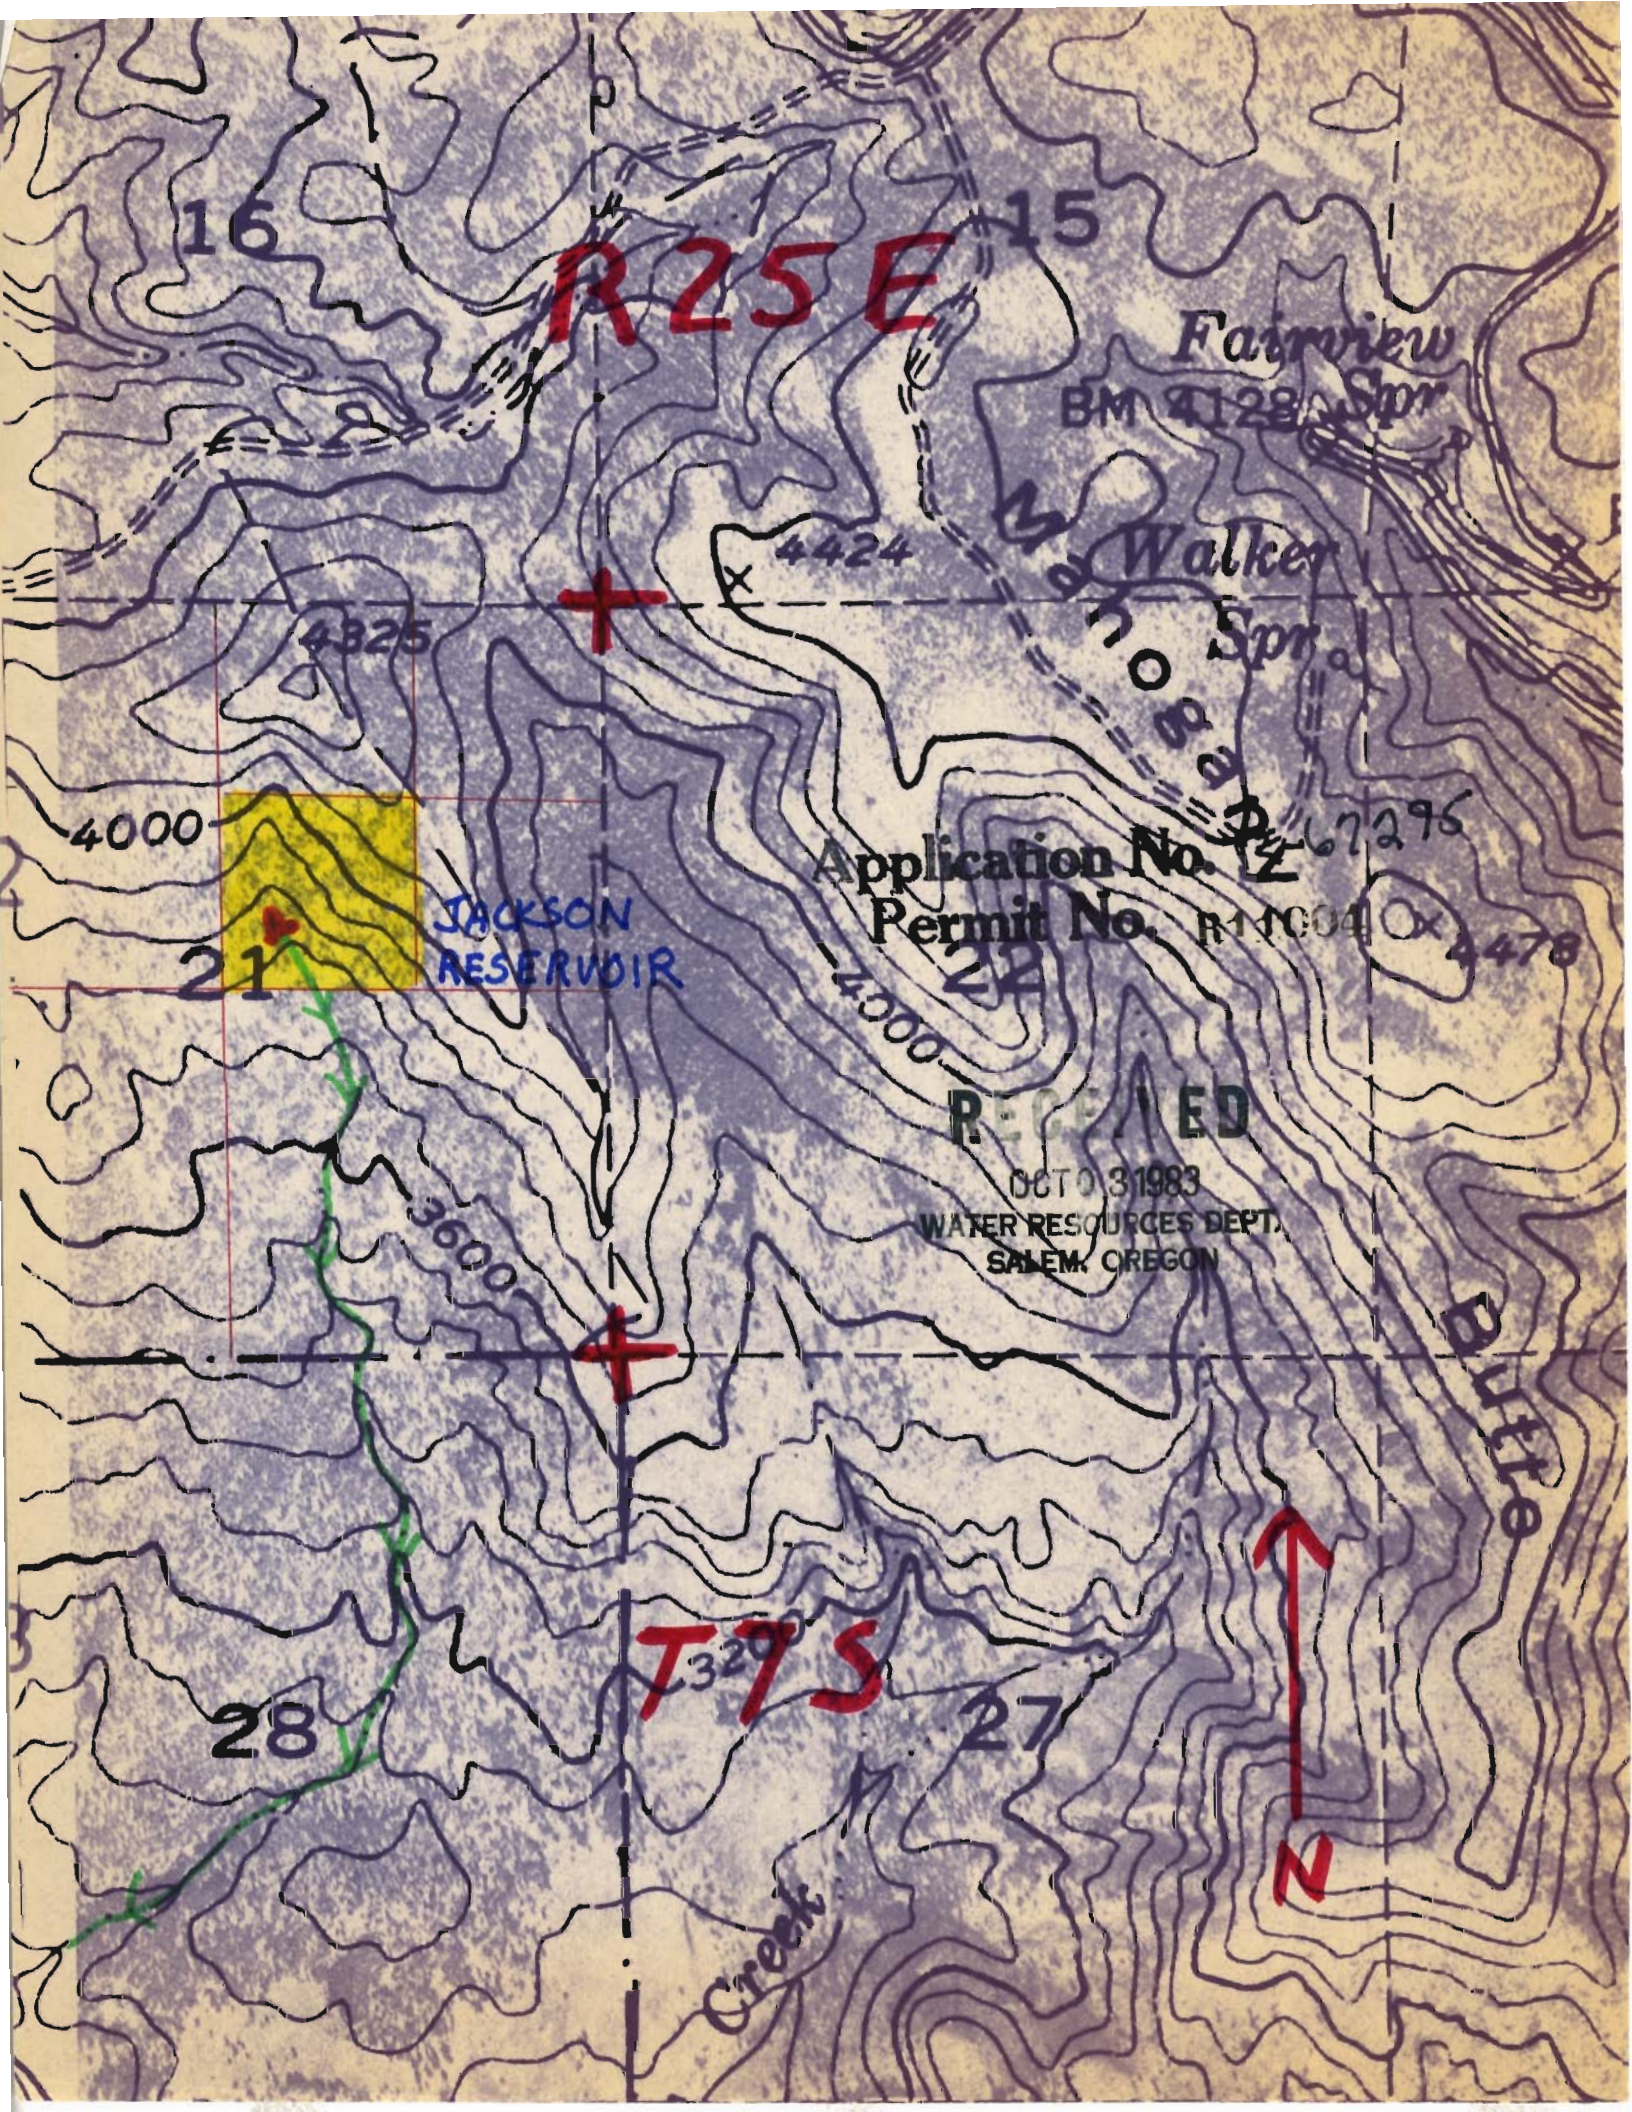

16

R25E

15

Fairview
BM 4128 Spr

Walker
Spr

4325

4424

4000

21

JACKSON
RESERVOIR

Application No. 67296

Permit No. R11004

Ox 4478


OCT 03 1983

WATER RESOURCES DEPT.
SALEM, OREGON

3600

Butte

28

T7S

27

Creek

N