


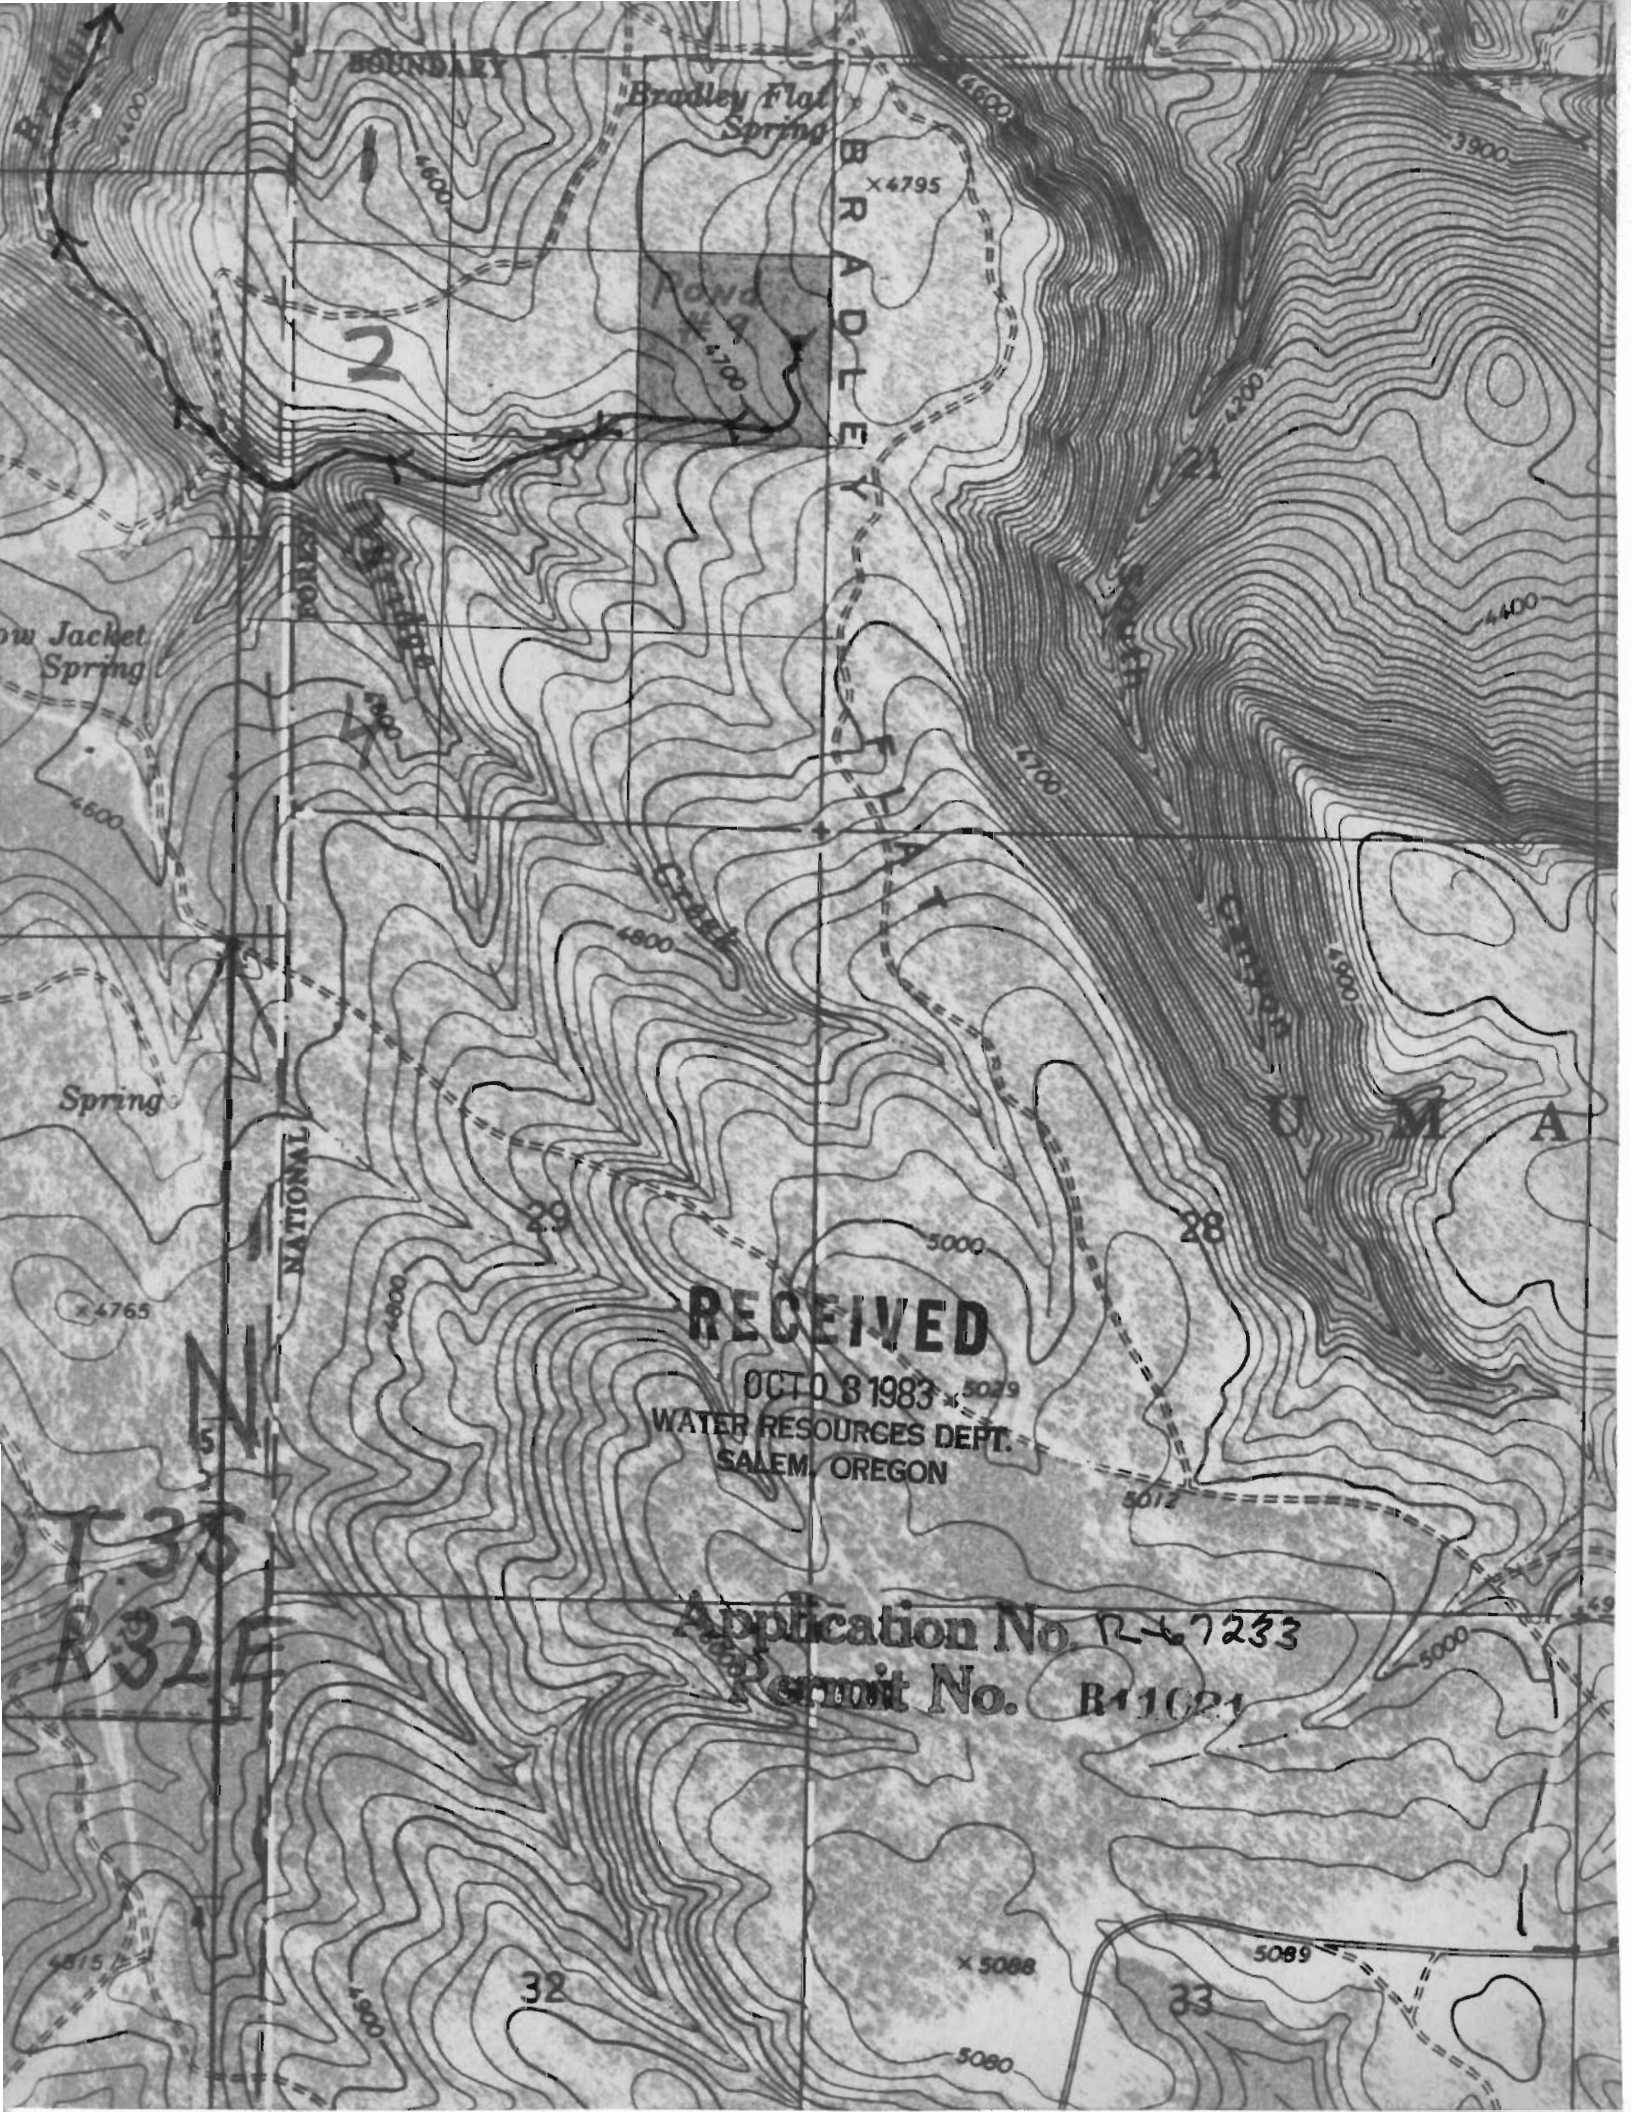

BOUNDARY

Bradley Flat Spring

x4795

BRADLEY

Pond

x4700

Low Jacket Spring

Spring

NATIONAL FOREST

RECEIVED

OCT 8 1983

WATER RESOURCES DEPT.
SALEM, OREGON

N

T-38
R-32E


Permit No. R-11021


32

x5088

5089

33

5080

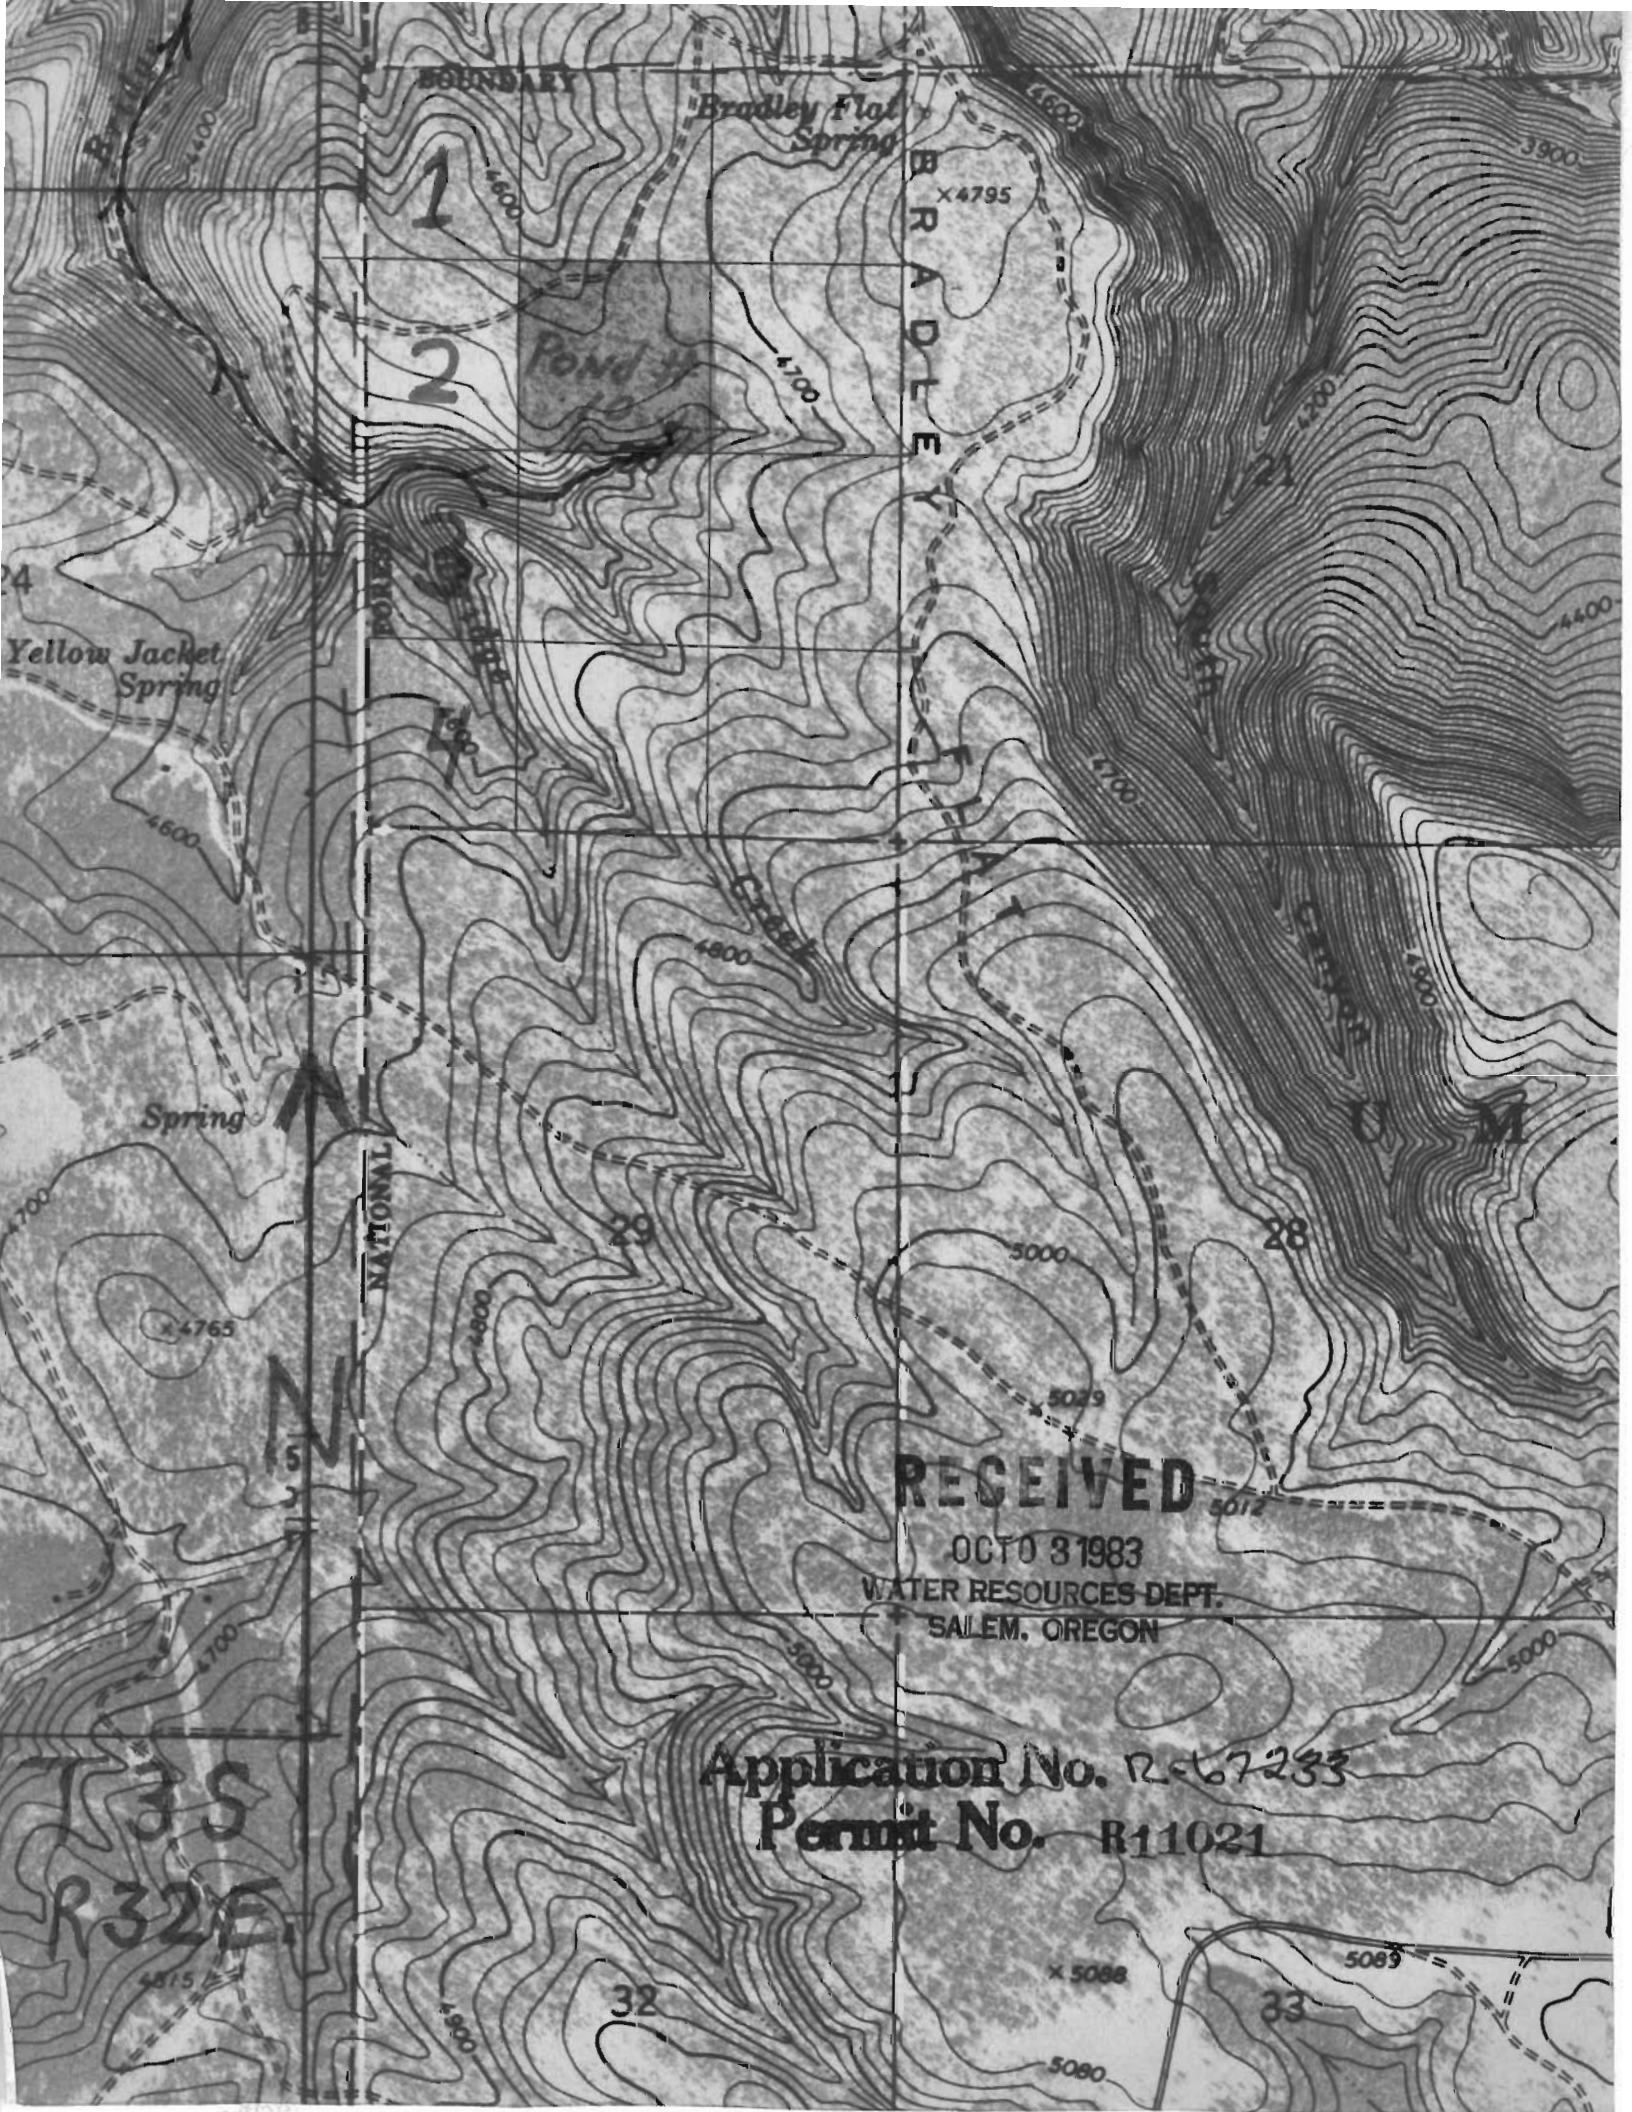

RECEIVED

OCT 3 1983

WATER RESOURCES DEPT.

SALEM, OREGON

Application No. R-67233

Permit No. R11021