


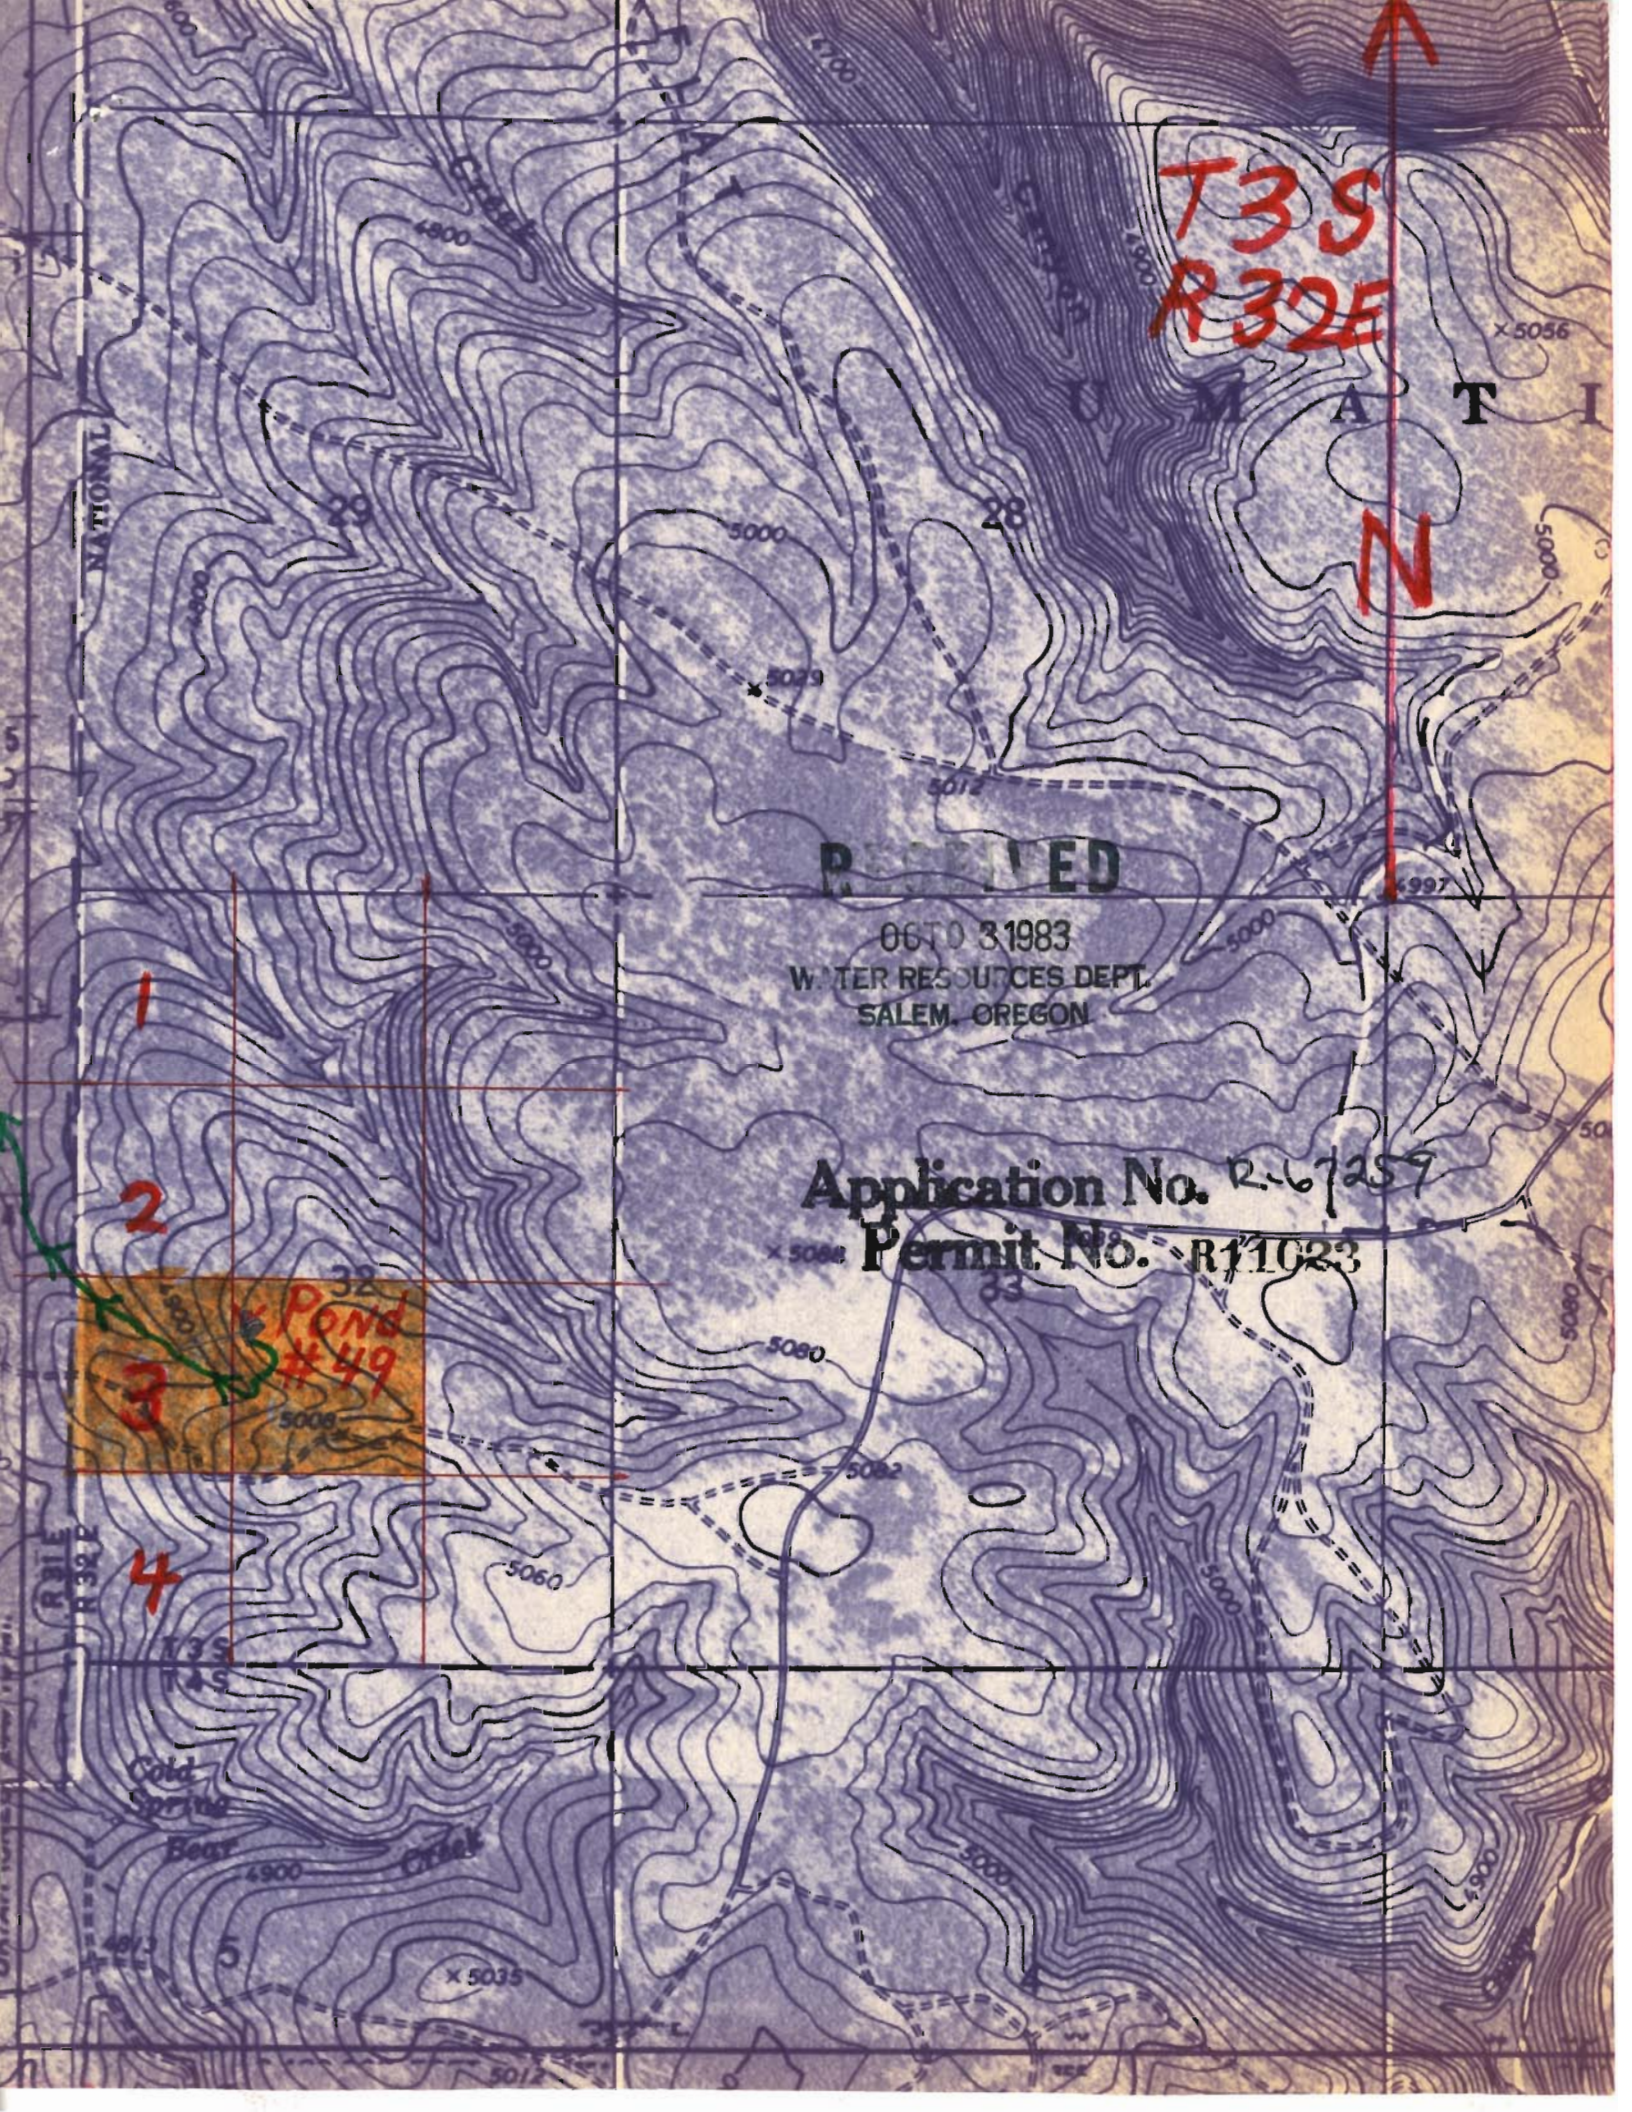

T3S
R32E

N

RECEIVED

OCT 03 1983
WATER RESOURCES DEPT.
SALEM, OREGON

Application No. R-67259

Permit No. R11023

Pond
#49

2

3

4

1

5

6

