


Application No. R-67231
Permit No. R11111

RECEIVED

OCTO 31 1983
WATER RESOURCES DEPT.
SALEM, OREGON

3 S N
R32 E

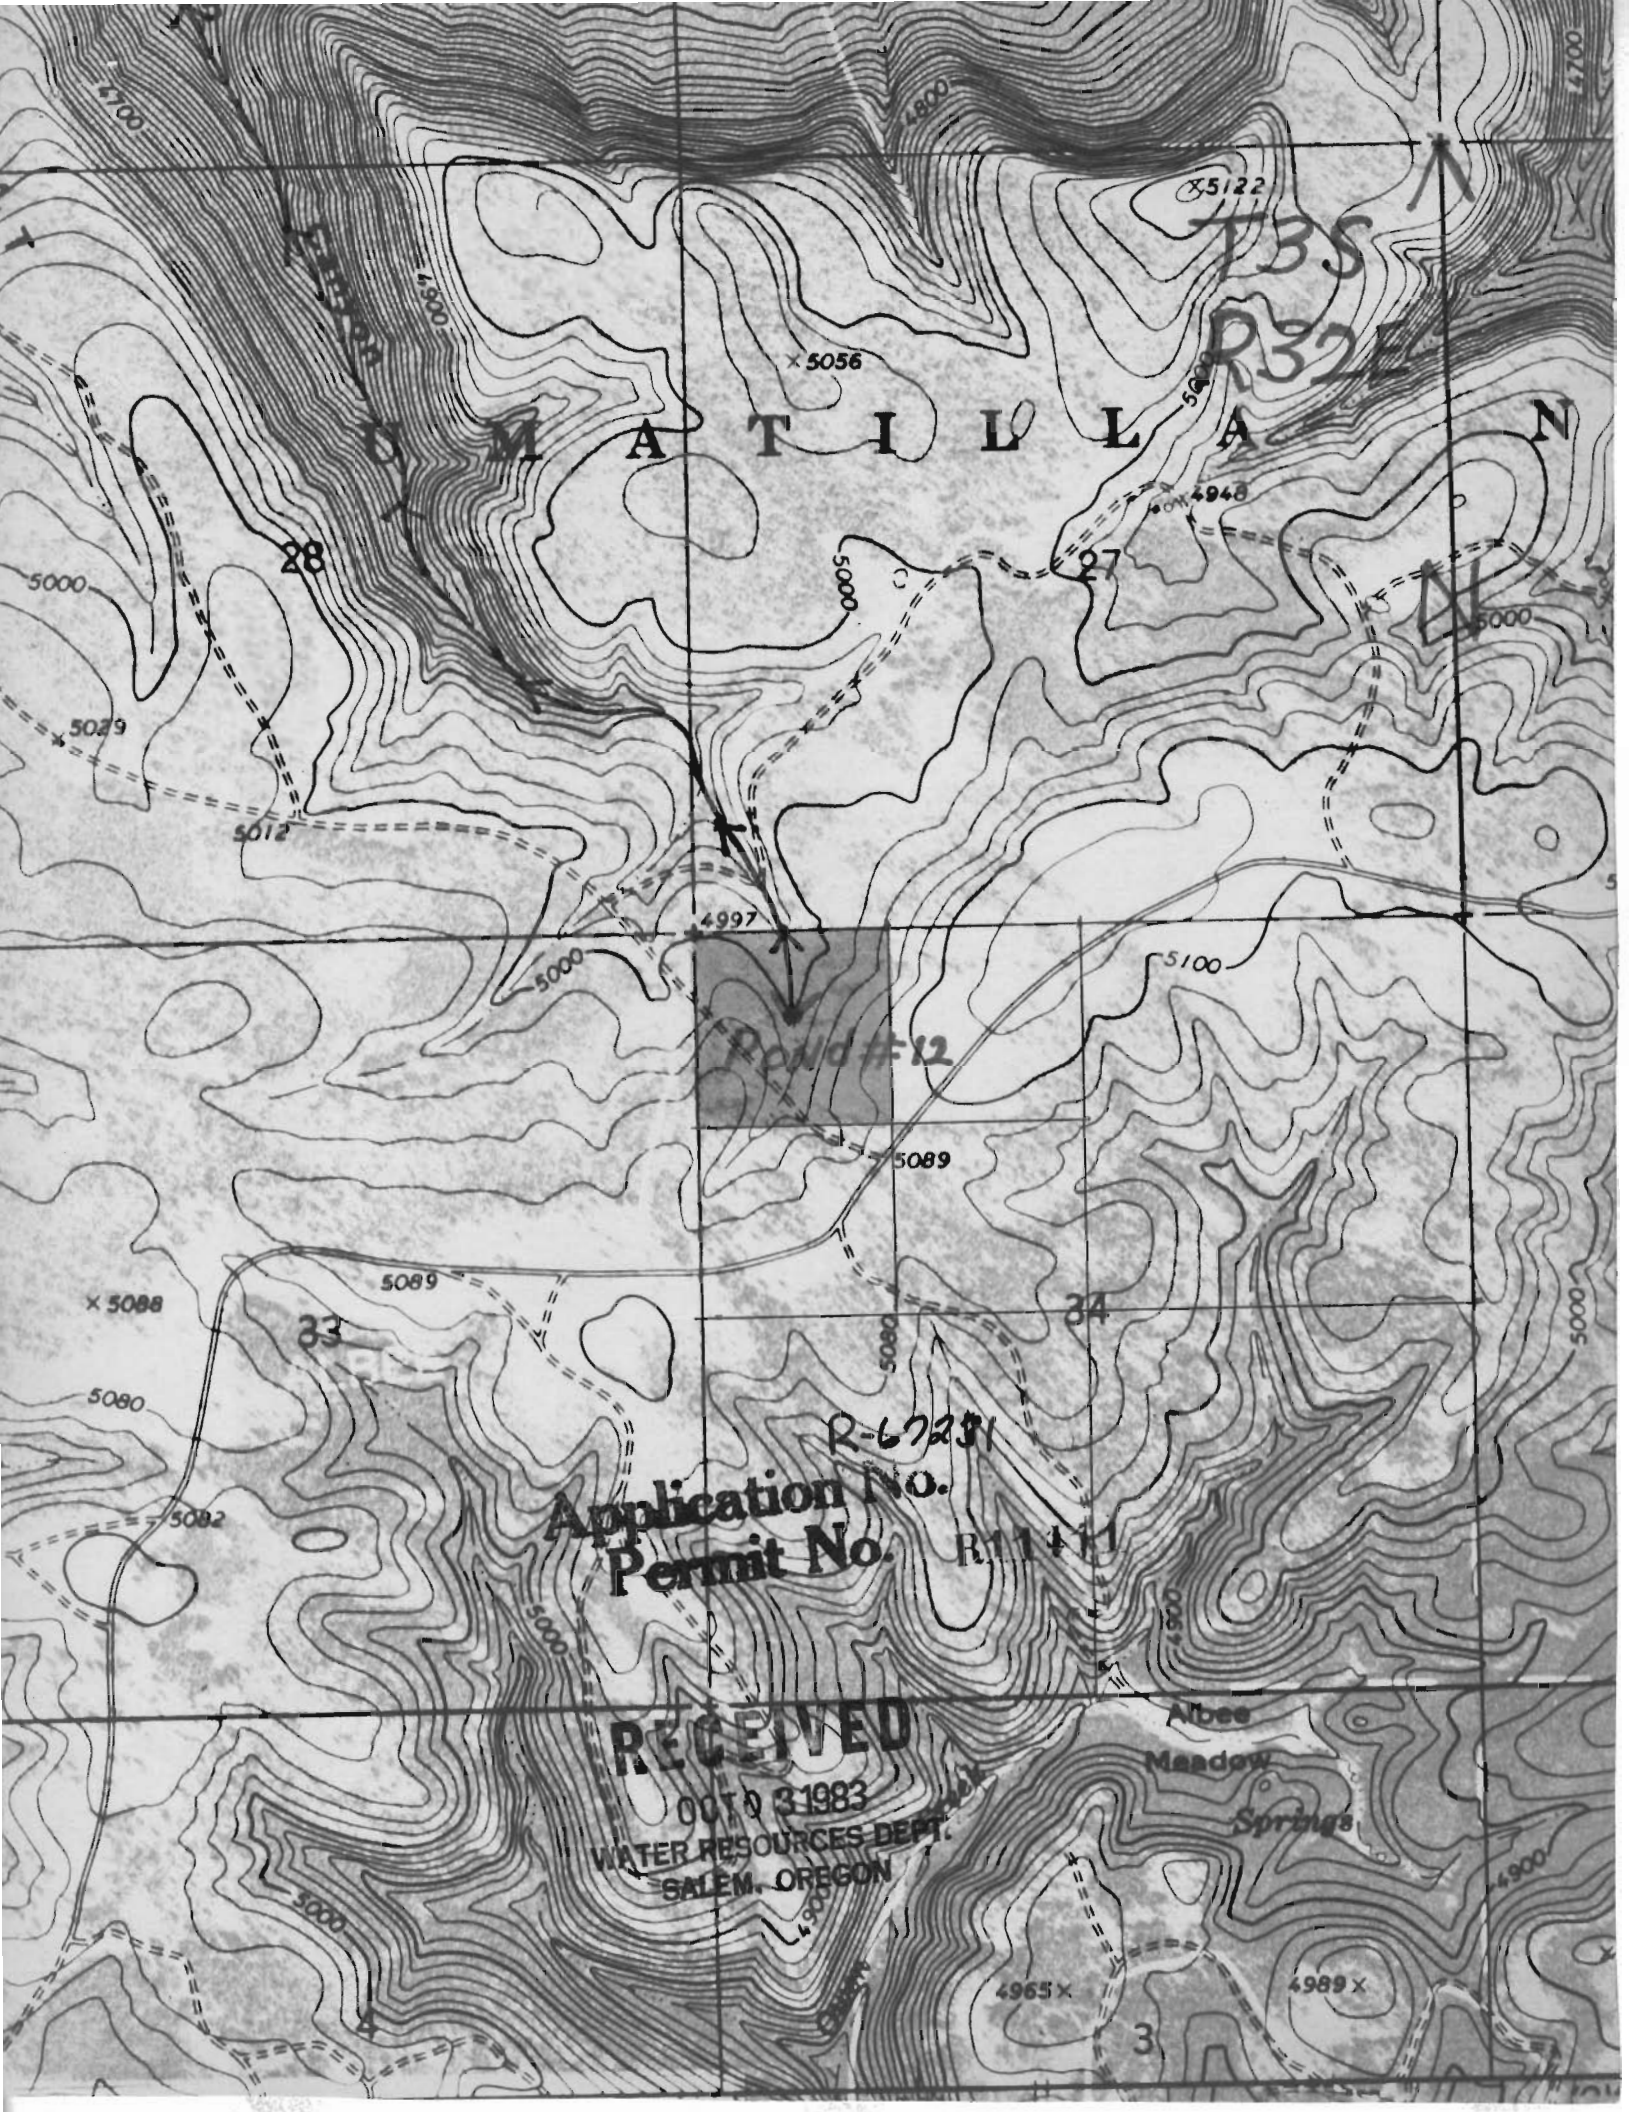

T3S
R32E

Pond #12

R-67231
Application No.
Permit No. R11411

RECEIVED

0070 31983
WATER RESOURCES DEPT.
SALEM, OREGON

Albee
Meadow
Springs