

T-8343

RECEIVED

SEP 21 1999

WATER RESOURCES DEPT.  
SALEM, OREGON

T13S, R34E, W.M.

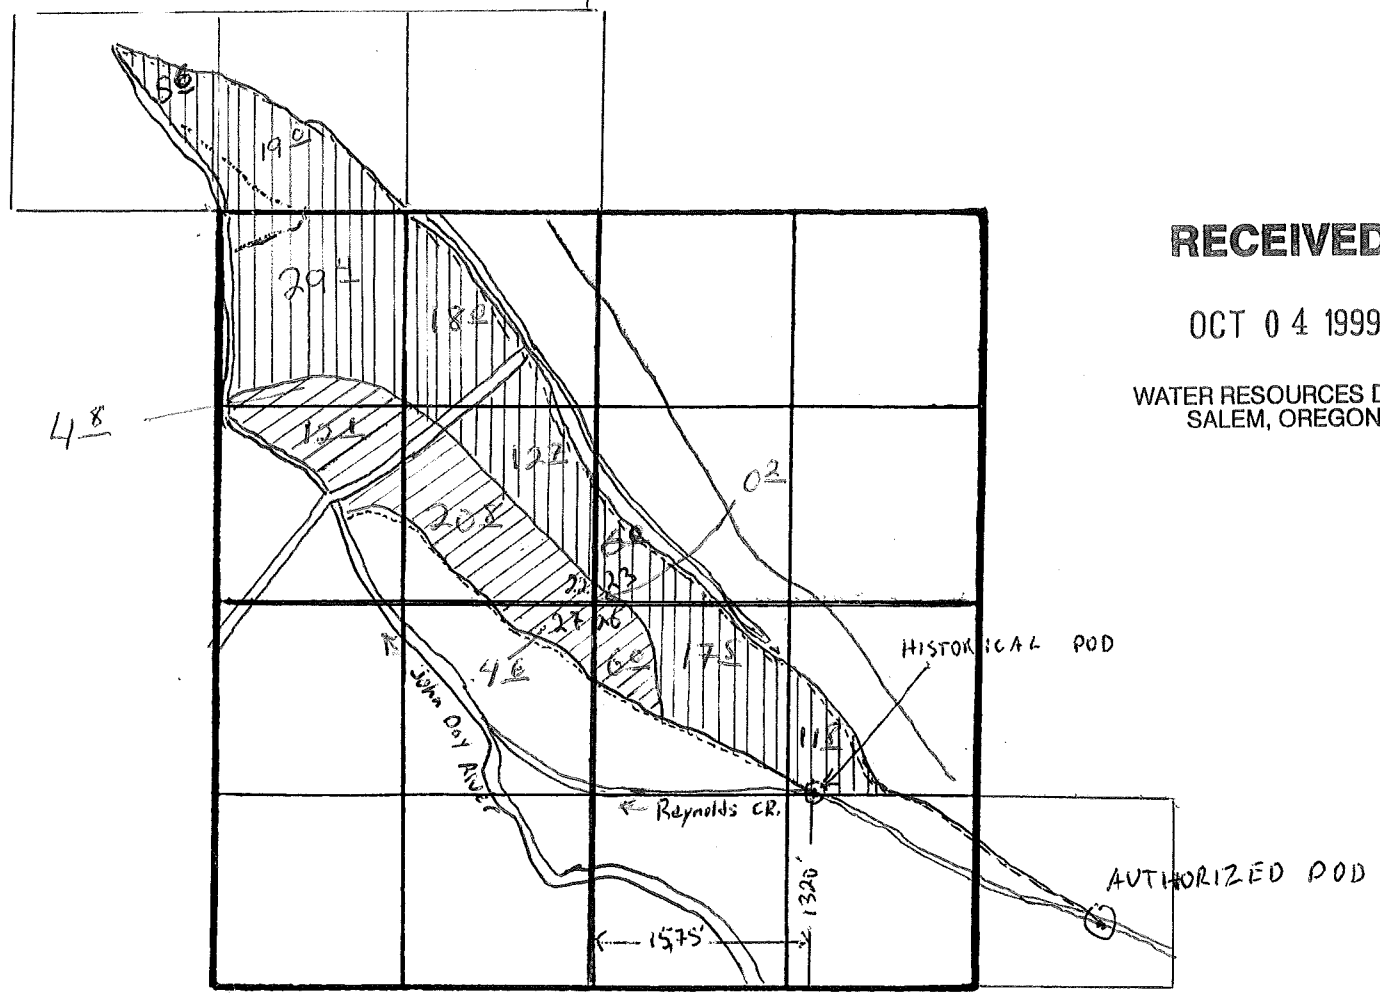
1" = 1320'





RECEIVED

OCT 04 1999

WATER RESOURCES DEPT.  
SALEM, OREGON



-  - HISTORICAL POD
-  - REMAINING RIGHT  
(C# 51854)

APPLICATION MAP FOR  
HISTORICAL POINT OF DIVERSION  
TRANSFER

FUR  
MARK LAWRENCE