


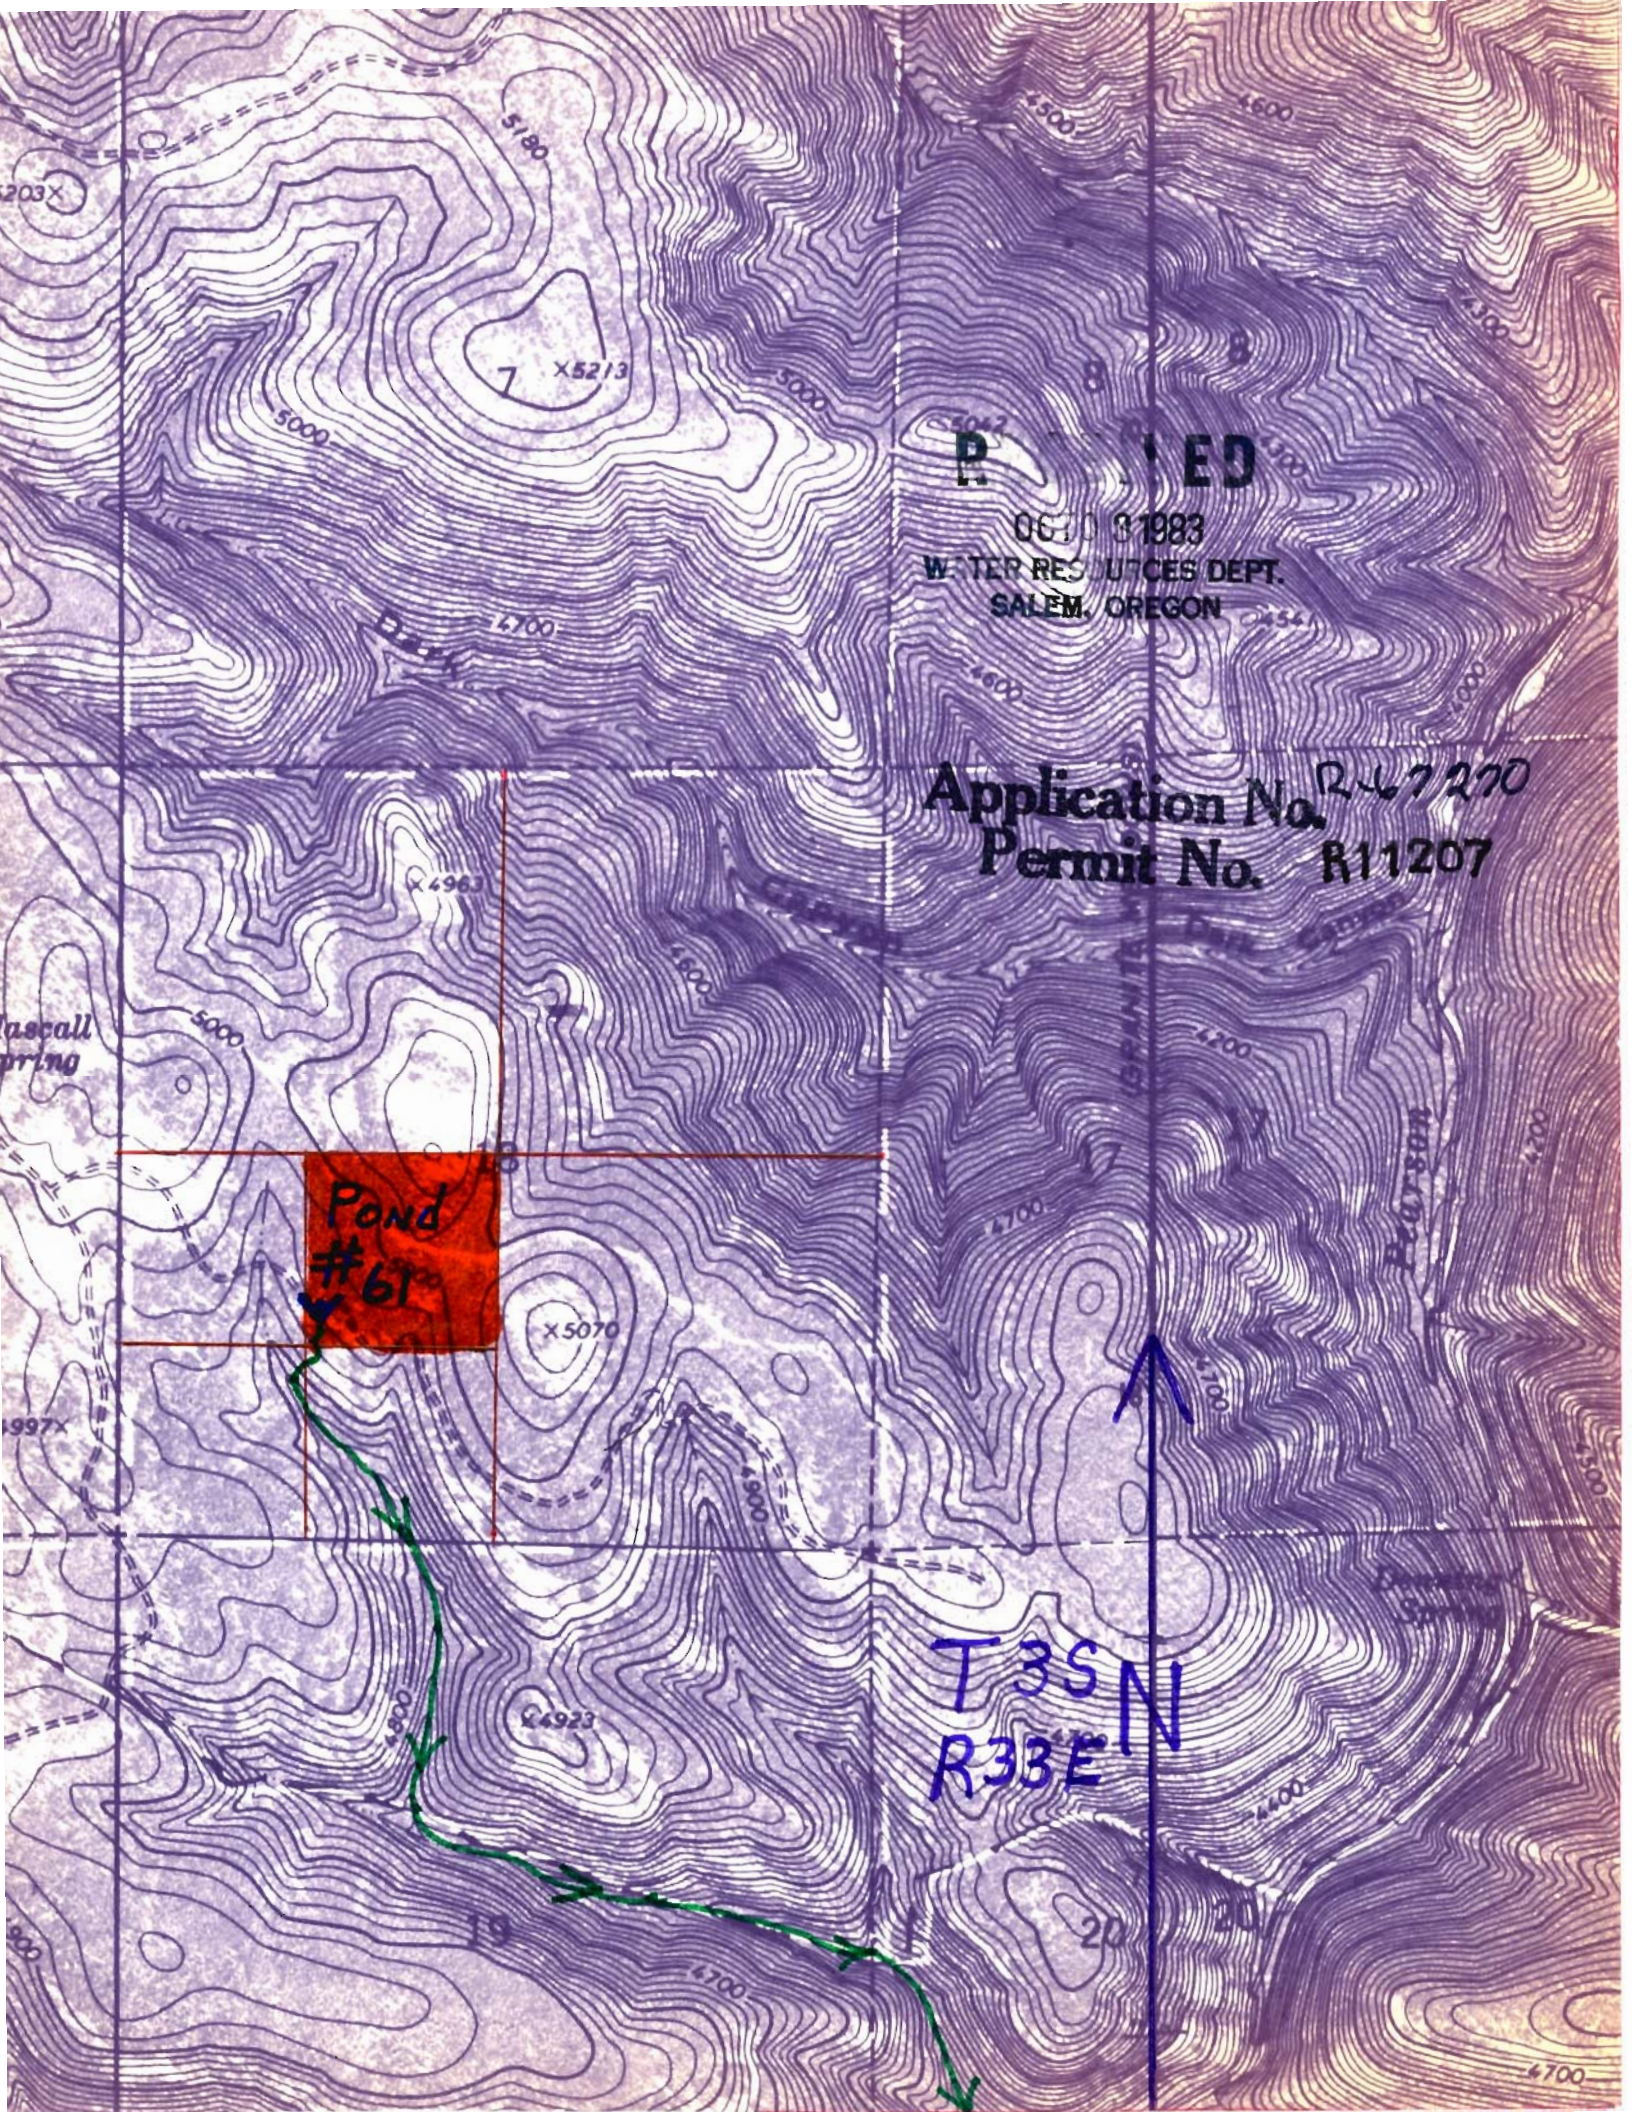

RECEIVED

0670 31983

WATER RESOURCES DEPT.
SALEM, OREGON

Application No. R-47270
Permit No. R11207

Pond
#61

T3S N
R33E