


Application No. RS7125
Permit No. R11267

Trout Pond

T8S
R31E

RECEIVED

OCT 5 1983
WATER RESOURCES DEPT.
SALEM, OREGON

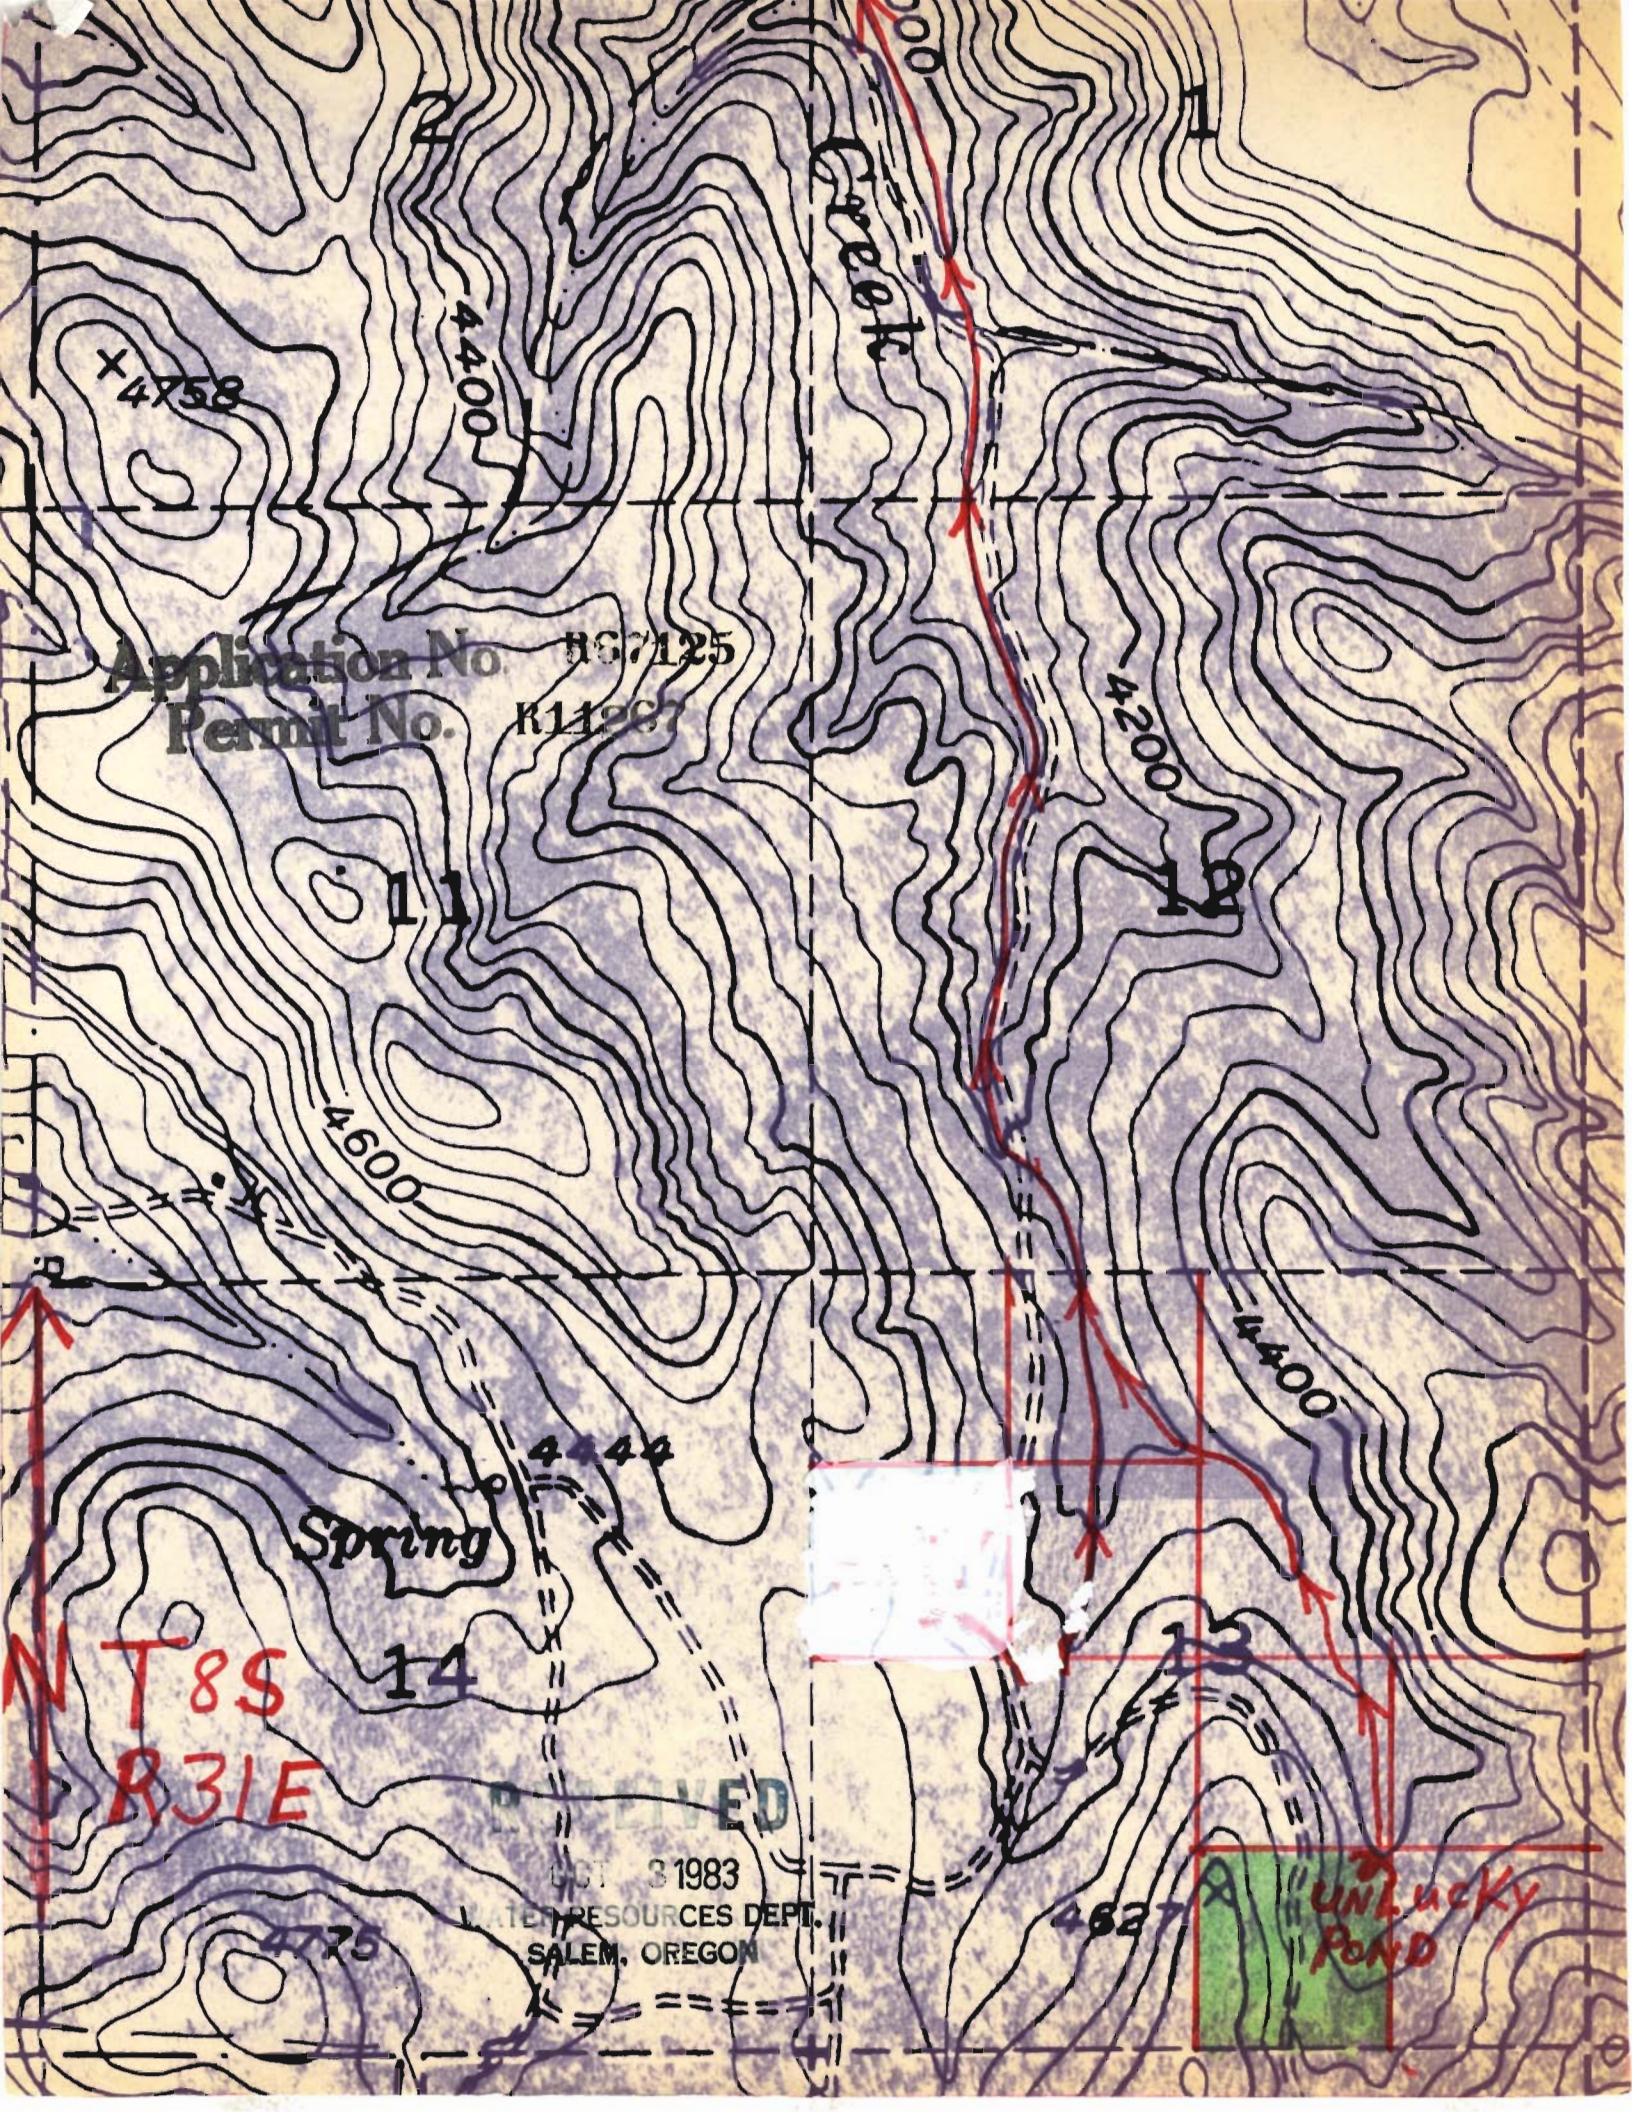

X 4758

Application No. B67125
Permit No. R11297


Spring

N T 8 S
R 31 E

RECEIVED

WATER RESOURCES DEPT.
SALEM, OREGON

UNLUCKY
POND

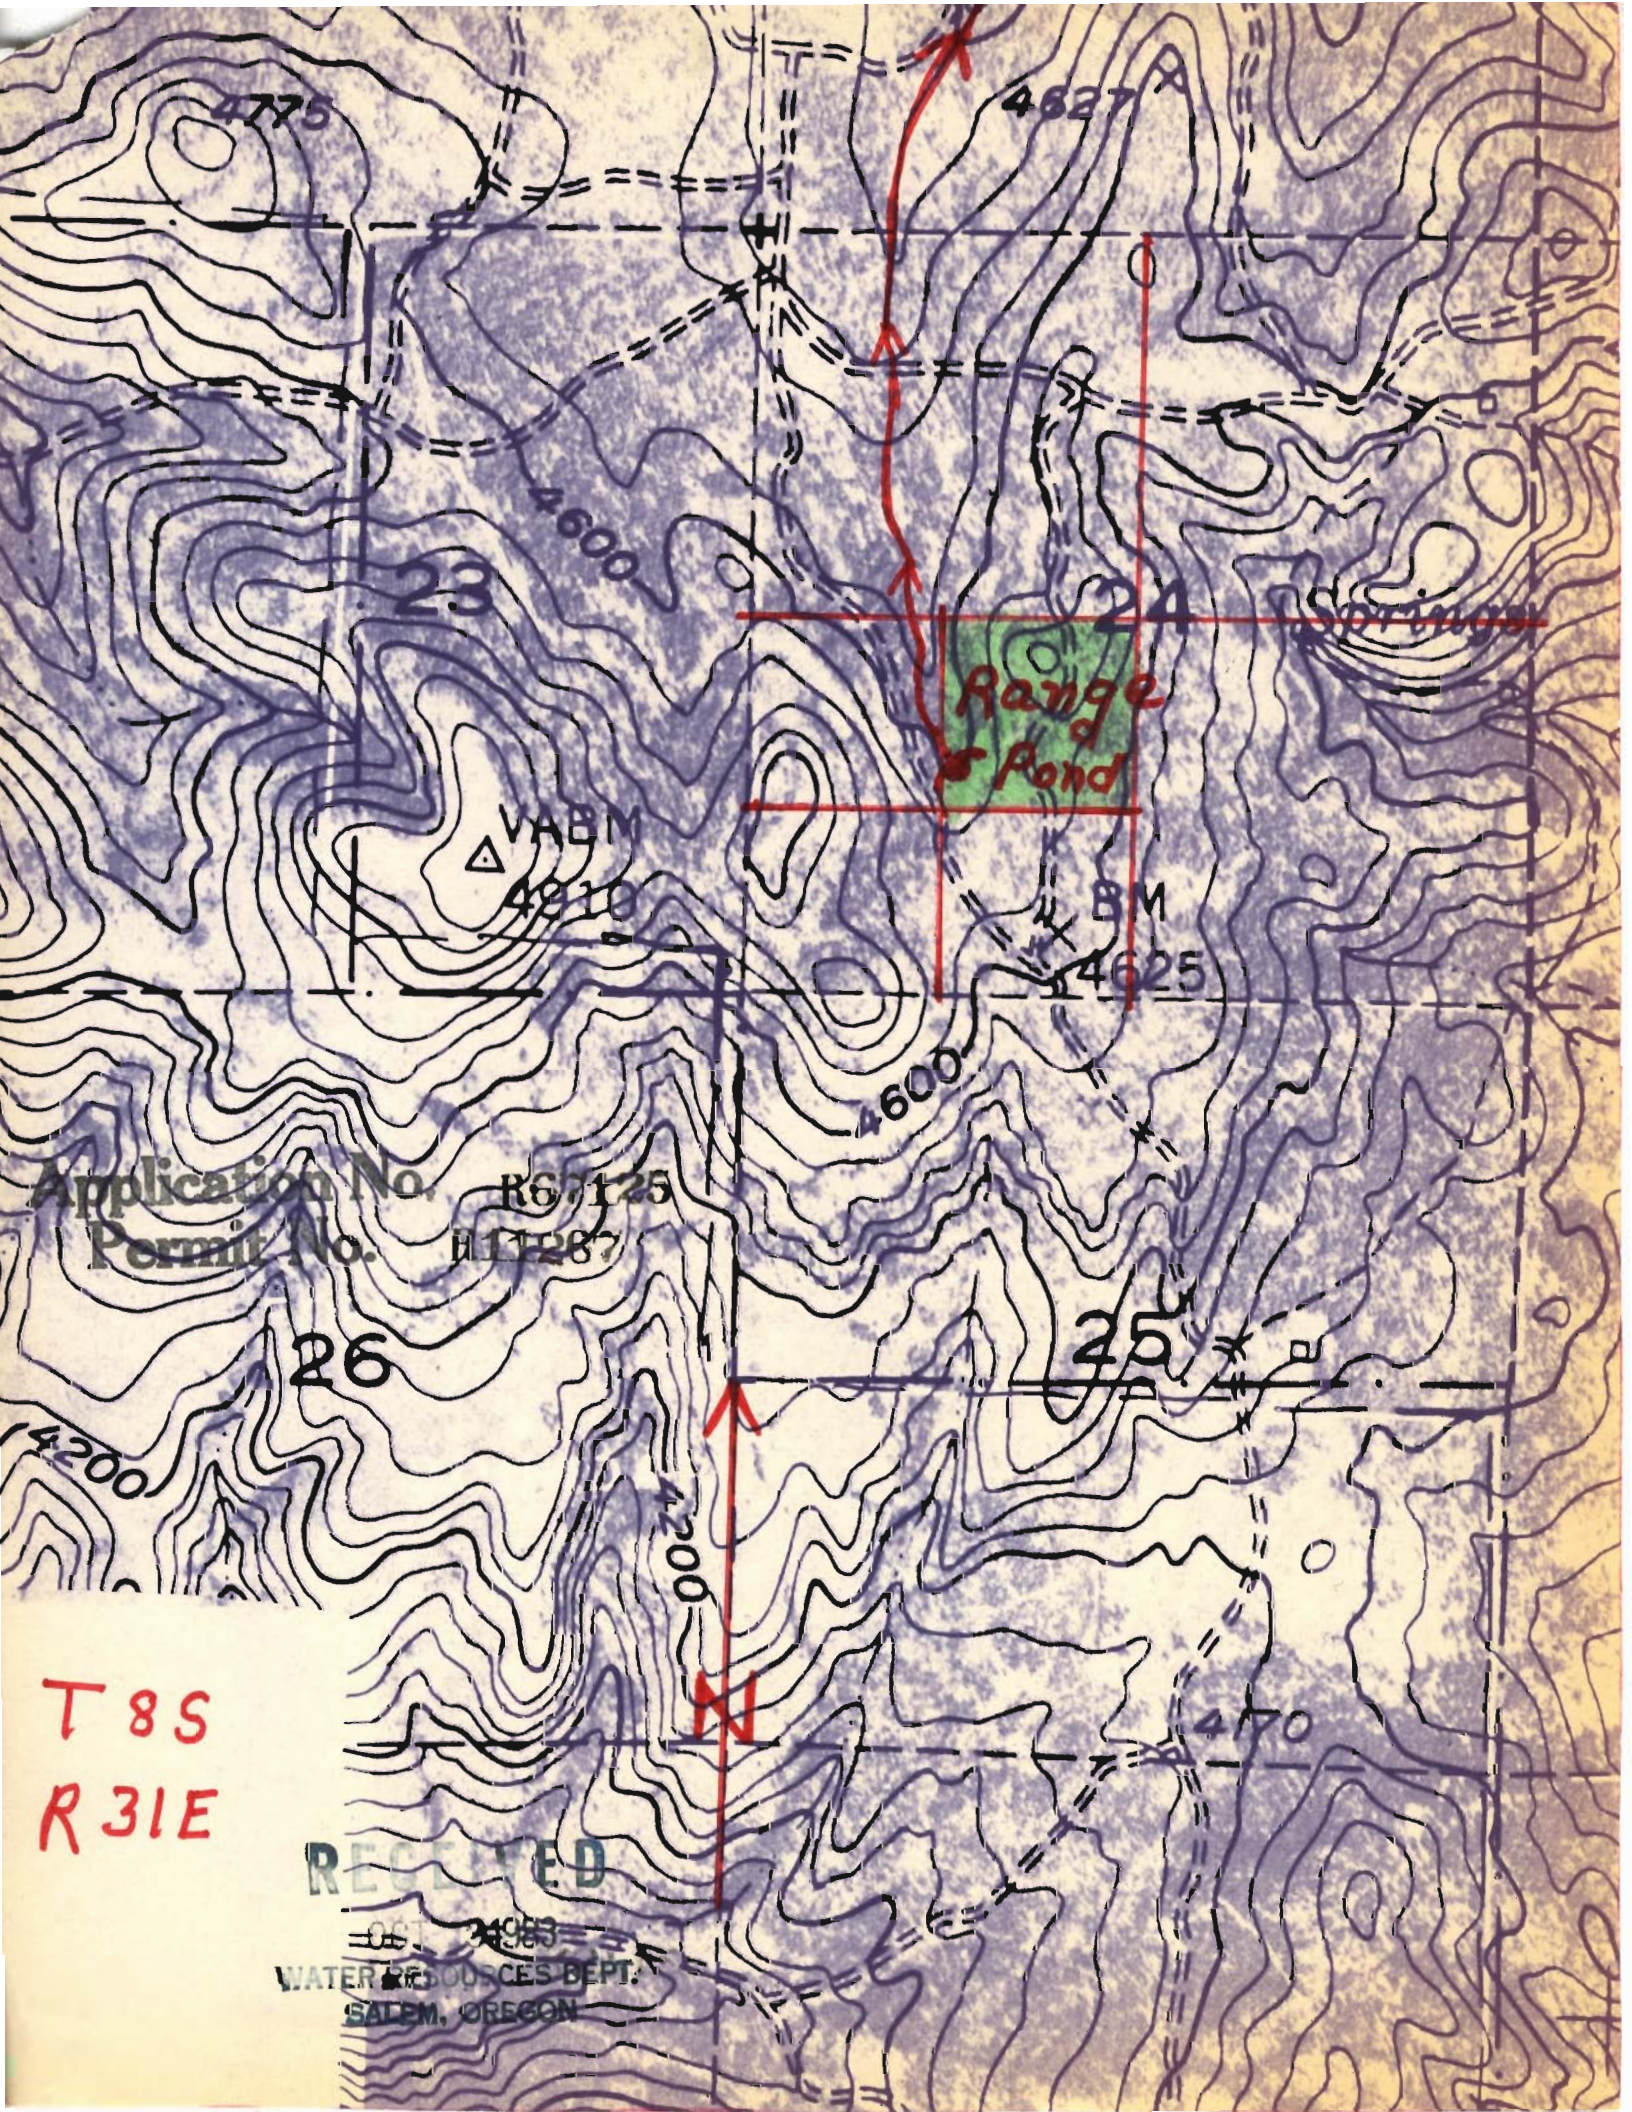

Application No. R67125
Permit No. H11287

T 8 S
R 31 E

RECEIVED
WATER RESOURCES DEPT.
SALEM, OREGON