


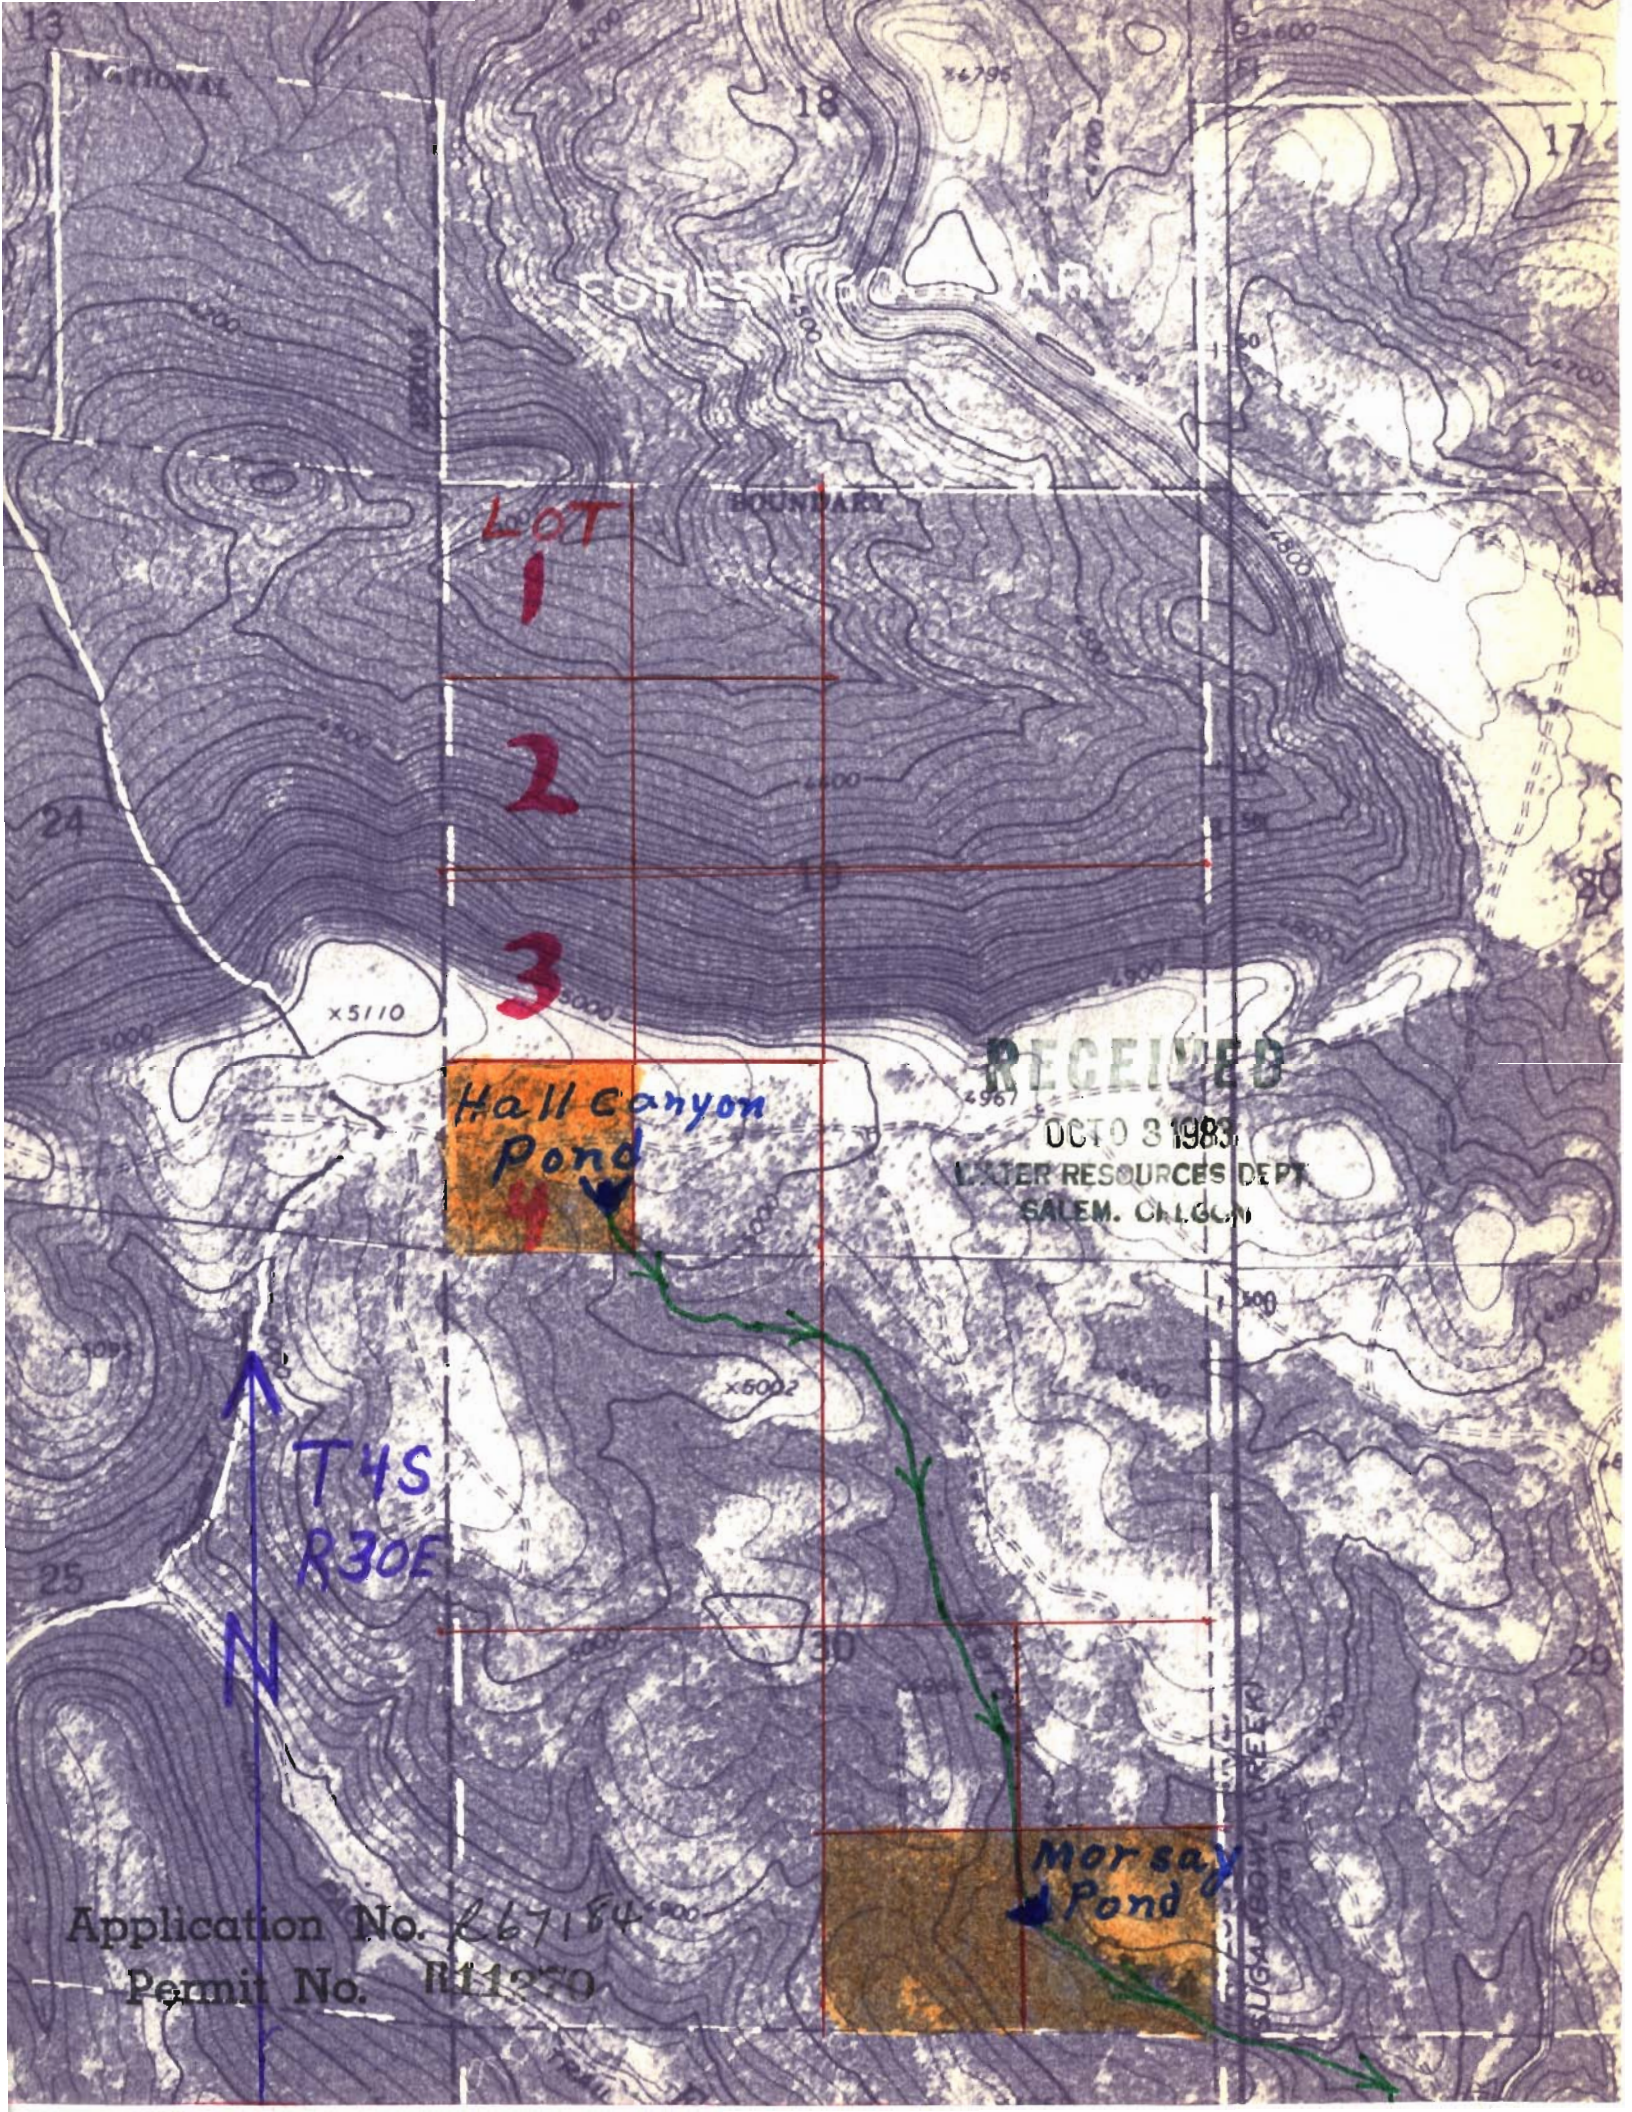

LOT
1

2

3

Hall Canyon
Pond

RECEIVED

OCT 3 1983

WATER RESOURCES DEPT
SALEM, OREGON

N

T4S
R30E

Application No. R67184

Permit No. R11270

Morsay
Pond