


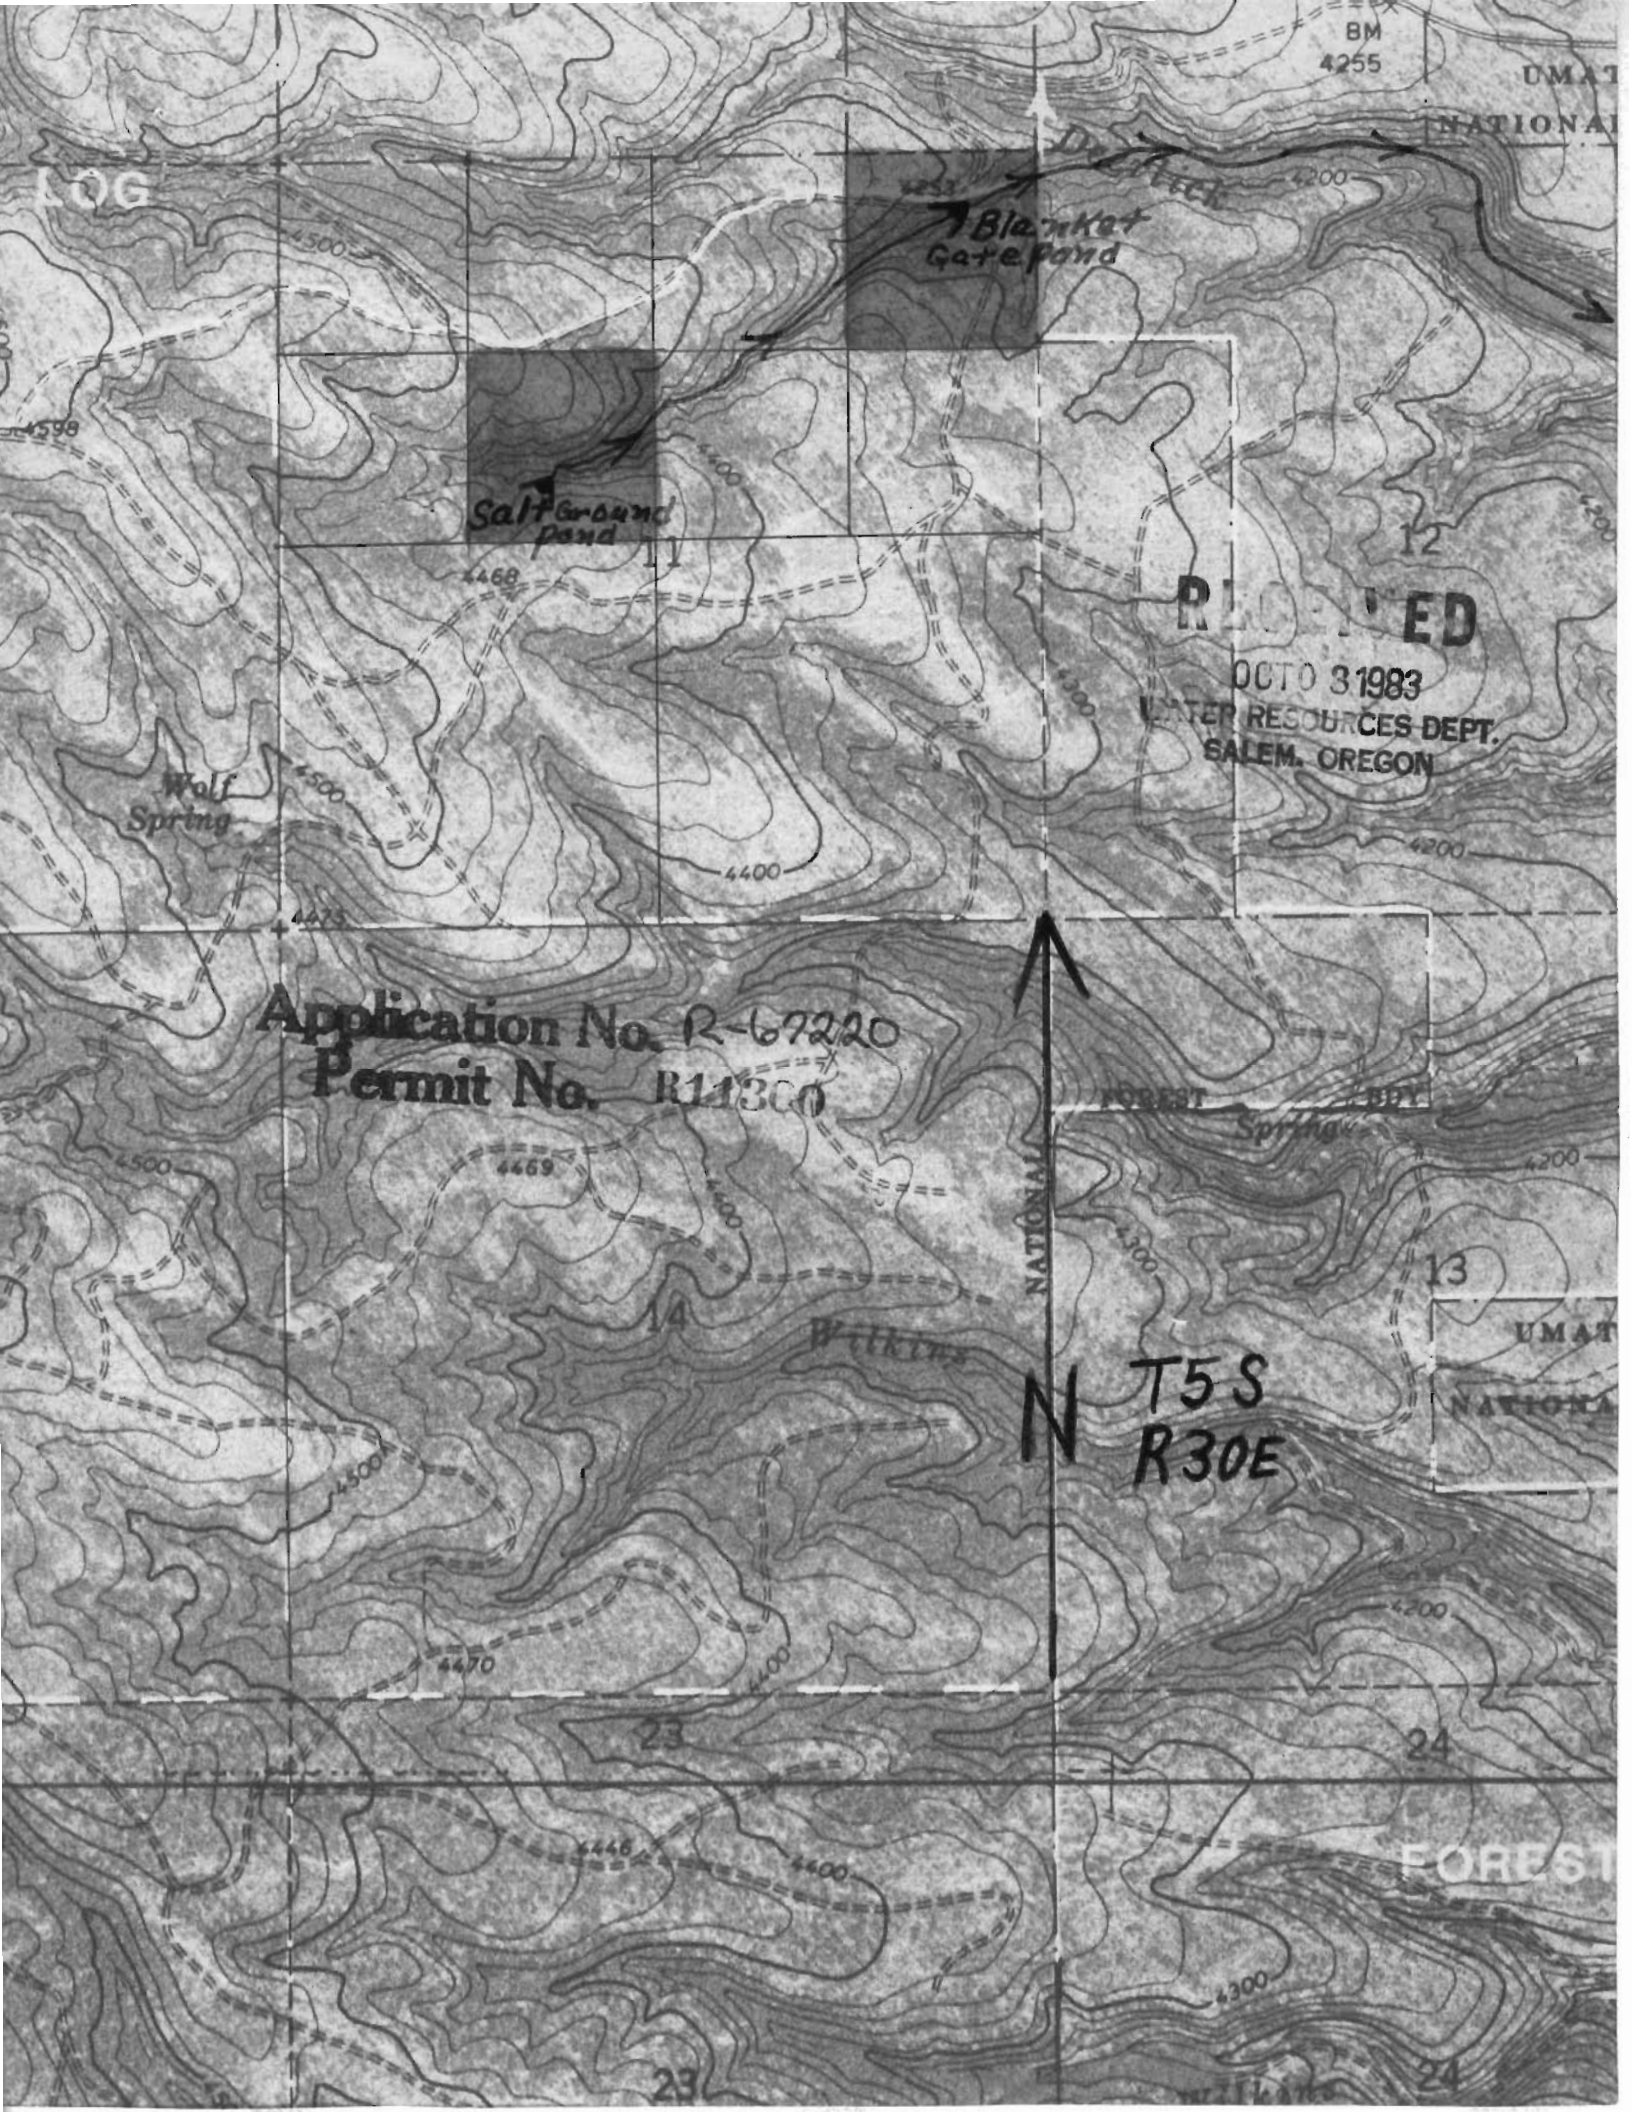

LOG

BM
4255

UMAT
NATIONAL

Blanket
Gate Pond

Salt Ground
Pond

RECEIVED

OCTO 31 1983

WATER RESOURCES DEPT.
SALEM, OREGON

Wolf
Spring

Application No. R-67220
Permit No. R11300

N

T5S
R30E

FOREST

Spring

Wilkins

FOREST