


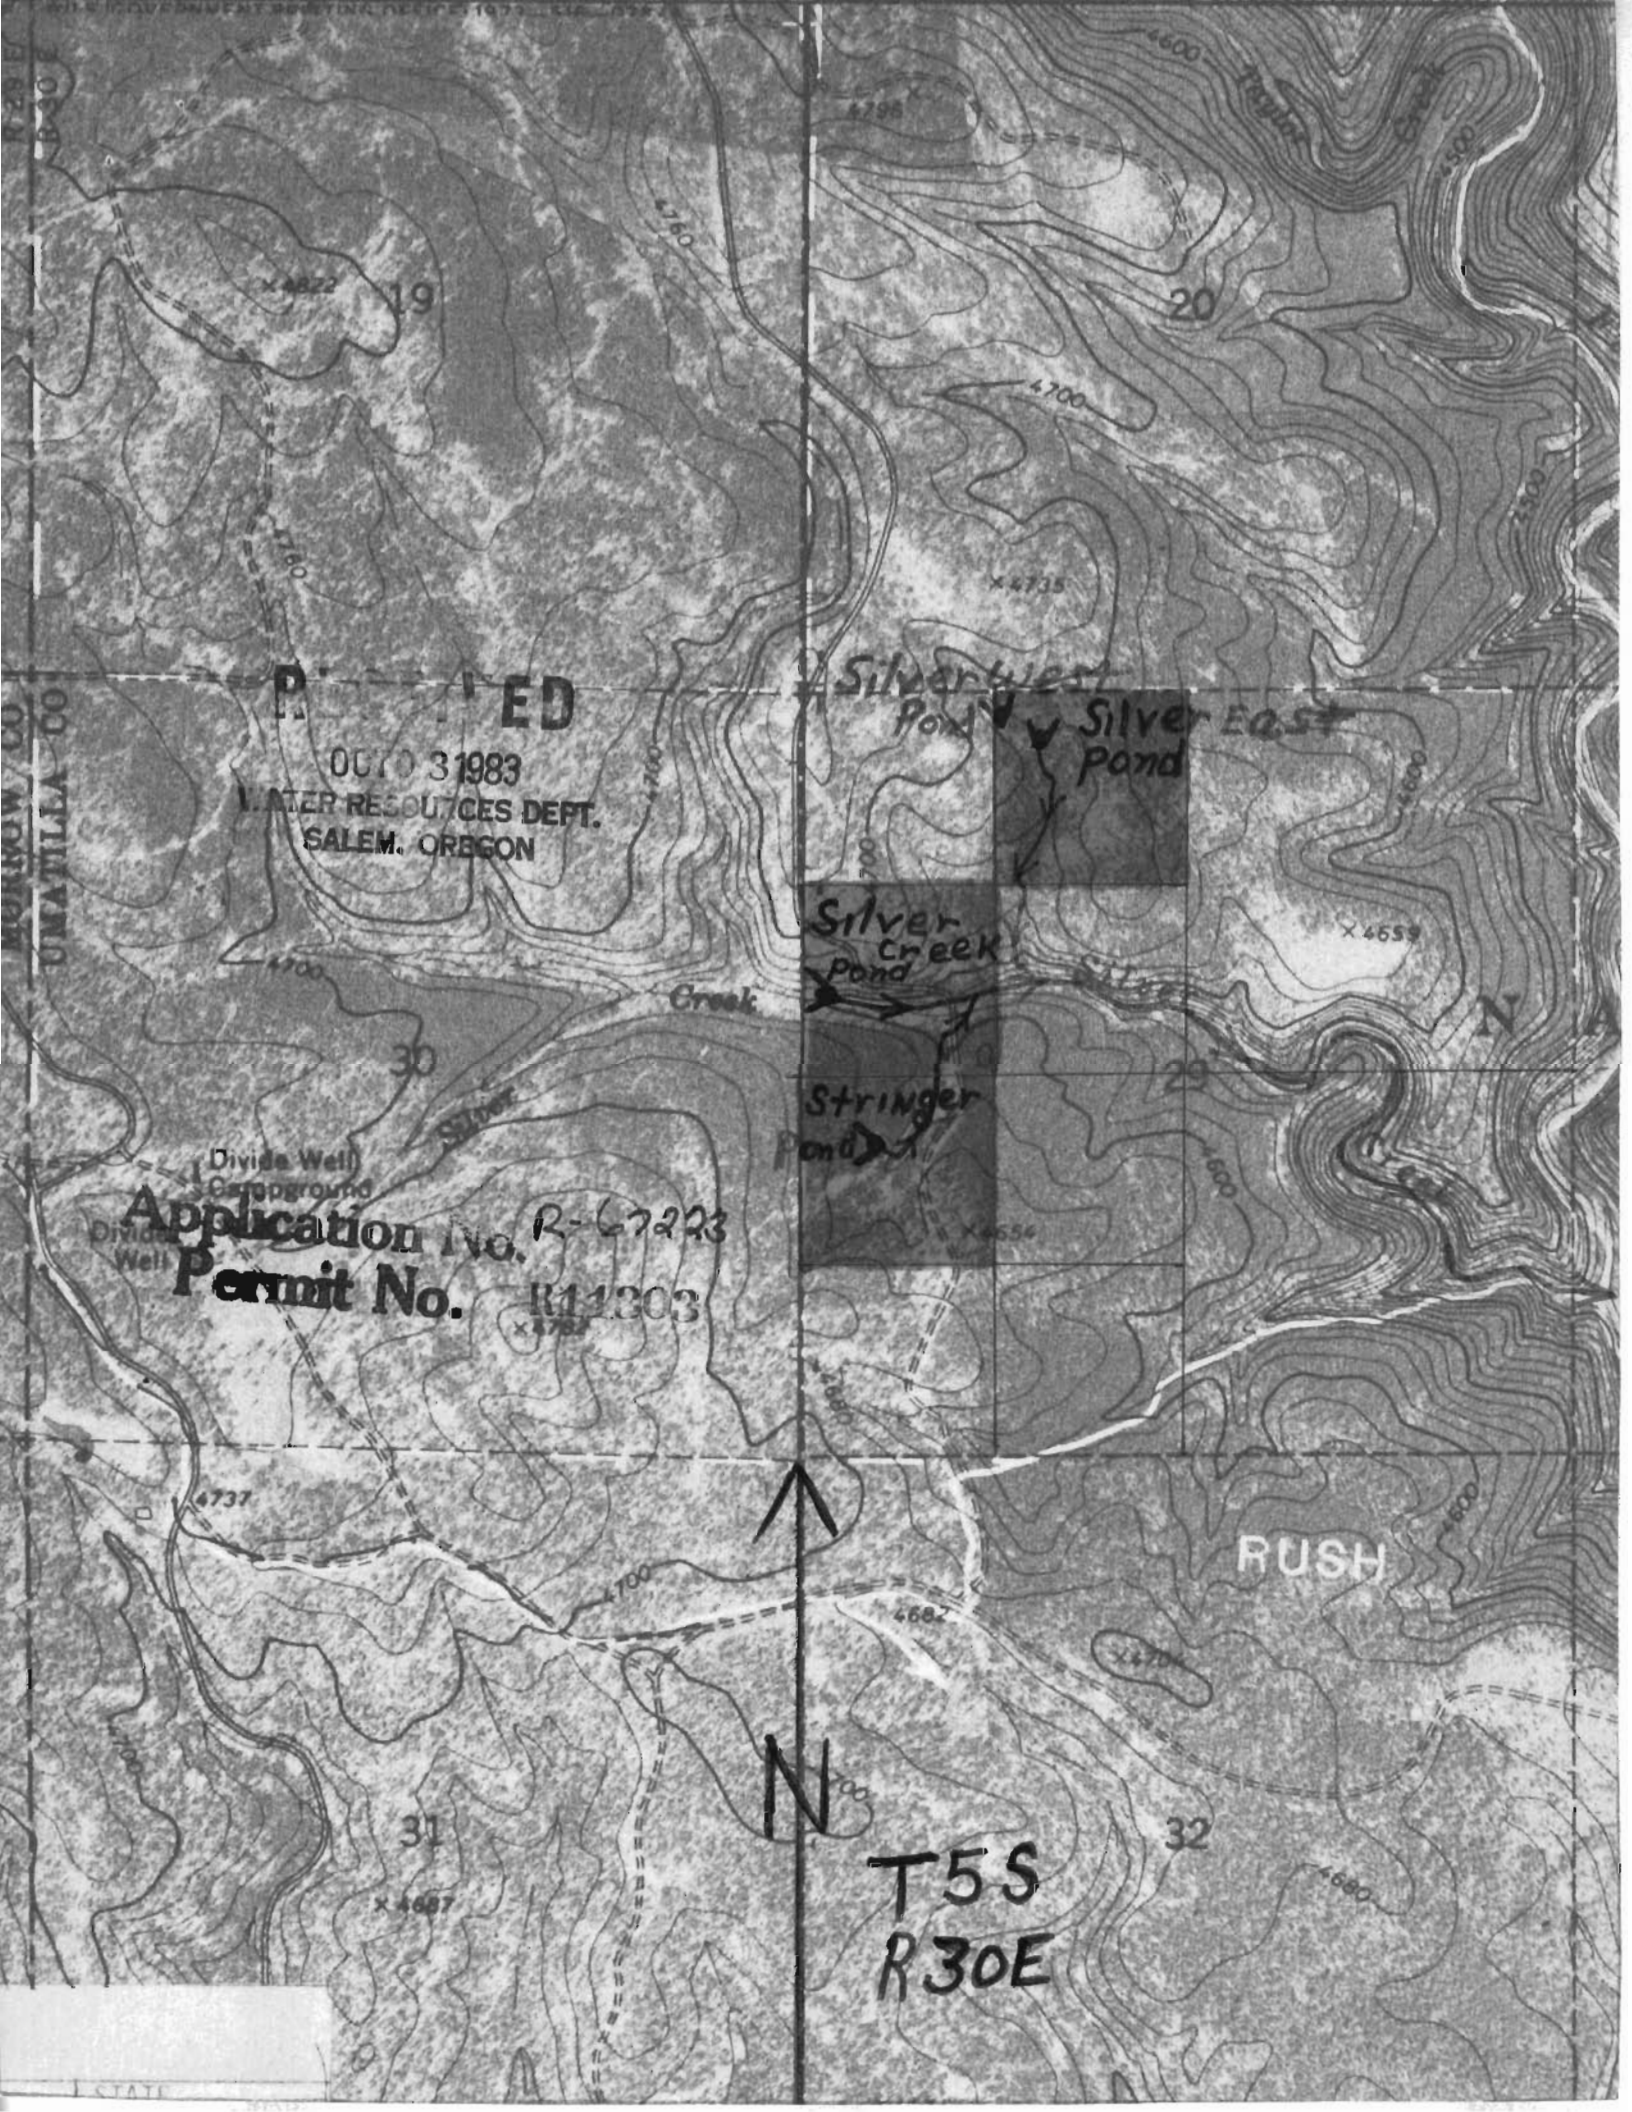

PERMIT

0070 31983
WATER RESOURCES DEPT.
SALEM, OREGON

Divide Well
Campground
Application No. R-67223
Permit No. R11303



T5S
R30E

RUSH