
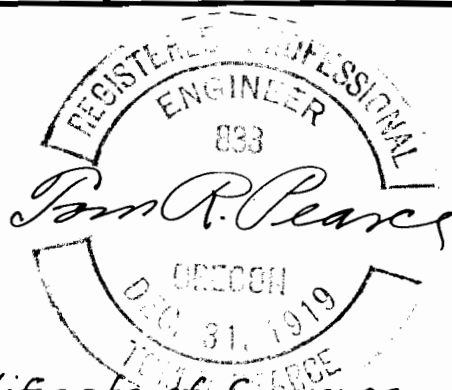


SHEAFFER DITCH

SEC. 26, T. 40 S., R. 7 W., N.M.

SCALE 2" = 1 MI.

MARCH, 1922

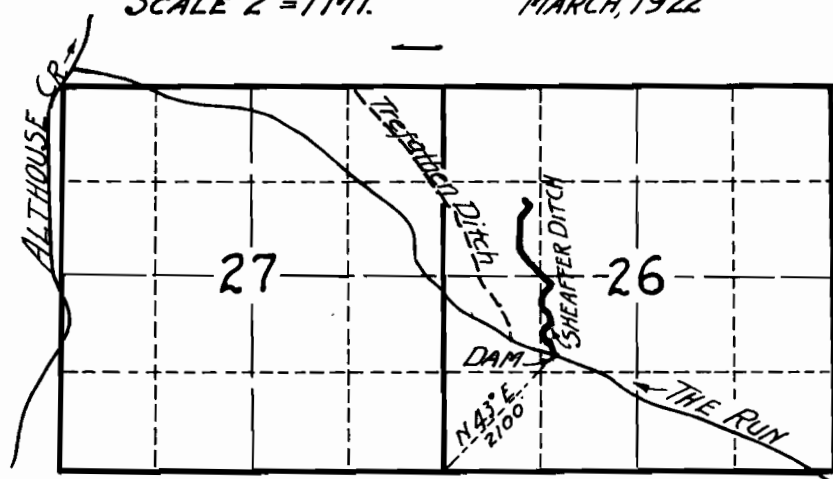

Certificate of Surveyor.

I, Tom R. Pearce, of Grants Pass, Oregon, do hereby certify that this map was made from notes taken during an actual survey made under my direction during March 1922 and that it correctly represents the work described in the accompanying application together with the location of streams and other ditches in the immediate vicinity.

Tom R. Pearce
8316 Surveyor.

5388