


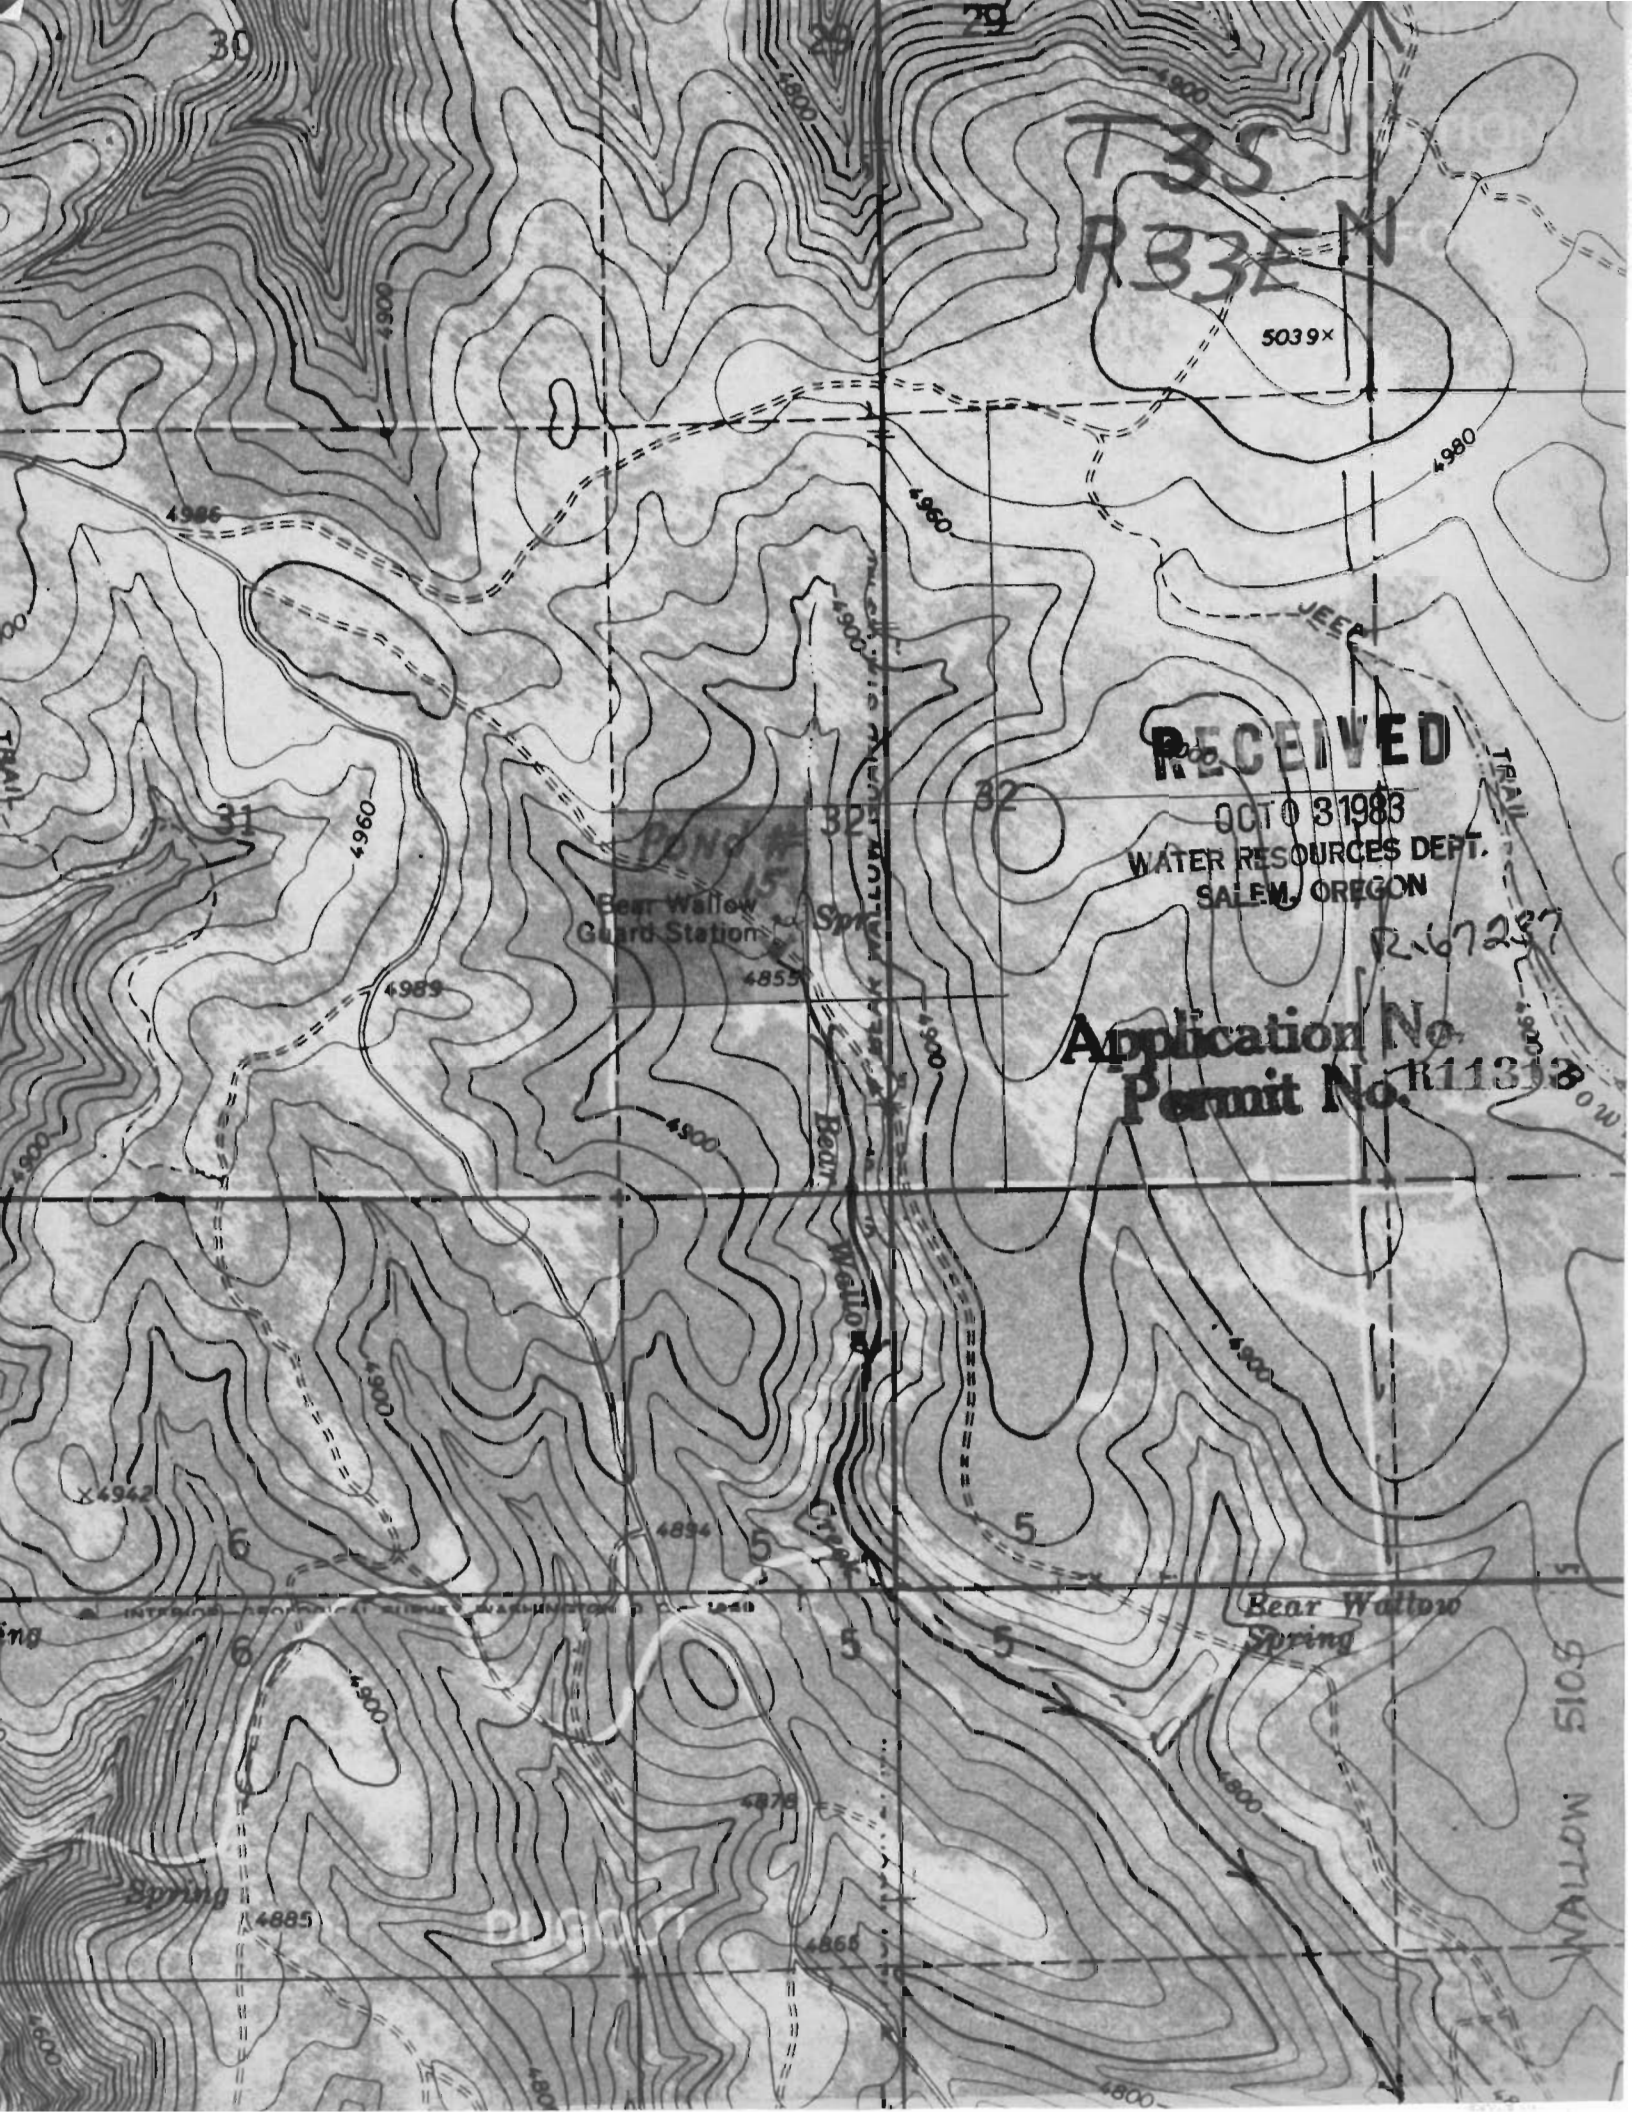

T35
R33E N

5039X

RECEIVED

OCT 03 1983
WATER RESOURCES DEPT.
SALEM, OREGON

R-67237

Application No.
Permit No. R11313

Bear Wallow
Guard Station

Bear Wallow
Spring

WALLOW 5105