




Lot #1
Pond 17

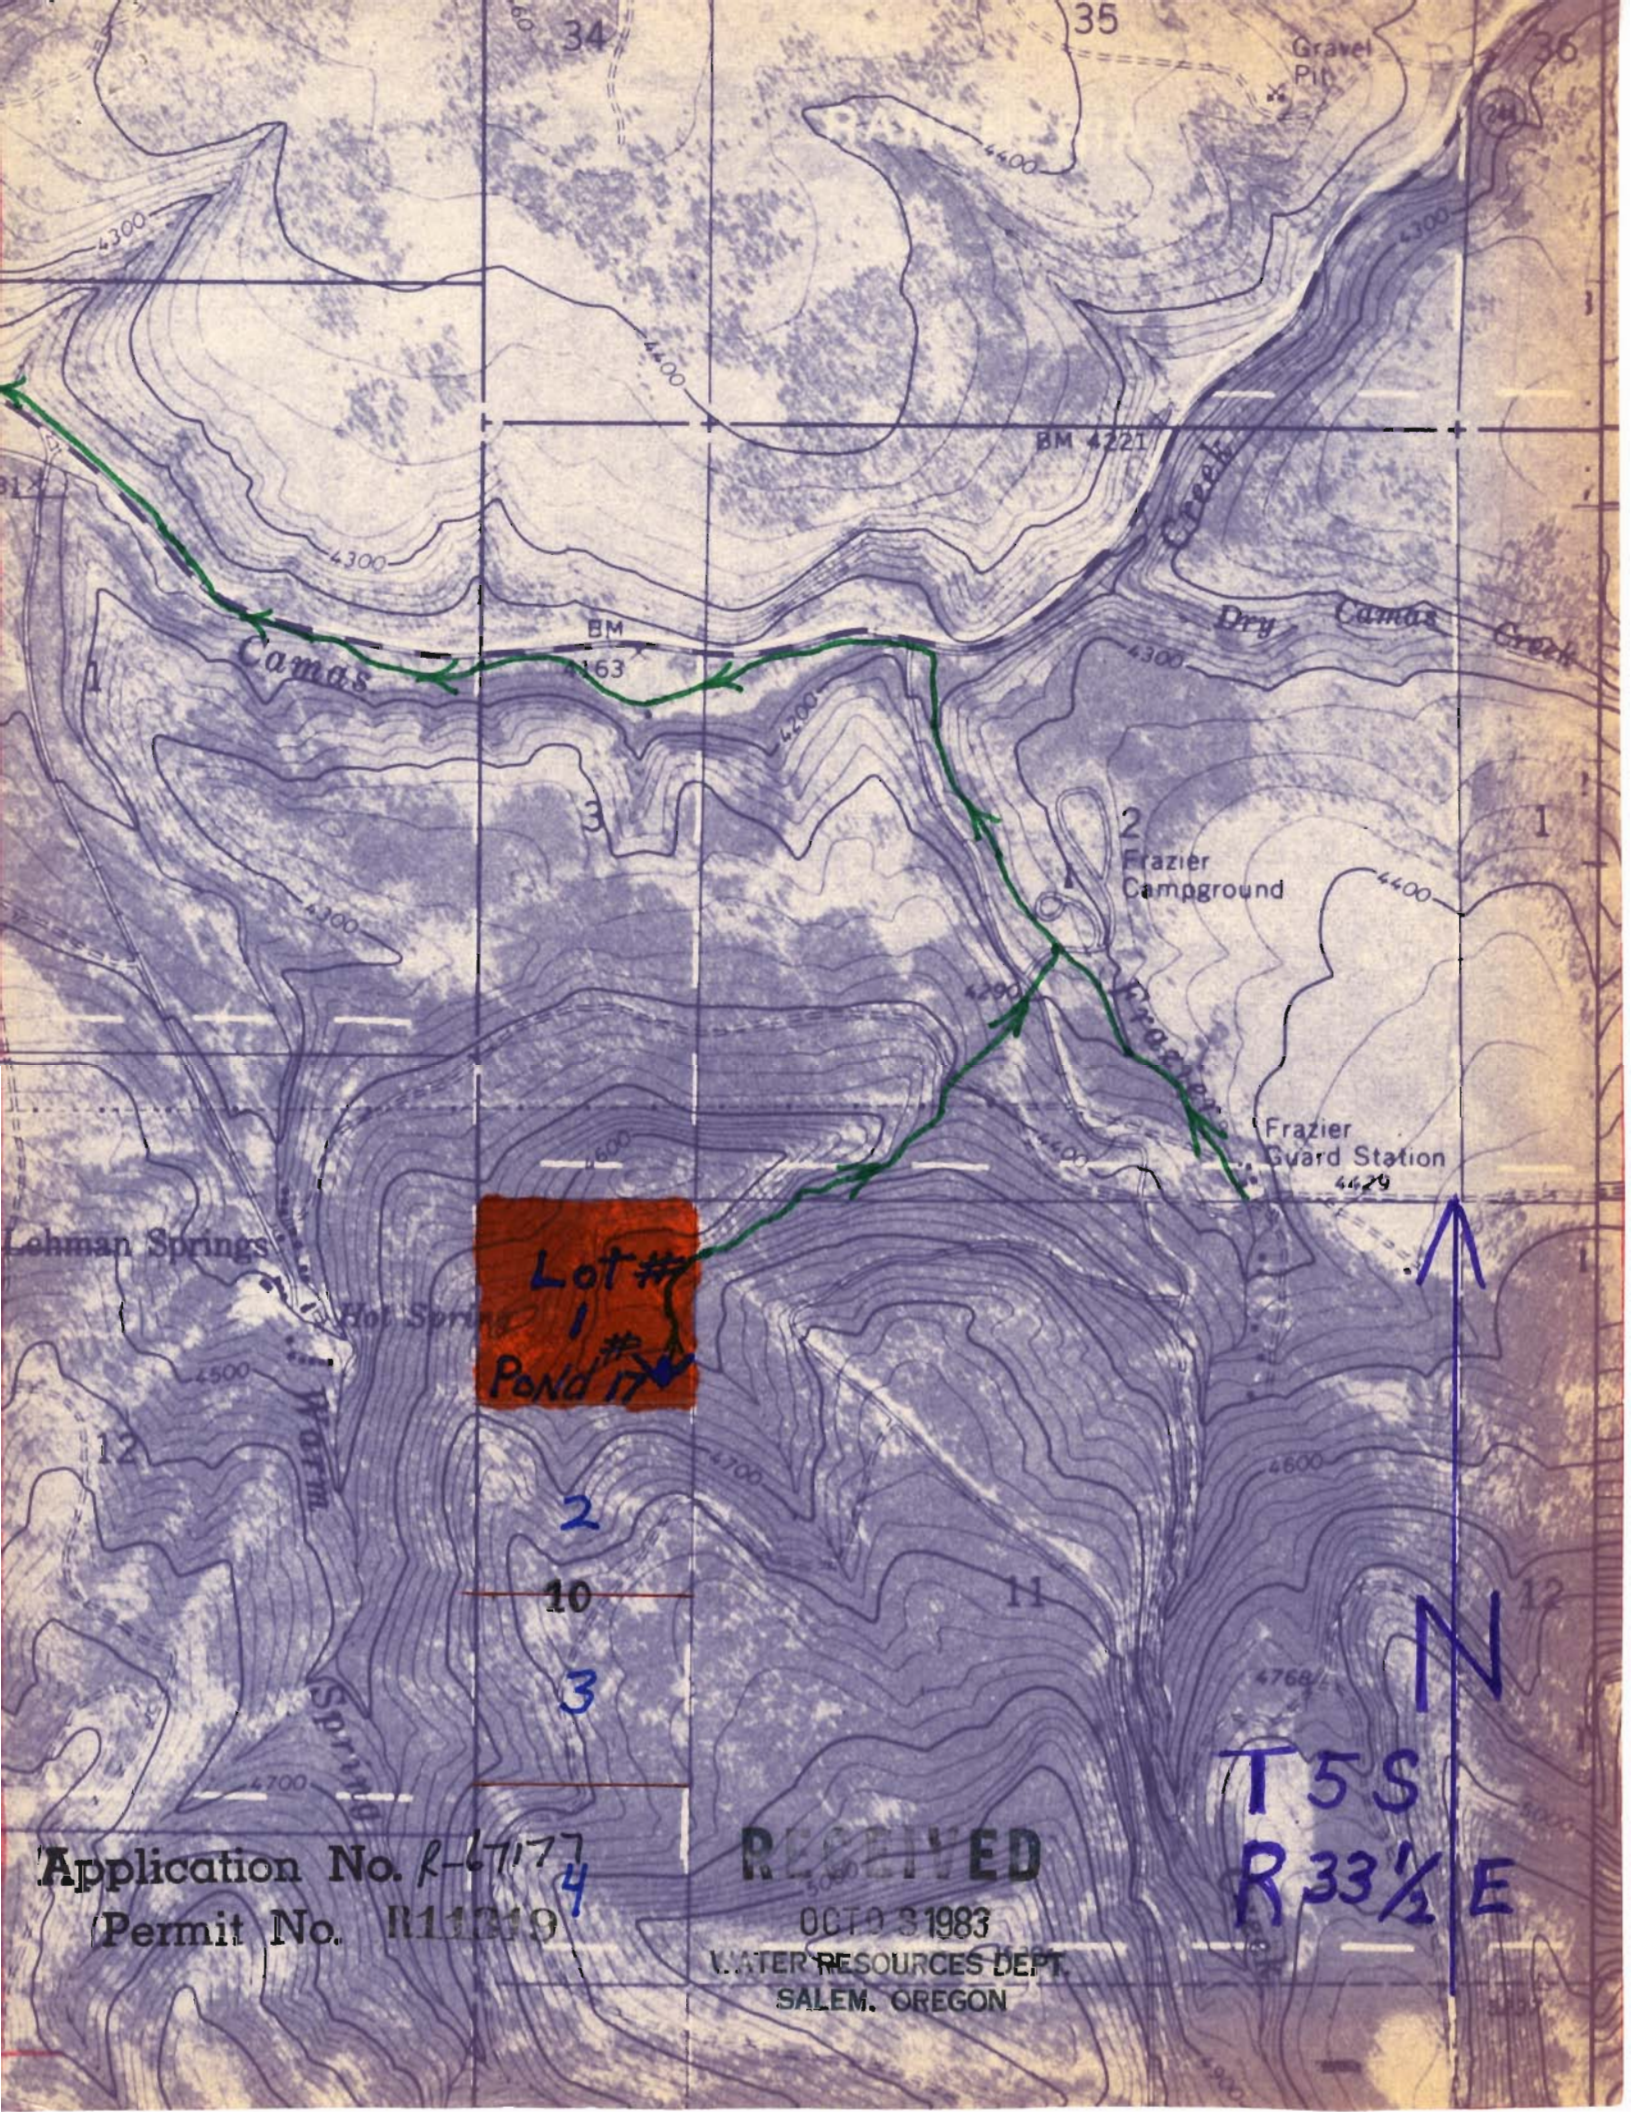


N

T5S
R33½E

Application No. R-67177
Permit No. R11219

RECEIVED
OCT 9 1983
WATER RESOURCES DEPT.
SALEM, OREGON

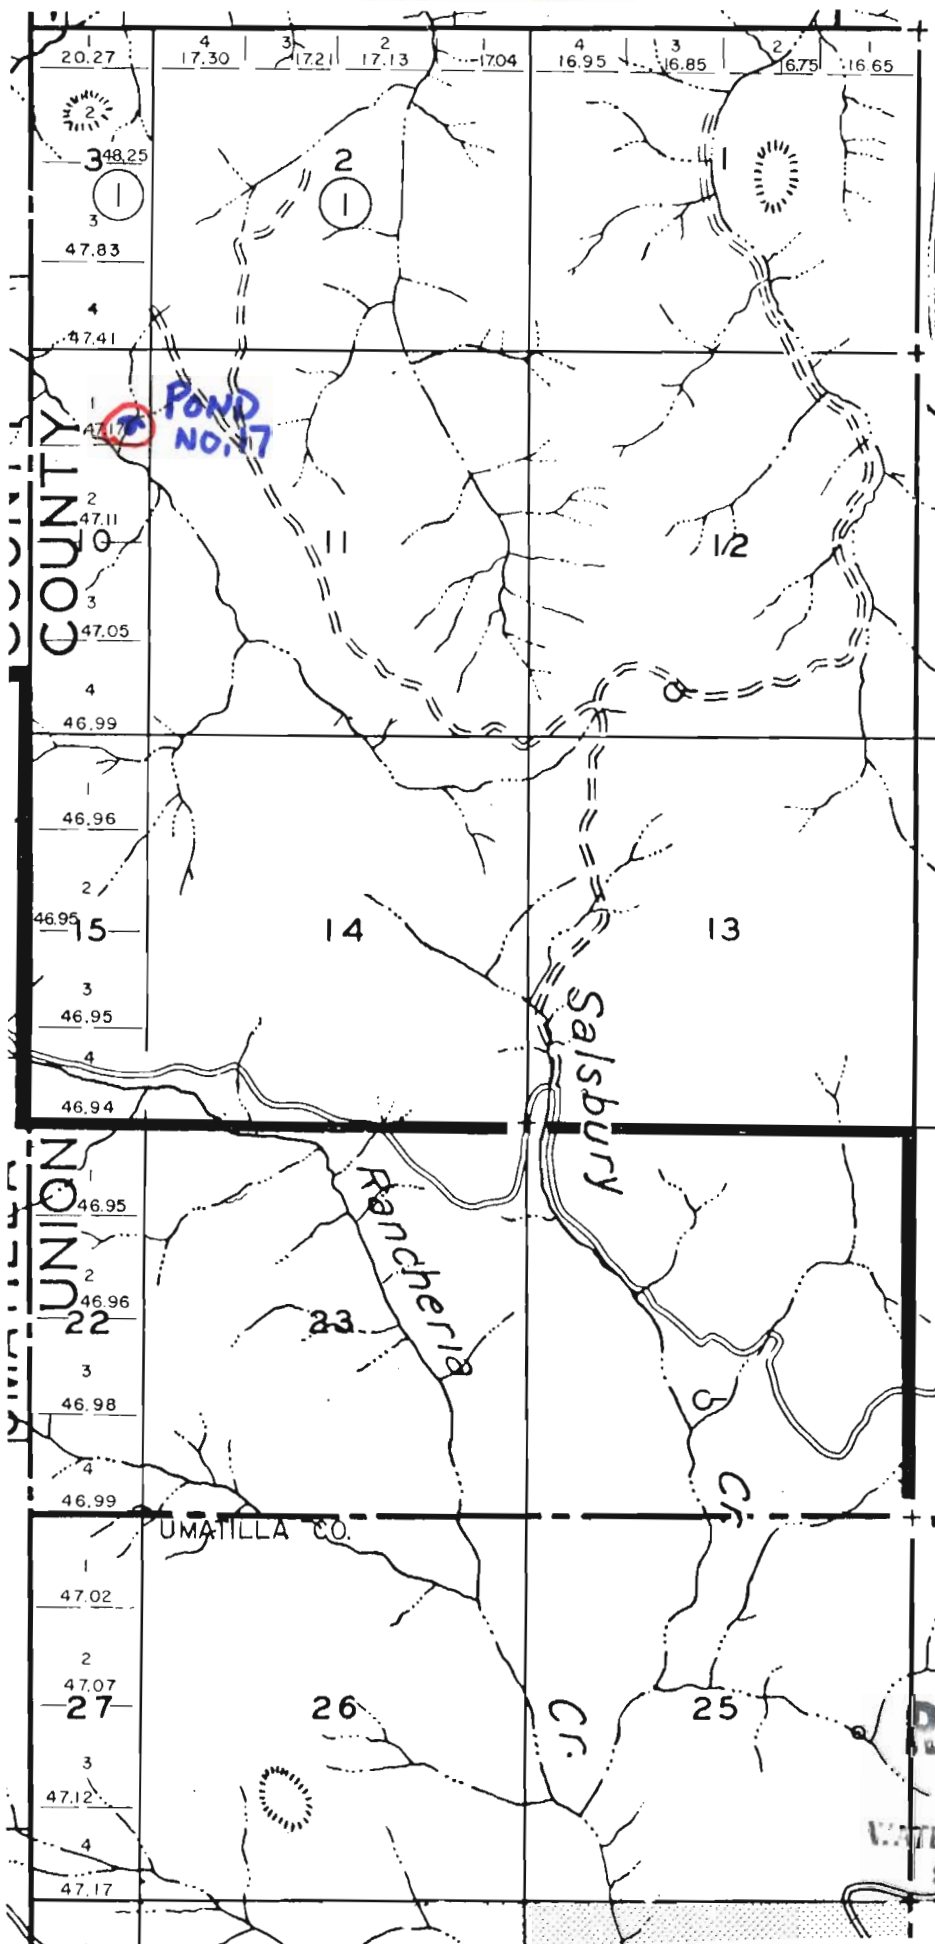

TSS

SCALE
2" = 1 mile



Application No. *R. 67177*
Permit No.

RECEIVED

OCT 03 1983

WATER RESOURCES DEPT.
SALEM, OREGON