


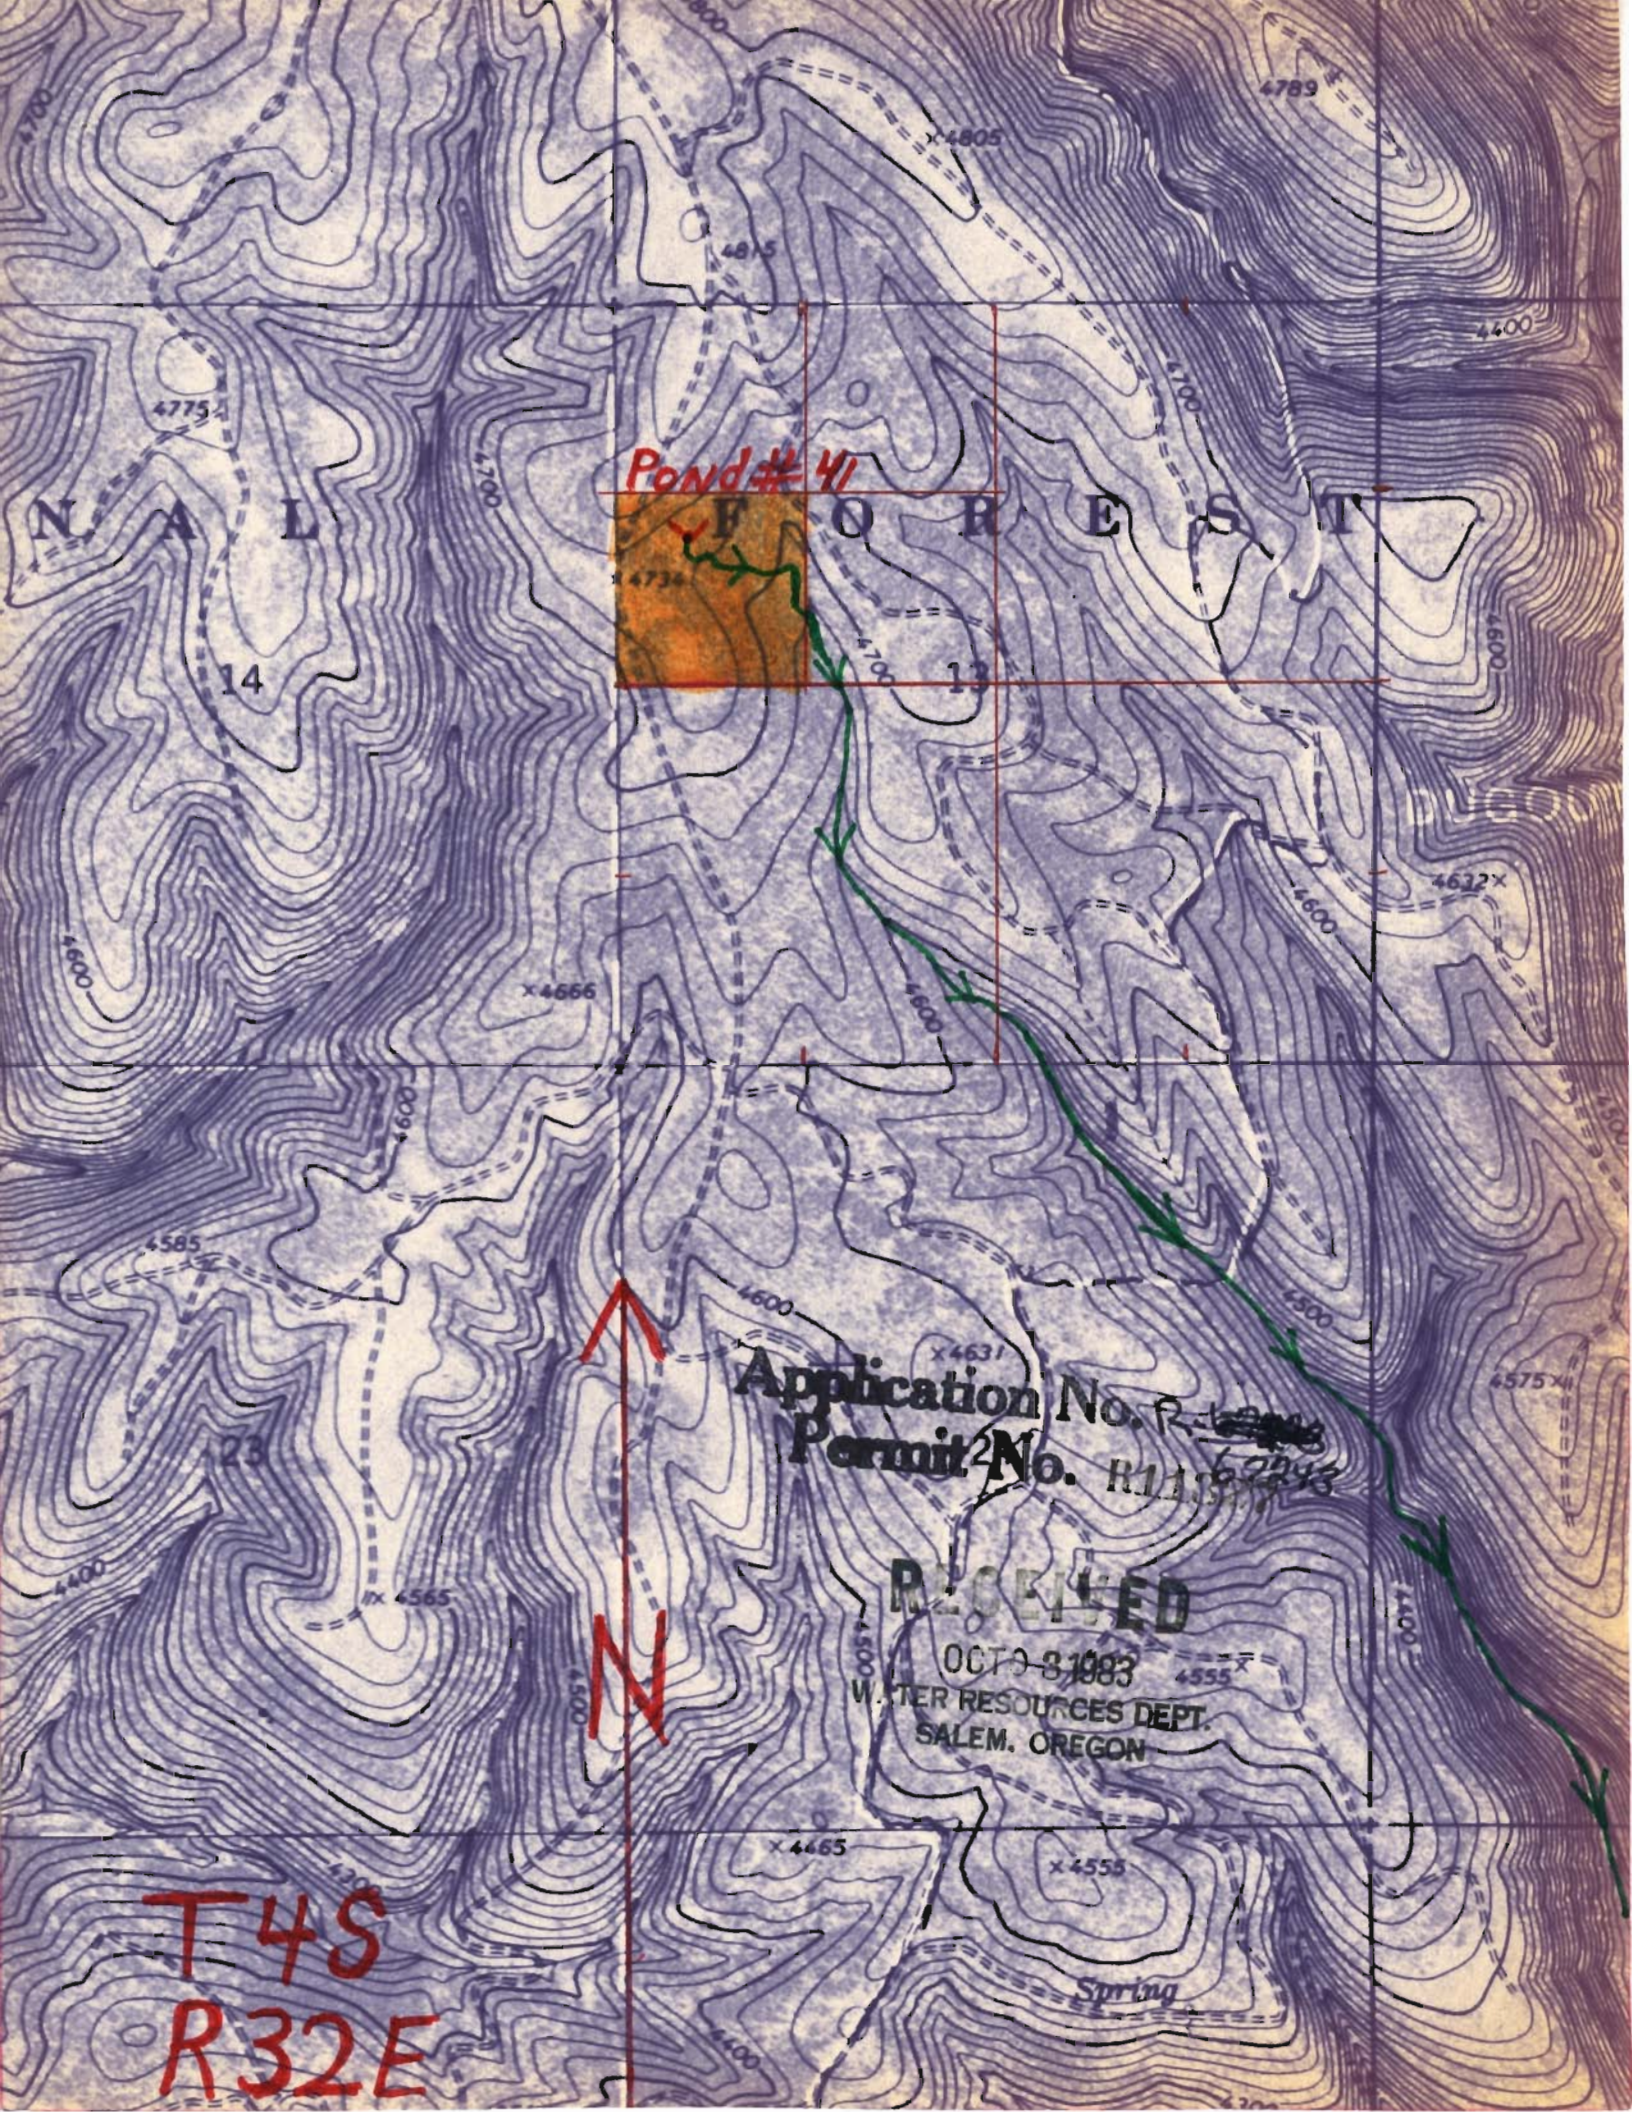

Pond # 41

N A L F O R E S T

14

13



N


RECEIVED

OCT 9-8-1983

WATER RESOURCES DEPT.
SALEM, OREGON

T4S
R32E

Spring


Pond
23

RECEIVED

OCT 9 3 1983
WATER RESOURCES DEPT.
SALEM, OREGON

Application No. R457243
Permit No. R11327

T4S
R32EN

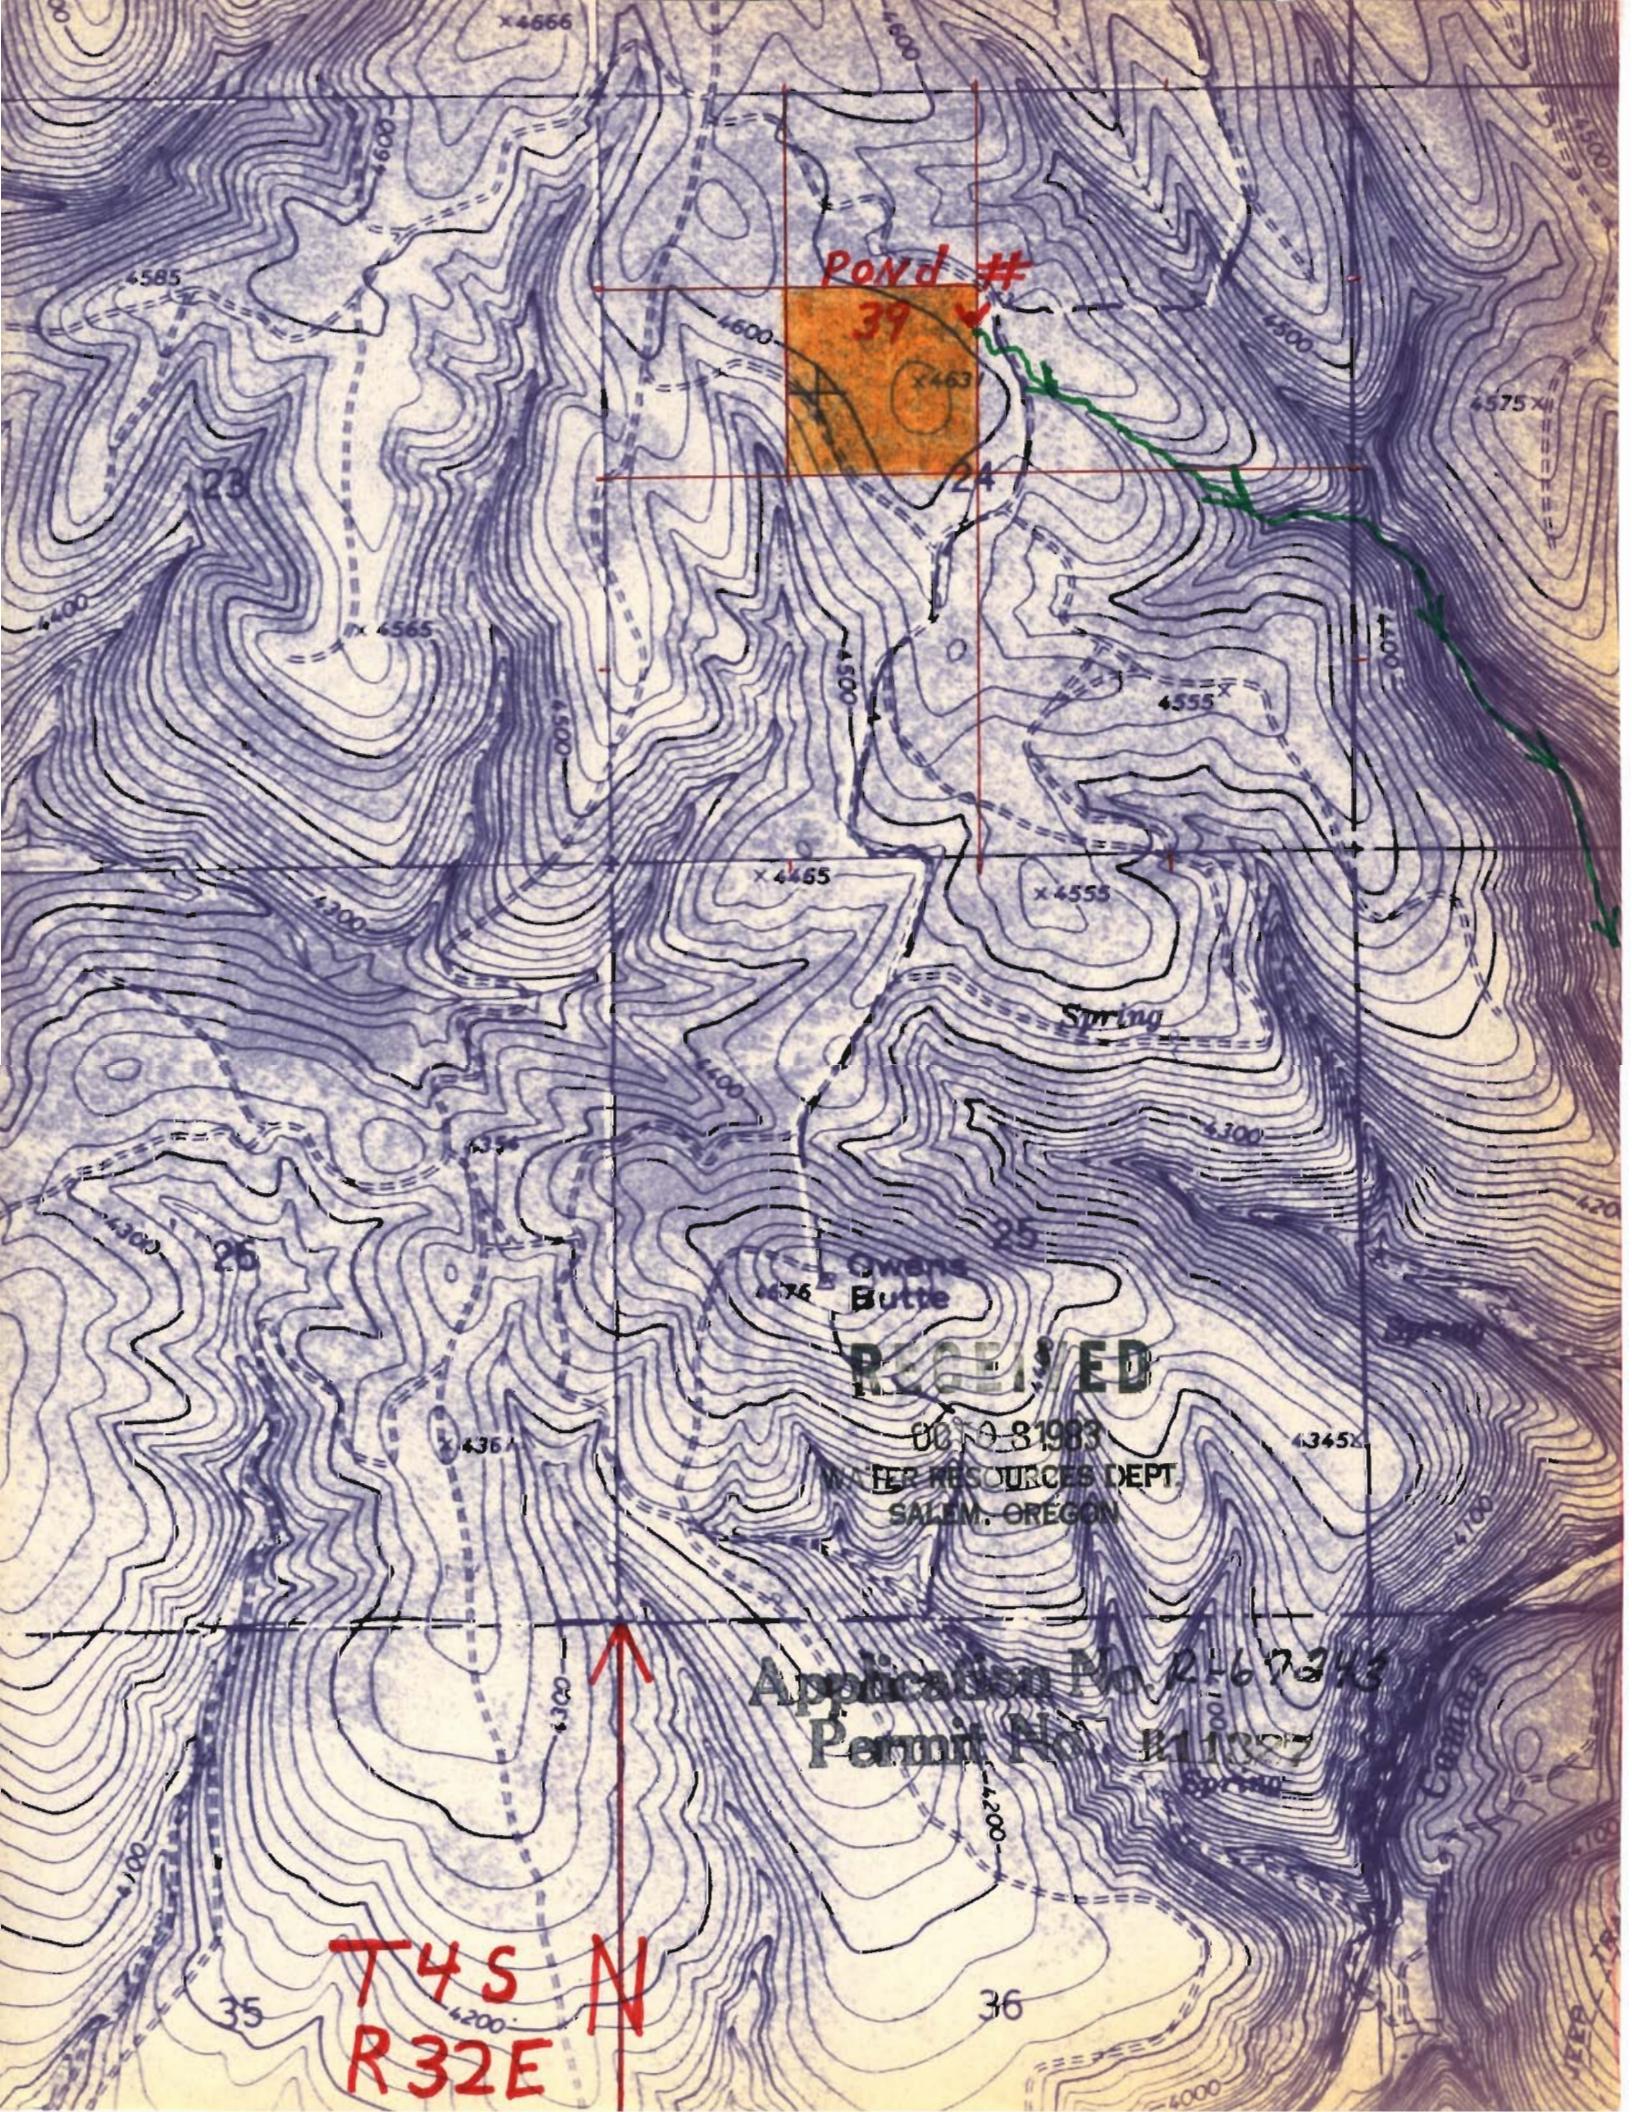

POND #
39

RECEIVED

0070 81983

WATER RESOURCES DEPT.
SALEM, OREGON

Application No. 2467243
Permit No. B11327

T4S N
R32E