

T4S
R33E


RECEIVED

OCT 31 1983
WATER RESOURCES DEPT.
SALEM, OREGON

Application No. R-67251
Permit No. R11329

POND
#33

N

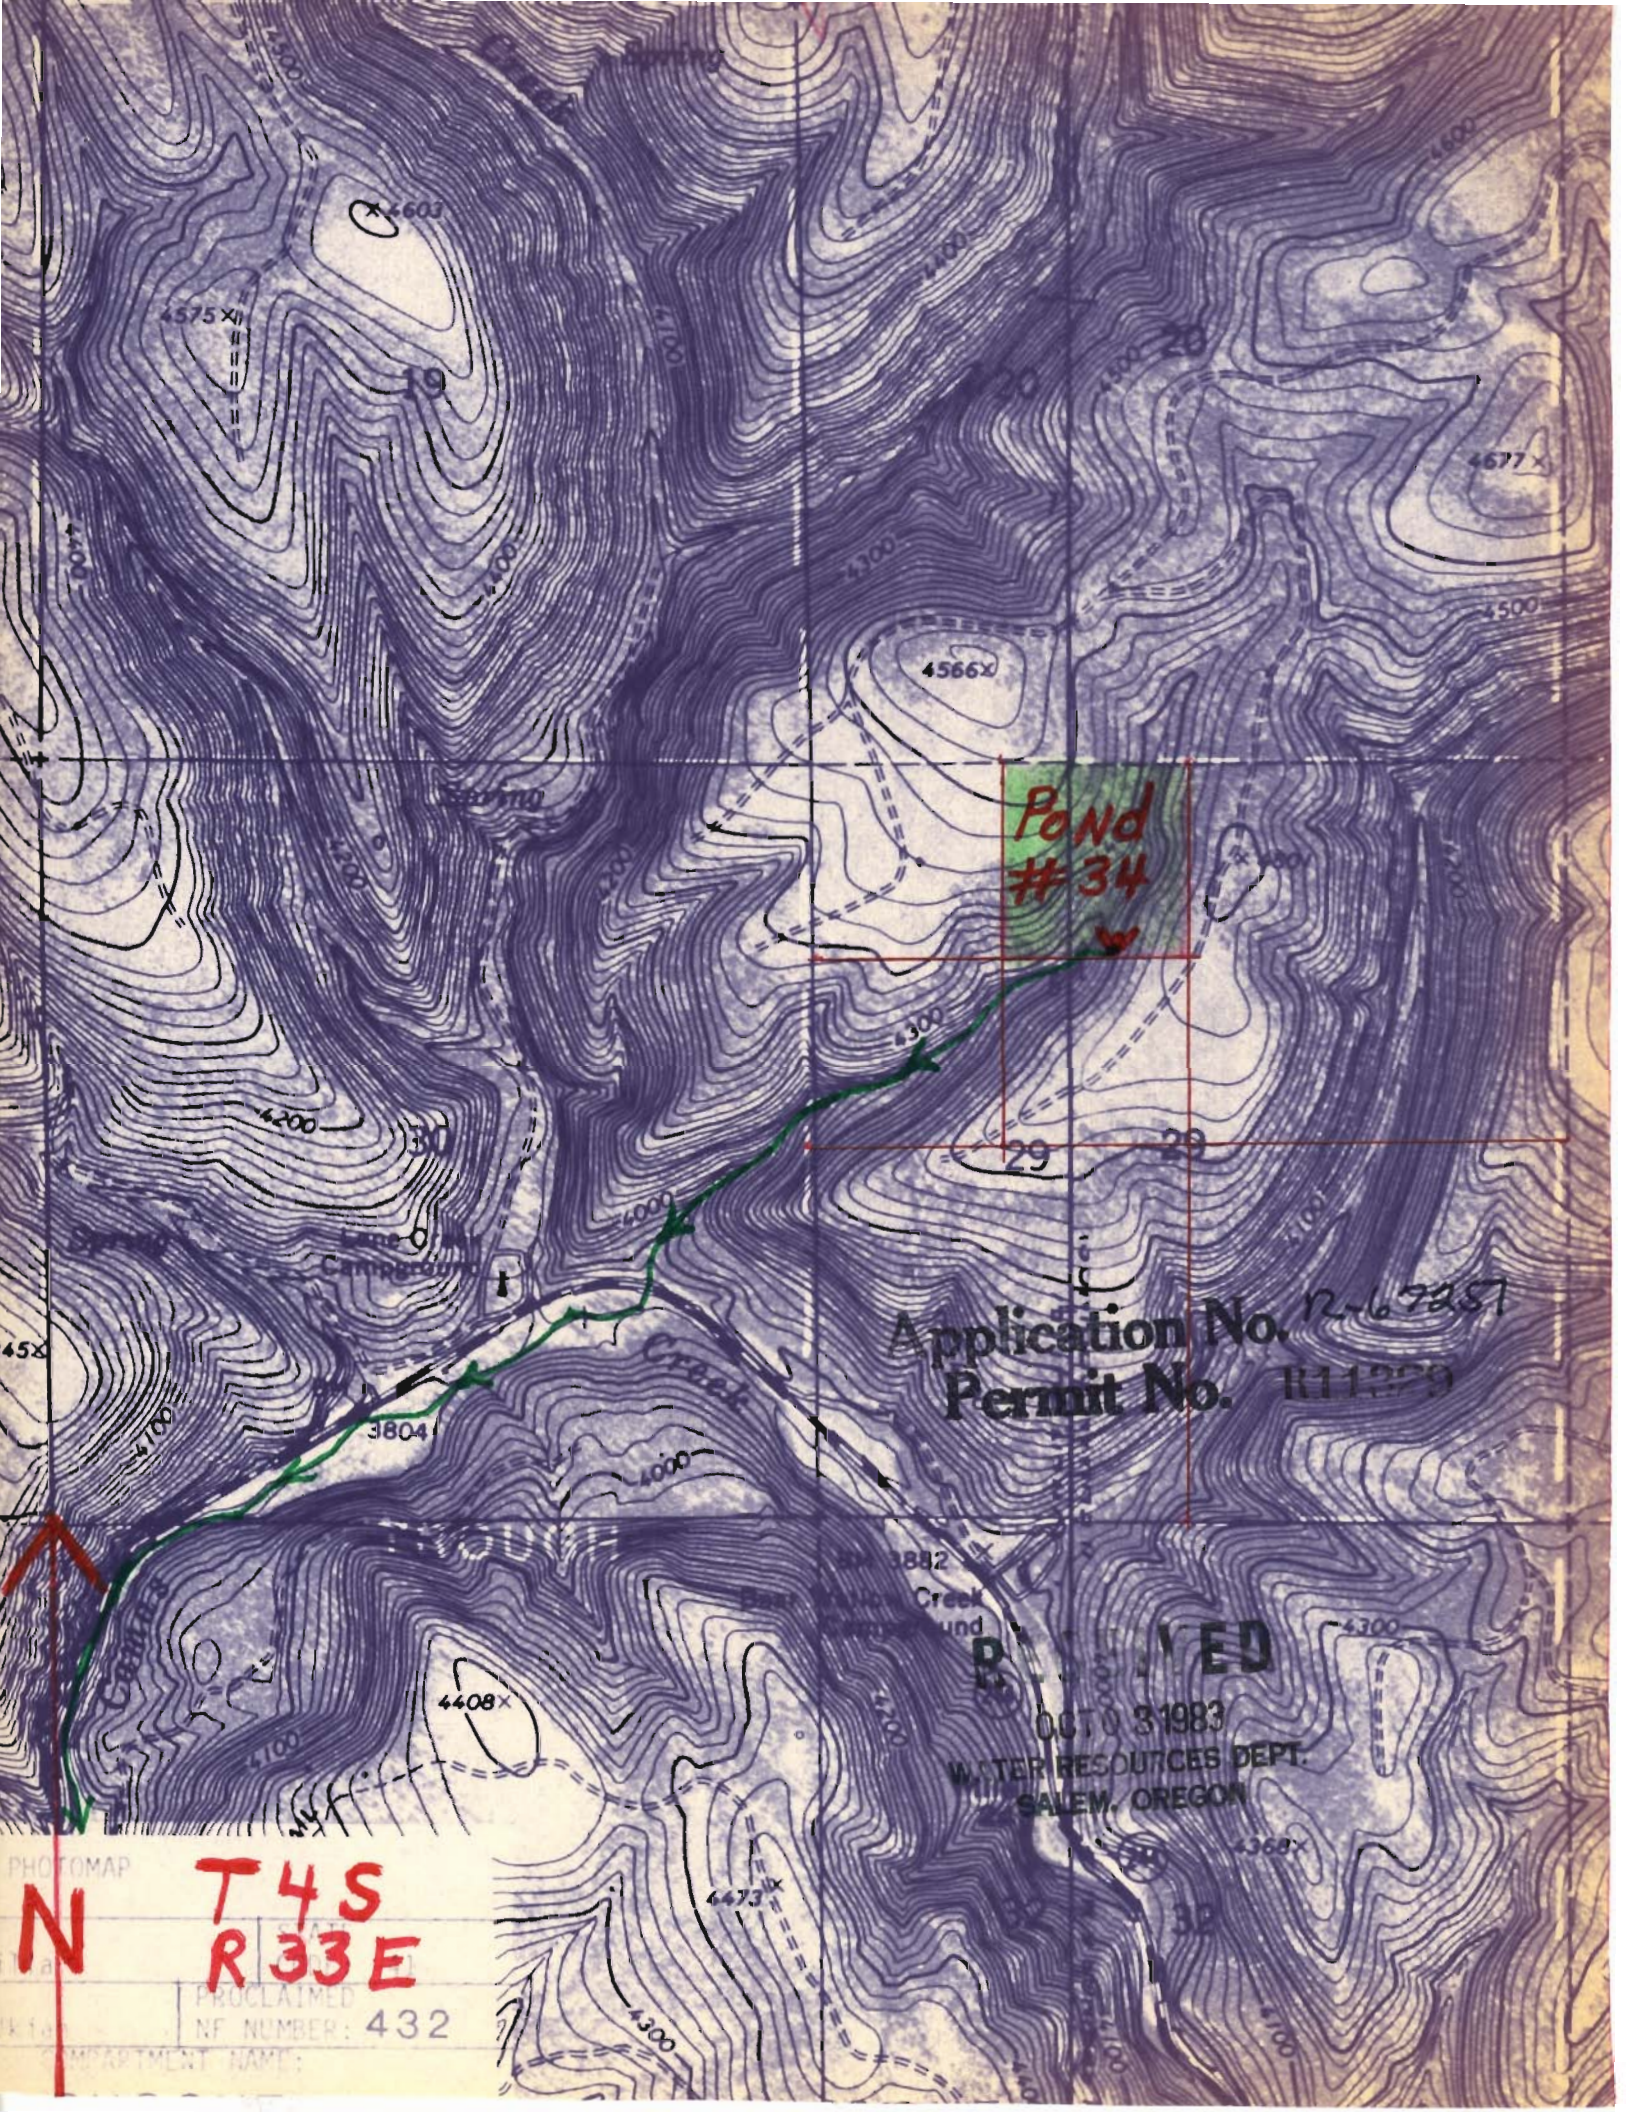

Pond
#34

Application No. R-67251
Permit No. R11229

RECEIVED

OCT 3 1983
WATER RESOURCES DEPT.
SALEM, OREGON

PHOTOMAP

N

T4S
R33E

PROCLAIMED
NF NUMBER: 432